




THE SURFACE UTILITY INFORMATION SHOWN ON THESE PLANS IS A UTILITY QUALITY DATA. THIS QUALITY LEVEL WAS DETERMINED ACCORDING TO THE GUIDELINES OF ASCS/C 38-02, TITLE "STANDARD GUIDELINES FOR THE COLLECTION AND DEPOSITION OF EXISTING SURFACE UTILITY DATA." THE CONTRACTOR AND SUBCONTRACTORS SHALL BE RESPONSIBLE FOR THE EXISTING SURFACE UTILITIES RECORDING AND DEPOSITION. THE CONTRACTOR SHALL NOTIFY THE CITY OF MINNESOTA (CITY) (COPPER STATE ONE FOR MINNESOTA) THE CONTRACTOR AND/OR SUBCONTRACTOR AGREE TO BE FULLY RESPONSIBLE FOR ANY AND ALL DAMAGES, WHICH MIGHT BE OCCASIONED BY HIS OR HER FAILURE TO EXACTLY LOCATE AND PRESERVE ANY AND ALL UTILITIES (UNDERGROUND AND OVERHEAD).

IF THE CONTRACTOR ENCOUNTERS ANY DRAIN TIE WITHIN THE SITE, HE OR SHE SHALL NOTIFY THE ENGINEERING WITH THE LOCATION, SIZE, INVERT AND IF THE TIE LINE IS ACTIVE. NO DRAIN TIE SHALL BE BACKFILLED WITHOUT APPROVAL FROM THE PROJECT ENGINEER.

IT SHALL BE THE RESPONSIBILITIES OF THE CONTRACTOR TO RELOCATE ALL EXISTING UTILITIES WHICH CONFLICT WITH THE PROPOSED IMPROVEMENTS SHOWN ON THE PLANS.

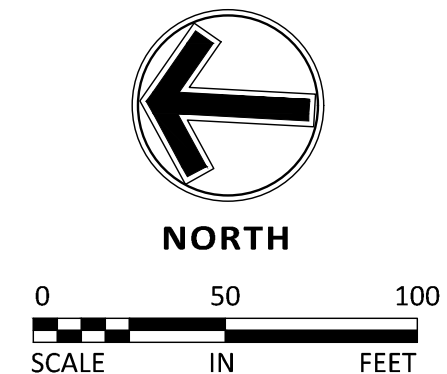

THESE RECORD PLANS HAVE BEEN PREPARED, IN PART, BASED ON INFORMATION COMPILED AND FURNISHED BY OTHERS. THE ENGINEER HAS NOT VERIFIED THE ACCURACY AND/OR COMPLETENESS OF THE INFORMATION PROVIDED AND SHALL NOT BE RESPONSIBLE FOR ANY ERRORS OR OMISSIONS WHICH HAVE BEEN INCORPORATED INTO THESE RECORD PLANS AS A RESULT.



2850 CUTTERS GROVE AVE
SUITE 207
ANOKA, MN 55303

**Project
MISKE
MEADOWS
SEVENTH
ADDITION**

Location
ELK RIVER, MN

Certification

I hereby certify that this plan, specification or report was prepared by me or under my direct supervision and that I am a duly licensed professional ENGINEER under the laws of the state of Minnesota.


Eric T. Luth
Registration No. 50475 Date: 04/26/2021
If applicable, contact us for a wet signed copy of this plan which is available upon request at Sambatek's, Minnetonka, MN office.

Summary

Designed: ETL Drawn: CJS
Approved: ETL Initial Issue: 04/26/2021
Phase: CONSTRUCTION

Revision History

No.	Date	By	Submittal / Revision
A	05/17/21	JB	REVISE STORM

Sheet Title
UTILITY PLAN -
FILLMORE
DRIVE

Sheet No. Revision
C6.03 A

Project No. 20460.70