


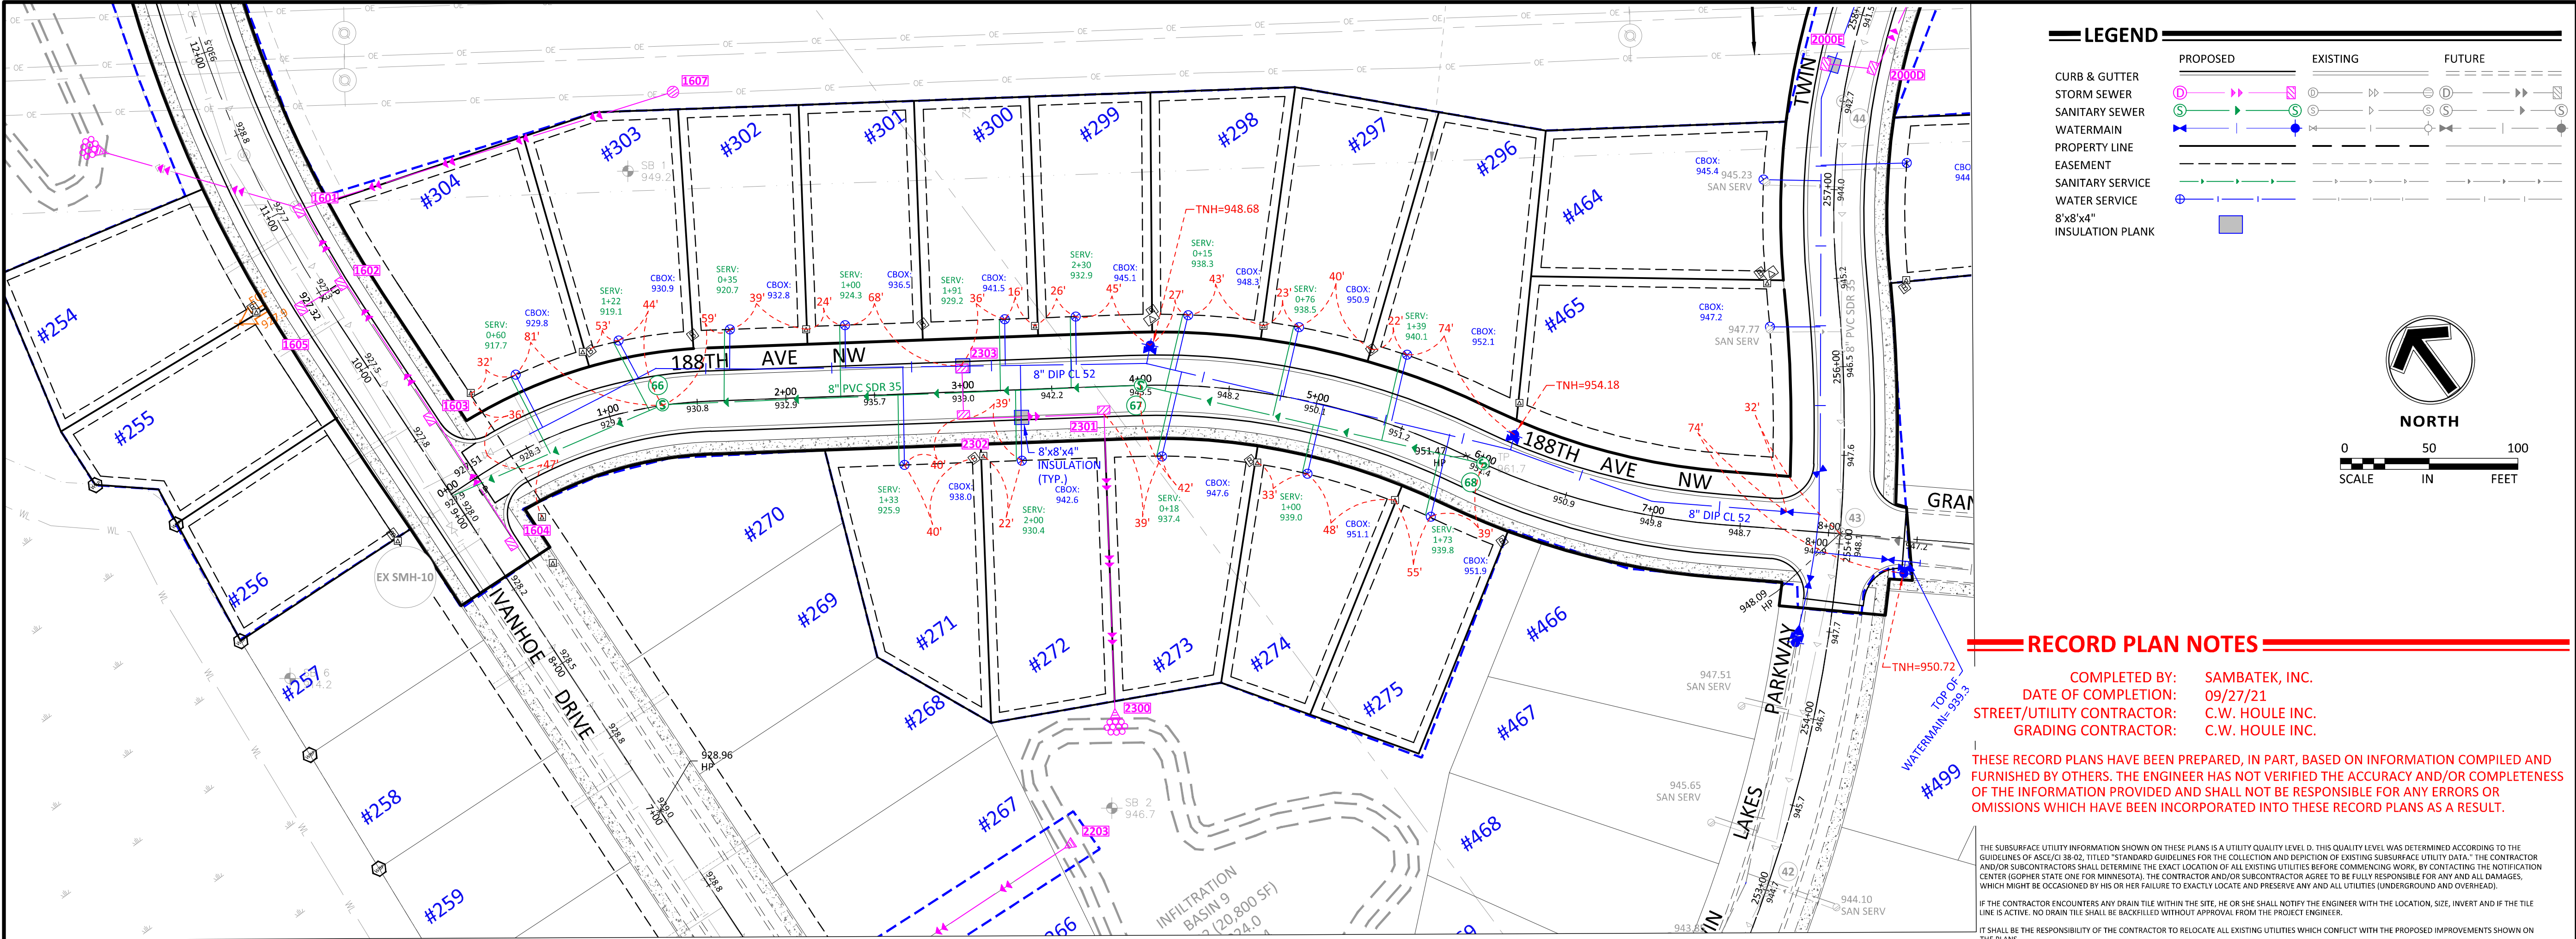

Client
PAXMAR, LLC.

2850 CUTTERS GROVE AVE
SUITE 207
ANOKA, MN 55303

Project
**MISKE
MEADOWS
SEVENTH
ADDITION**

Location
ELK RIVER, MN

Certification

I hereby certify that this plan, specification or report was prepared by me or under my direct supervision and that I am a duly licensed professional ENGINEER under the laws of the state of Minnesota.

Eric T. Luth

Eric T. Luth
Registration No. 50475 Date: 04/26/2021

If applicable, contact us for a wet signed copy of this plan which is available upon request at Sambatek's, Minnetonka, MN office.

Summary

Designed: ETL Drawn: CIS
Approved: ETL Initial Issue: 04/26/2021
Phase: CONSTRUCTION

Revision History

No. Date By Submittal / Revision
A 05/17/21 JB REVISE STORM

Sheet Title
**UTILITY PLAN -
188TH AVENUE**

Sheet No. Revision
C6.04 A

Project No. 20460.70

