
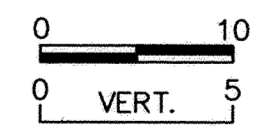
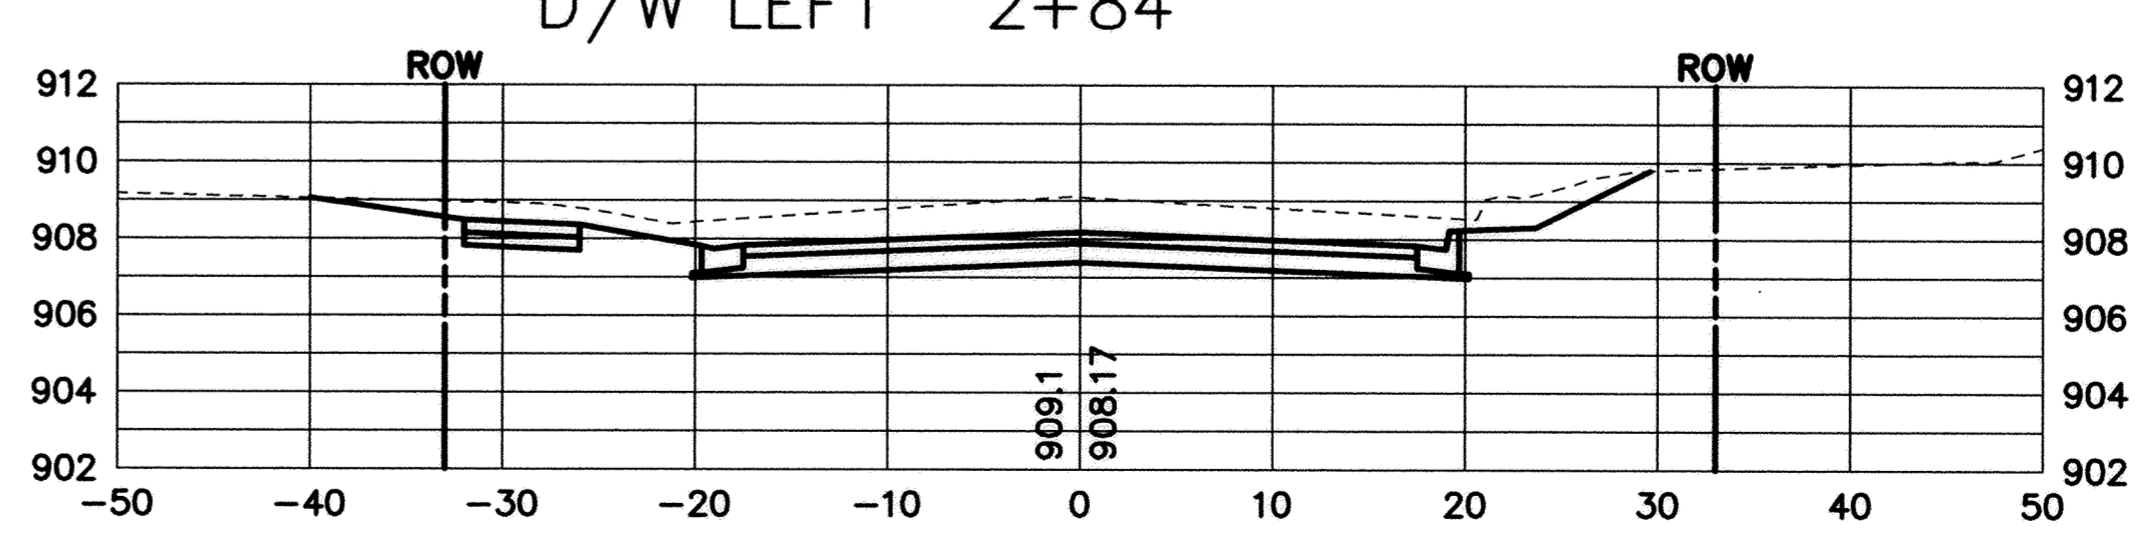
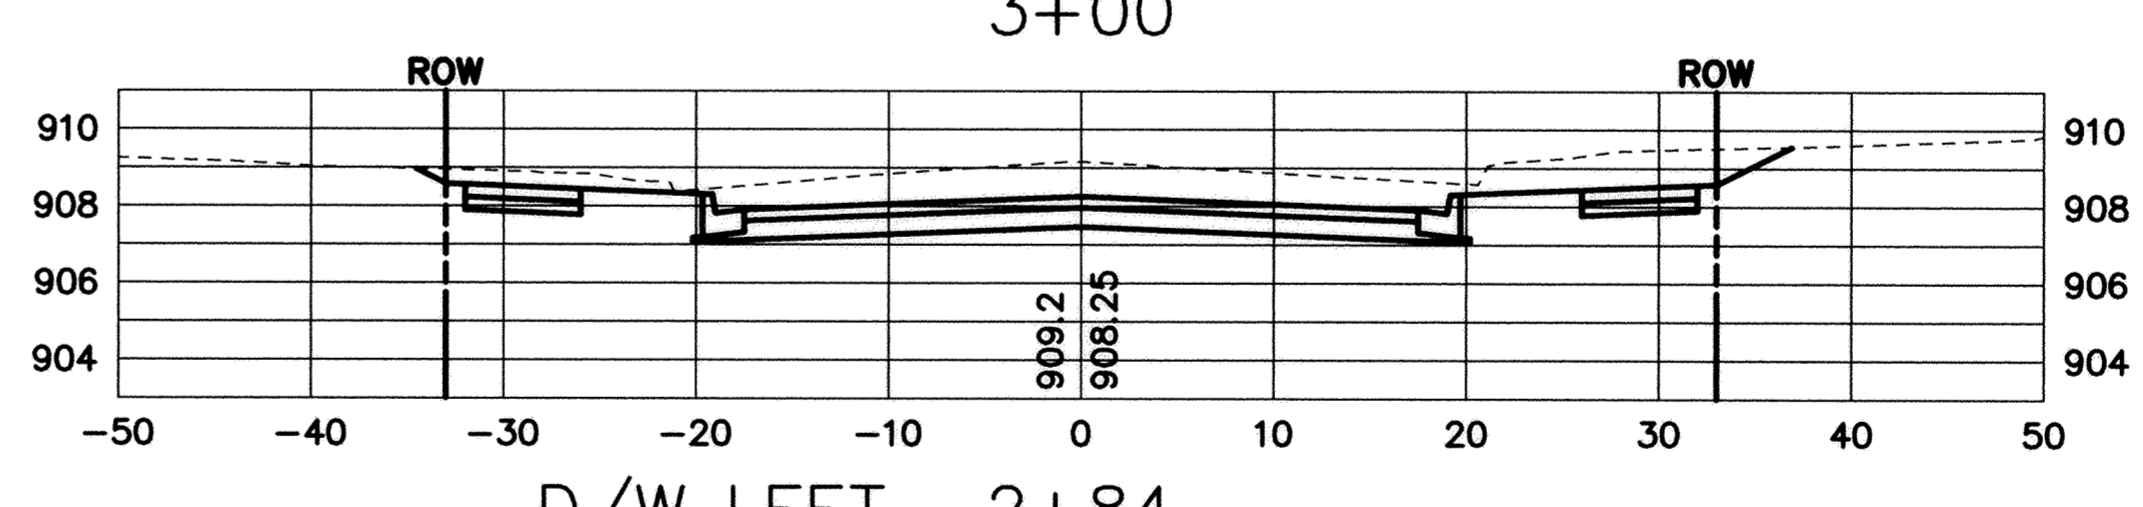
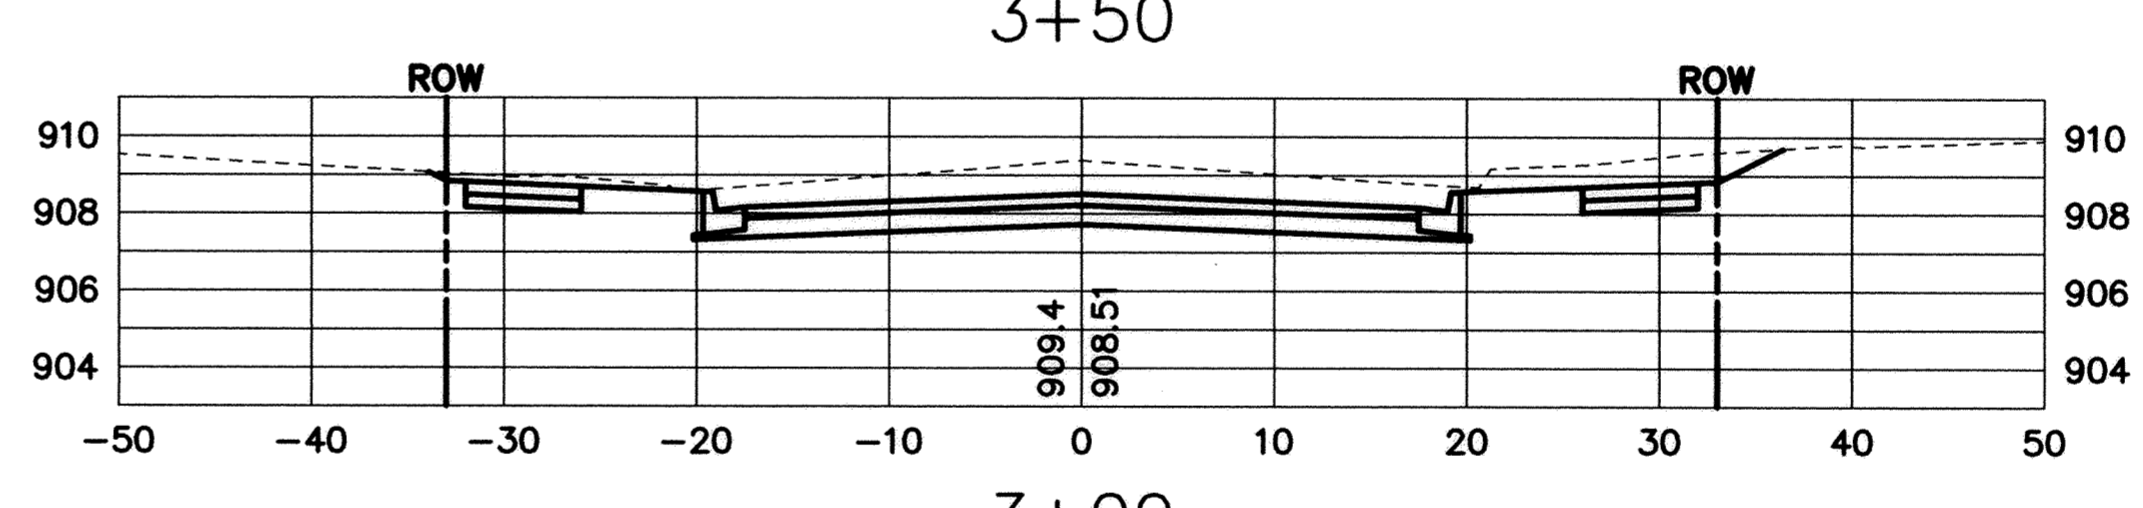
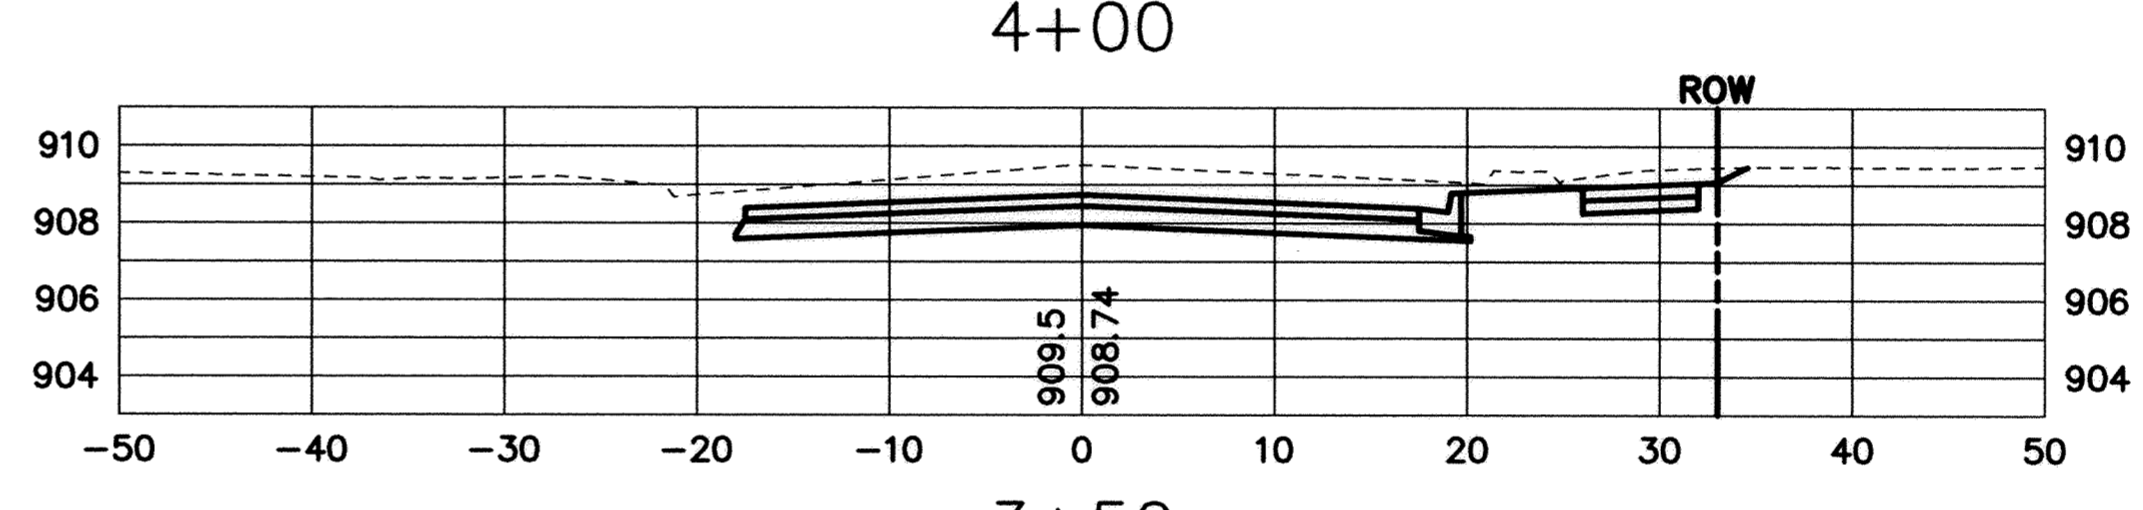
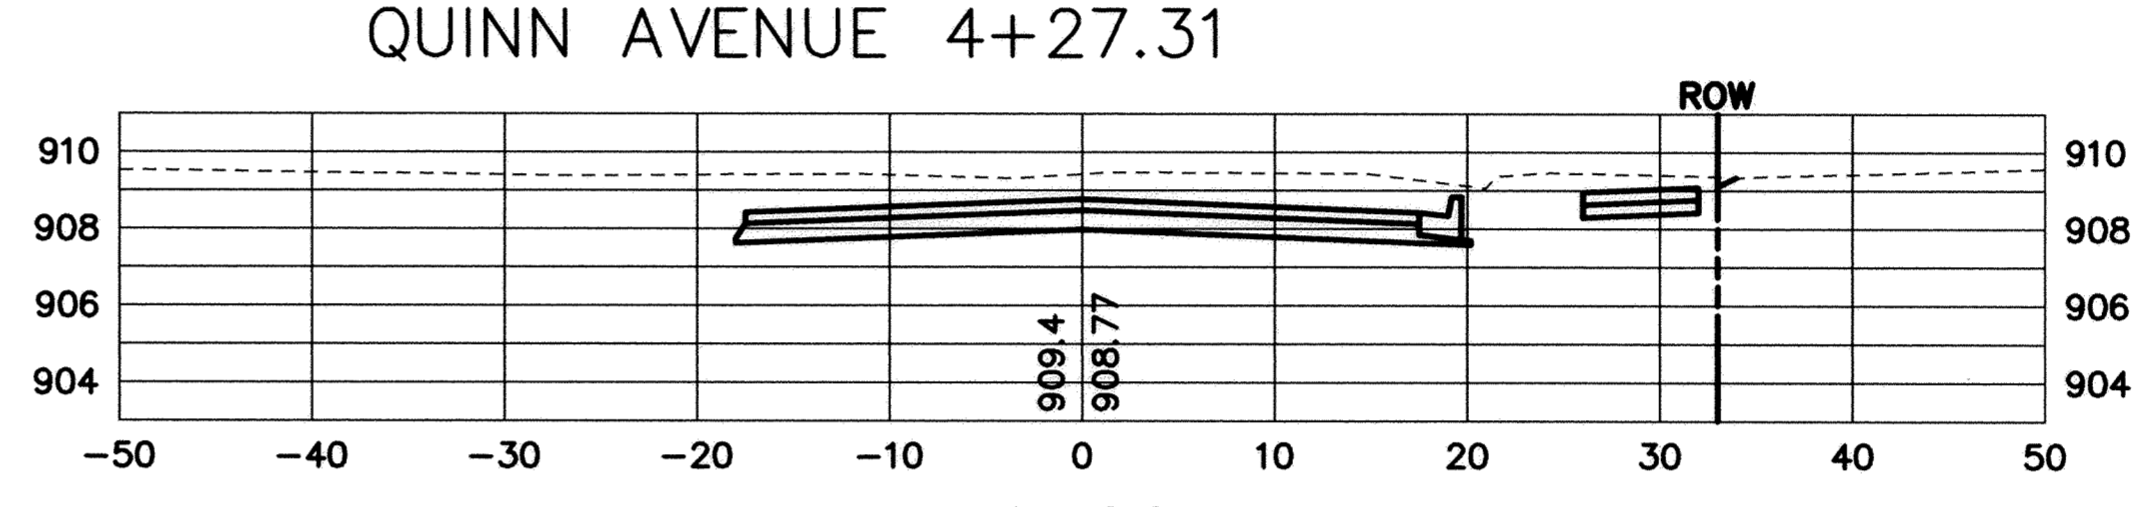
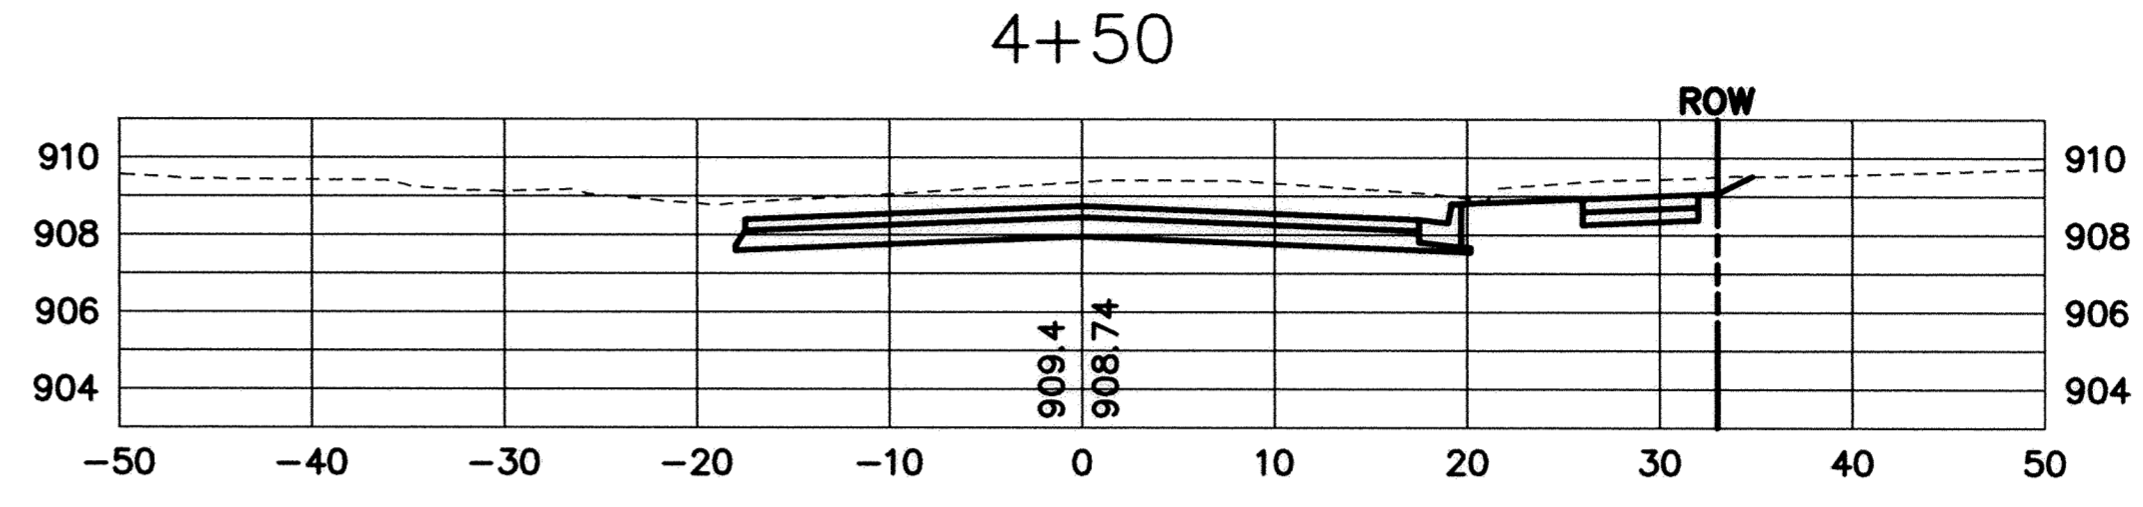
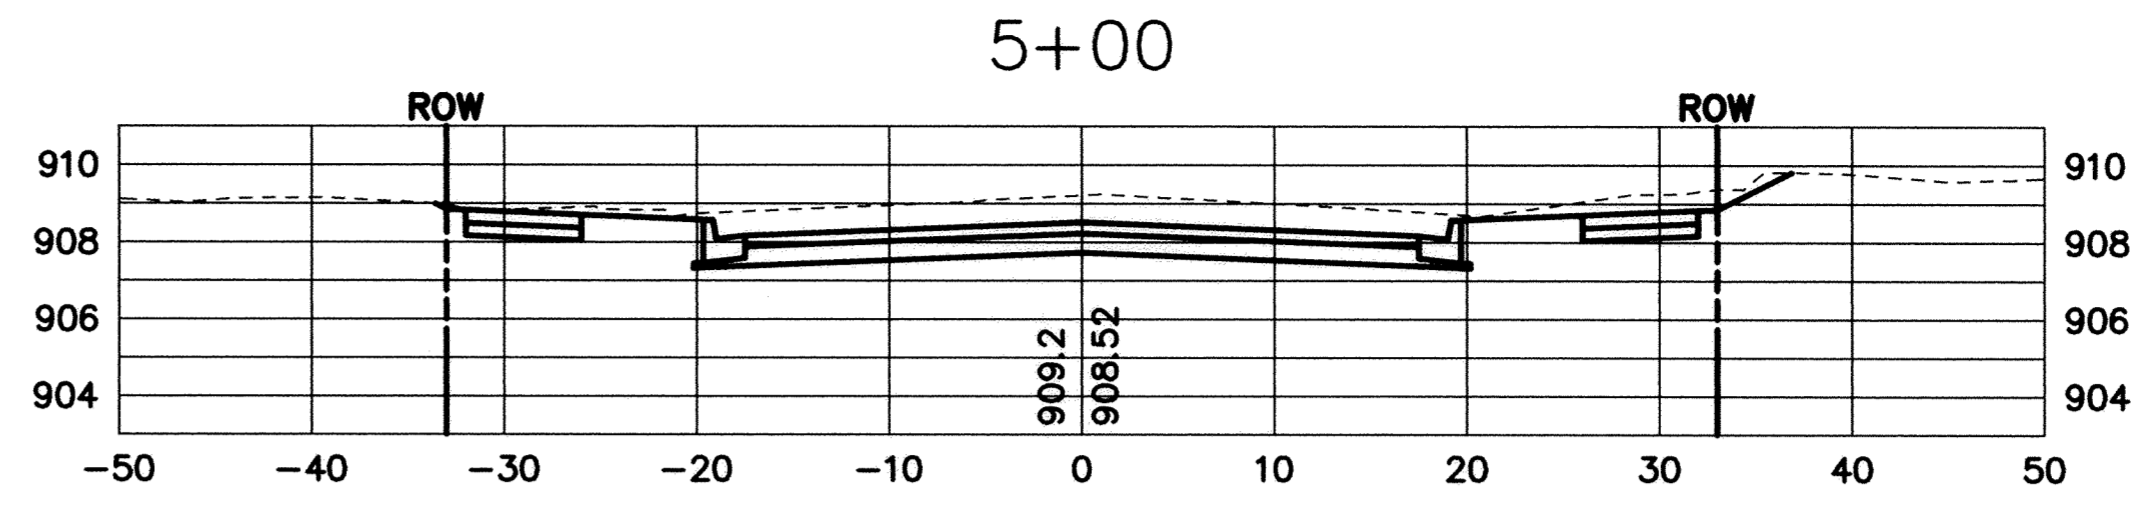
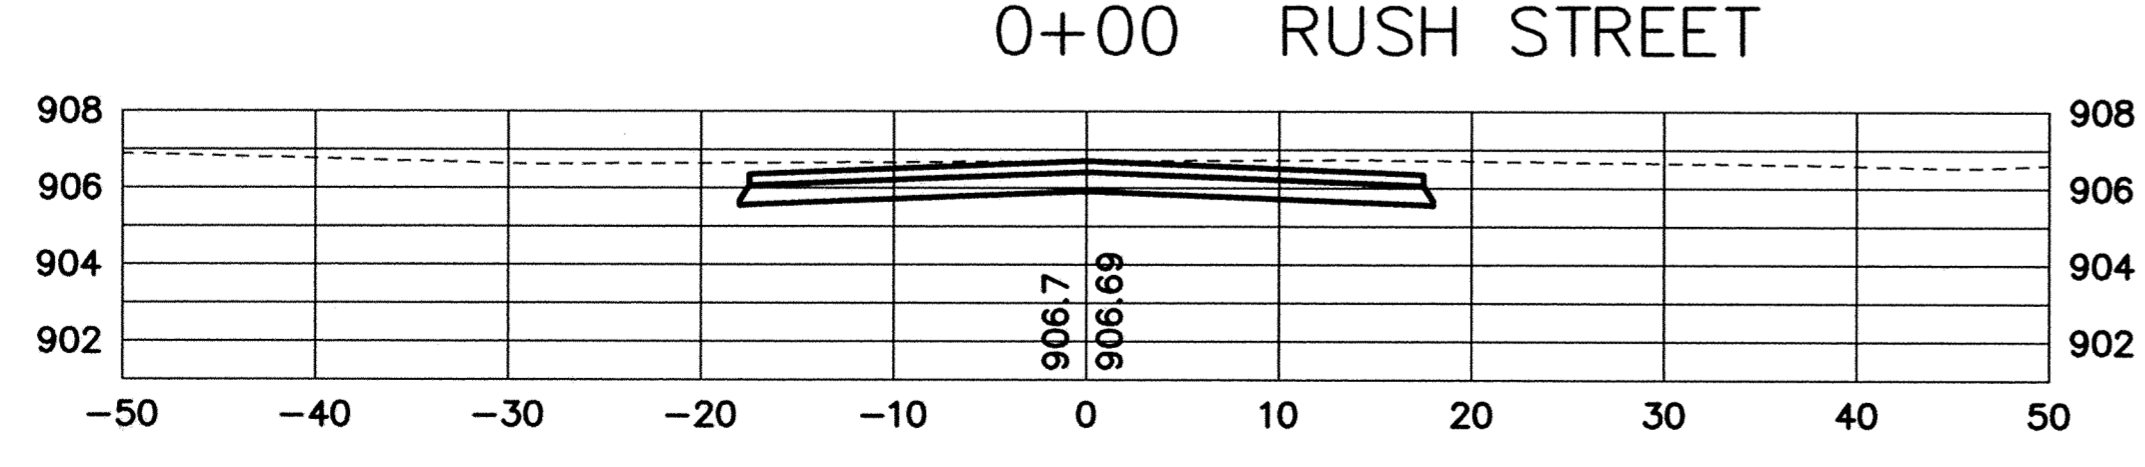
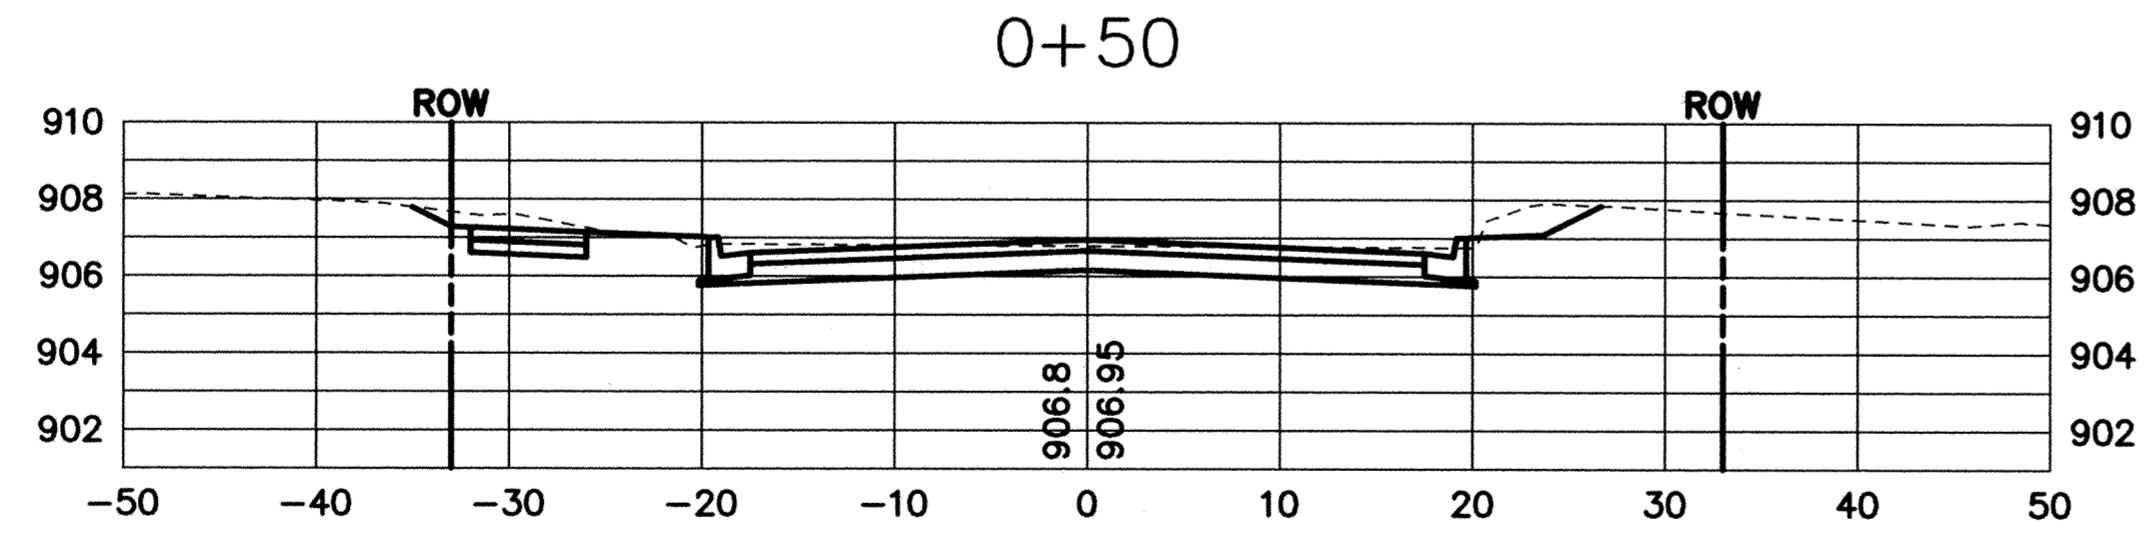
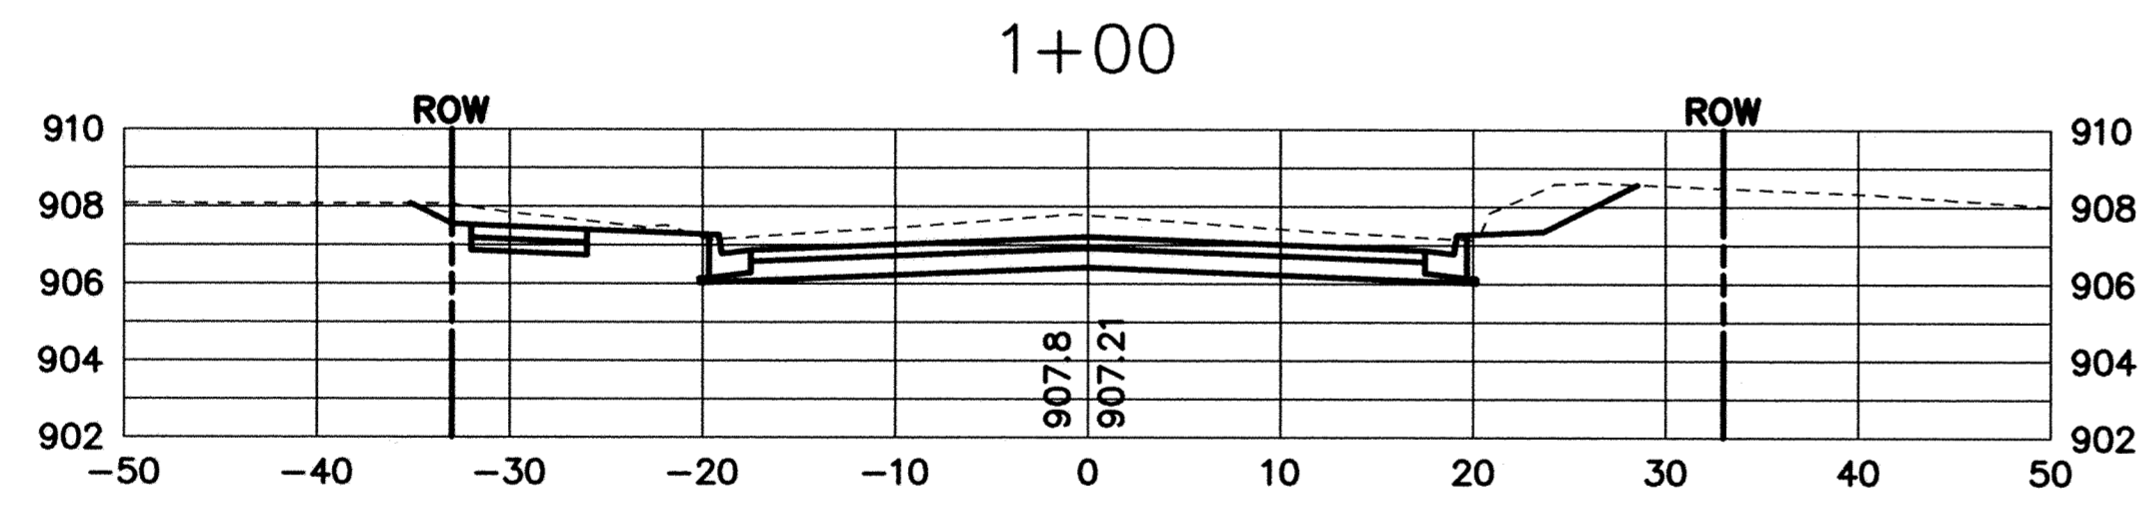
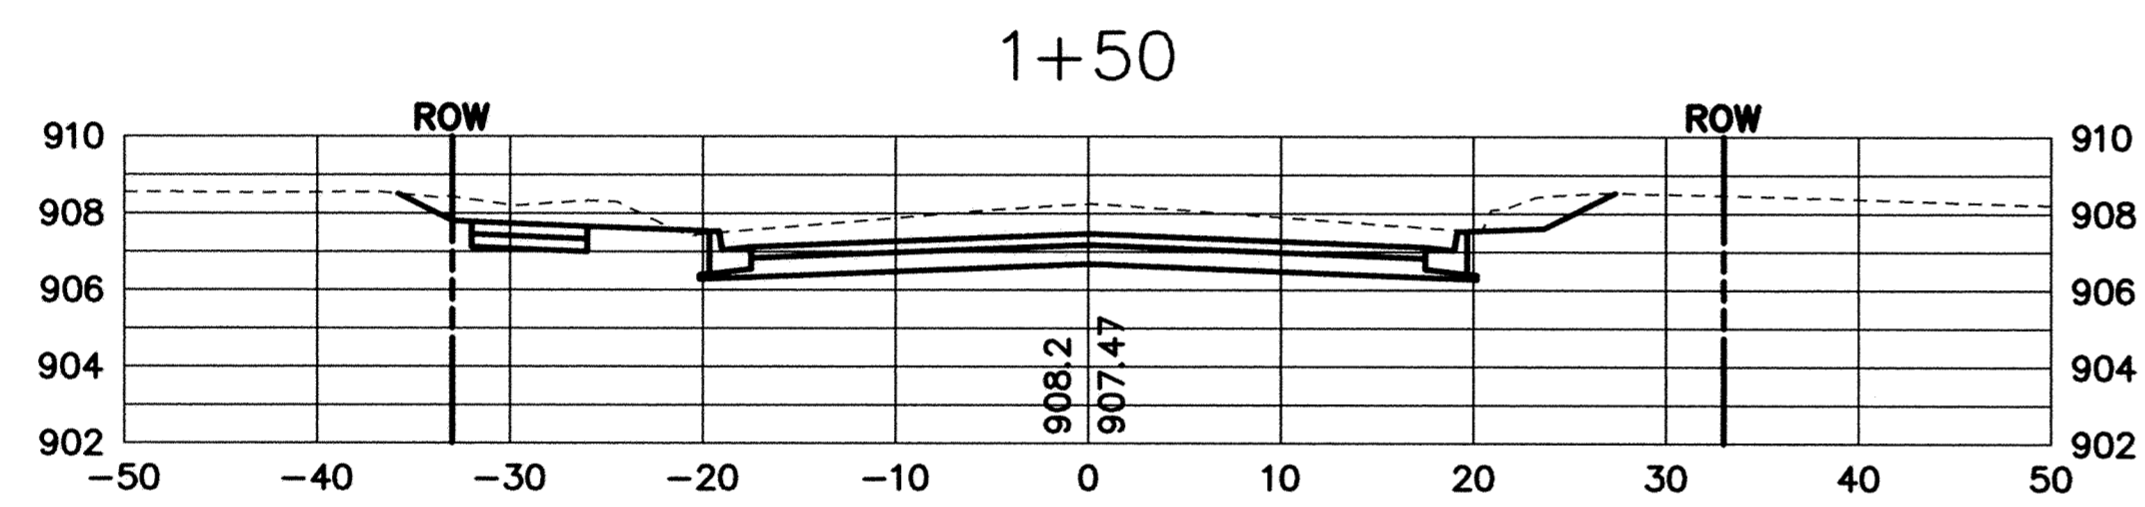
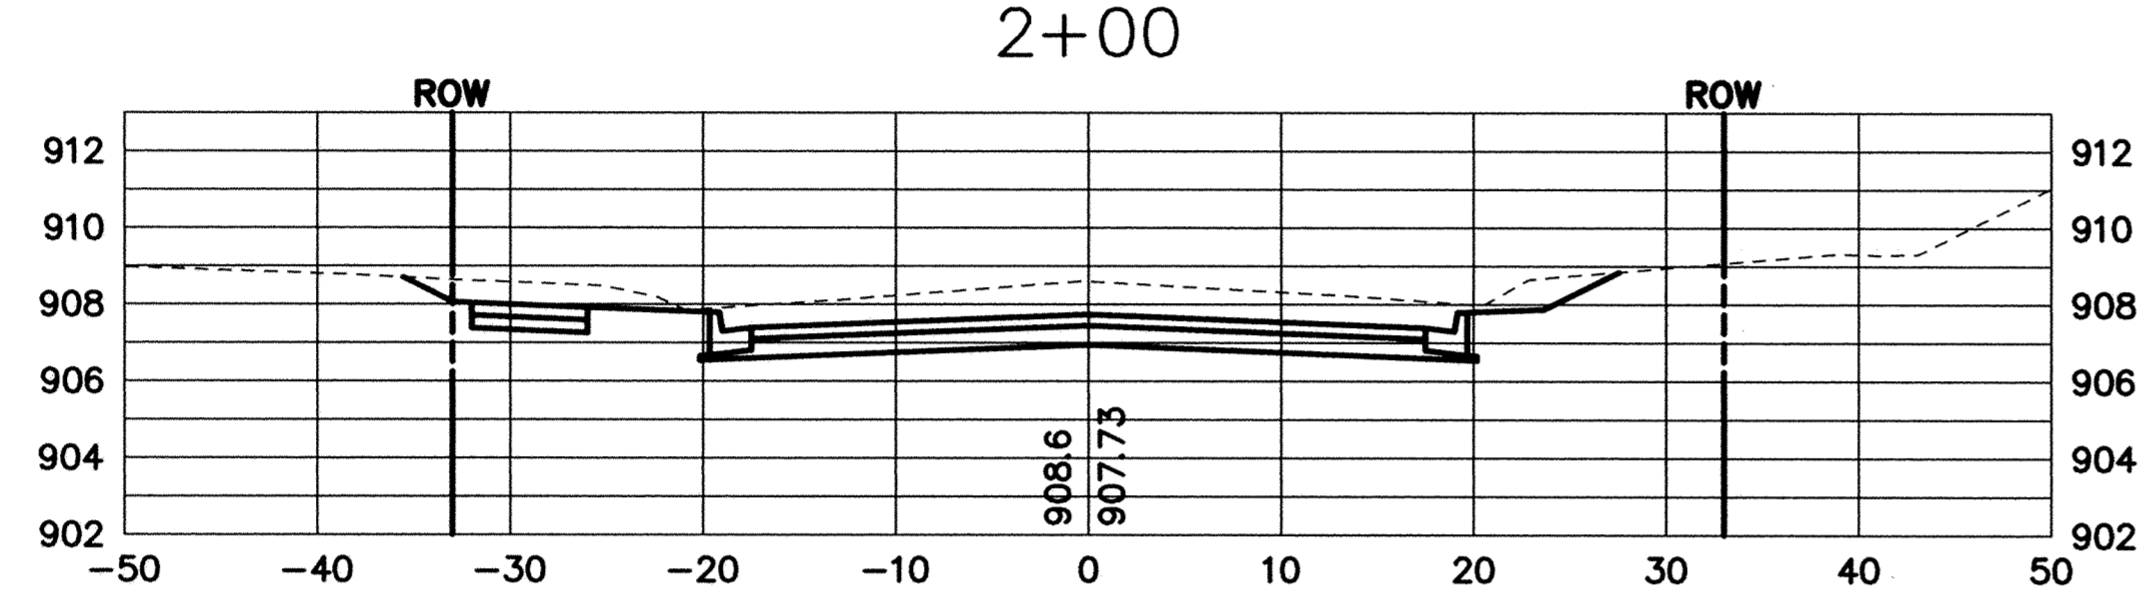


SACO PRODUCTS • NEW HOPE, MINNESOTA  
REVISIONS BY PART NUMBER 0000  
REVISIONS BY PART NUMBER 0000  
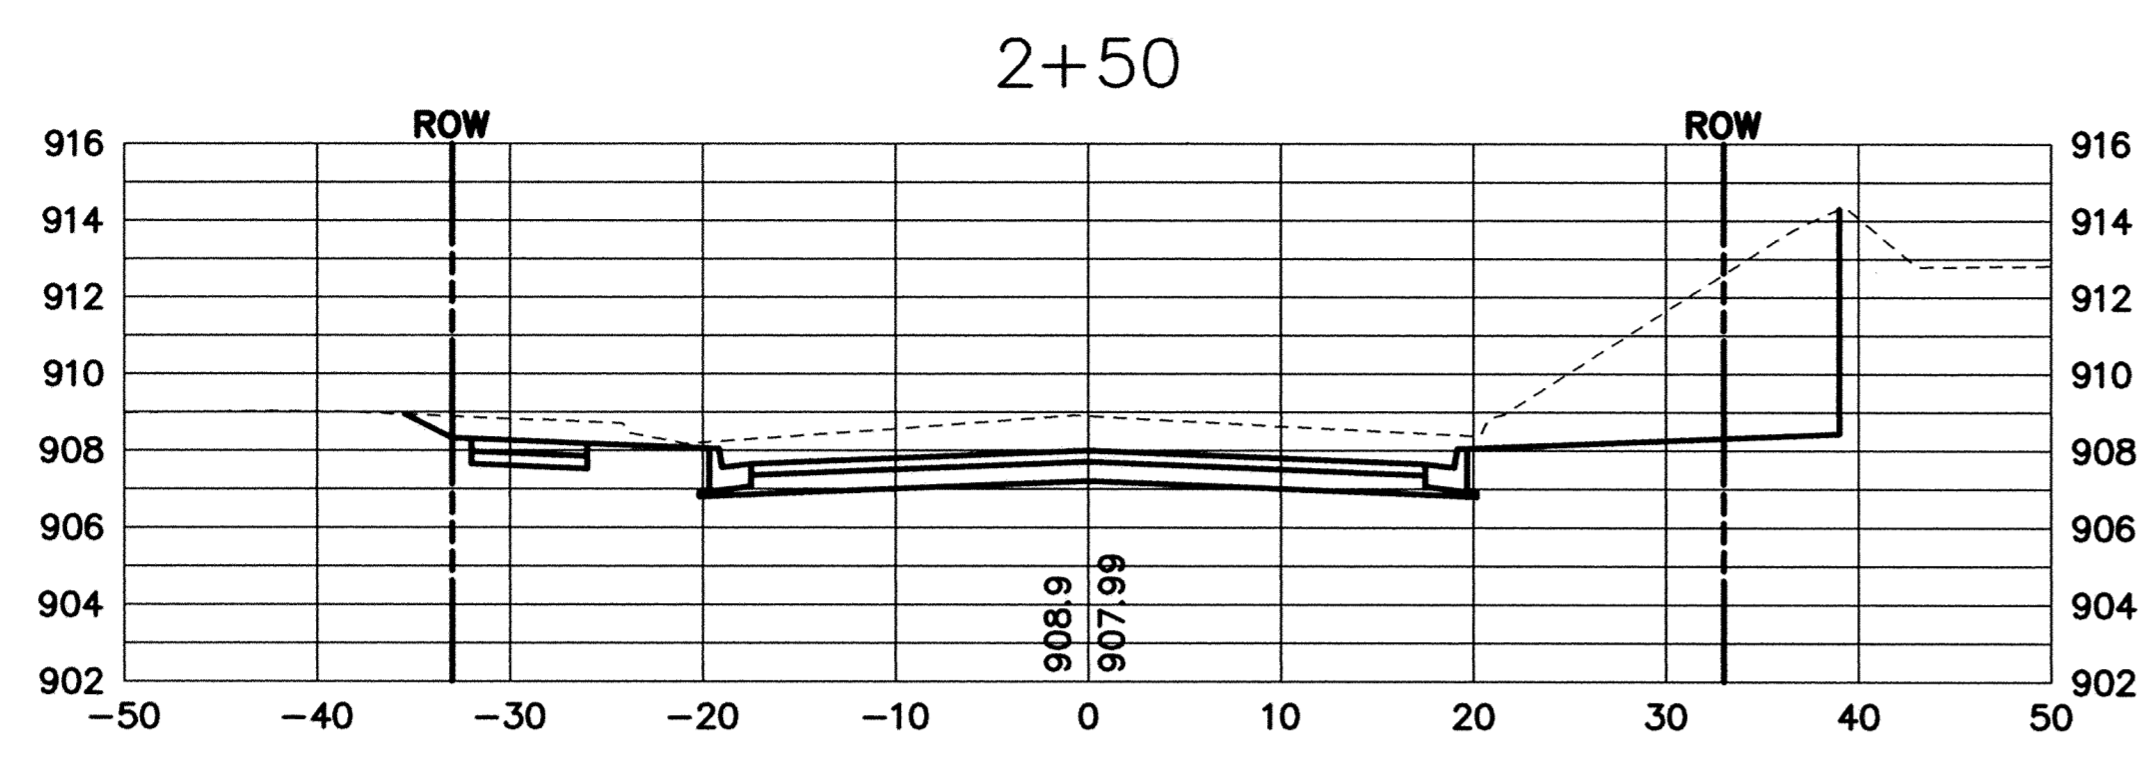


**RECORD PLAN**  
**APRIL 2004**

DESIGNED BY: DESIGNED BY DRAWN BY: RKM  
 APPROVED BY: APPROVED BY JOB NUMBER 818980J  
 CAD DATE: April 21, 2003 2:20:03 p.m.  
 CAD FILE: 818980J\dwg\c\CT-X01.DWG (RMONJEA)

I HEREBY CERTIFY THAT THIS PLAN, SPECIFICATION, OR REPORT WAS PREPARED BY ME OR UNDER MY DIRECT SUPERVISION AND THAT I AM A DULY LICENSED PROFESSIONAL ENGINEER UNDER THE LAWS OF THE STATE OF MINNESOTA.  
 SIGNATURE \_\_\_\_\_ DATE \_\_\_\_\_  
 PRINTED NAME KRISTINA J THOMPSON LIC. NO. 42350

NO.	DATE	BY	REVISION DESCRIPTION

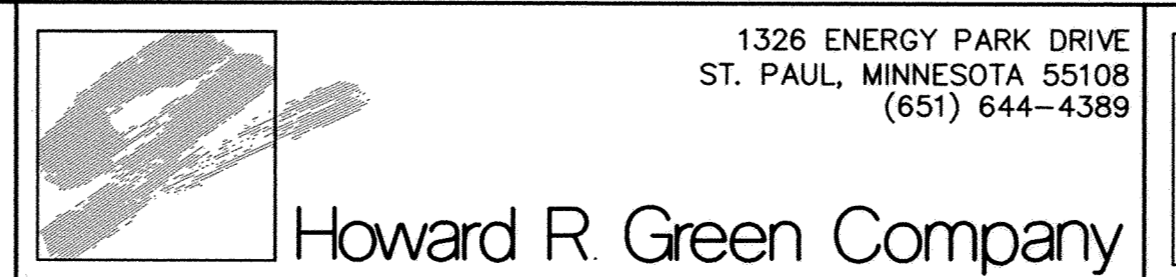

**2003 STREET IMPROVEMENTS**  
**CITY OF ELK RIVER**

**CROSS SECTIONS**  
**FOURTH STREET**  
**0+00 TO 5+00**

SHEET NO.  
**25**