
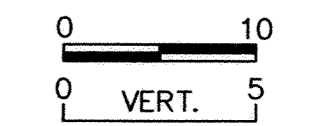
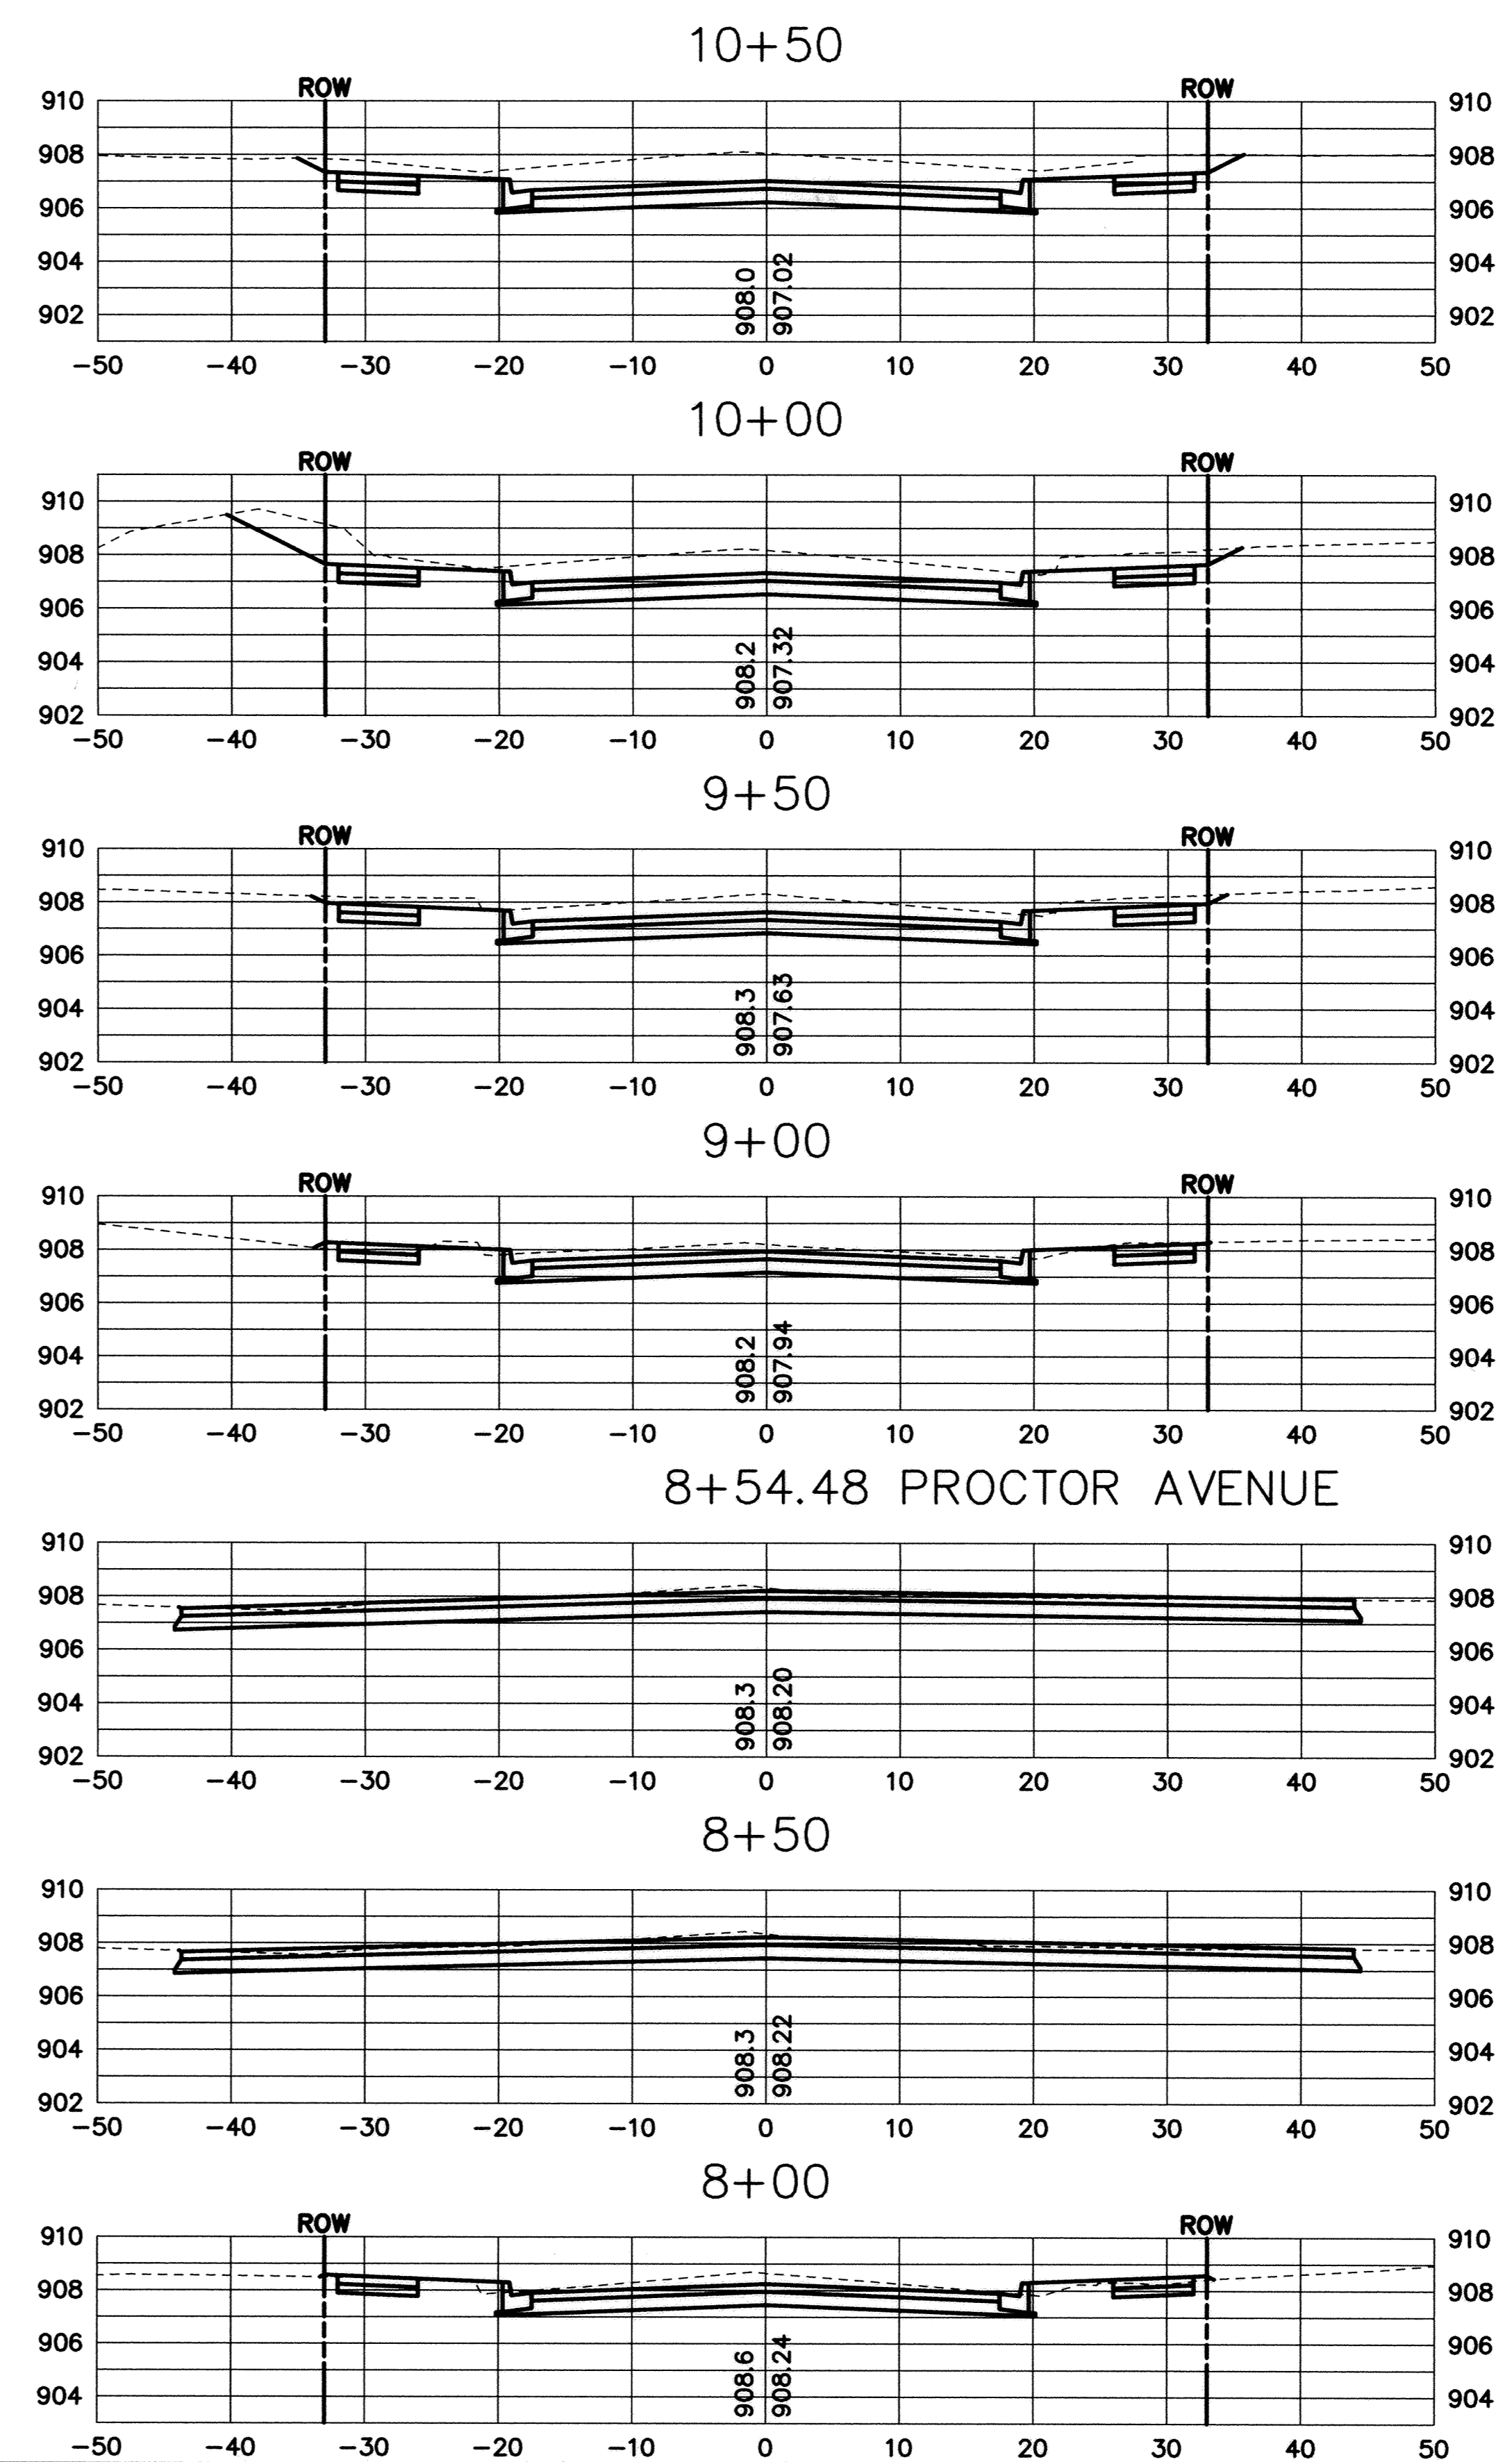


SAICO PRODUCTS • NEW HOPE, MINNESOTA  
REORDER BY PART NUMBER 8555  
SAICO PRODUCTS • NEW HOPE, MINNESOTA  
REORDER BY PART NUMBER 8555  
SAICO PRODUCTS • NEW HOPE, MINNESOTA  
REORDER BY PART NUMBER 8555  
SAICO PRODUCTS • NEW HOPE, MINNESOTA  
REORDER BY PART NUMBER 8555

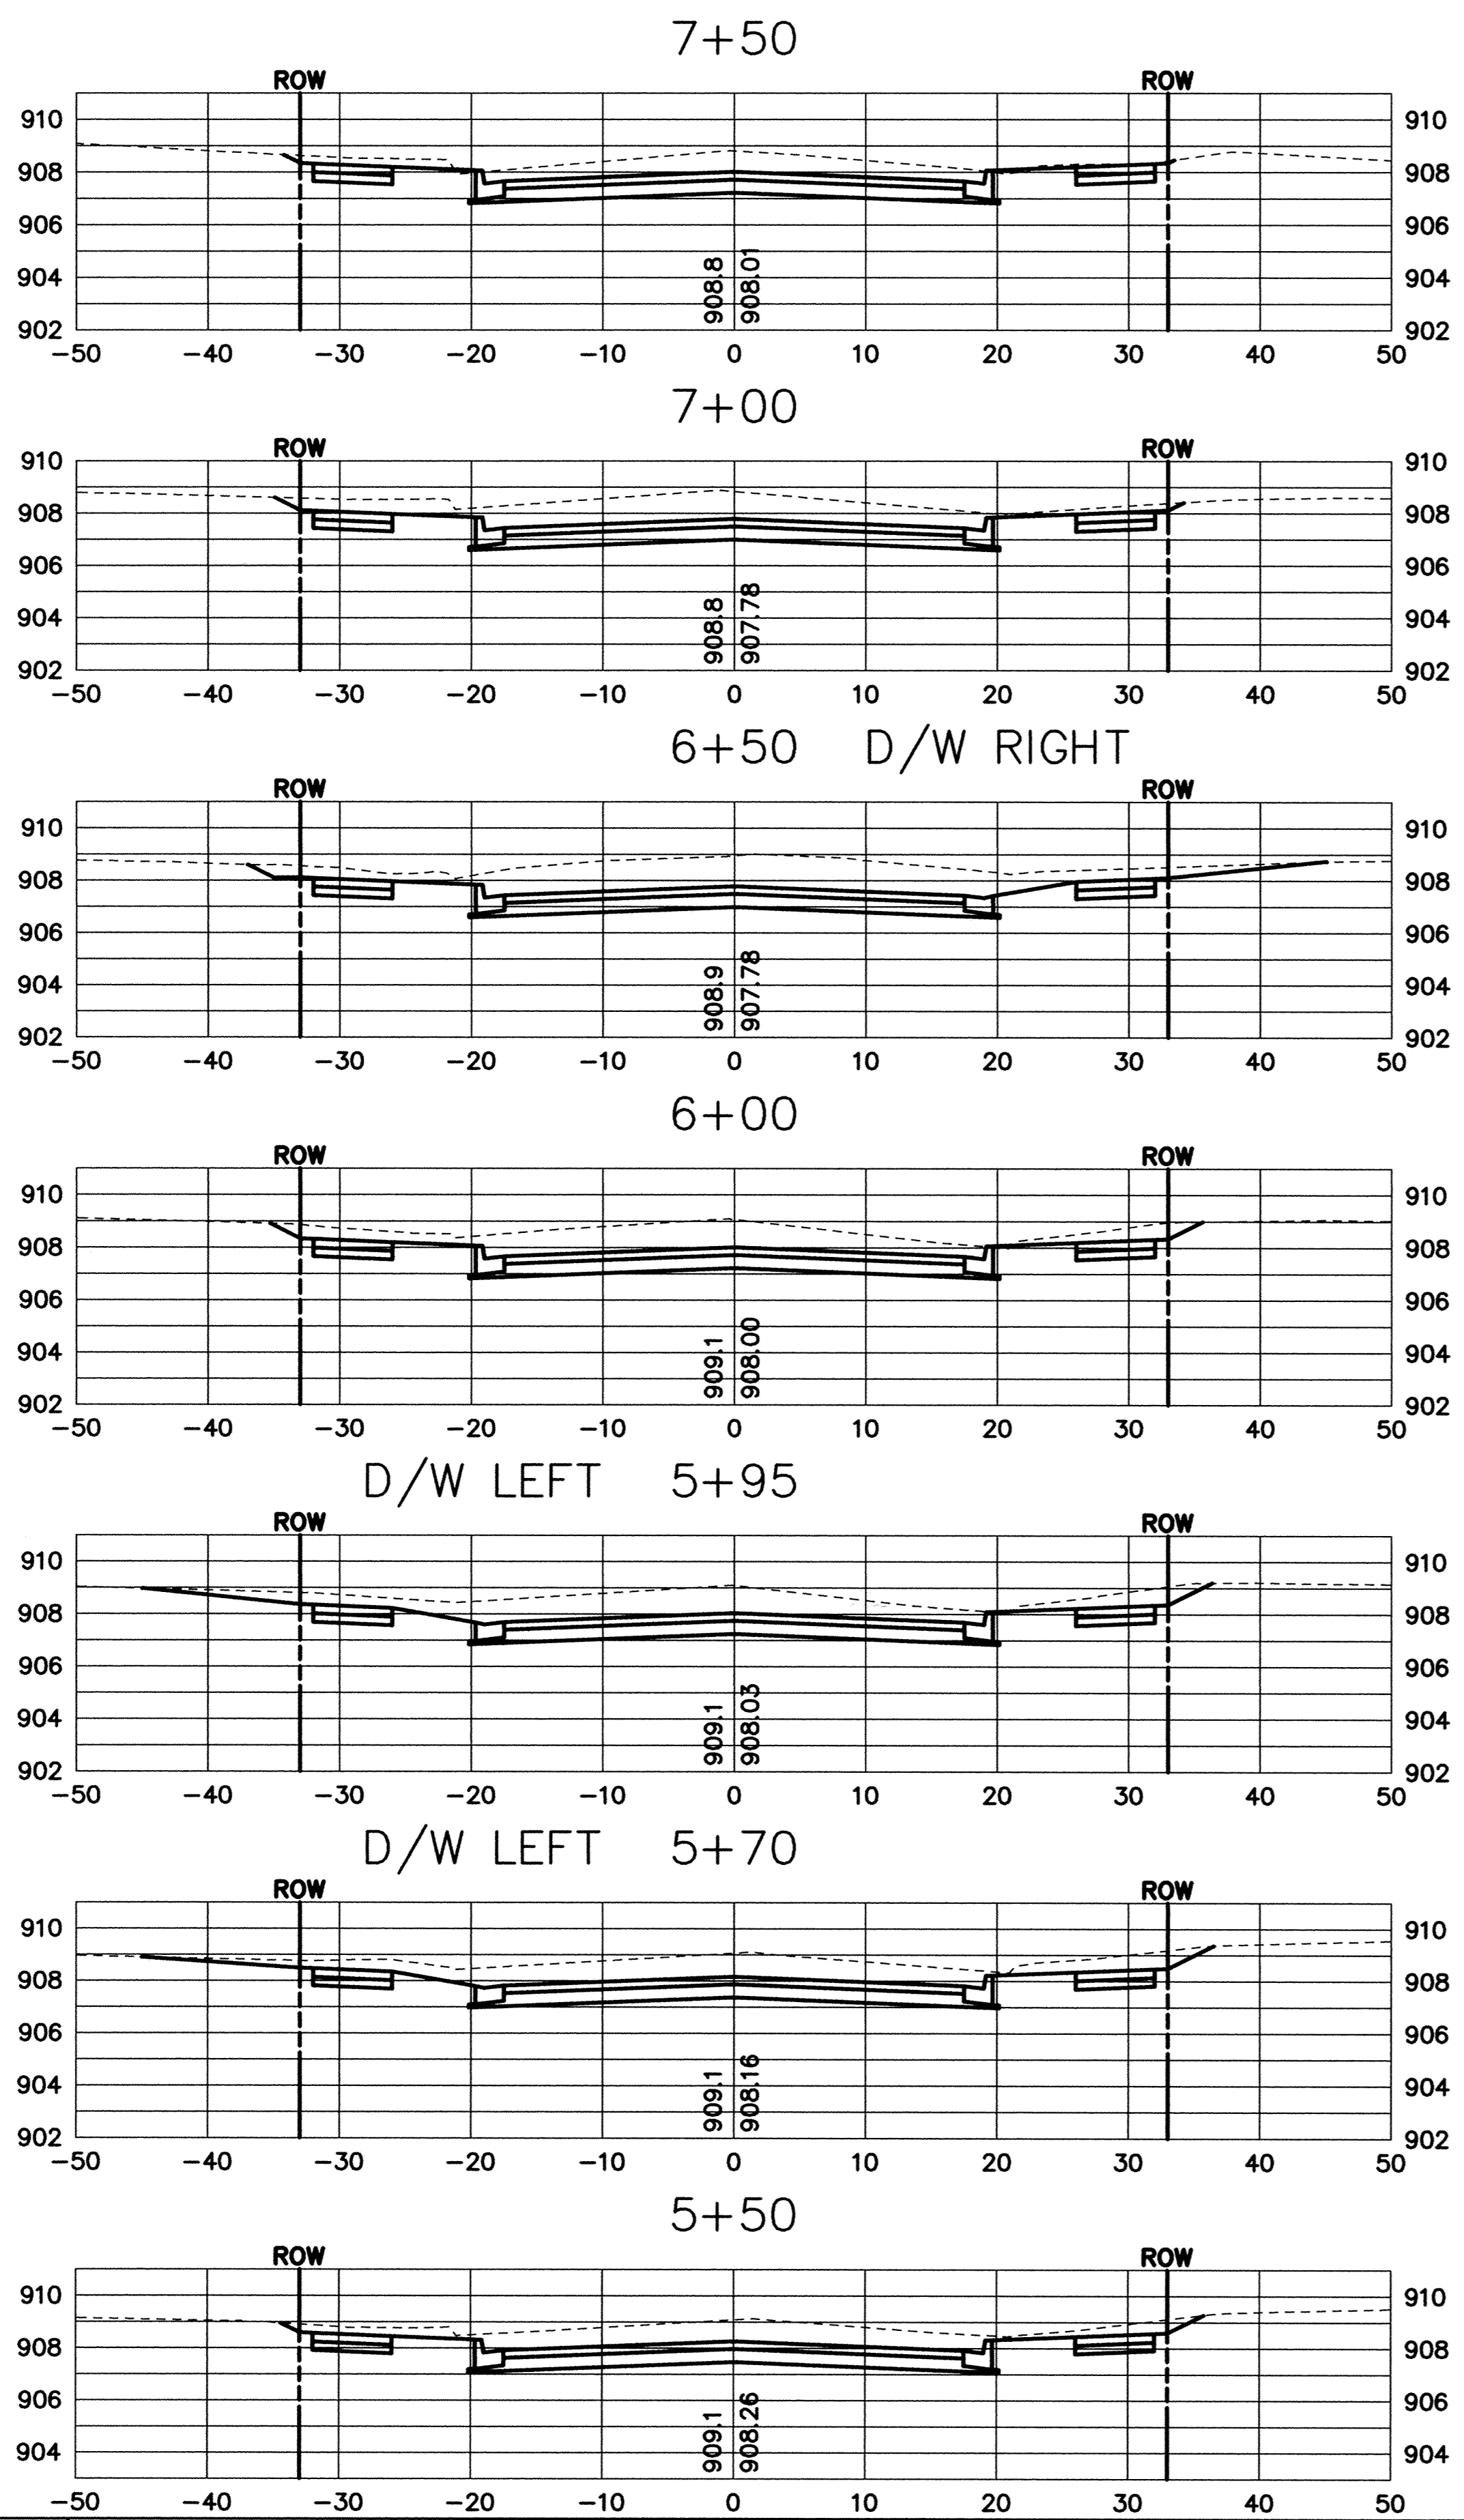

RECORD PLAN  
APRIL 2004

DESIGNED BY: DESIGNED BY: DRAWN BY: RKM  
 APPROVED BY: APPROVED BY: JOB NUMBER 818980J  
 CAD DATE: April 14, 2003 10:59:33 a.m.  
 CAD FILE: 818980J\Draw\C\CT-X02.DWG (RMONJEA)

I HEREBY CERTIFY THAT THIS PLAN, SPECIFICATION, OR REPORT WAS PREPARED BY ME OR UNDER MY DIRECT SUPERVISION AND THAT I AM A DULY LICENSED PROFESSIONAL ENGINEER UNDER THE LAWS OF THE STATE OF MINNESOTA.

SIGNATURE \_\_\_\_\_ DATE \_\_\_\_\_  
 PRINTED NAME KRISTINA J THOMPSON LIC. NO. 42350

NO.	DATE	BY	REVISION DESCRIPTION

1326 ENERGY PARK DRIVE  
 ST. PAUL, MINNESOTA 55108  
 (651) 644-4389

Howard R. Green Company

2003 STREET IMPROVEMENTS  
 CITY OF ELK RIVER

CROSS SECTIONS  
 FOURTH STREET  
 5+50 TO 10+50

SHEET NO.  
**26**

DRAWING NUMBER  
 '03IMPR 04  
 26