
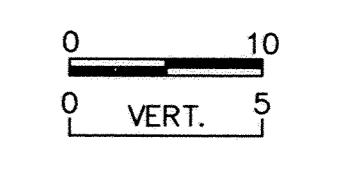
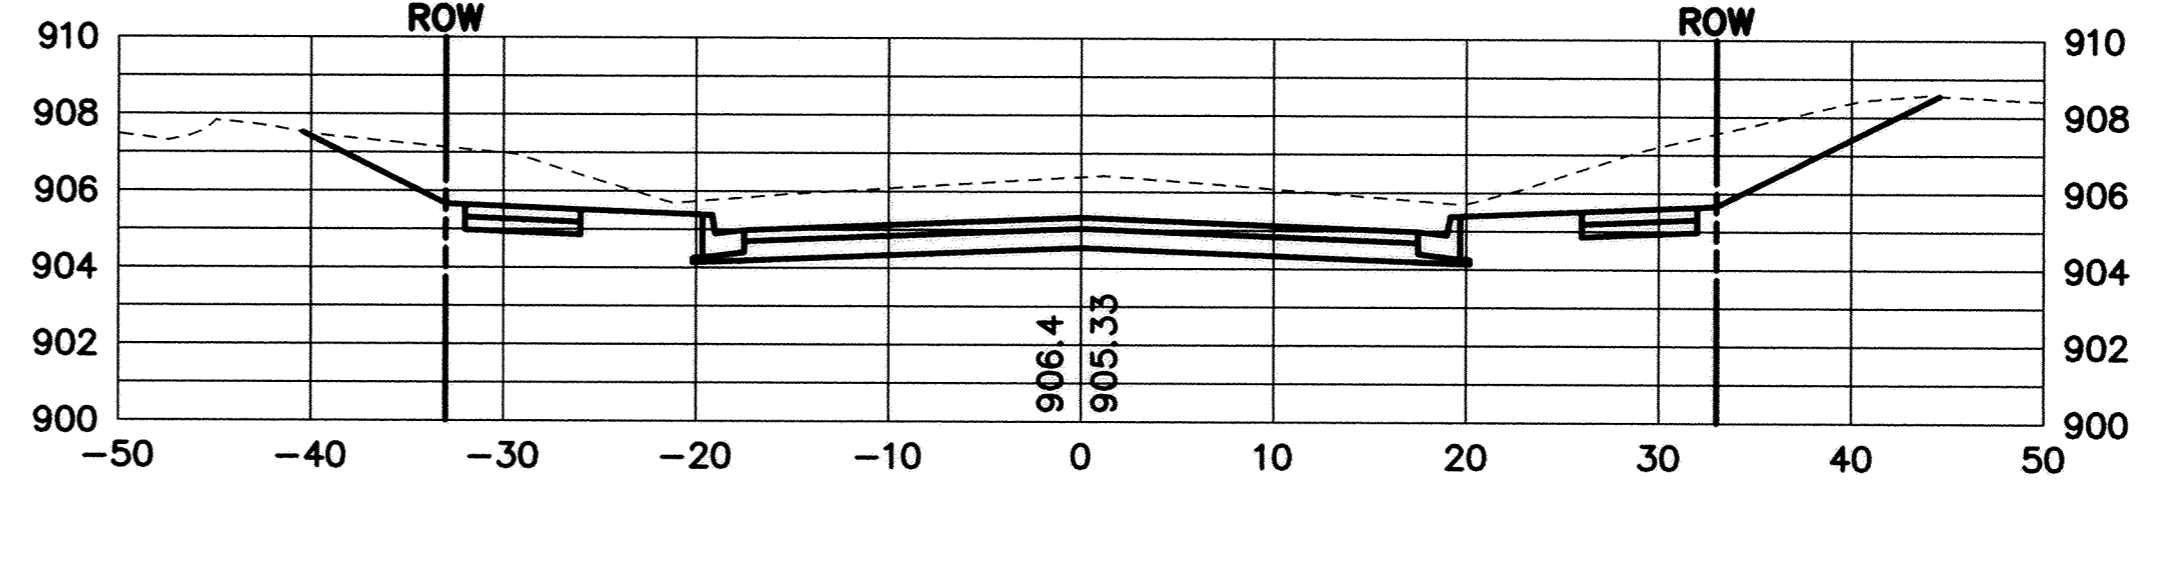
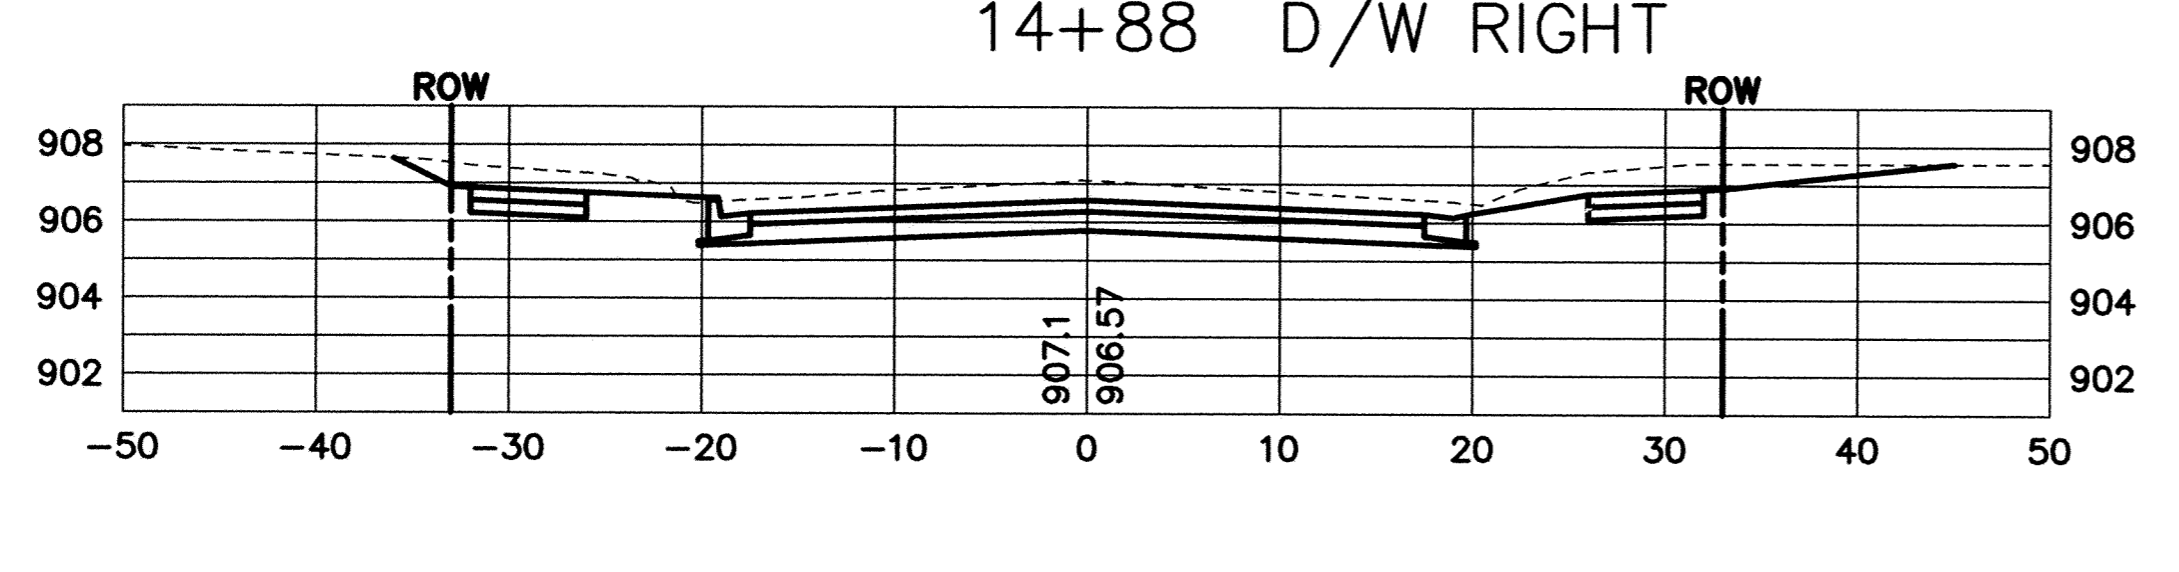
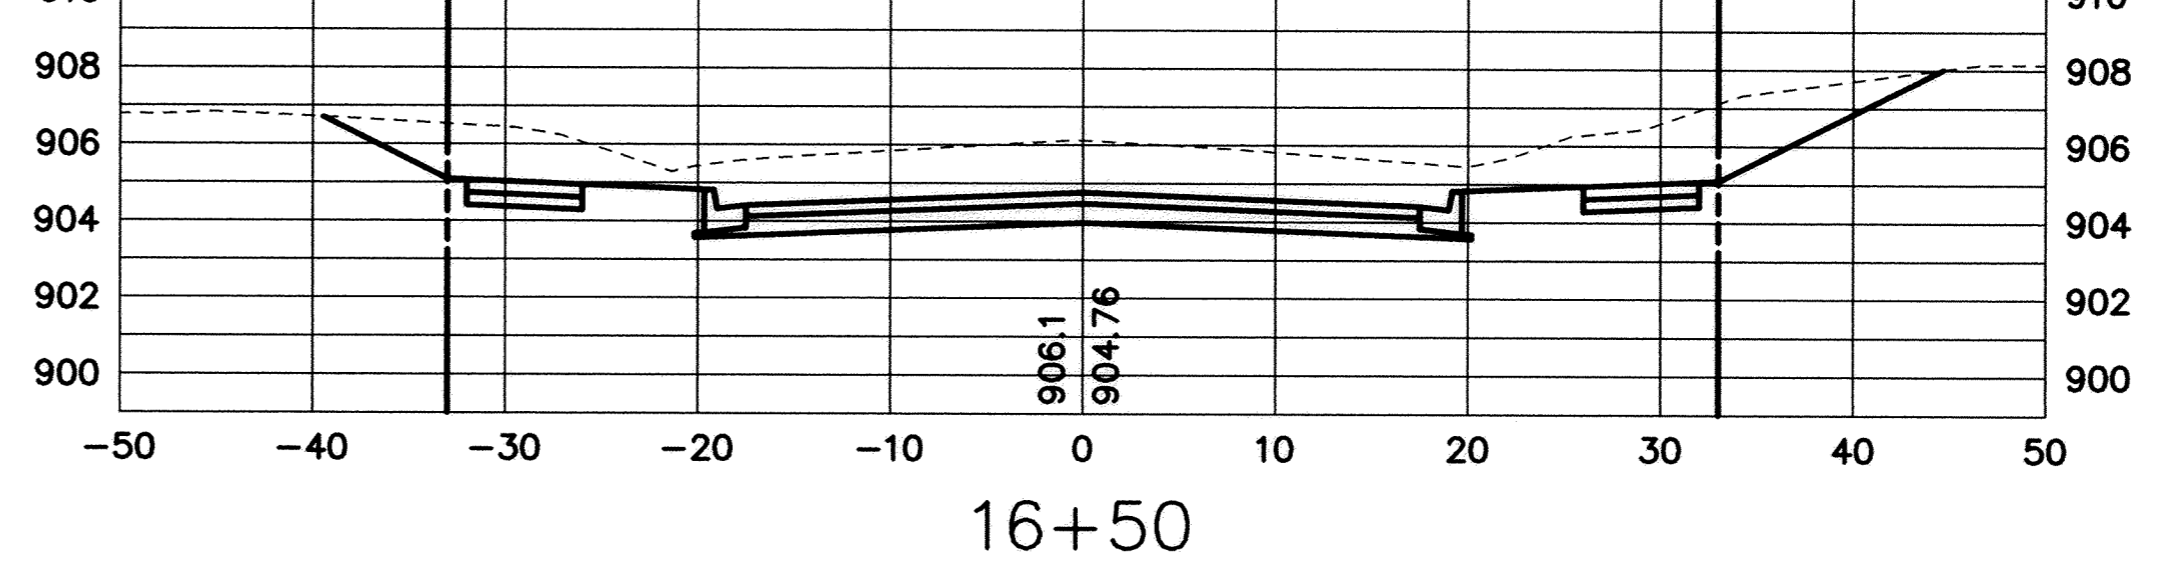
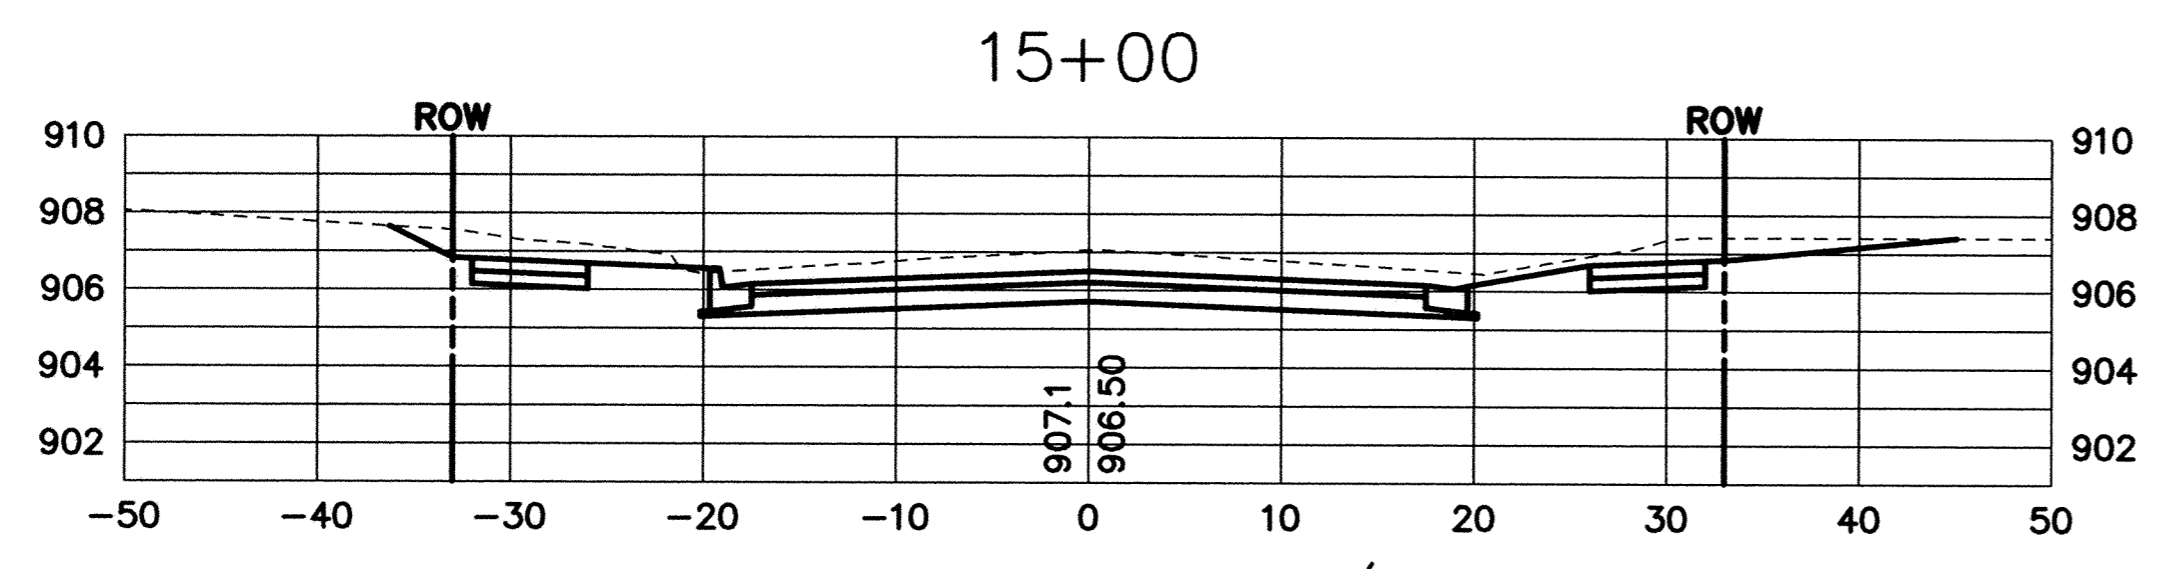
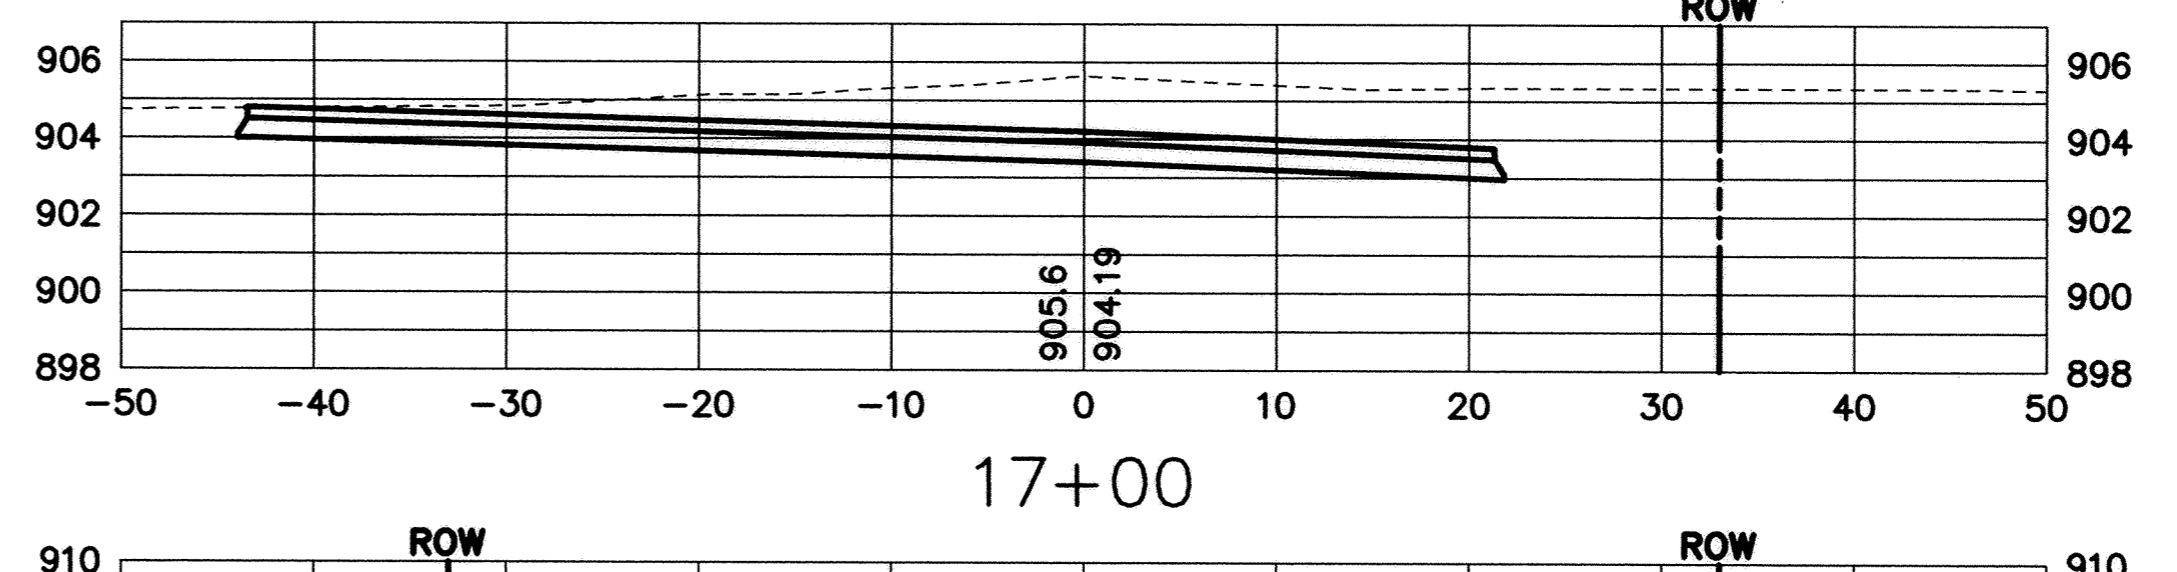
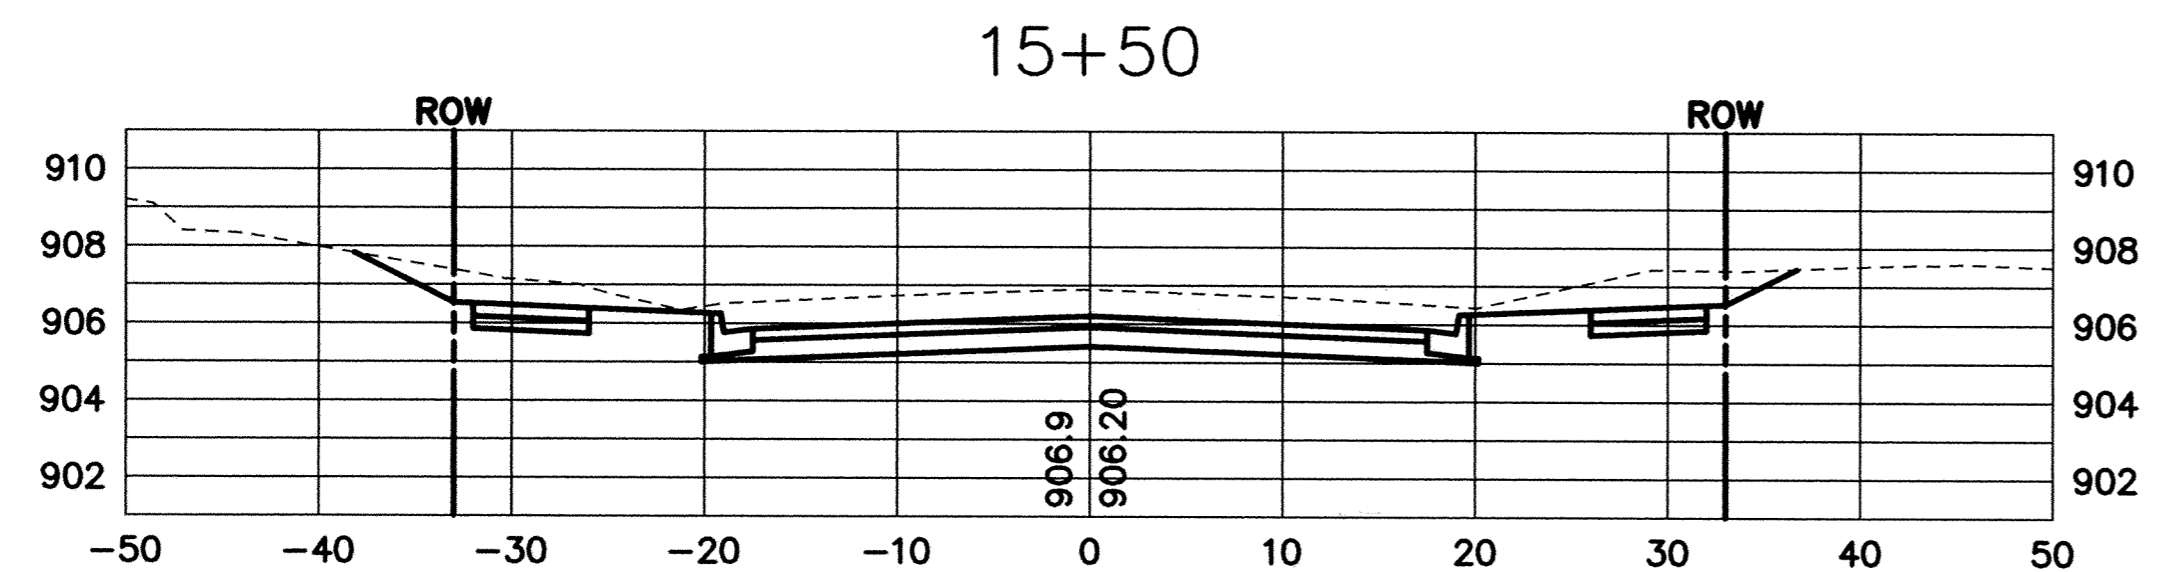
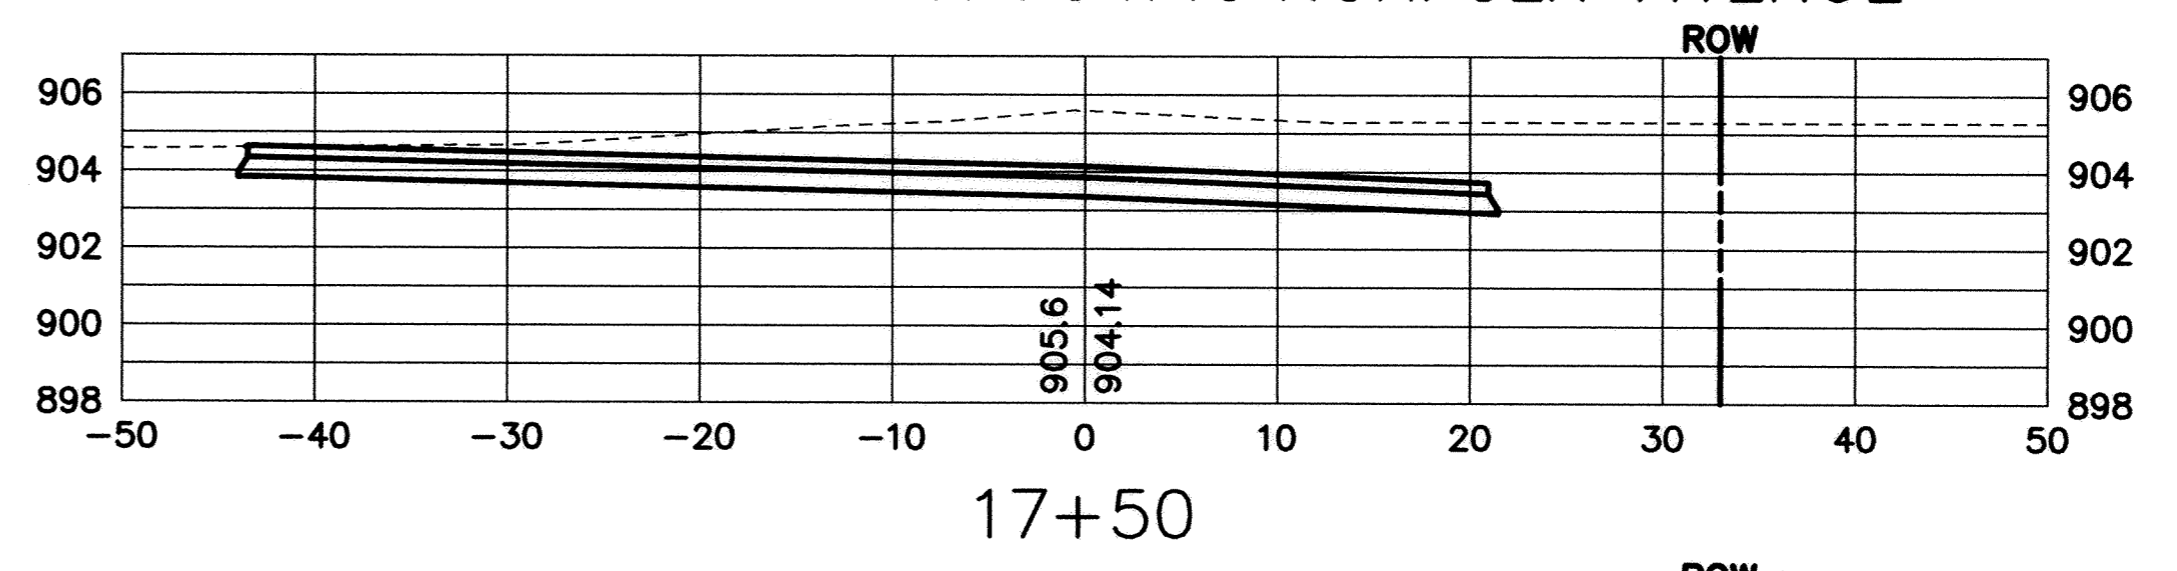
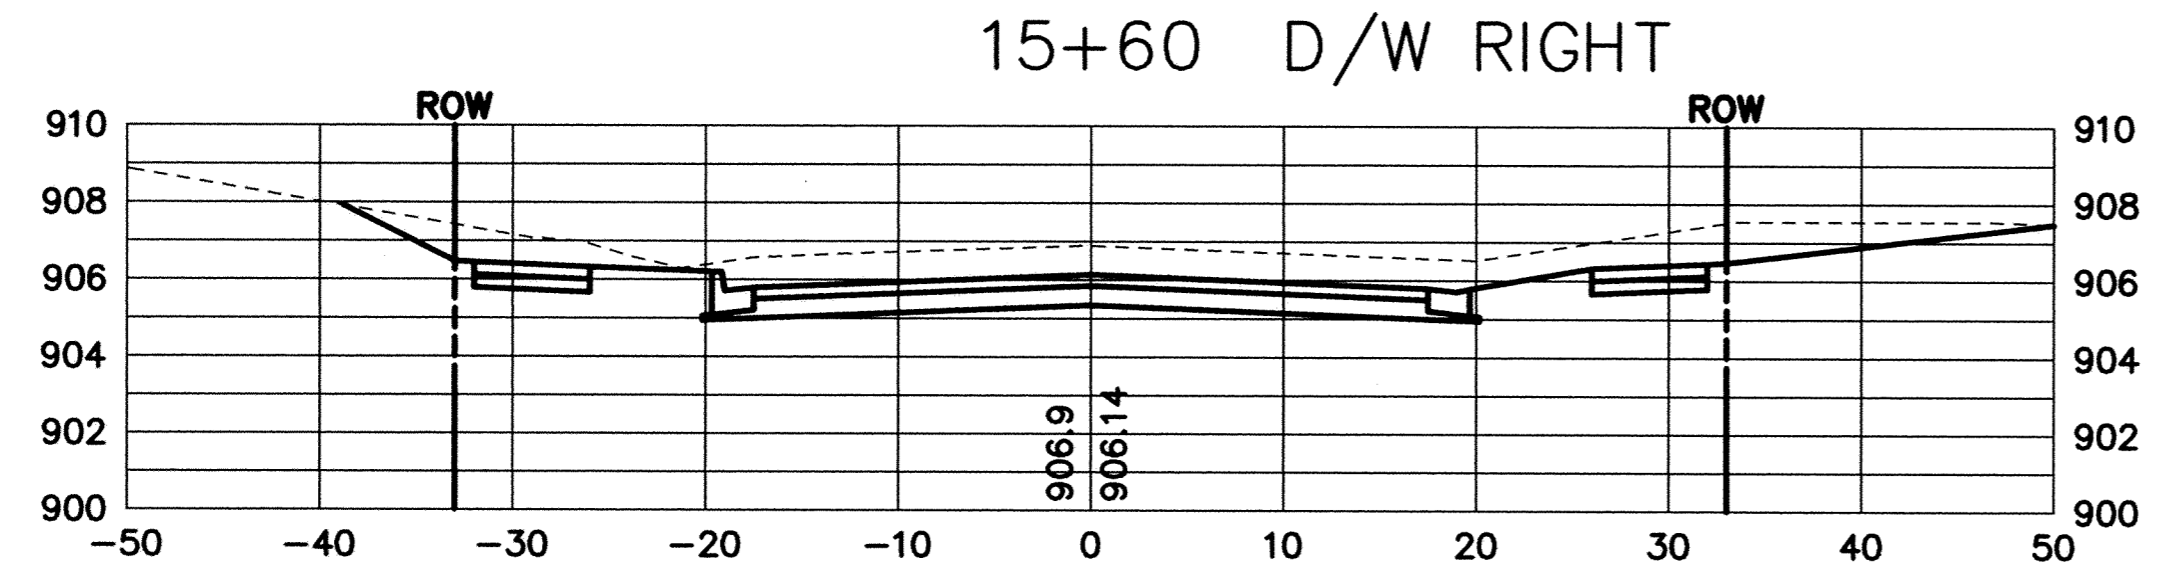
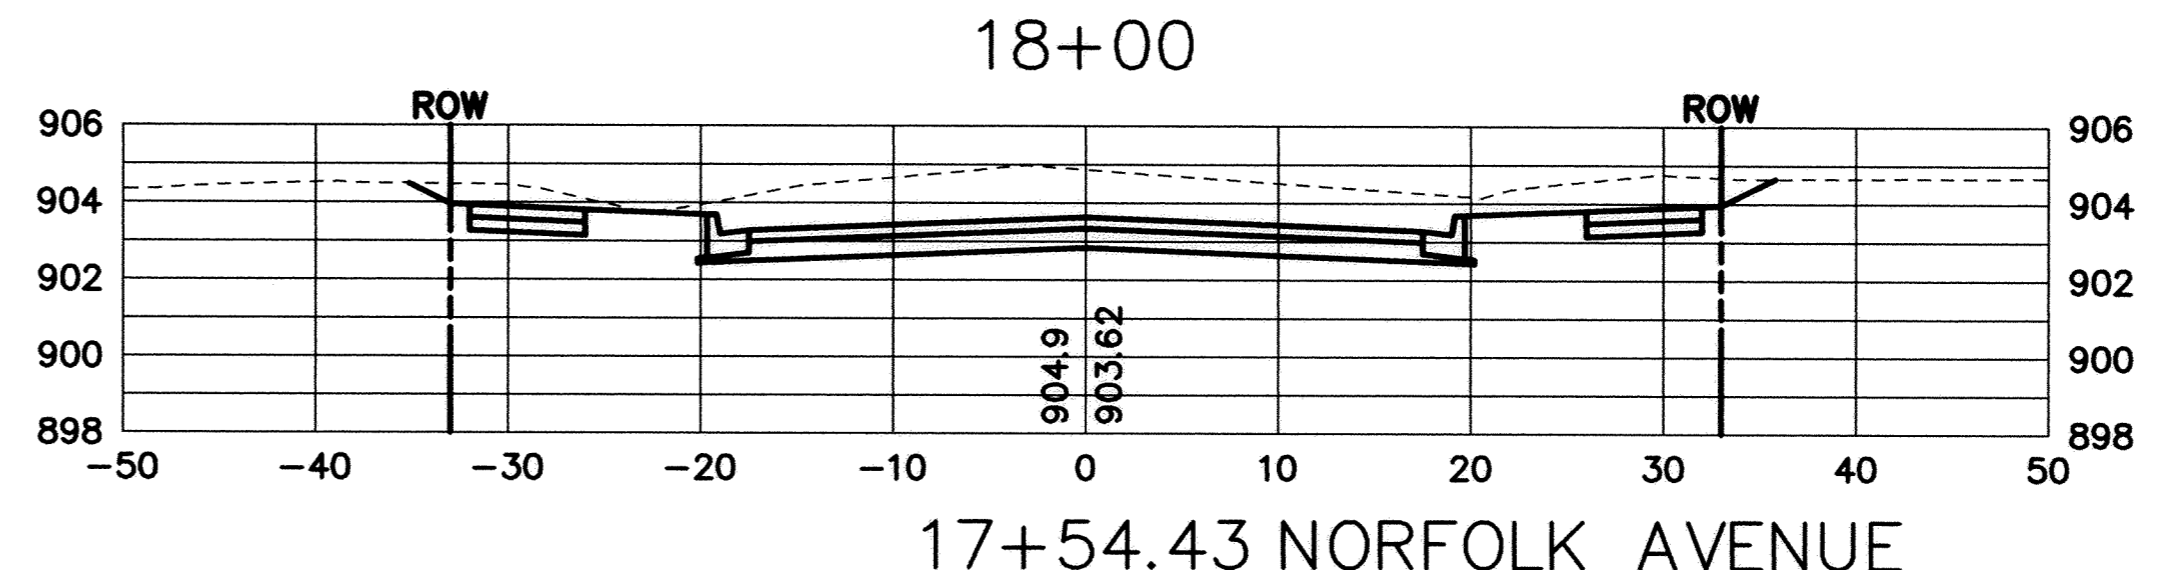
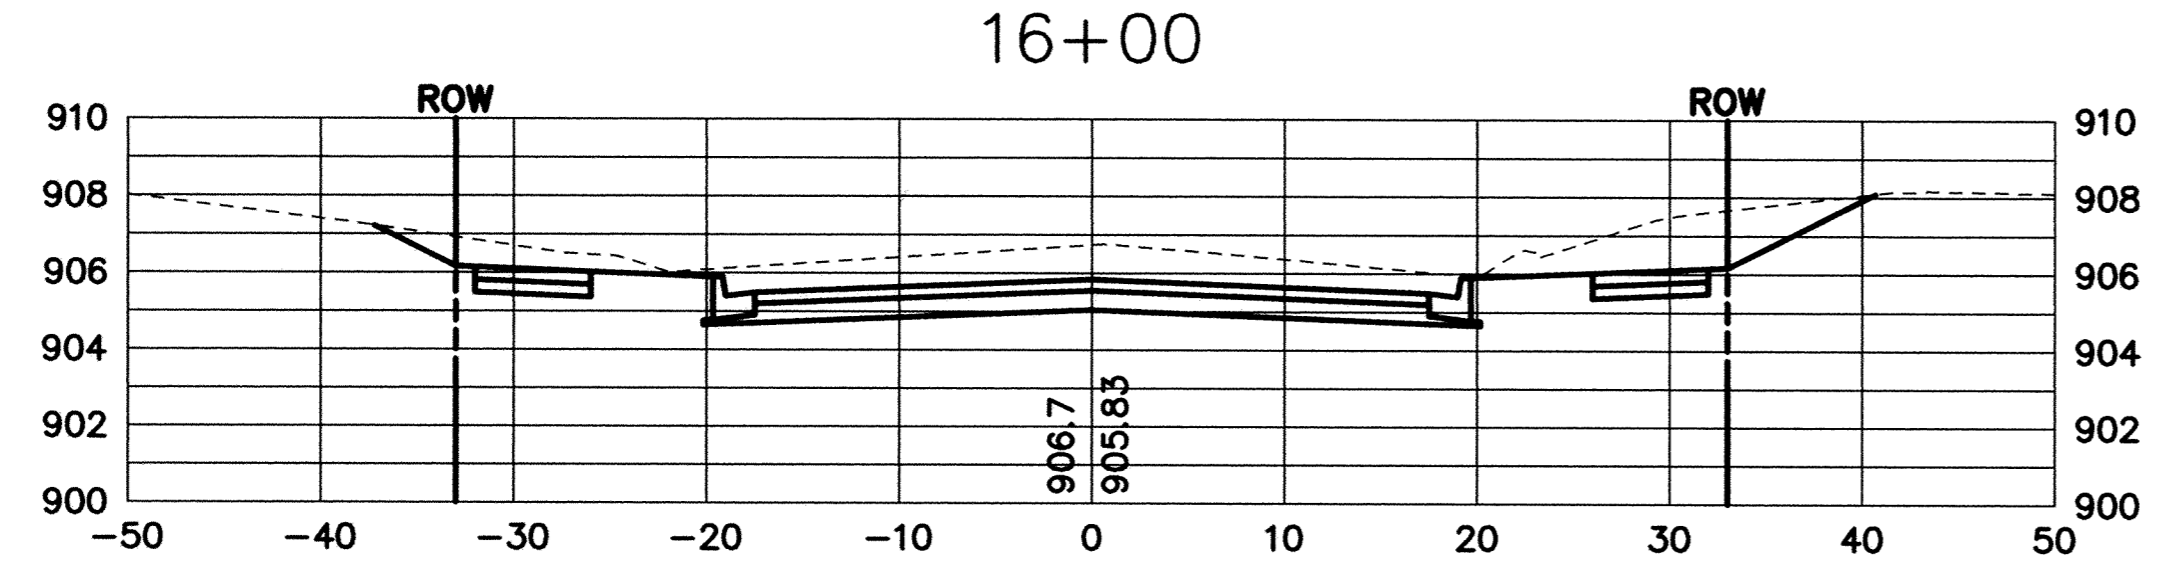
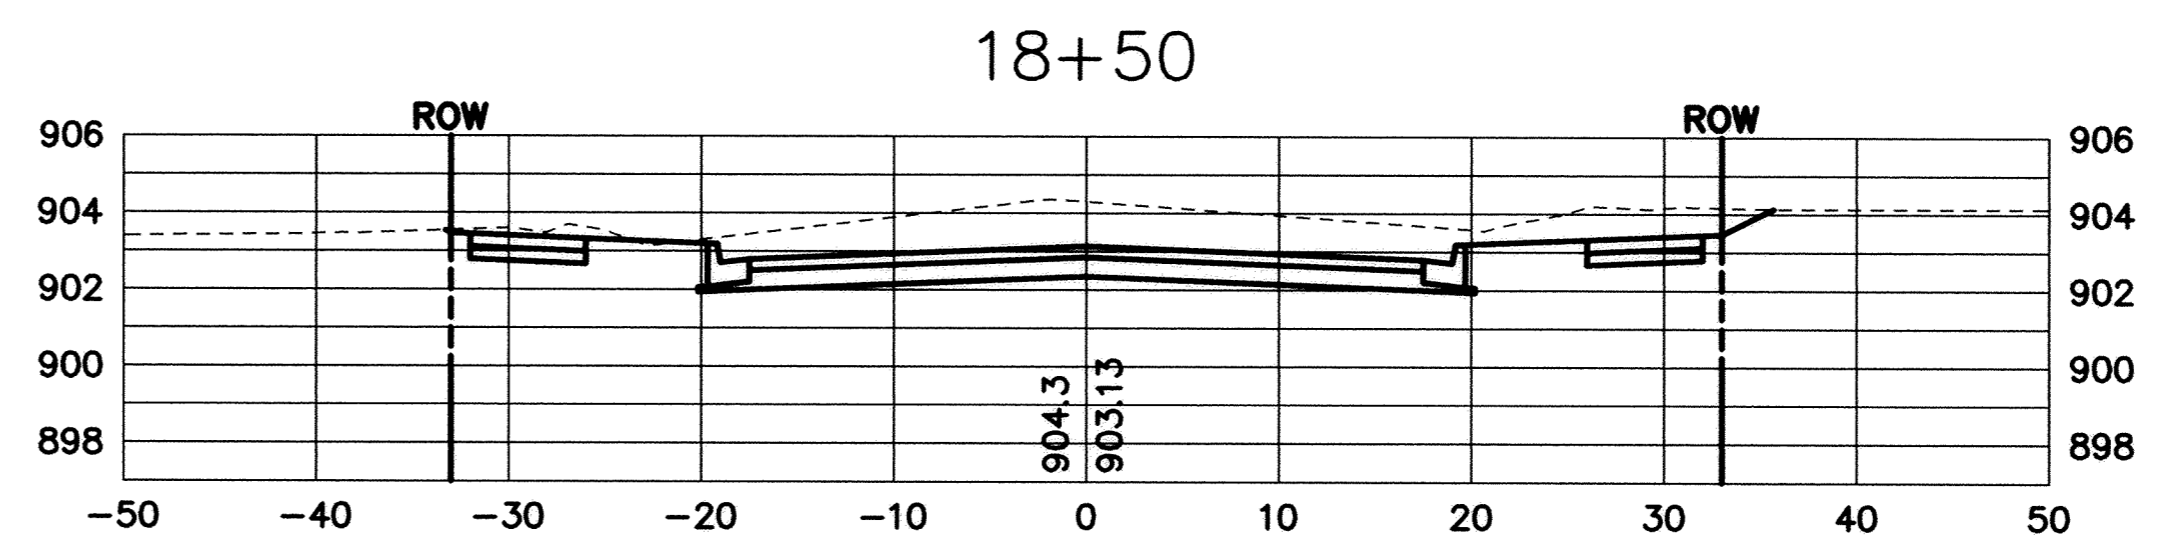


S&C/D PRODUCTS • NEW HOPE, MINNESOTA
PROJECT BY PART NUMBER 8532
REVISIONS: 1. 04/14/04
2. 04/14/04
3. 04/14/04
4. 04/14/04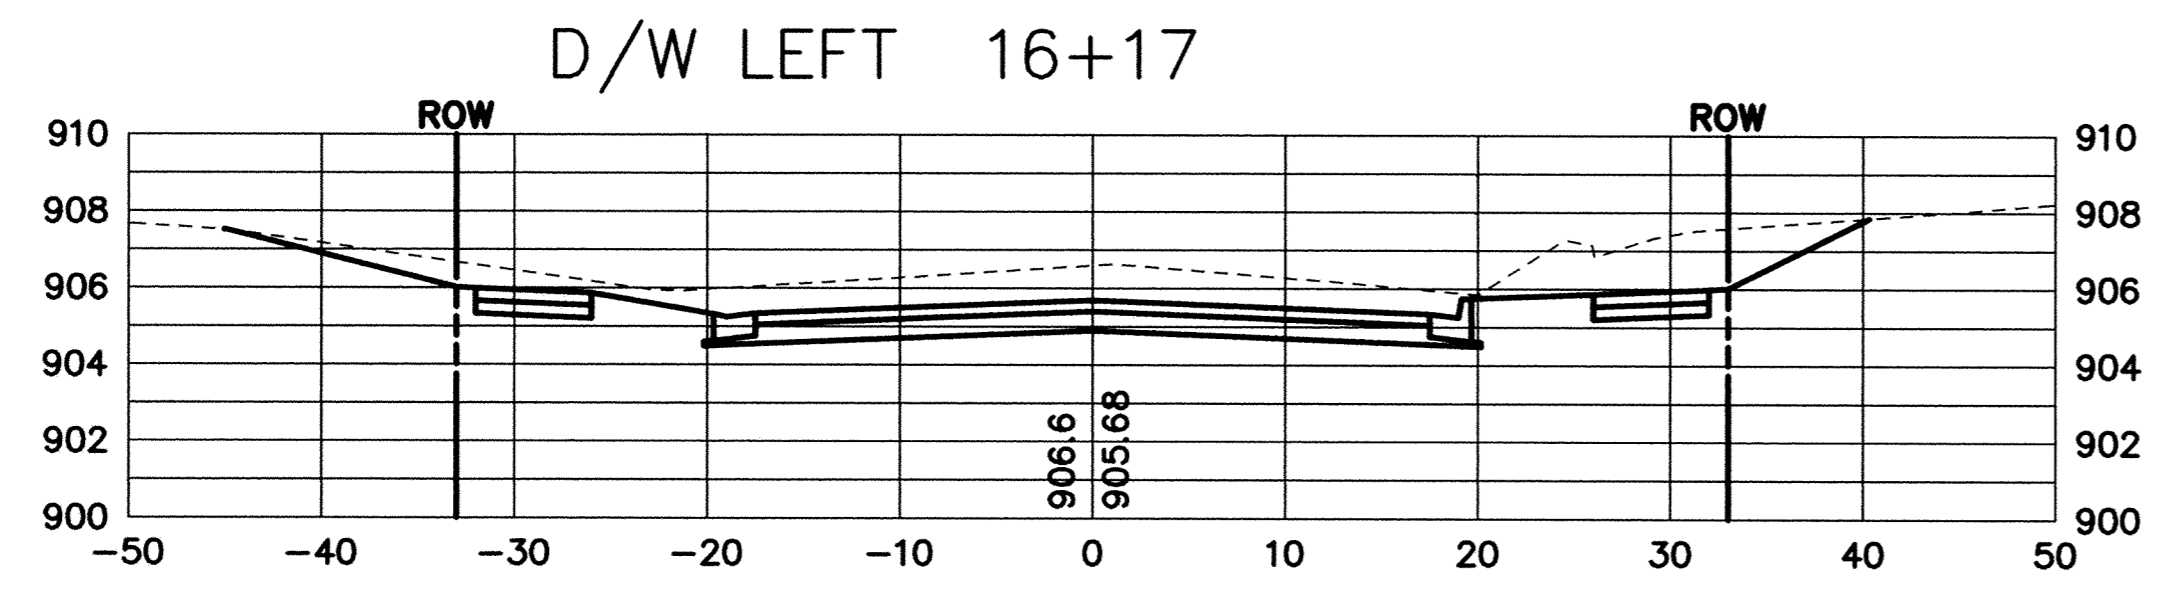
RECORD PLAN
APRIL 2004

DESIGNED BY: DESIGNED BY: DRAWN BY: RKM
 APPROVED BY: APPROVED BY: JOB NUMBER 818980J
 CAD DATE: April 14, 2003 11:01:16 a.m.
 CAD FILE: 818980J\Draw\C\CT-X04.DWG (RMONJEA)

I HEREBY CERTIFY THAT THIS PLAN, SPECIFICATION, OR REPORT WAS PREPARED BY ME OR UNDER MY DIRECT SUPERVISION AND THAT I AM A DULY LICENSED PROFESSIONAL ENGINEER UNDER THE LAWS OF THE STATE OF MINNESOTA.

SIGNATURE _____ DATE _____
 PRINTED NAME KRISTINA J. THOMPSON LIC. NO. 42350

NO.	DATE	BY	REVISION DESCRIPTION

1326 ENERGY PARK DRIVE
 ST. PAUL, MINNESOTA 55108
 (651) 644-4389

Howard R. Green Company

2003 STREET IMPROVEMENTS
 CITY OF ELK RIVER

CROSS SECTIONS
 FOURTH STREET
 14+88 TO 18+50

SHEET NO.
28