
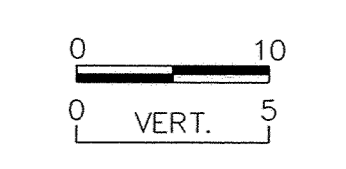
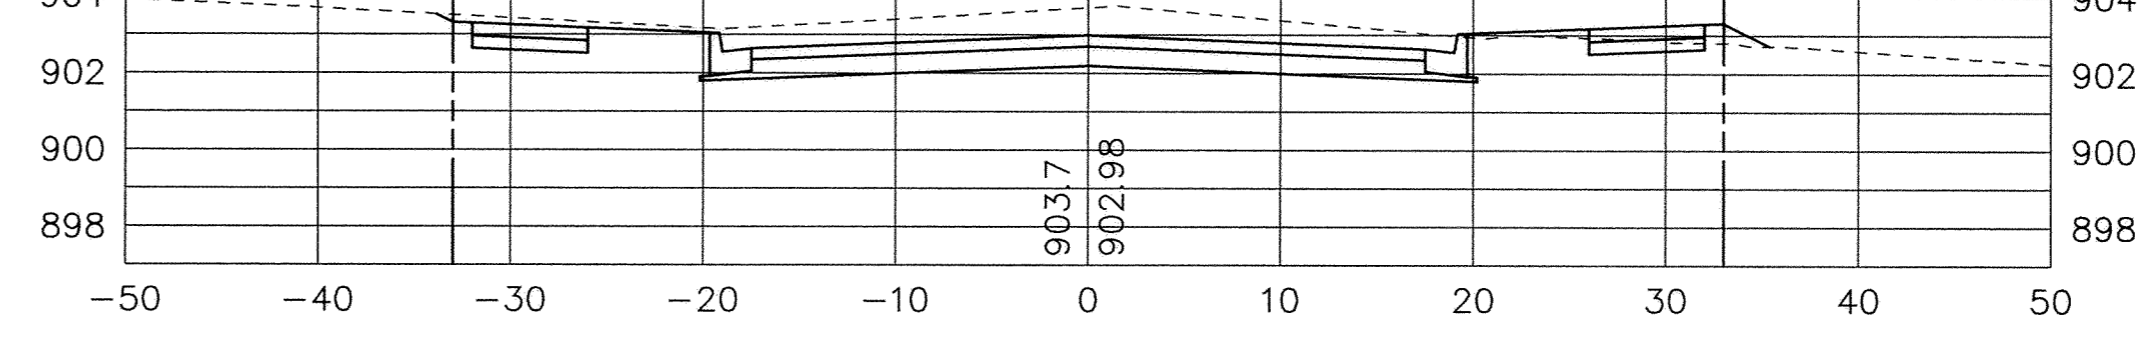
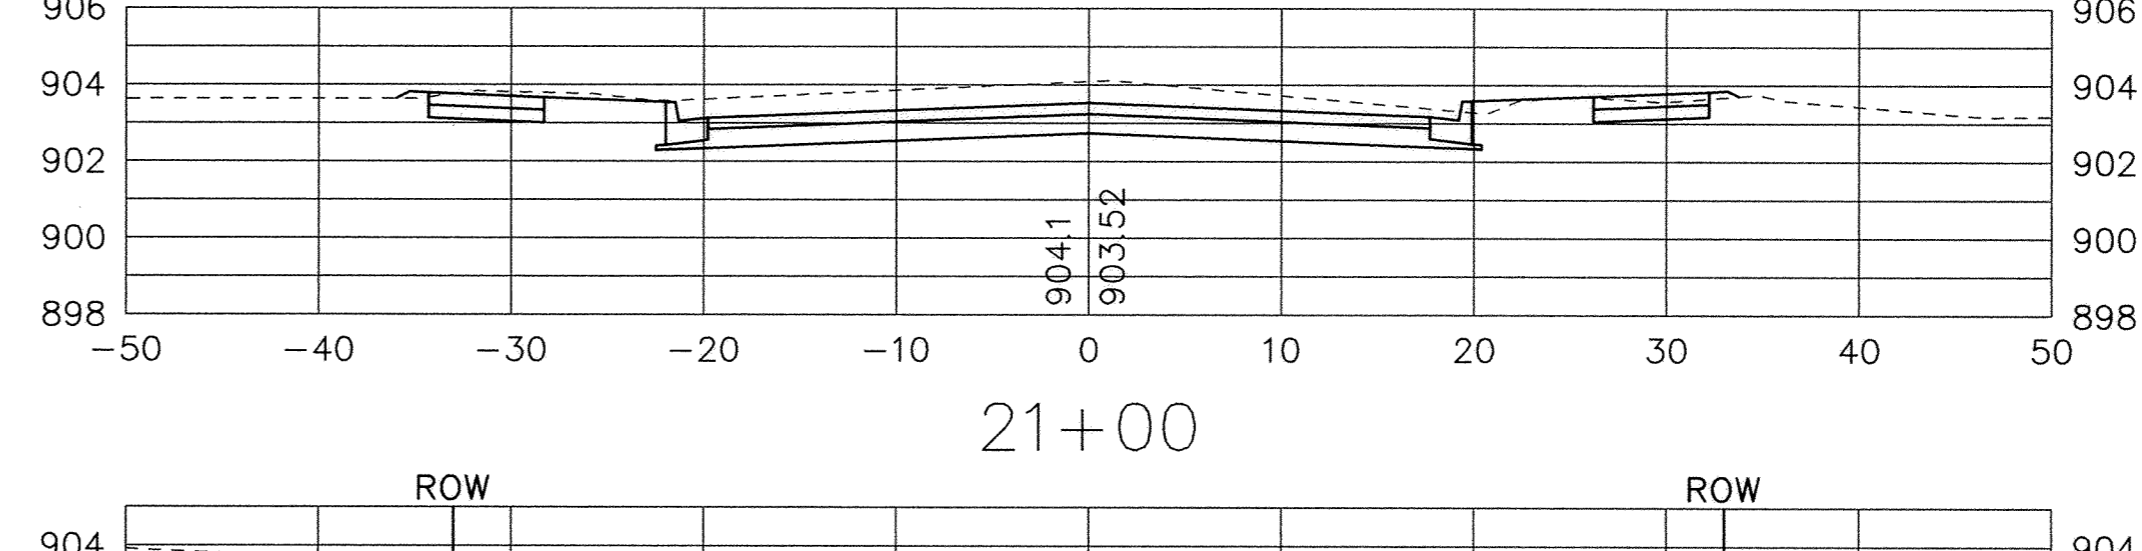
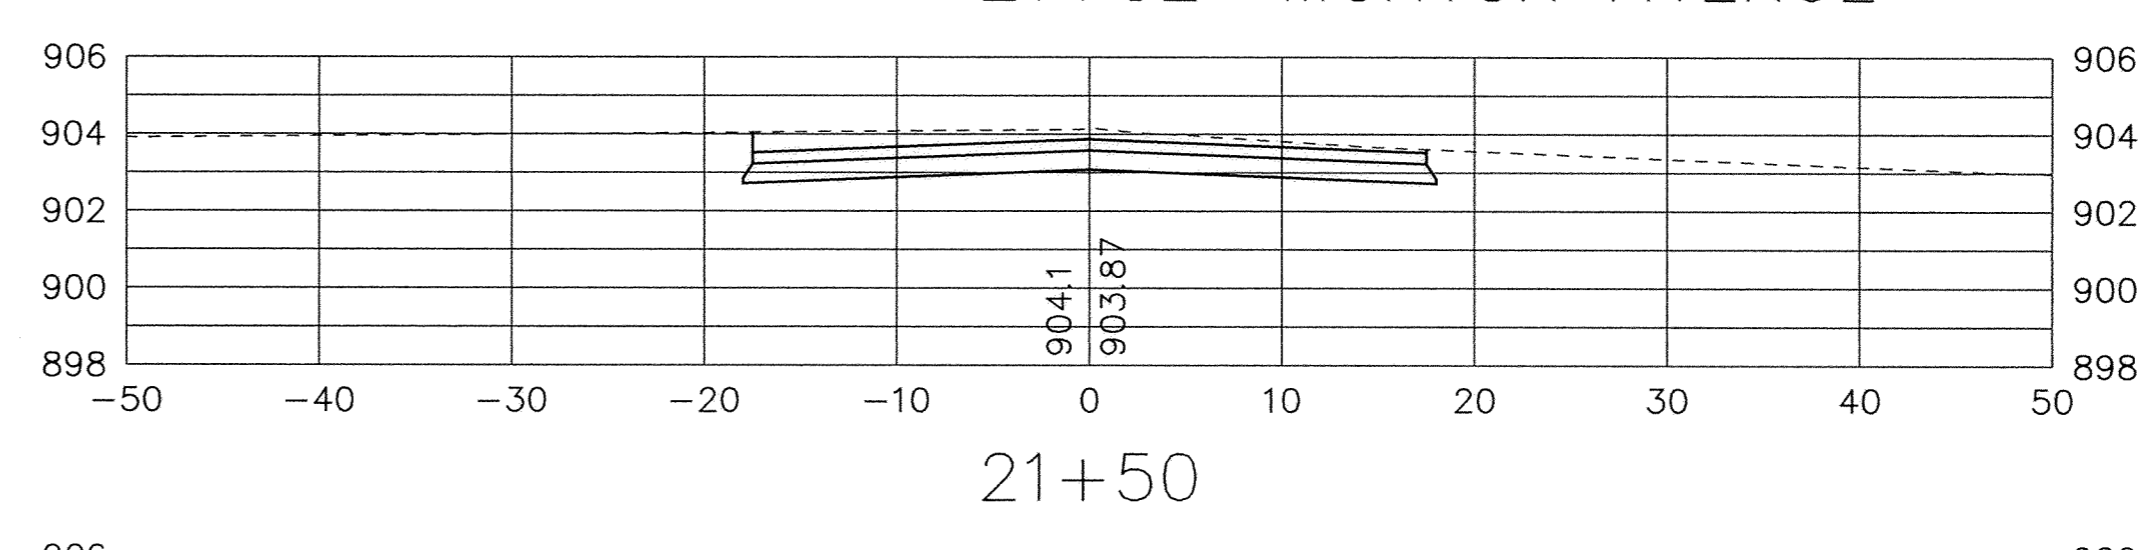
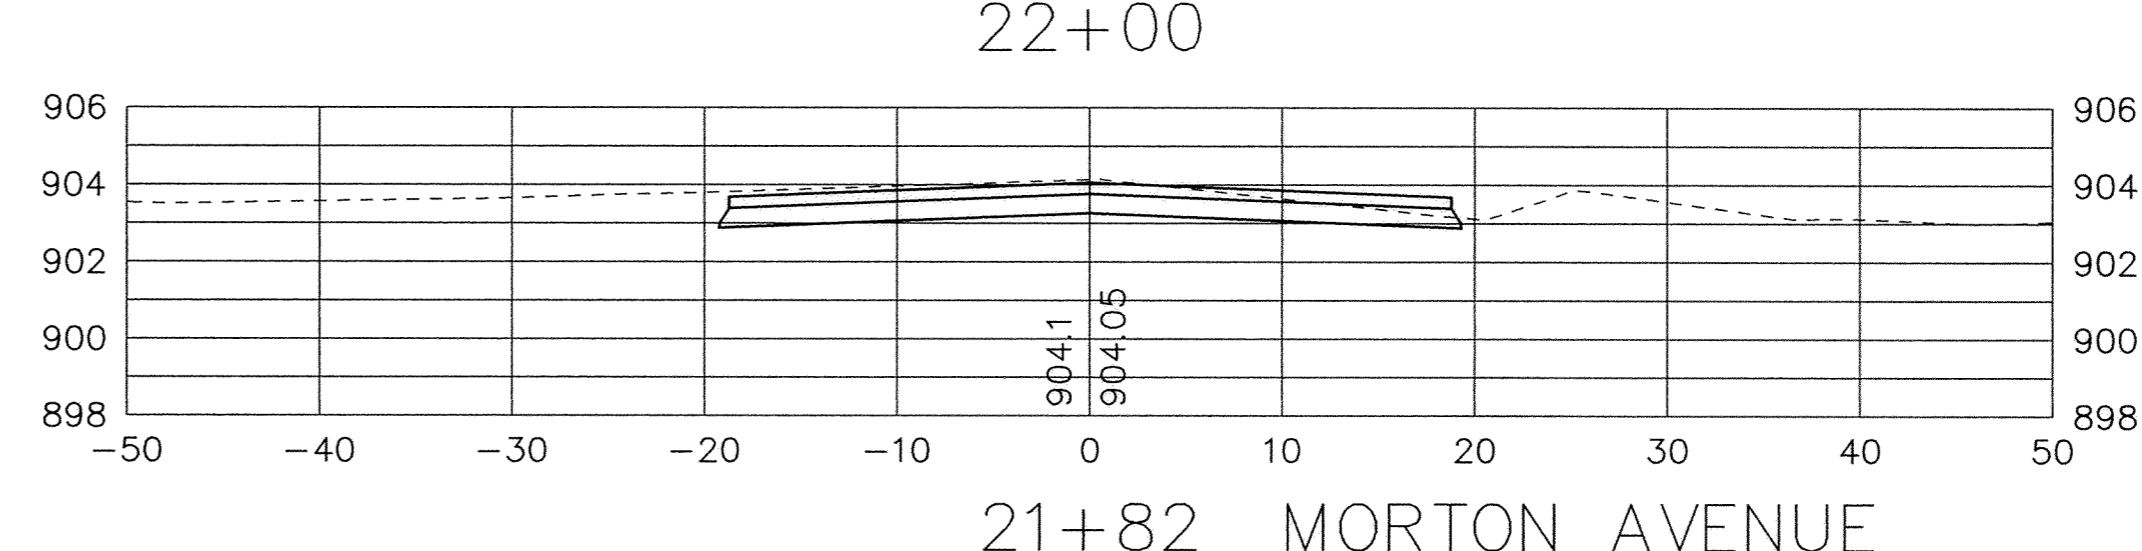
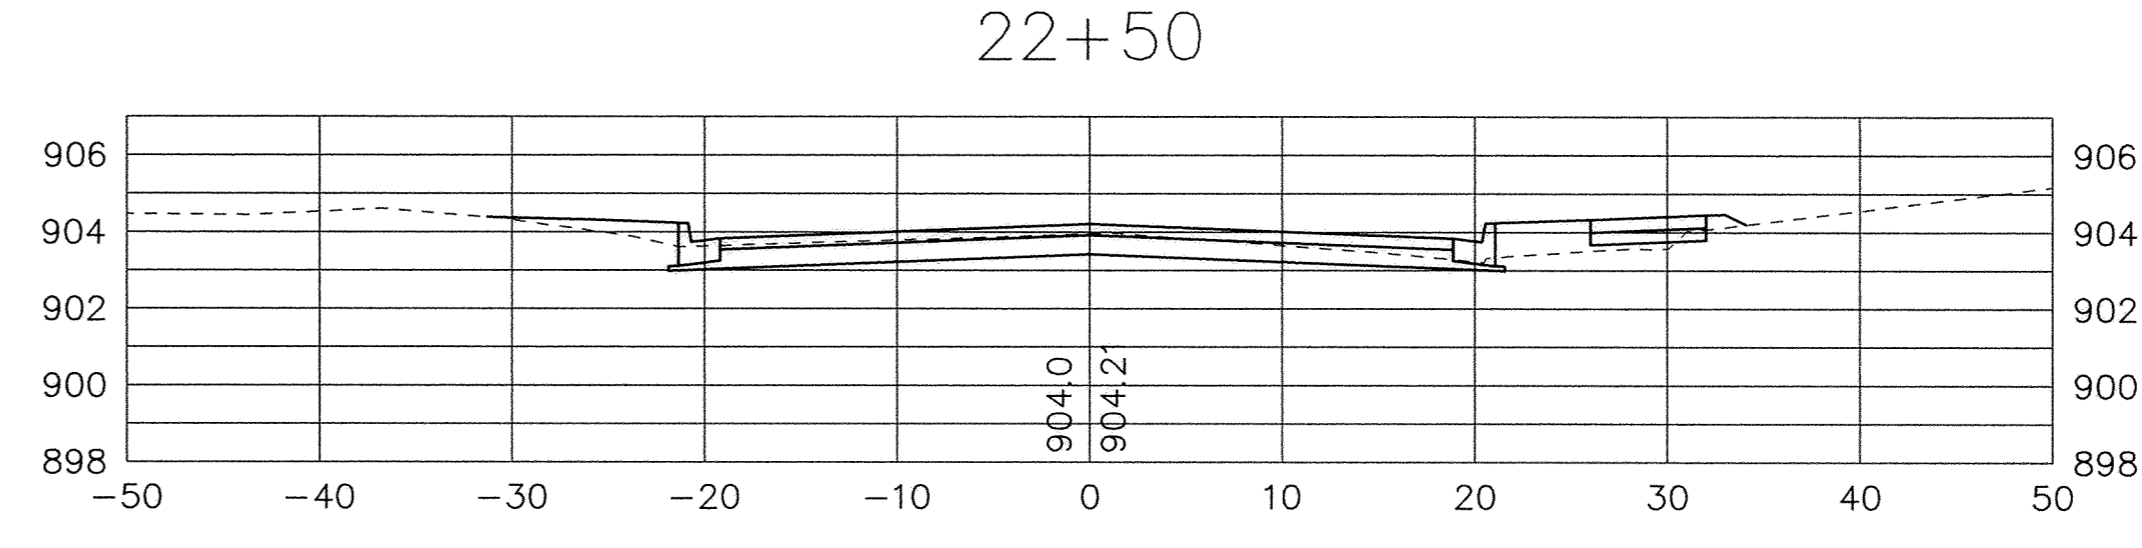
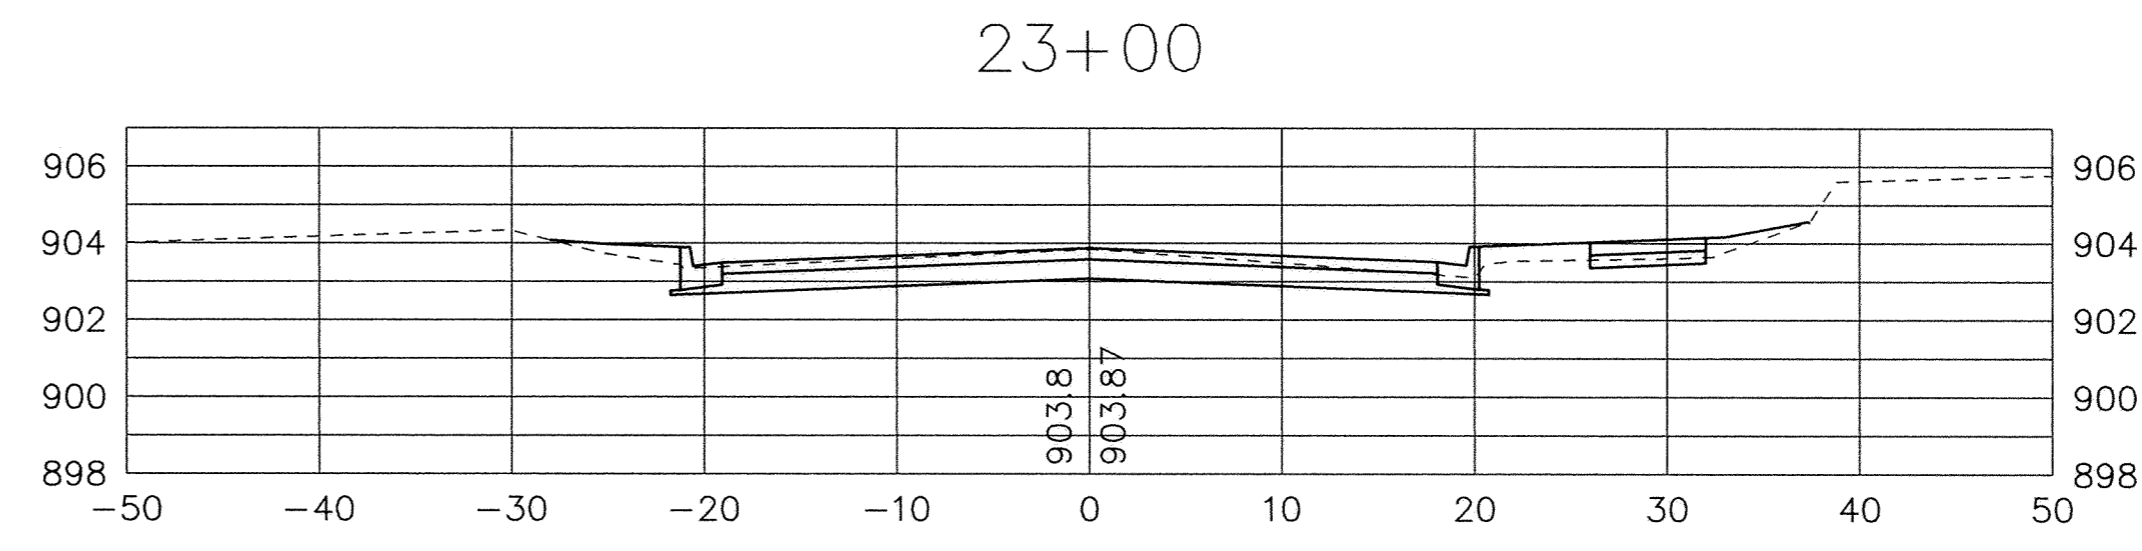
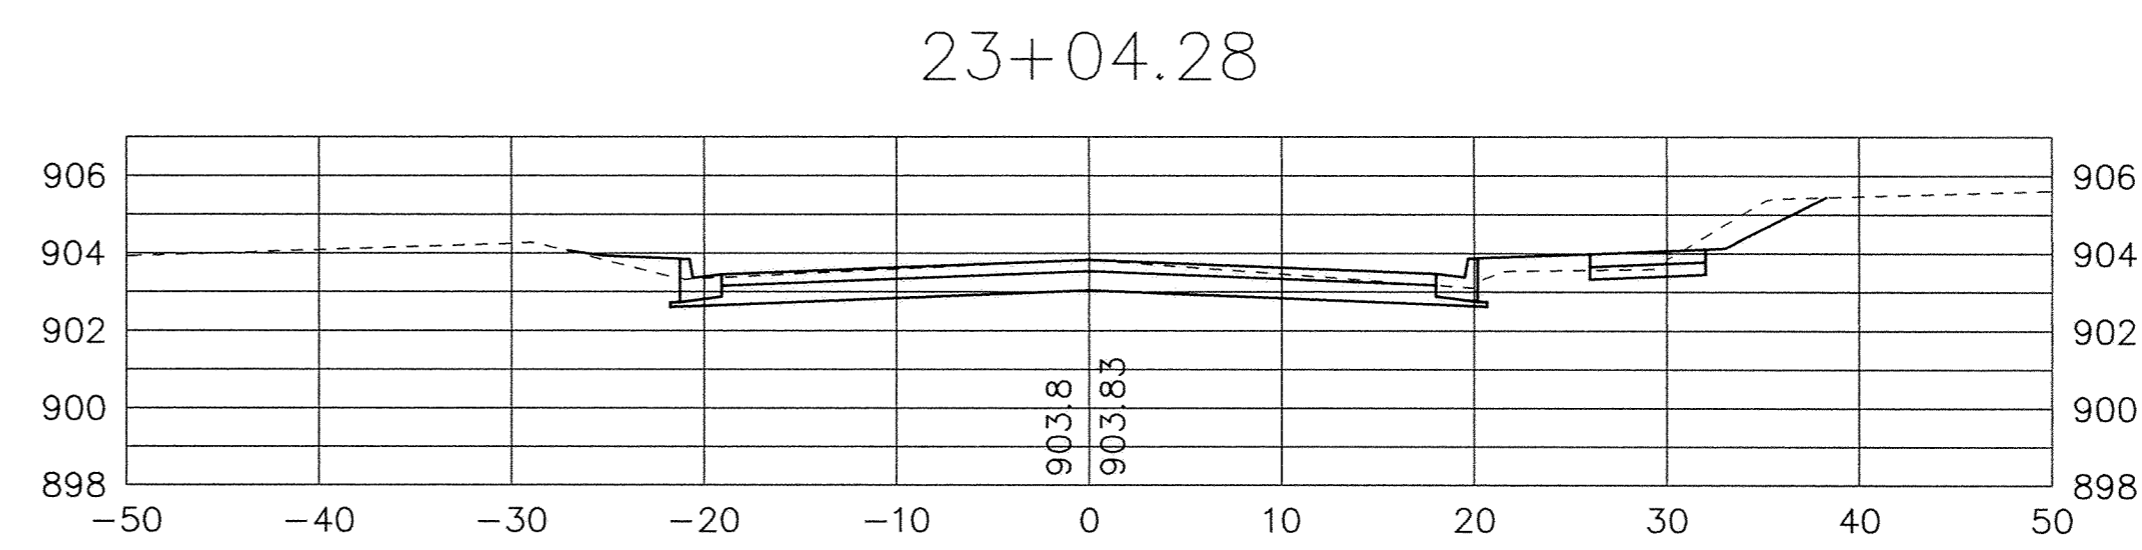
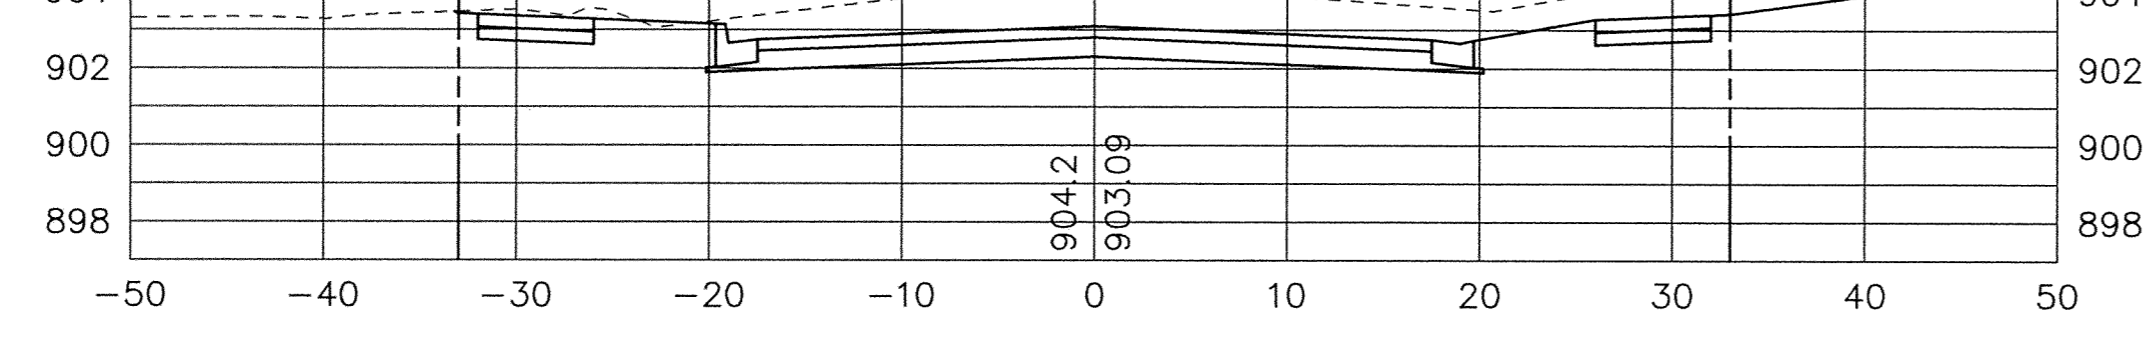
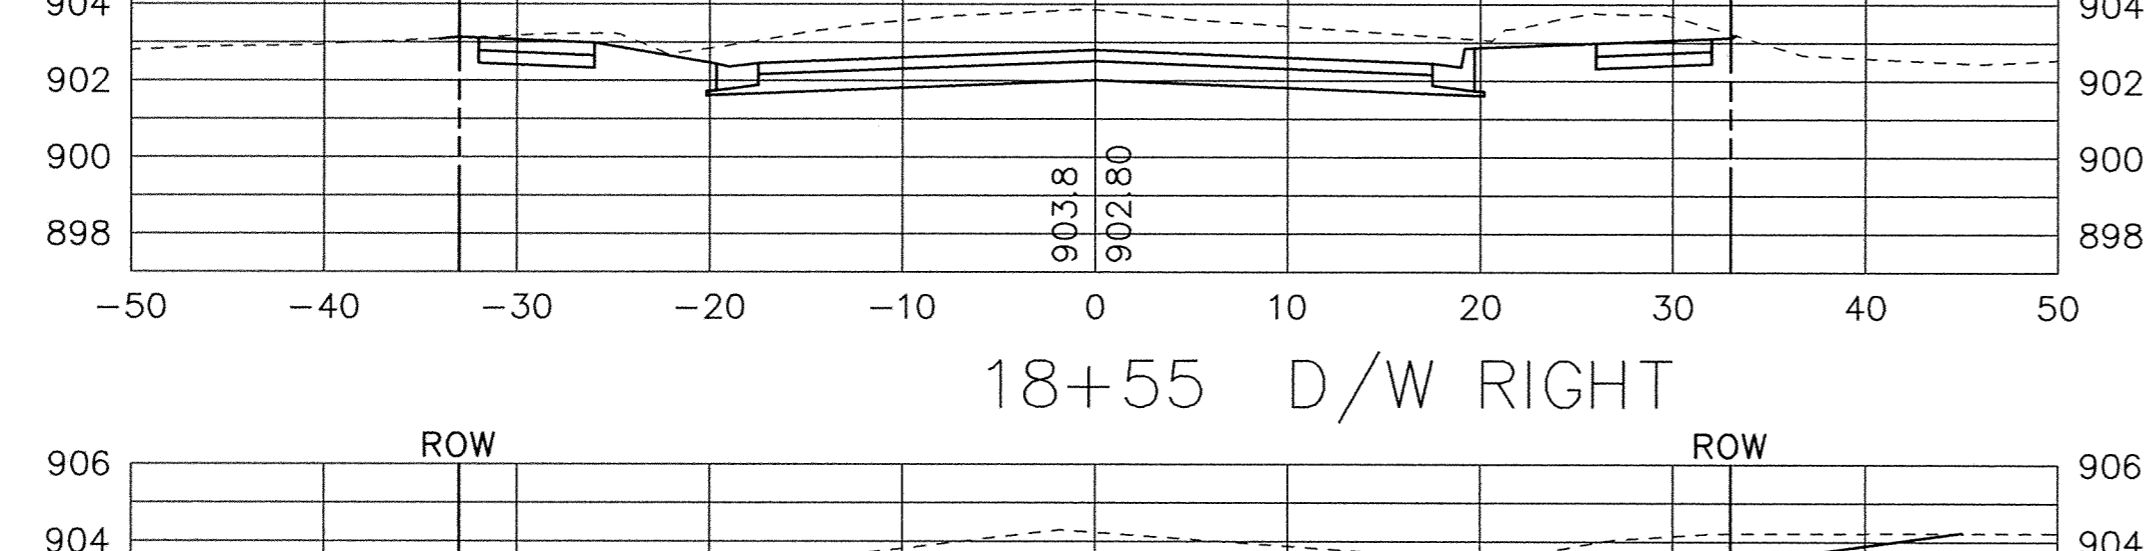
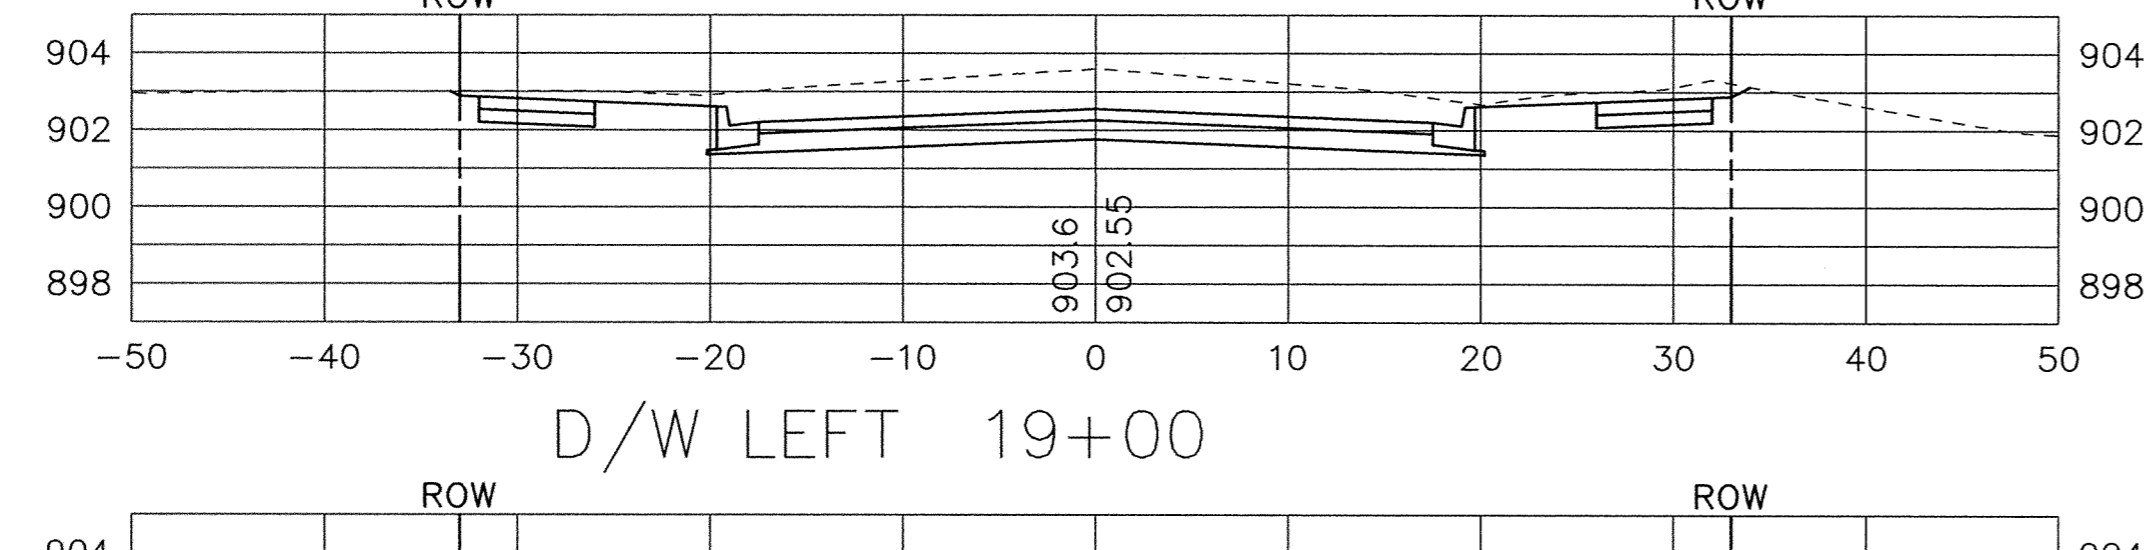
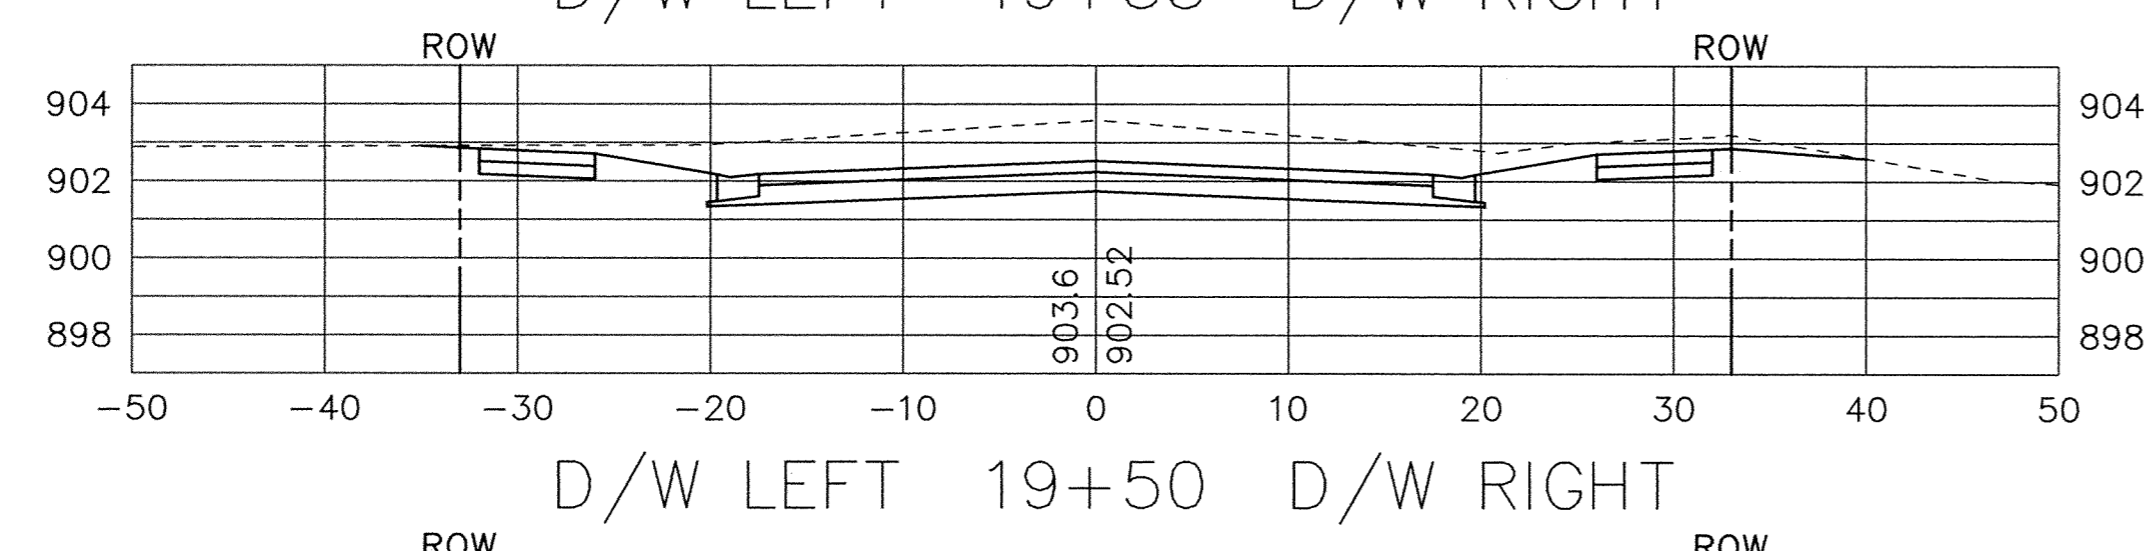
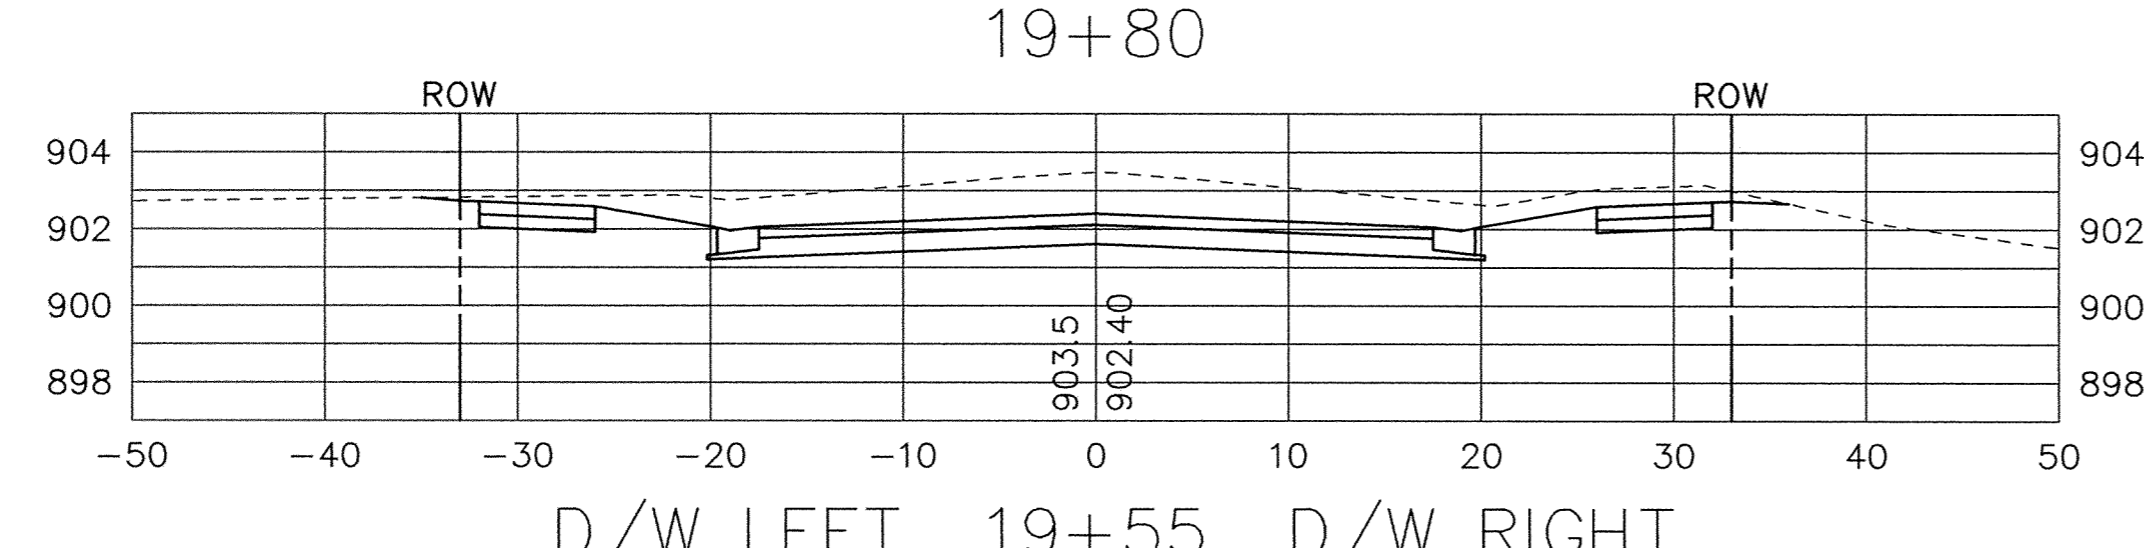
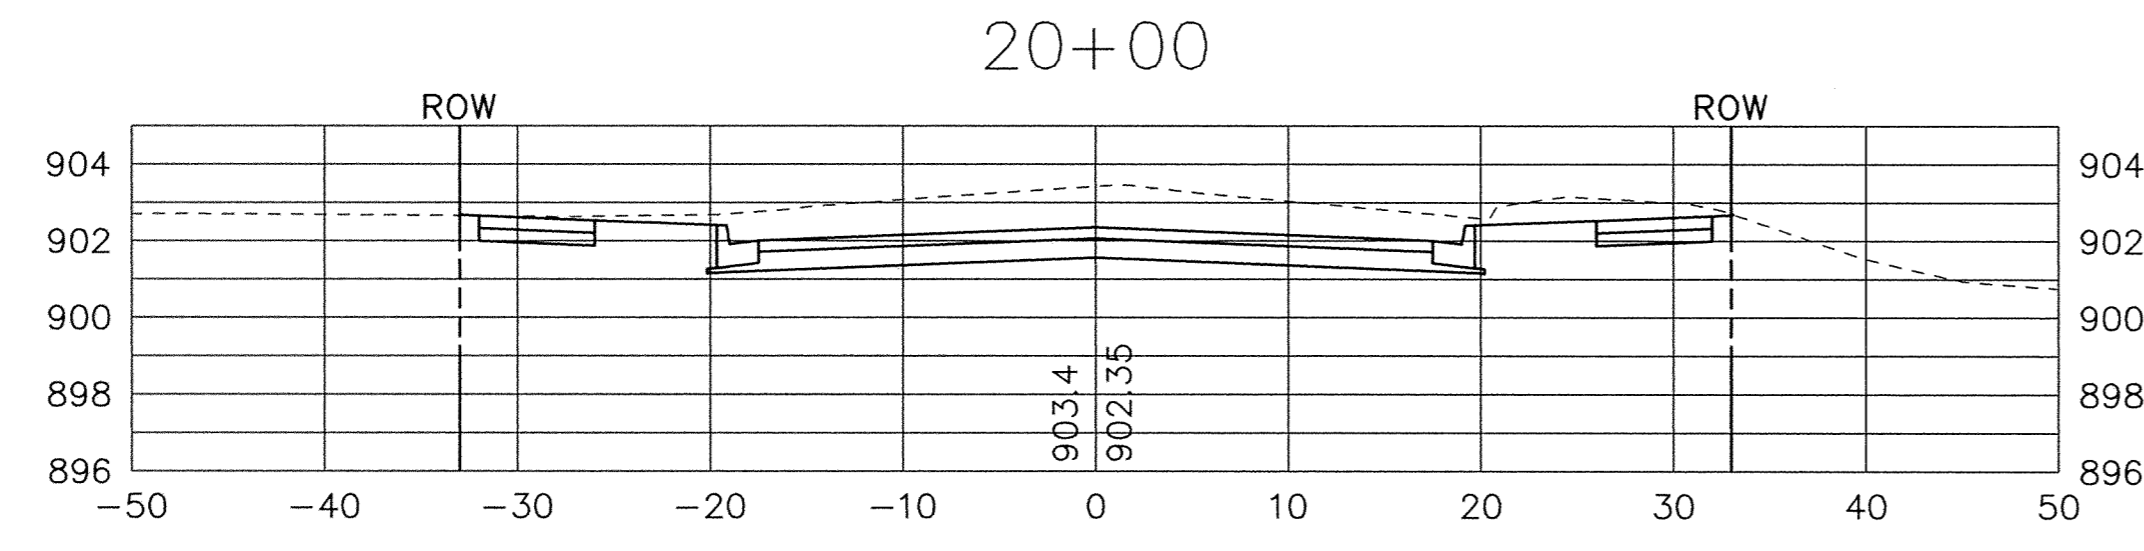


SDCO PRODUCTS • NEW URGENT, MINNESOTA
DESIGNED BY PAUL KAMBERG, SDPE
REVISIONS BY PAUL KAMBERG, SDPE
NATIONAL BOARD OF PRINTING ON THE LINE
SDCO PRODUCTS • NEW URGENT, MINNESOTA
DESIGNED BY PAUL KAMBERG, SDPE
REVISIONS BY PAUL KAMBERG, SDPE
NATIONAL BOARD OF PRINTING ON THE LINE
SDCO PRODUCTS • NEW URGENT, MINNESOTA
DESIGNED BY PAUL KAMBERG, SDPE
REVISIONS BY PAUL KAMBERG, SDPE
NATIONAL BOARD OF PRINTING ON THE LINE

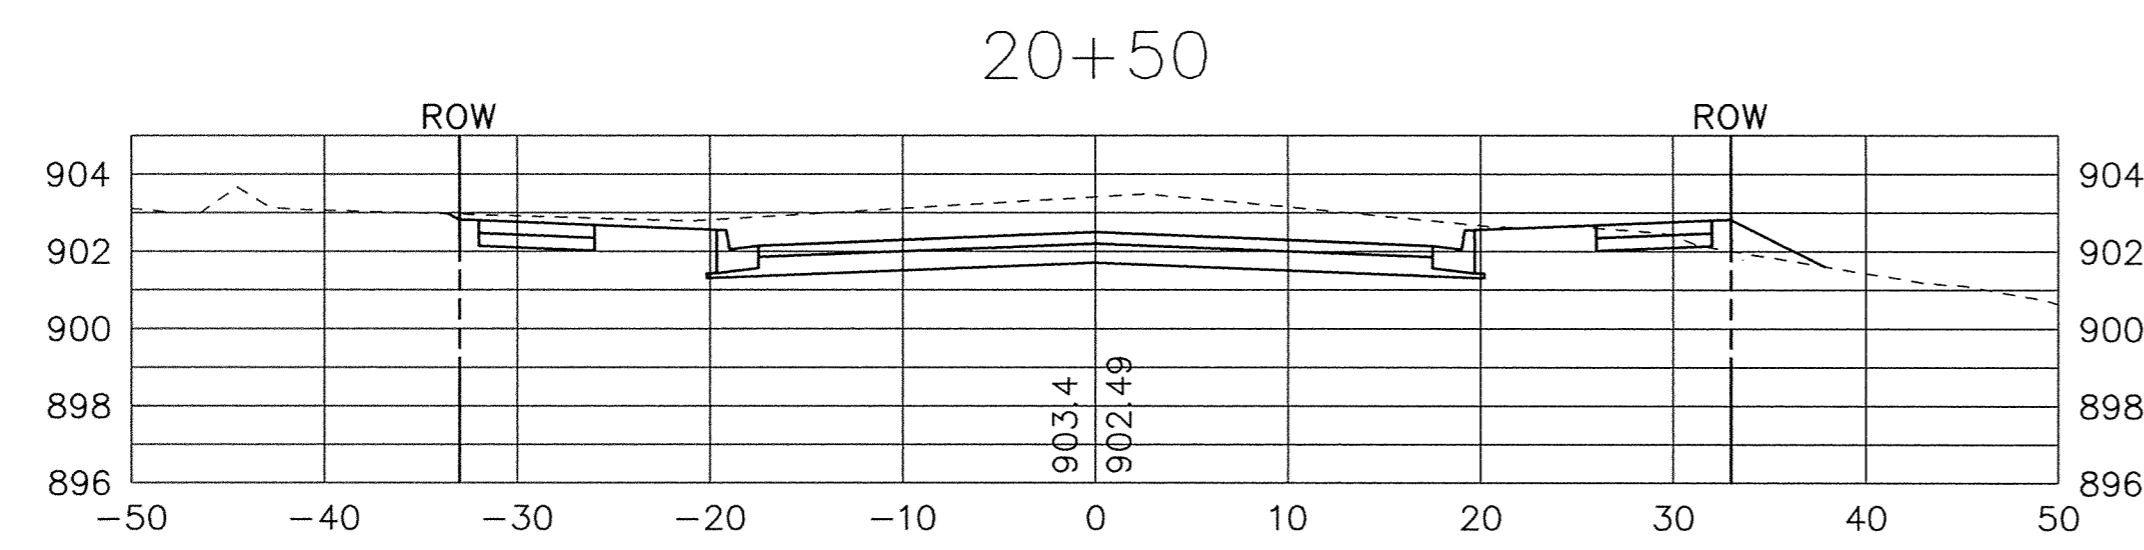

RECORD PLAN
APRIL 2004

DESIGNED BY: DESIGNED BY DRAWN BY: RKM
 APPROVED BY: APPROVED BY JOB NUMBER 818980J
 CAD DATE: April 14, 2003 11:02:08 a.m.
 CAD FILE: 818980\J\dwg\c\CT-X05.DWG (RMONJEA)

I HEREBY CERTIFY THAT THIS PLAN, SPECIFICATION, OR REPORT WAS PREPARED BY ME OR UNDER MY DIRECT SUPERVISION AND THAT I AM A DULY LICENSED PROFESSIONAL ENGINEER UNDER THE LAWS OF THE STATE OF MINNESOTA.
 SIGNATURE _____ DATE _____
 PRINTED NAME KRISTINA J THOMPSON LIC. NO. 42350

NO.	DATE	BY	REVISION DESCRIPTION



1326 ENERGY PARK DRIVE
 ST. PAUL, MINNESOTA 55108
 (651) 644-4389

2003 STREET IMPROVEMENTS
 CITY OF ELK RIVER

CROSS SECTIONS
 FOURTH STREET
 18+55 TO 23+04.28

SHEET NO.
29