
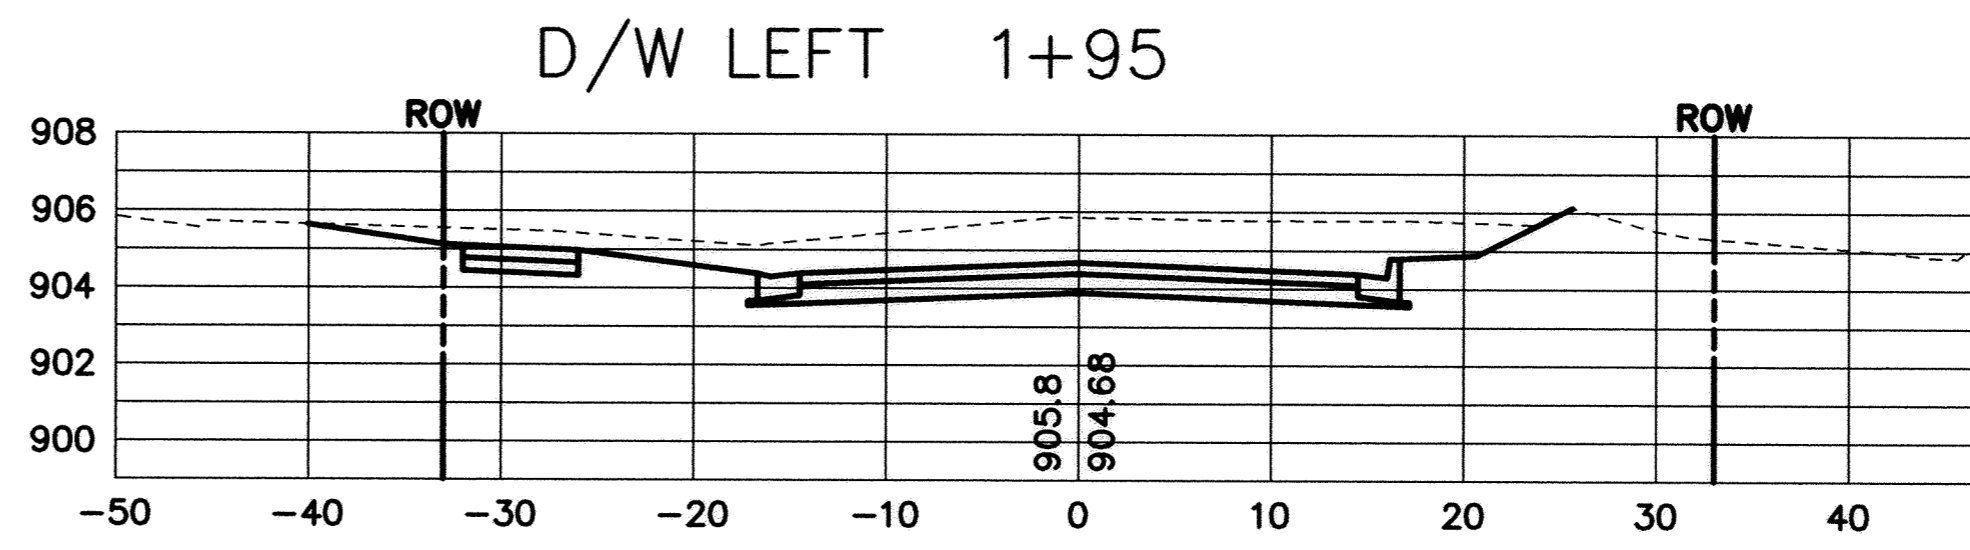
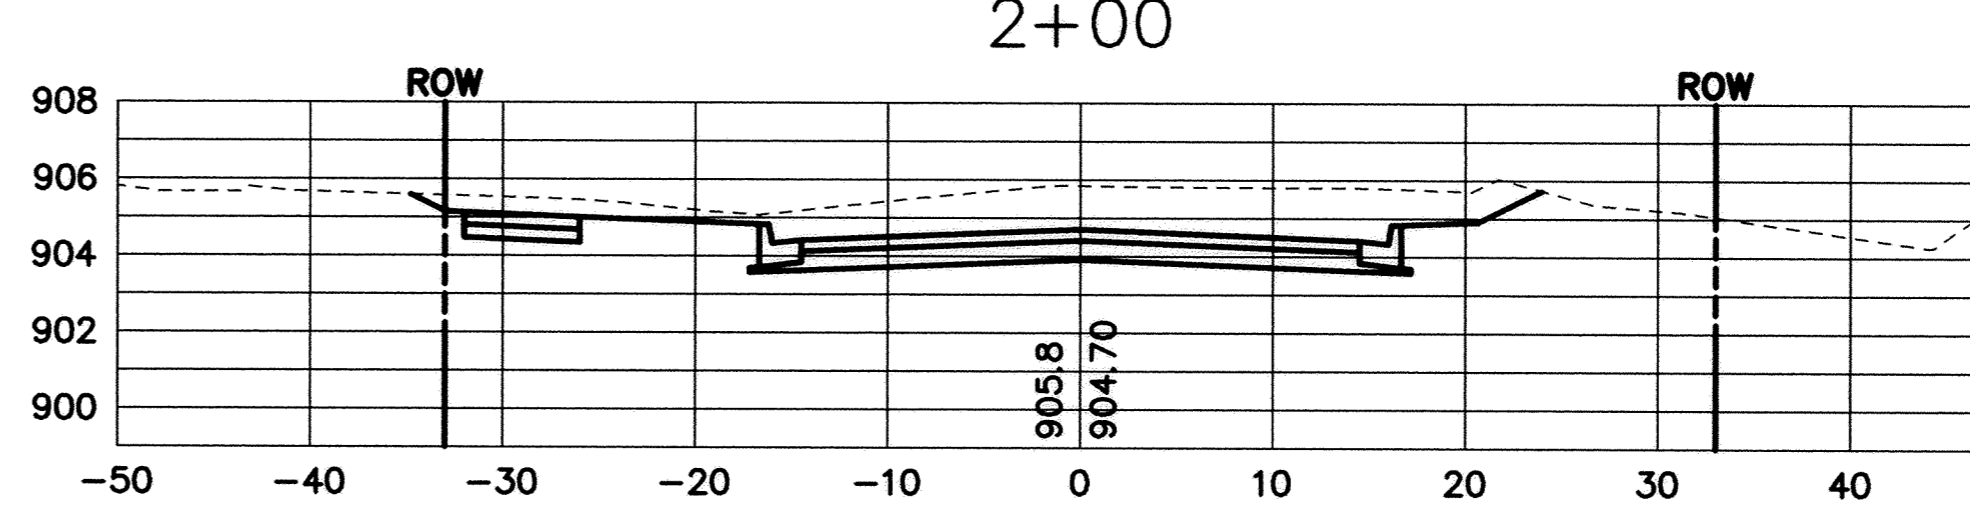
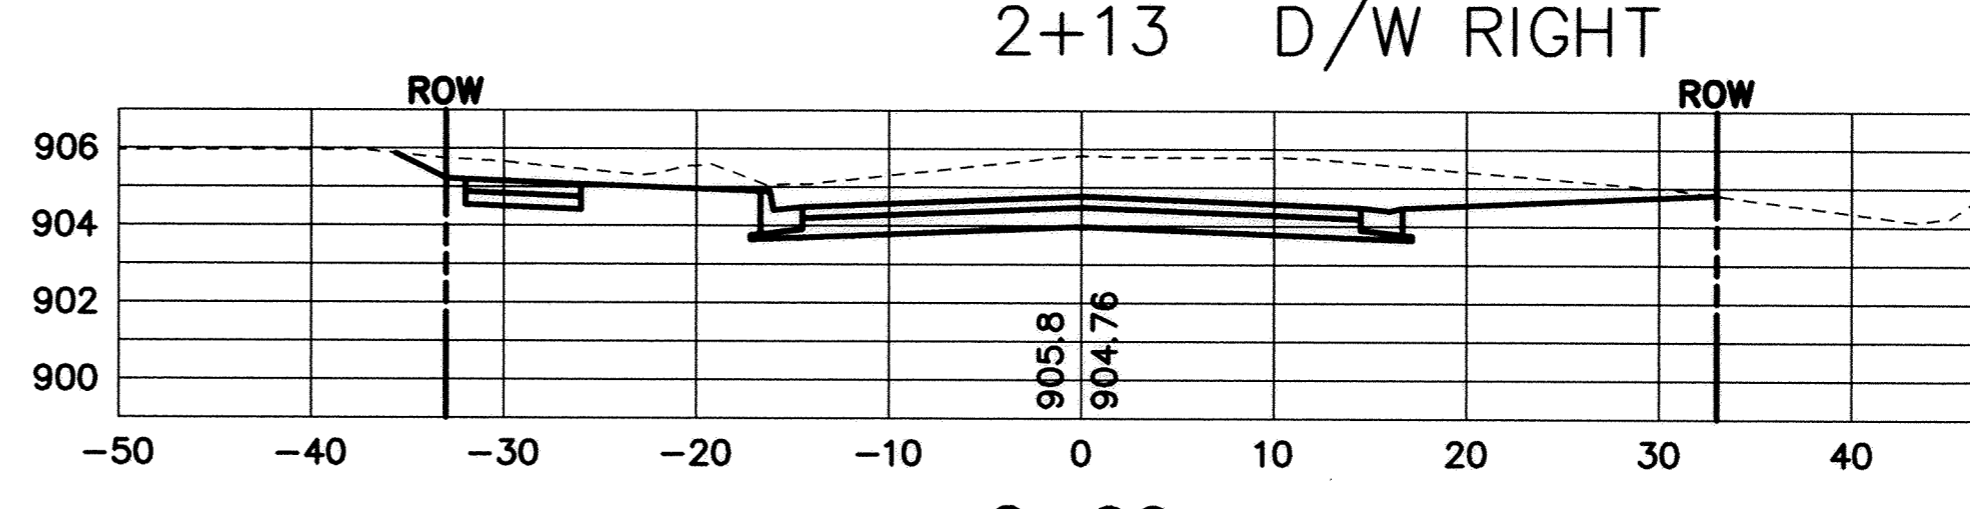
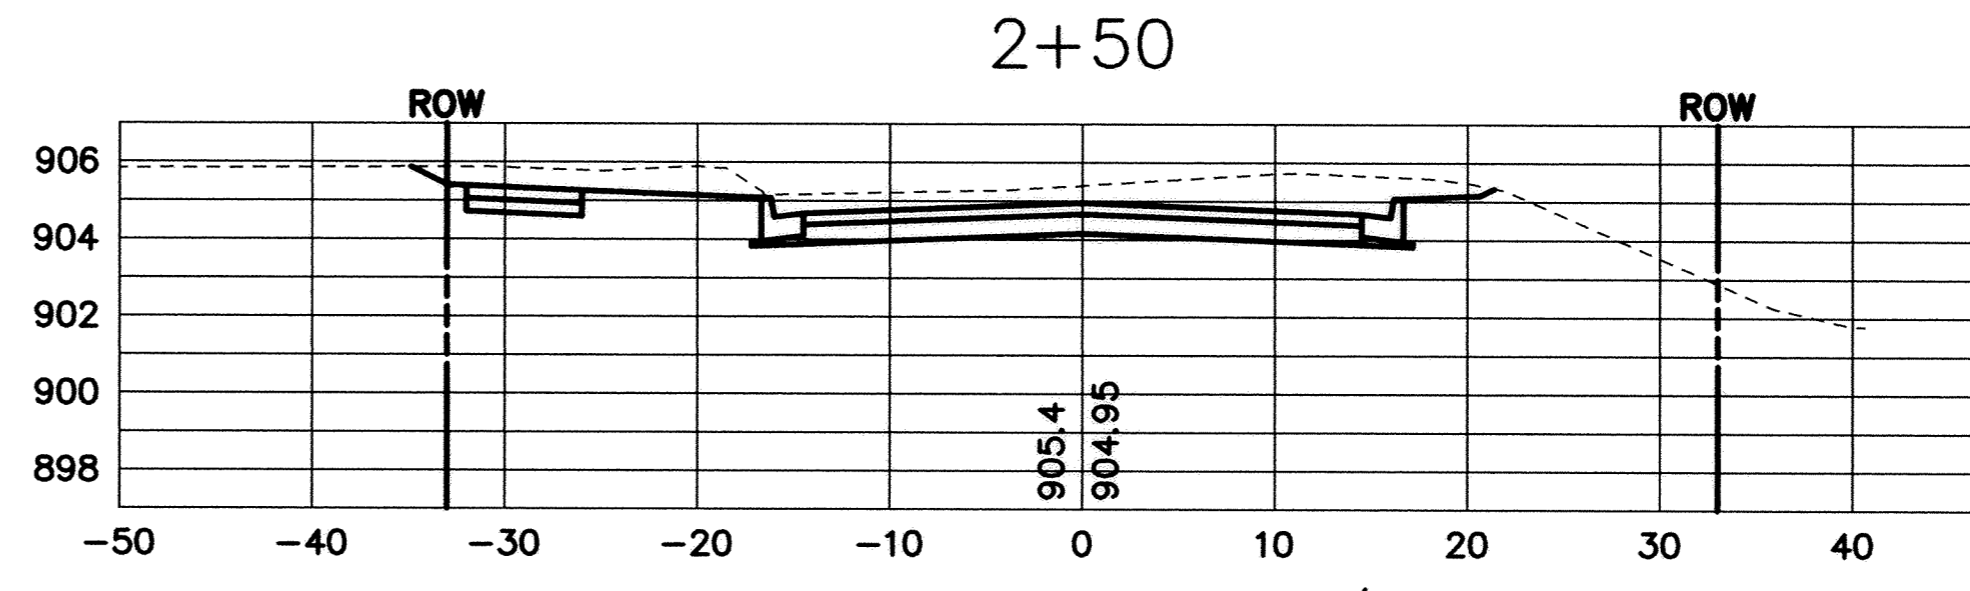
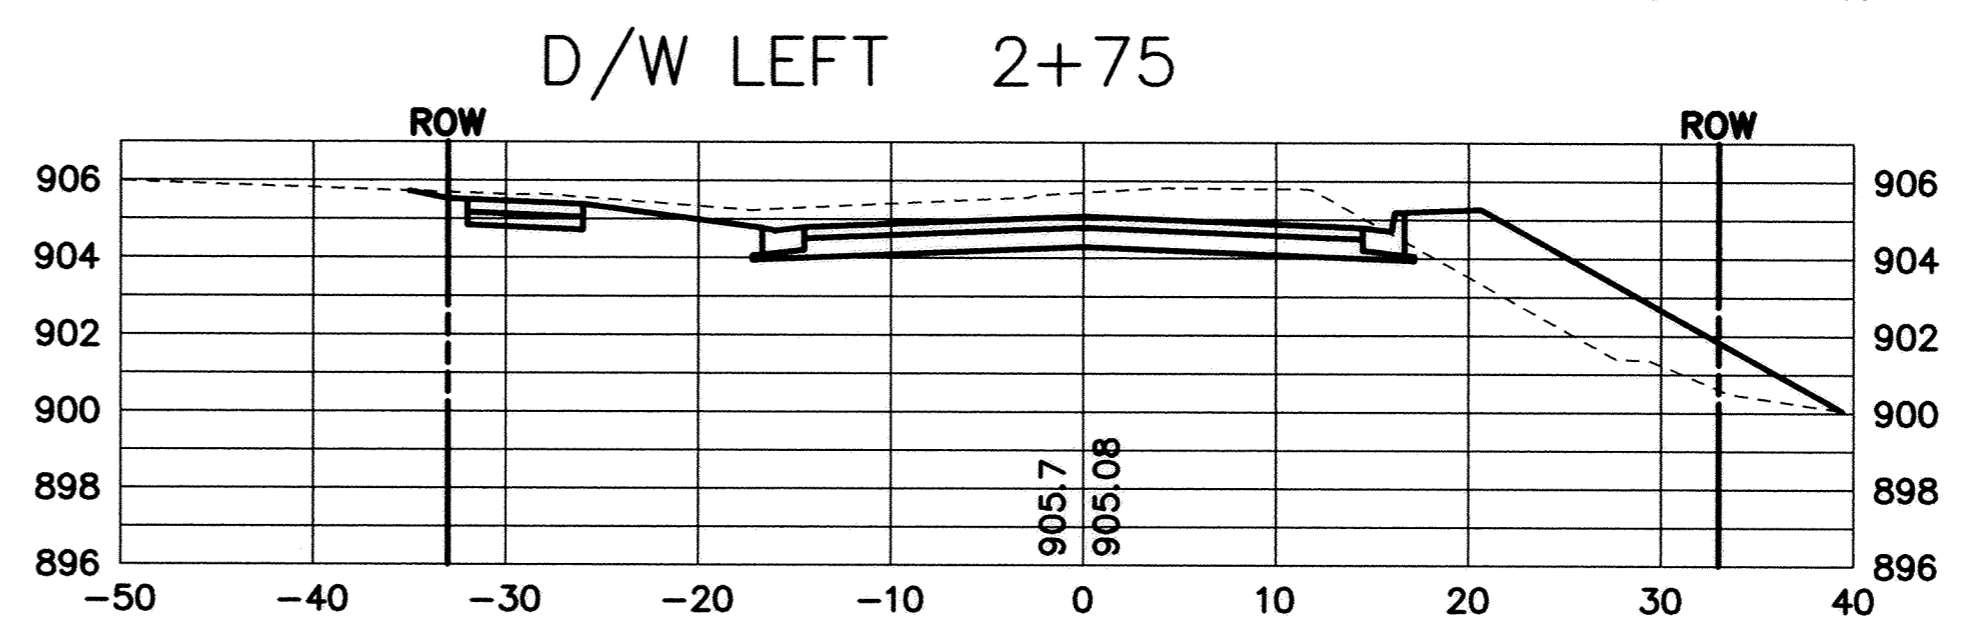
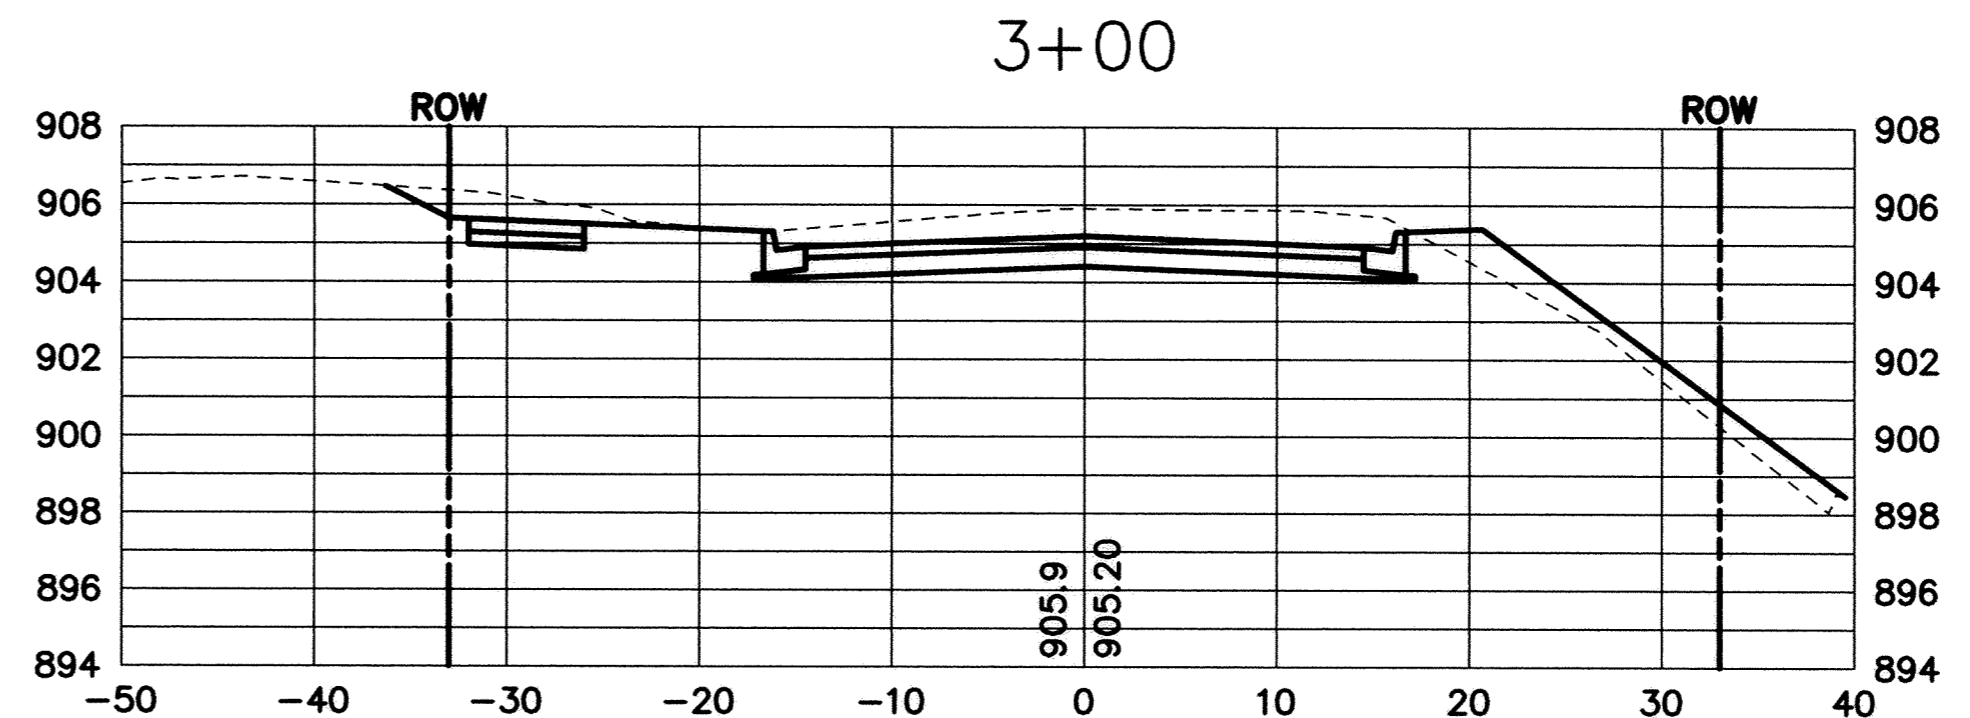
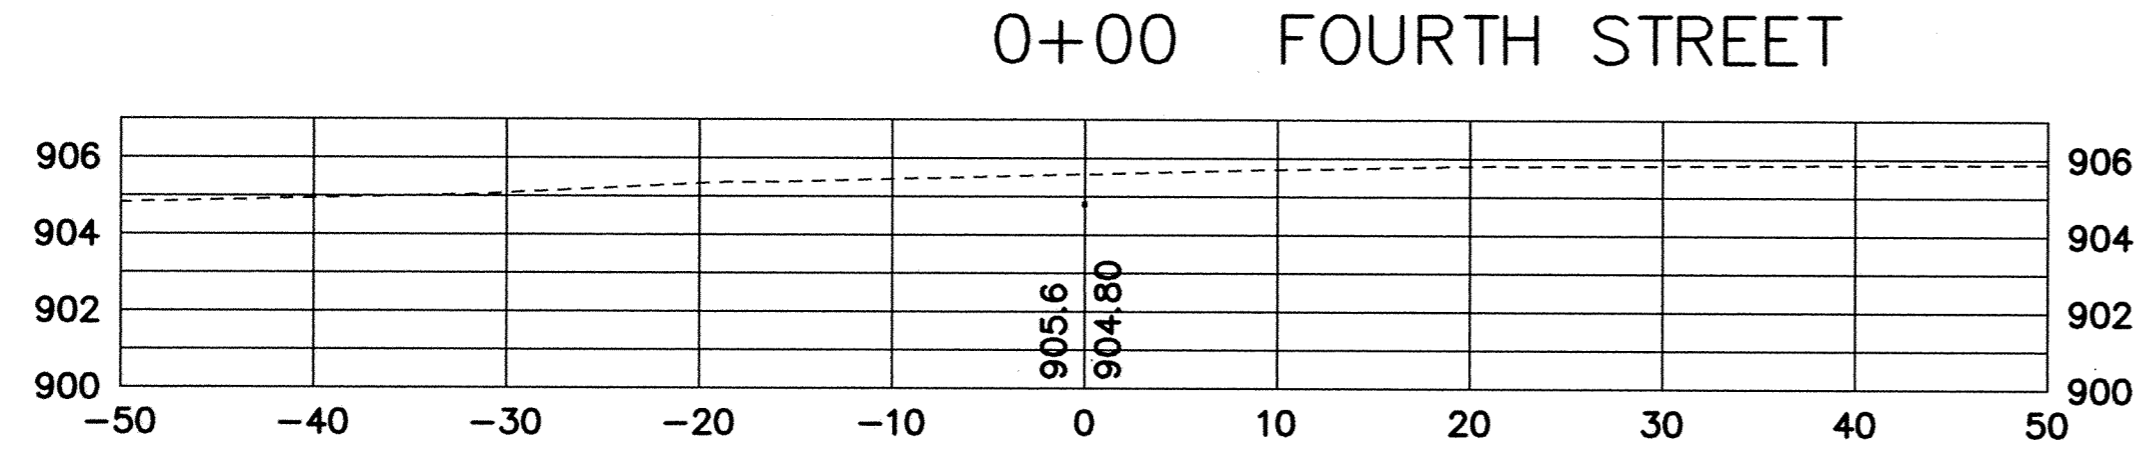
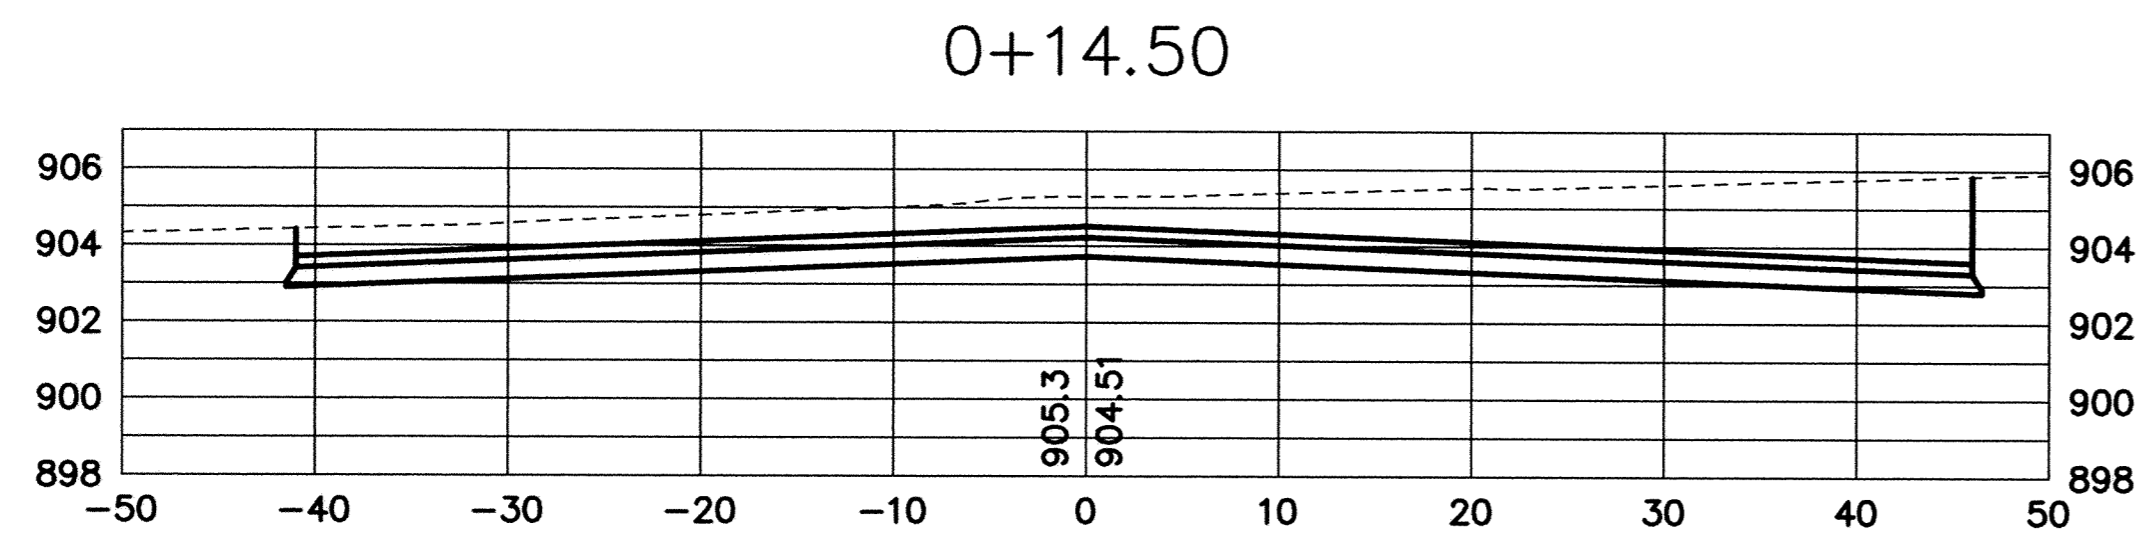
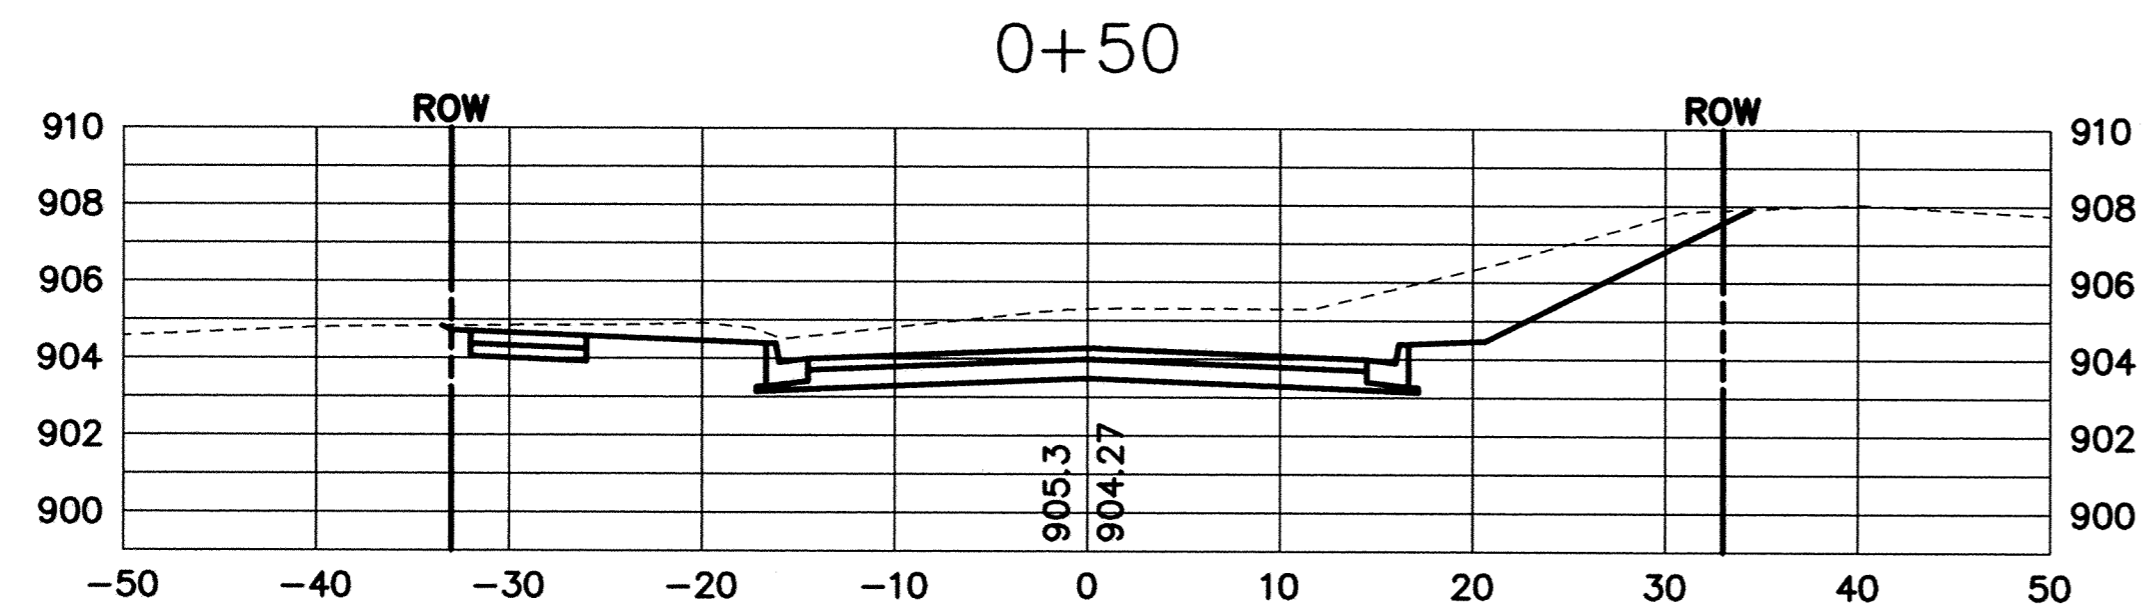
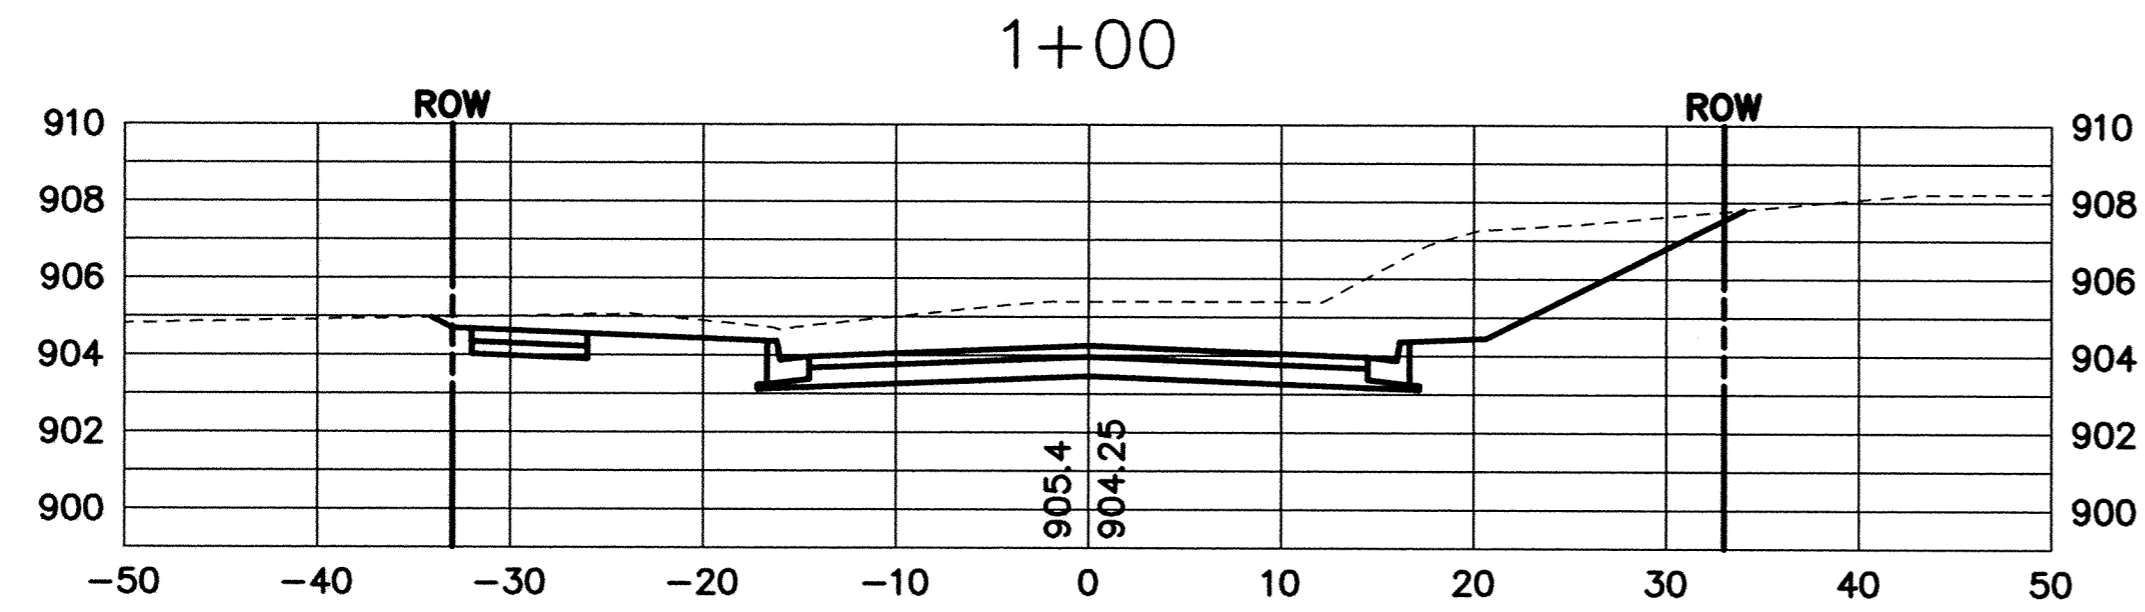
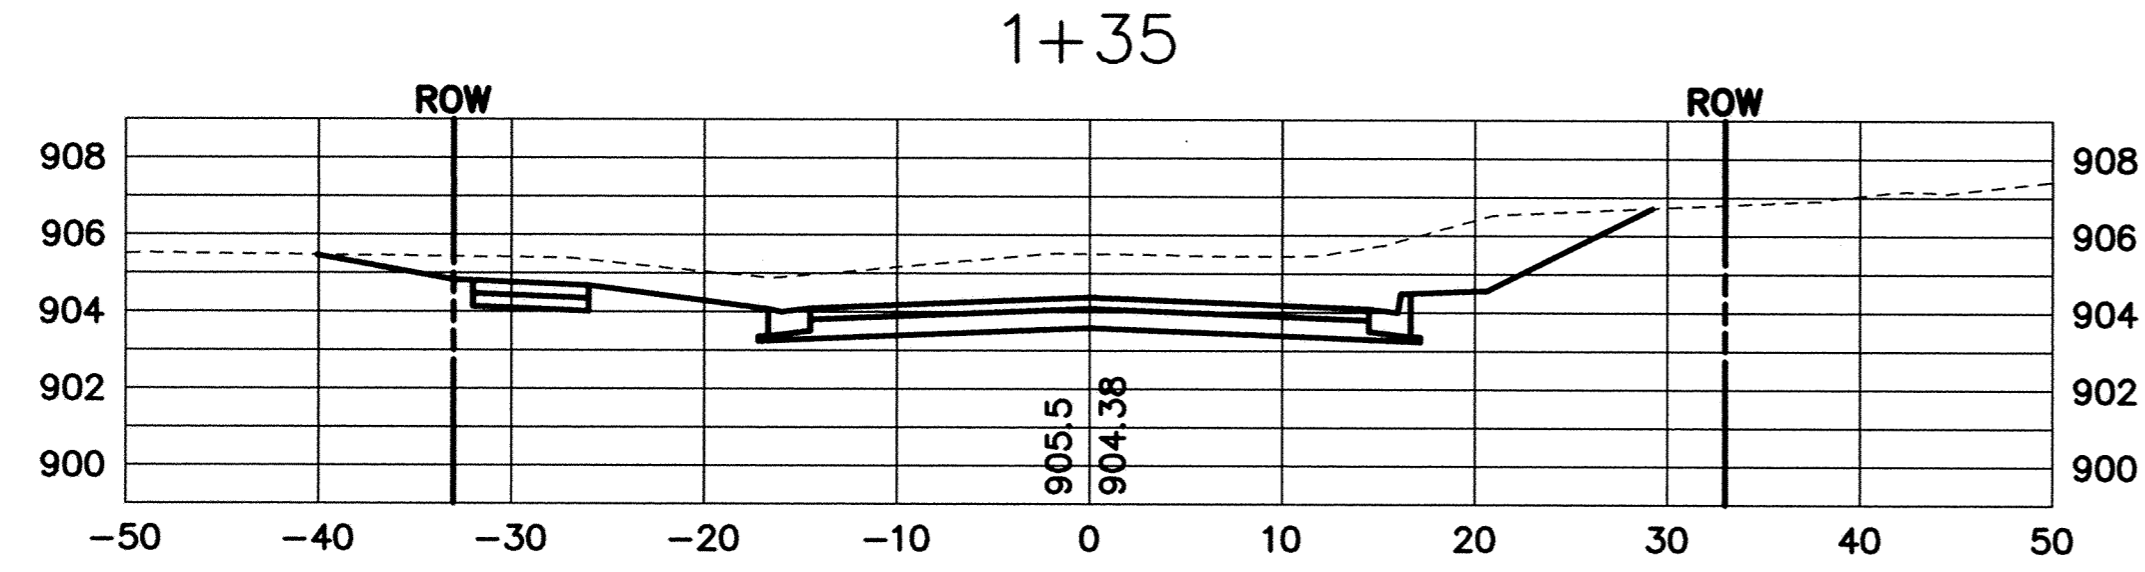


SARCO PRODUCTS • NEW HOPE, MINNESOTA
DESIGNED BY PART NUMBER 8525
REVISIONS: 01
SARCO PRODUCTS • NEW HOPE, MINNESOTA
DESIGNED BY PART NUMBER 8525
REVISIONS: 01
SARCO PRODUCTS • NEW HOPE, MINNESOTA
DESIGNED BY PART NUMBER 8525
REVISIONS: 01
SARCO PRODUCTS • NEW HOPE, MINNESOTA
DESIGNED BY PART NUMBER 8525
REVISIONS: 01

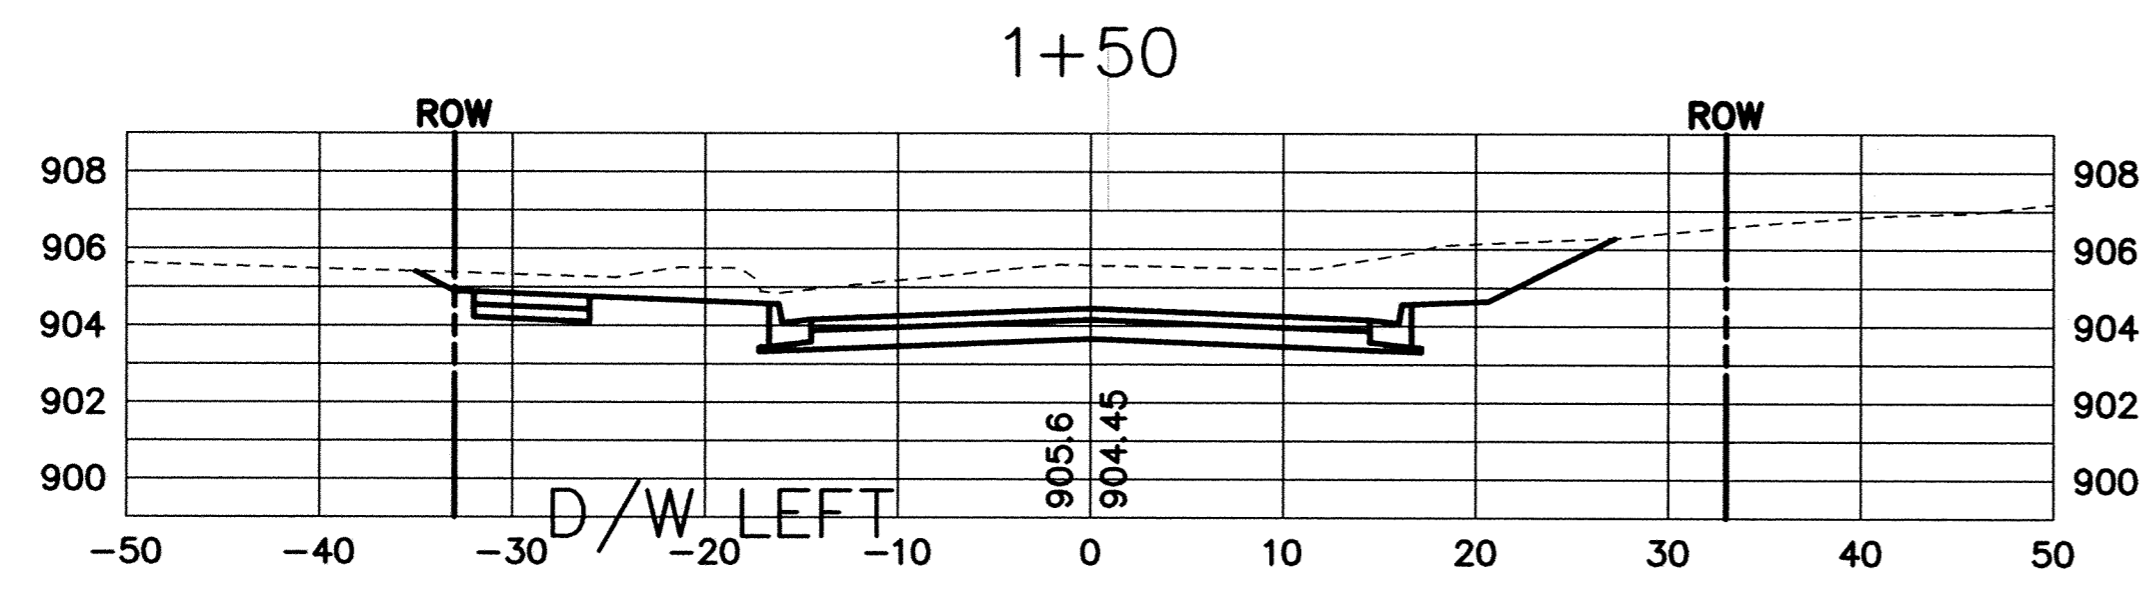

RECORD PLAN
APRIL 2004

DESIGNED BY: DESIGNED BY DRAWN BY: RKM
 APPROVED BY: APPROVED BY JOB NUMBER 818980J
 CAD DATE: April 14, 2003 11:10:05 a.m.
 CAD FILE: 818980J\Dwg\C\CT-X10.DWG (RMONJEA)

I HEREBY CERTIFY THAT THIS PLAN, SPECIFICATION, OR REPORT WAS PREPARED BY ME OR UNDER MY DIRECT SUPERVISION AND THAT I AM A DULY LICENSED PROFESSIONAL ENGINEER UNDER THE LAWS OF THE STATE OF MINNESOTA.
 SIGNATURE: _____ DATE: _____
 PRINTED NAME: KRISTINA J THOMPSON LIC. NO. 42350

NO.	DATE	BY	REVISION DESCRIPTION



1326 ENERGY PARK DRIVE
 ST. PAUL, MINNESOTA 55108
 (651) 644-4389
 2003 STREET IMPROVEMENTS
 CITY OF ELK RIVER

CROSS SECTIONS
 NORFOLK AVENUE
 0+00 TO 3+00

SHEET NO.
34
 DRAWING NUMBER
 031MPR.04