



SACO PRODUCTS • NEW HOPE, MINNESOTA
REVISION RECORD OF PRINT ON THIS LINE
SACO PRODUCTS • NEW HOPE, MINNESOTA
REVISION RECORD OF PRINT ON THIS LINE
SACO PRODUCTS • NEW HOPE, MINNESOTA
REVISION RECORD OF PRINT ON THIS LINE
SACO PRODUCTS • NEW HOPE, MINNESOTA
REVISION RECORD OF PRINT ON THIS LINE


5+93 MAIN STREET

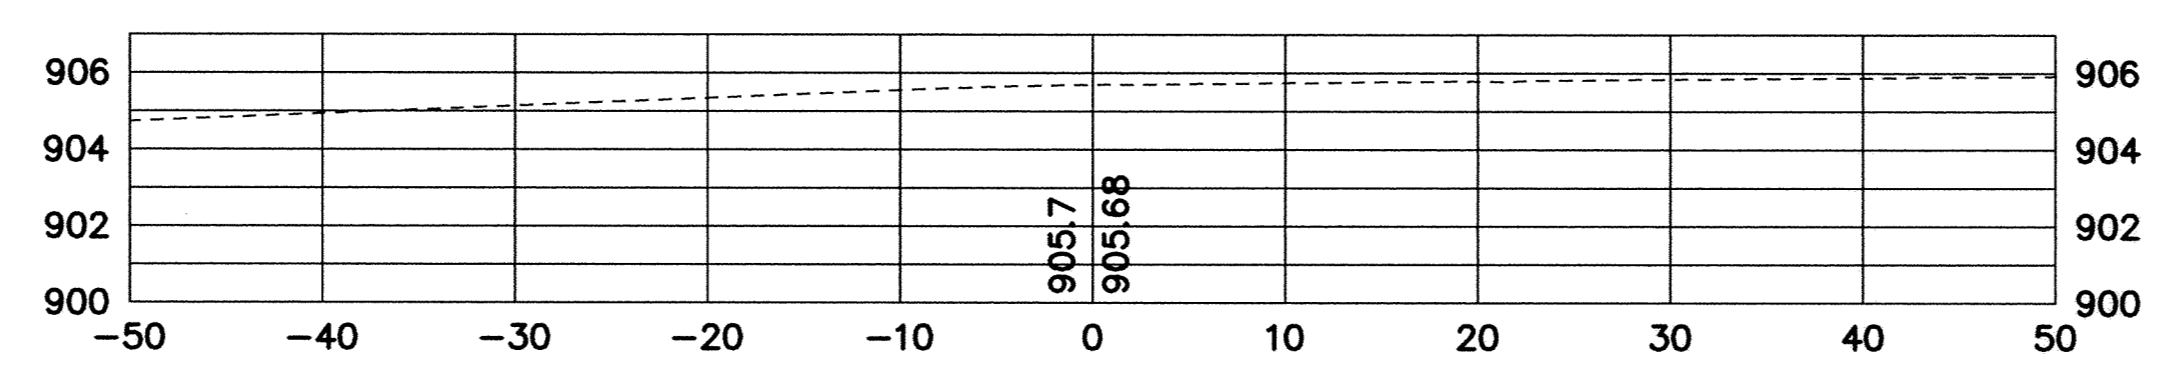


5+70.70

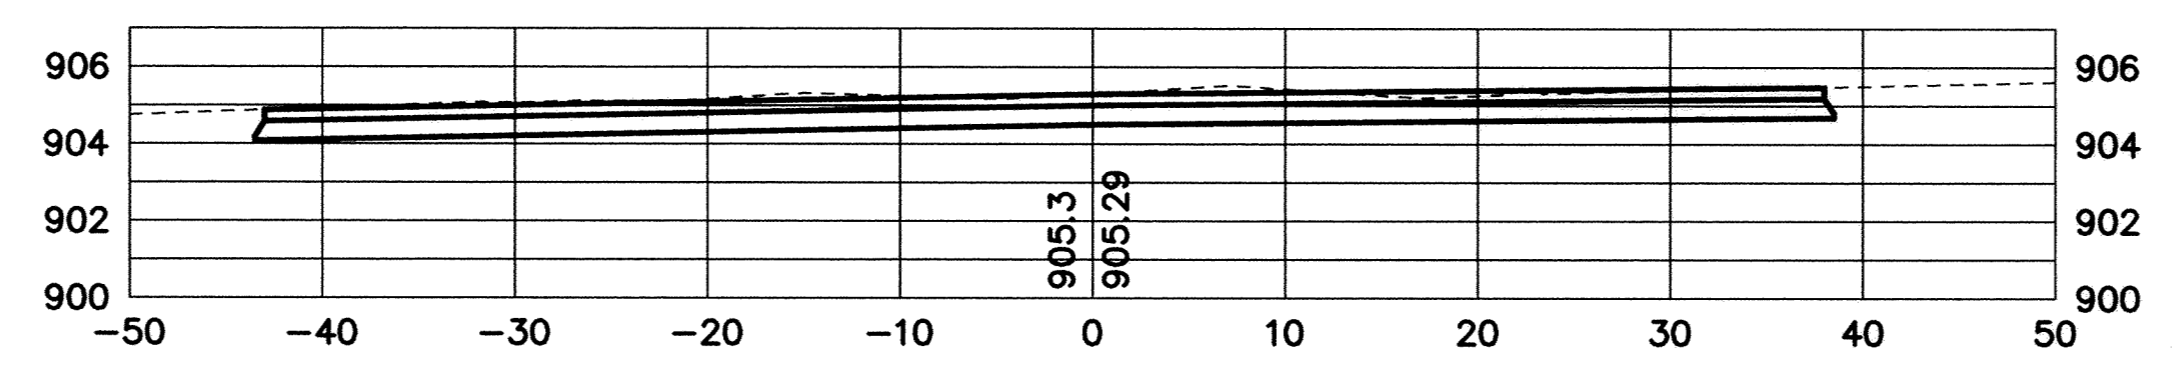

5+50

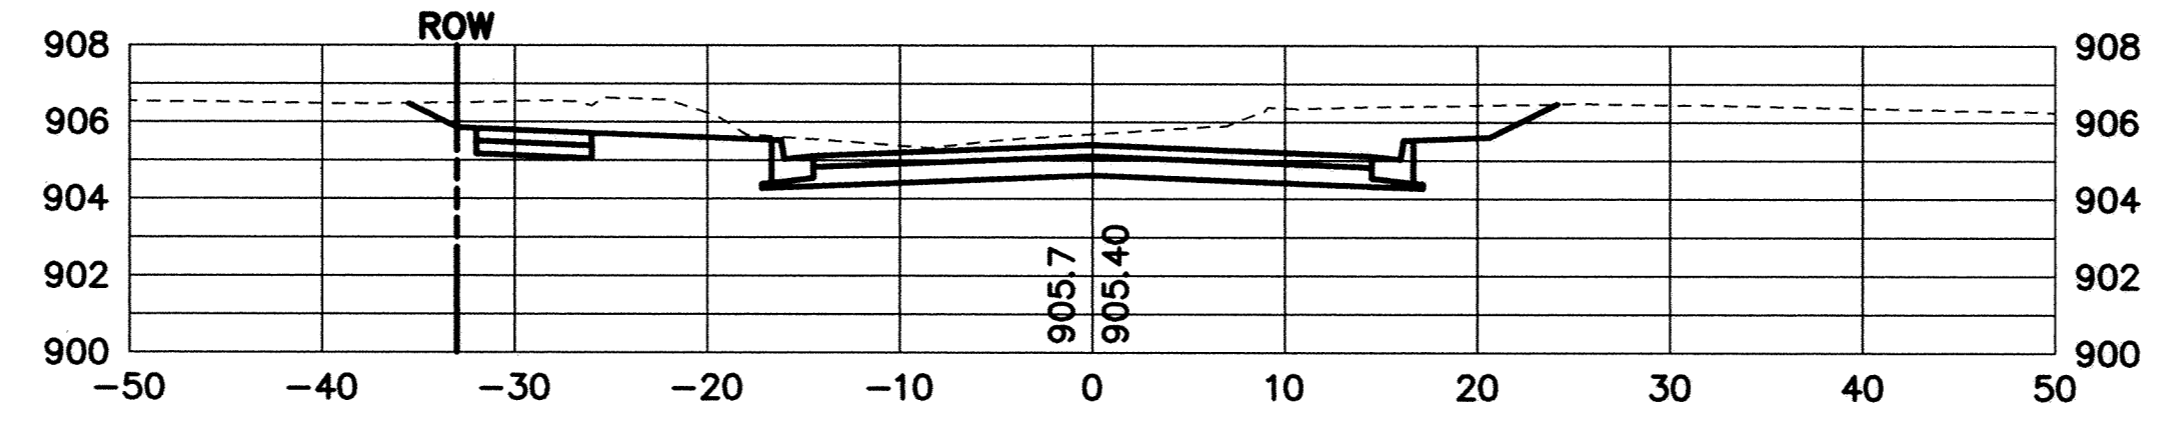

RECORD PLAN
APRIL 2004

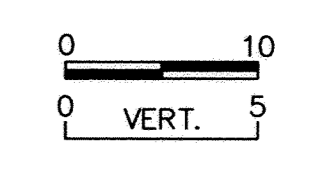

Xref: XSECT-BASE.DWG
 DESIGNED BY: DESIGNED BY DRAWN BY: RKM
 APPROVED BY: APPROVED BY JOB NUMBER 818980J
 CAD DATE: April 14, 2003 11:12:40 a.m.
 CAD FILE: 818980J\Draw\C\CT-X12.DWG (RMONJEA)

I HEREBY CERTIFY THAT THIS PLAN, SPECIFICATION, OR REPORT WAS PREPARED BY ME OR UNDER MY DIRECT SUPERVISION AND THAT I AM A DULY LICENSED PROFESSIONAL ENGINEER UNDER THE LAWS OF THE STATE OF MINNESOTA.
 SIGNATURE _____ DATE _____
 PRINTED NAME KRISTINA J THOMPSON LIC. NO. 42350

NO.	DATE	BY	REVISION DESCRIPTION



1326 ENERGY PARK DRIVE
ST. PAUL, MINNESOTA 55108
(651) 644-4389

Howard R. Green Company

2003 STREET IMPROVEMENTS
CITY OF ELK RIVER

CROSS SECTIONS
NORFOLK AVENUE
5+50 TO 5+93

SHEET NO.
36