
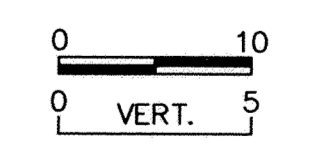
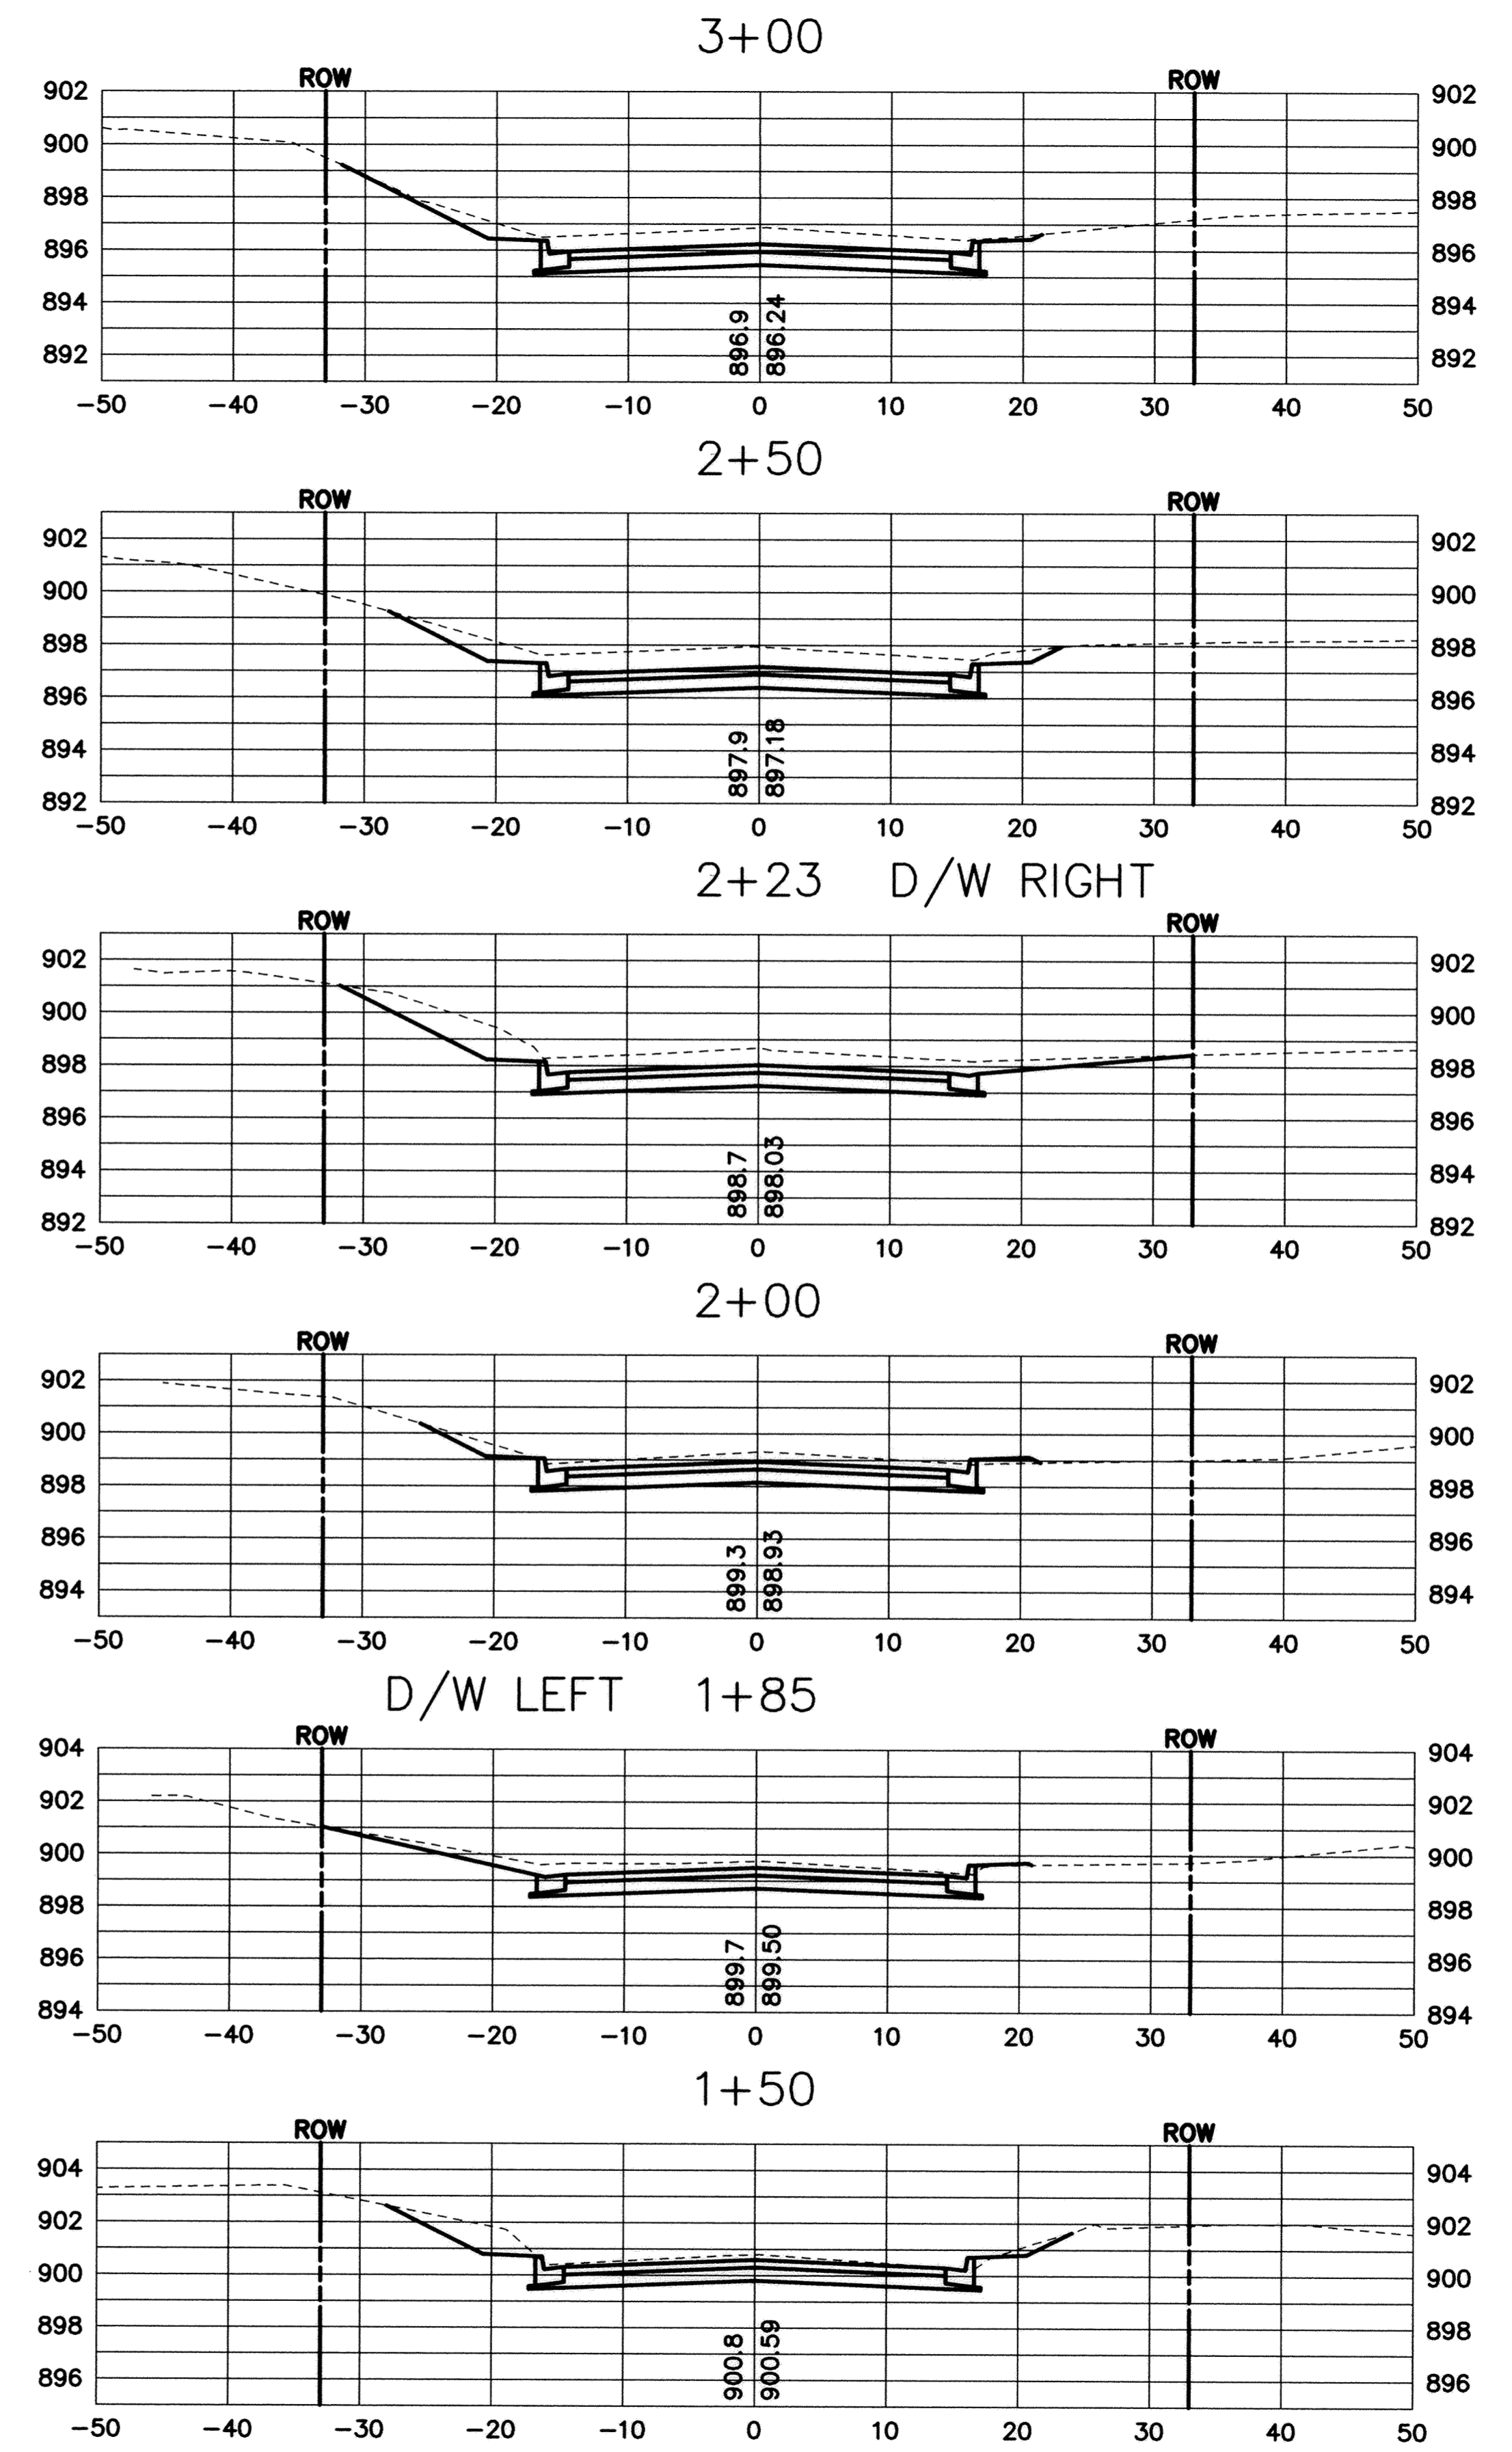


SACCO PRODUCTS • NEW HOPE, MINNESOTA
REVISION BY PART NUMBER 8952
SACCO PRODUCTS • NEW HOPE, MINNESOTA
REVISION BY PART NUMBER 8952
SACCO PRODUCTS • NEW HOPE, MINNESOTA
REVISION BY PART NUMBER 8952
SACCO PRODUCTS • NEW HOPE, MINNESOTA
REVISION BY PART NUMBER 8952

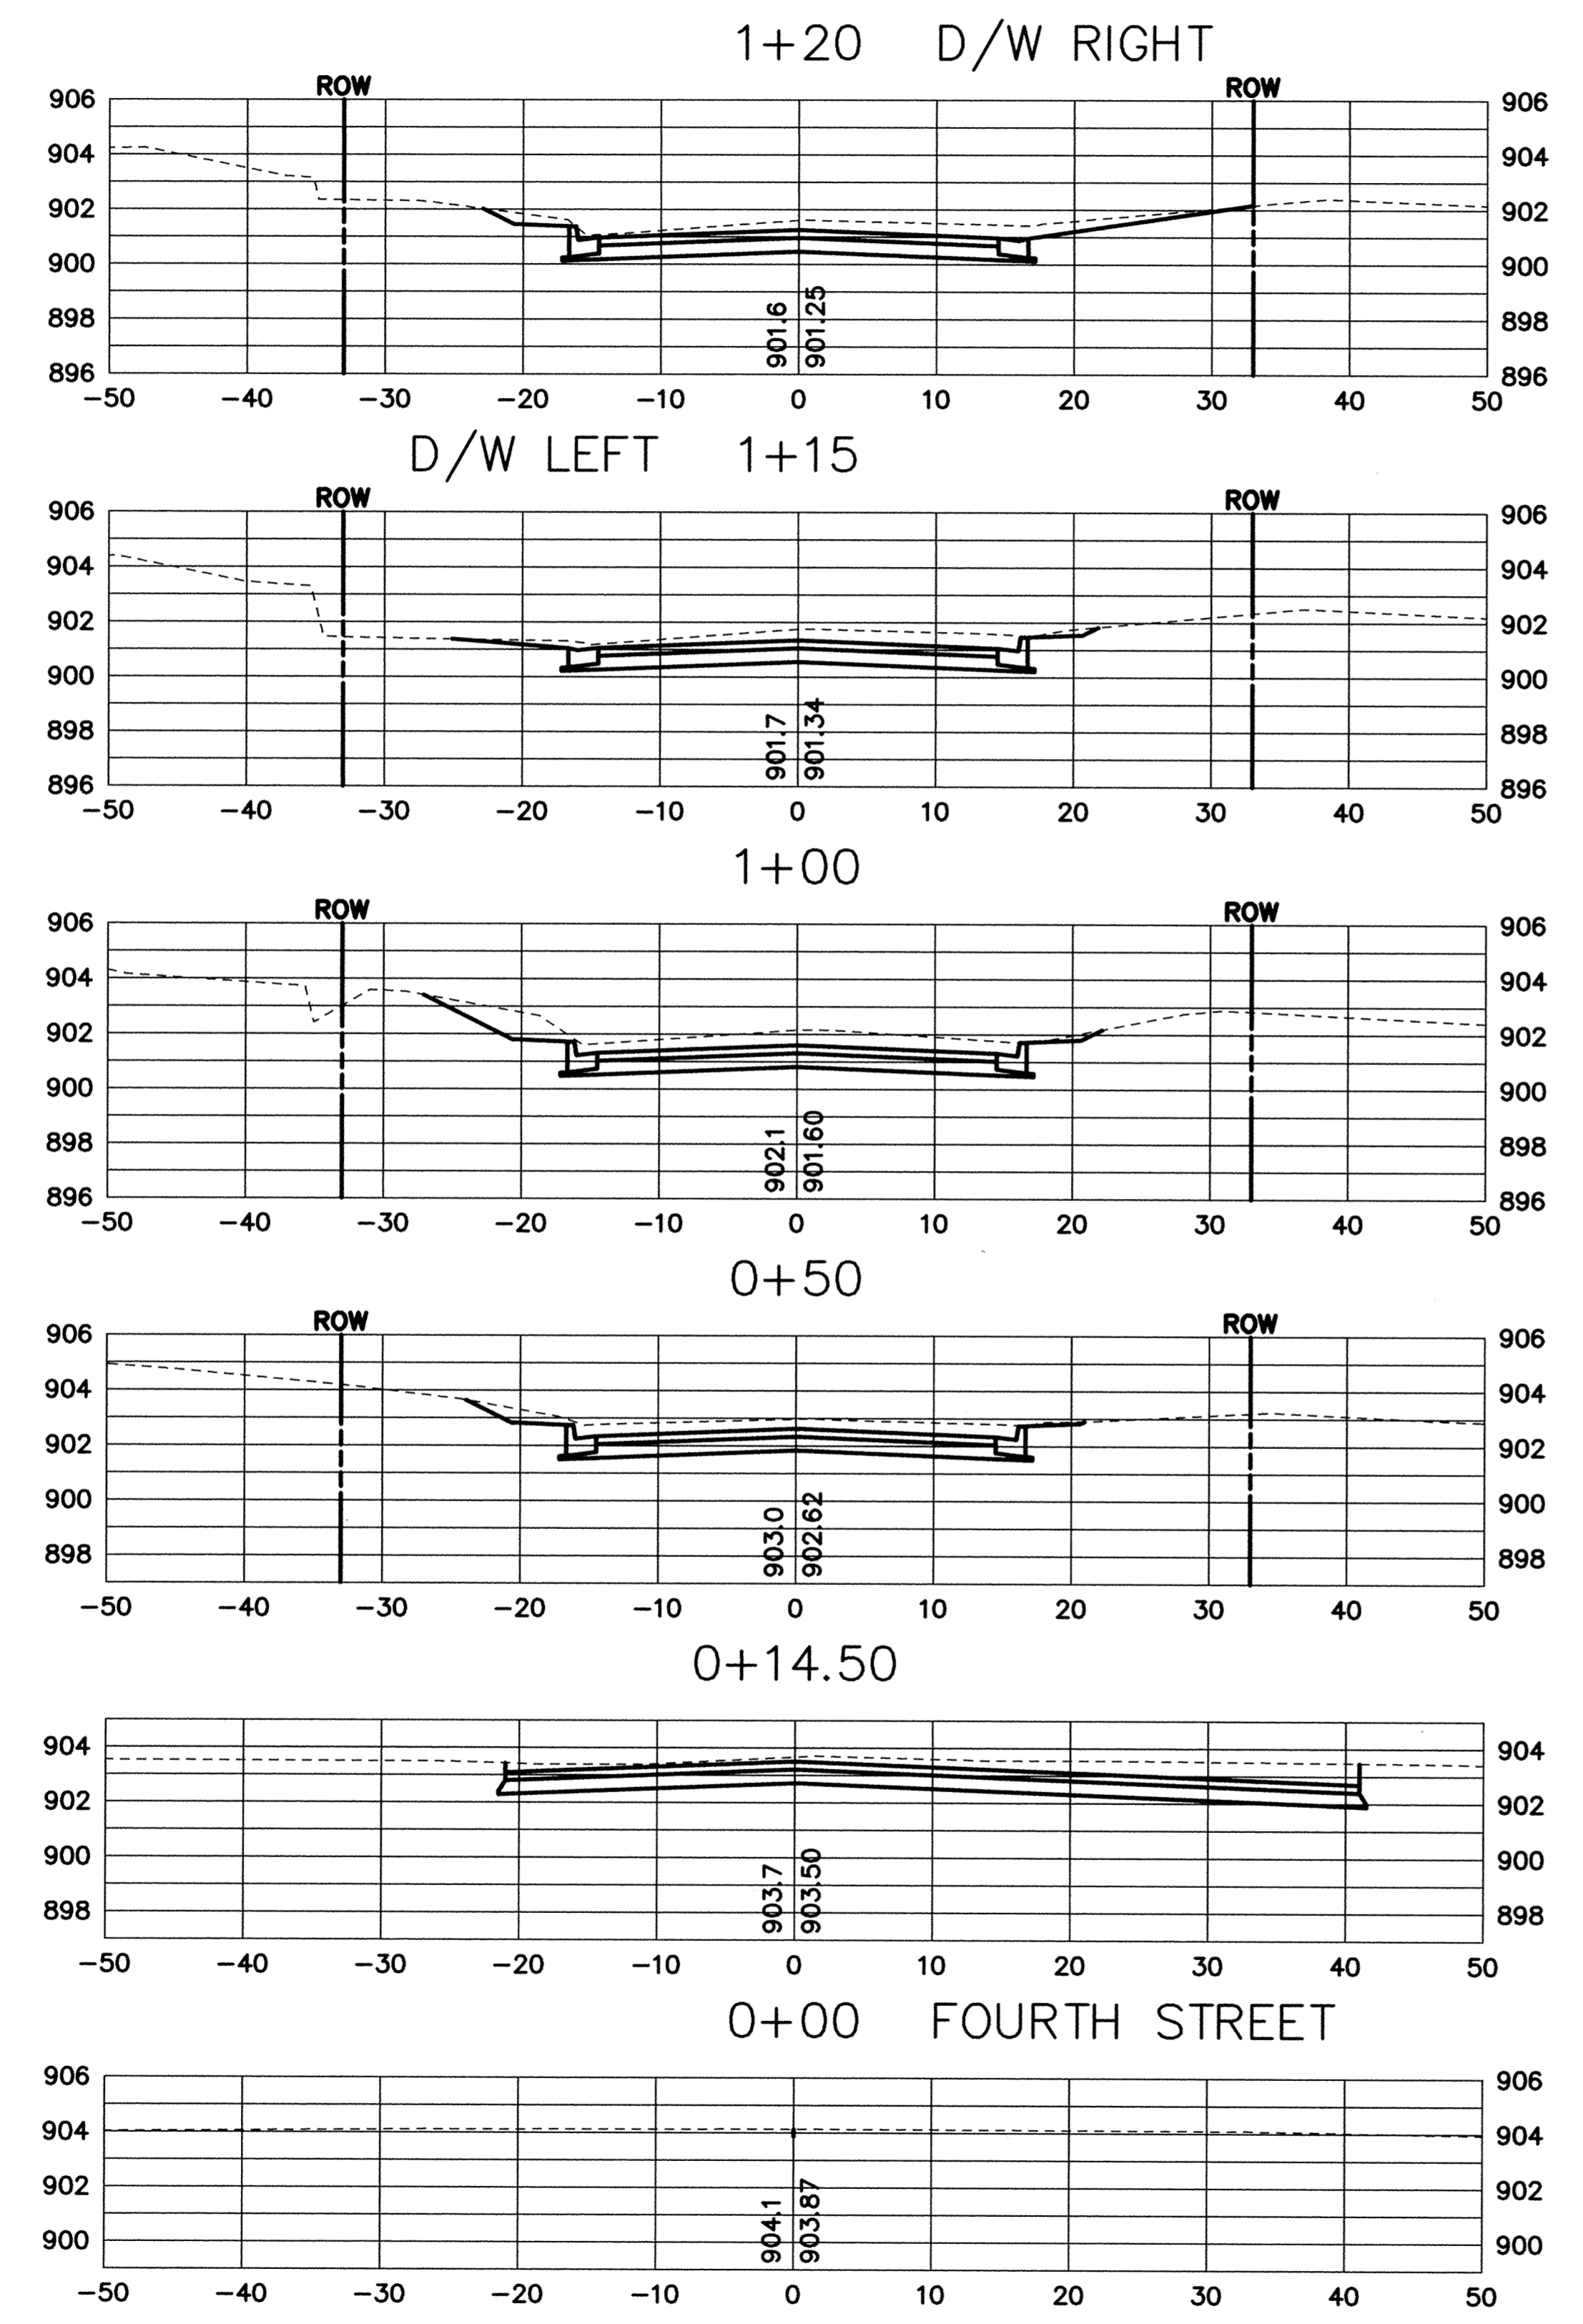

RECORD PLAN
APRIL 2004

DESIGNED BY: DESIGNED BY DRAWN BY: RKM
 APPROVED BY: APPROVED BY JOB NUMBER 818980J
 CAD DATE: April 24, 2003 10:41:52 a.m.
 CAD FILE: 818980J\Drawg\C\CT-X13.DWG (RMONJEA)

I HEREBY CERTIFY THAT THIS PLAN, SPECIFICATION, OR REPORT
 WAS PREPARED BY ME OR UNDER MY DIRECT SUPERVISION AND
 THAT I AM A DULY LICENSED PROFESSIONAL ENGINEER UNDER
 THE LAWS OF THE STATE OF MINNESOTA.
 SIGNATURE _____ DATE _____
 PRINTED NAME KRISTINA J. THOMPSON LIC. NO. 42350

NO.	DATE	BY	REVISION DESCRIPTION

 Howard R. Green Company
 1326 ENERGY PARK DRIVE
 ST. PAUL, MINNESOTA 55108
 (651) 644-4389

2003 STREET IMPROVEMENTS
 CITY OF ELK RIVER

CROSS SECTIONS
 MORTON AVENUE
 0+00 TO 3+00

SHEET NO.
37
 DRAWING NUMBER
 '03/MP.R.04