



SAECO PRODUCTS • NEW HOPE, MINNESOTA
REVISION BY PART NUMBER 8525
SAECO PRODUCTS • NEW HOPE, MINNESOTA
REVISION BY PART NUMBER 8525
SAECO PRODUCTS • NEW HOPE, MINNESOTA
REVISION BY PART NUMBER 8525
SAECO PRODUCTS • NEW HOPE, MINNESOTA
REVISION BY PART NUMBER 8525


1+50 TRUNK HIGHWAY NO. 10

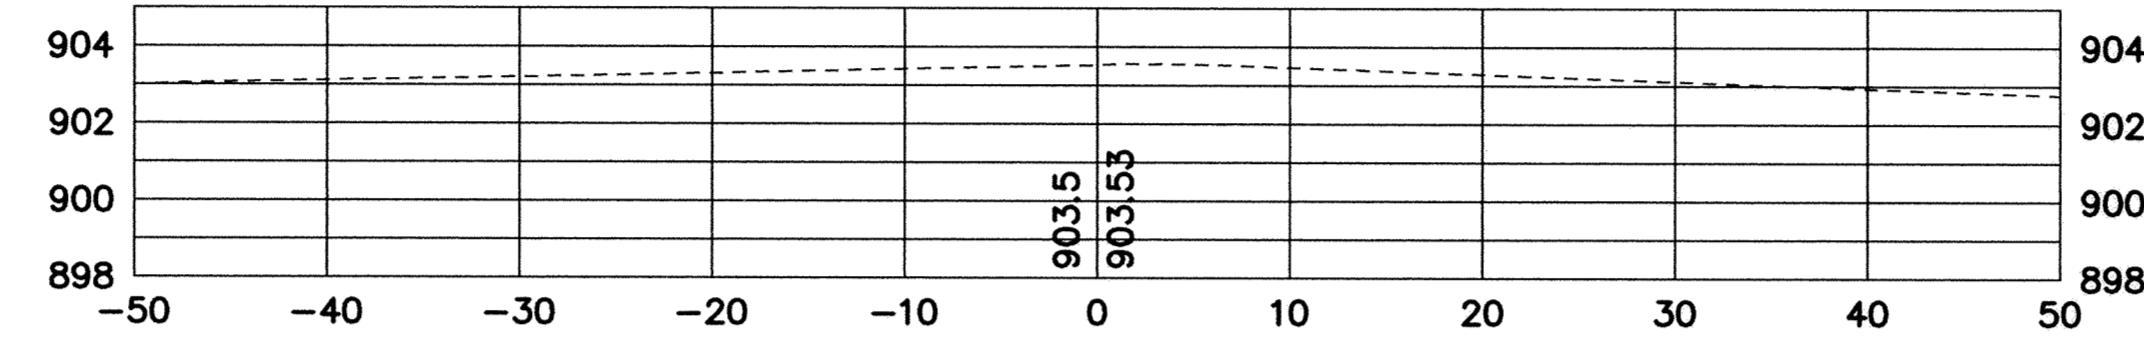


1+02.53

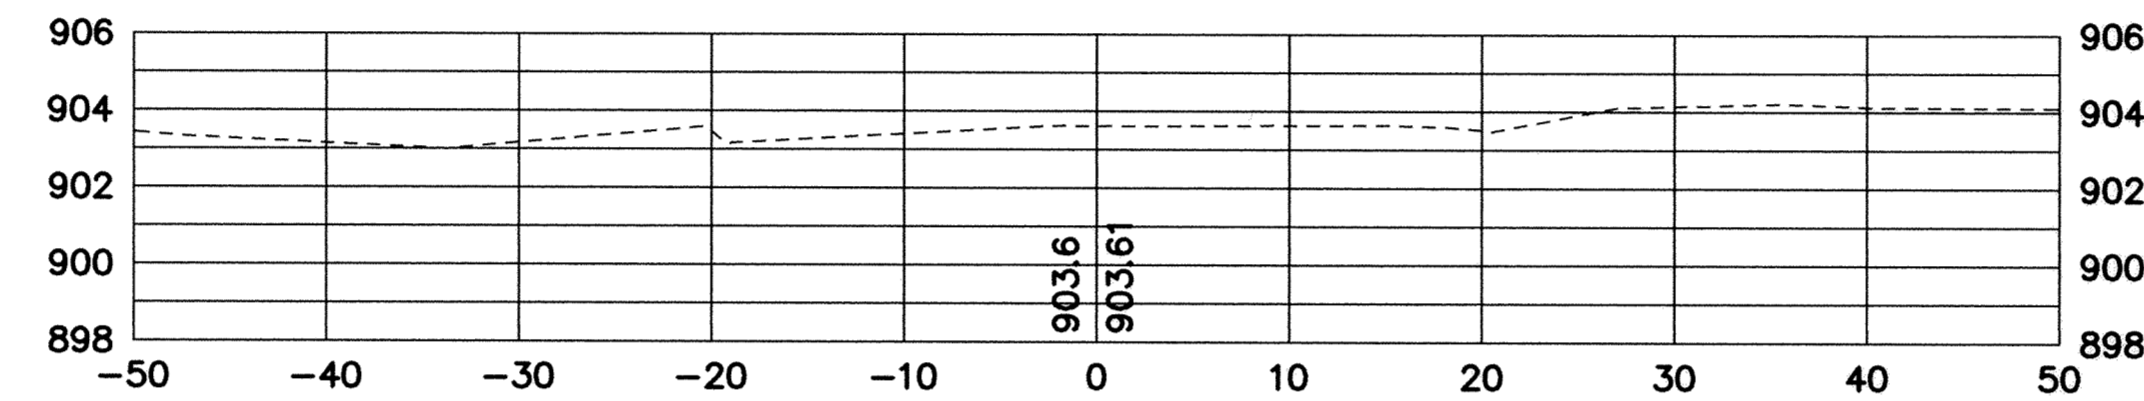


1+00

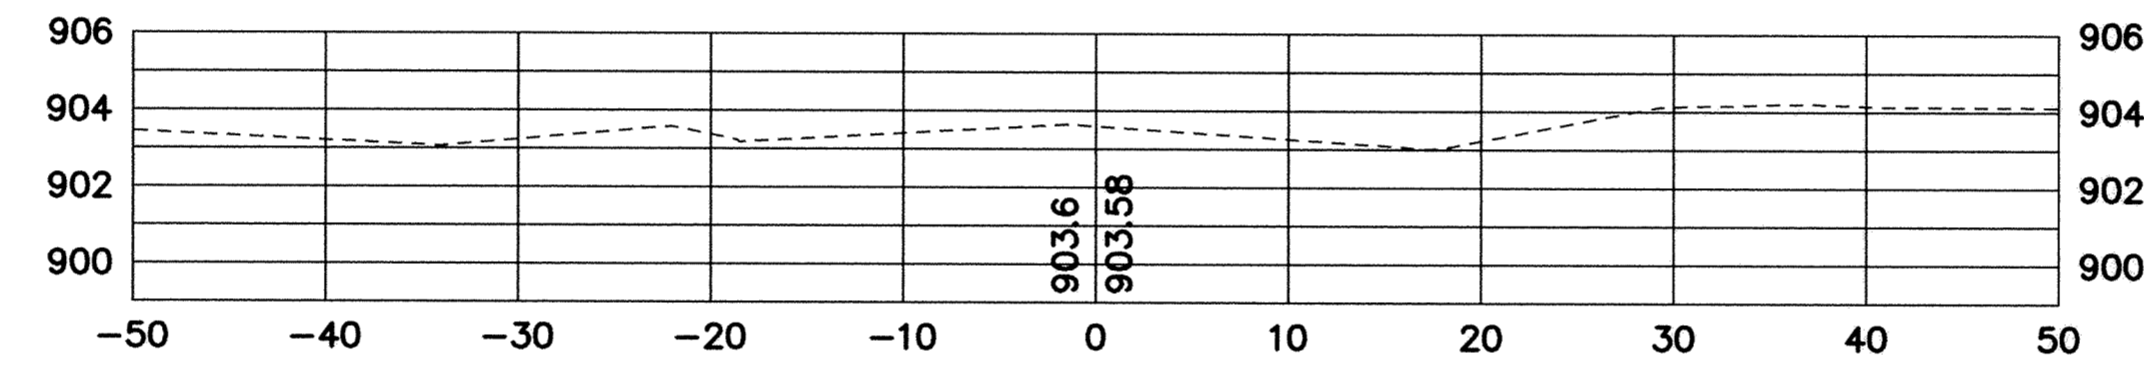


0+50

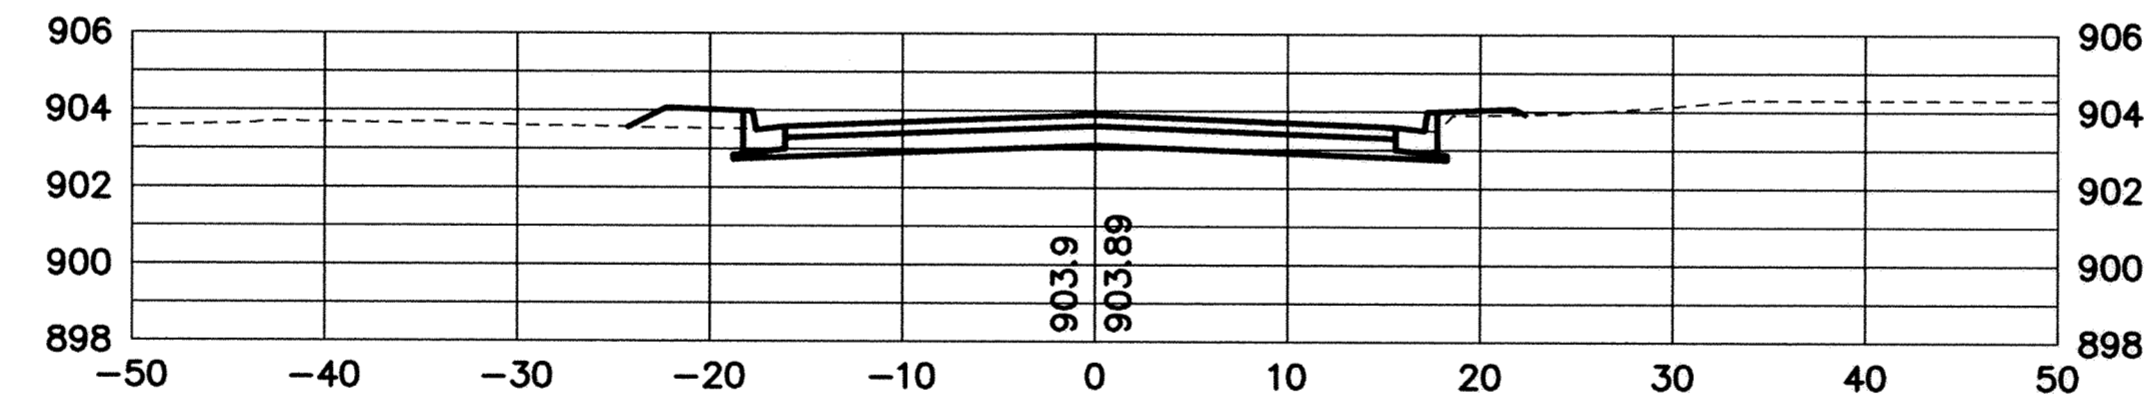

0+00 FOURTH STREET

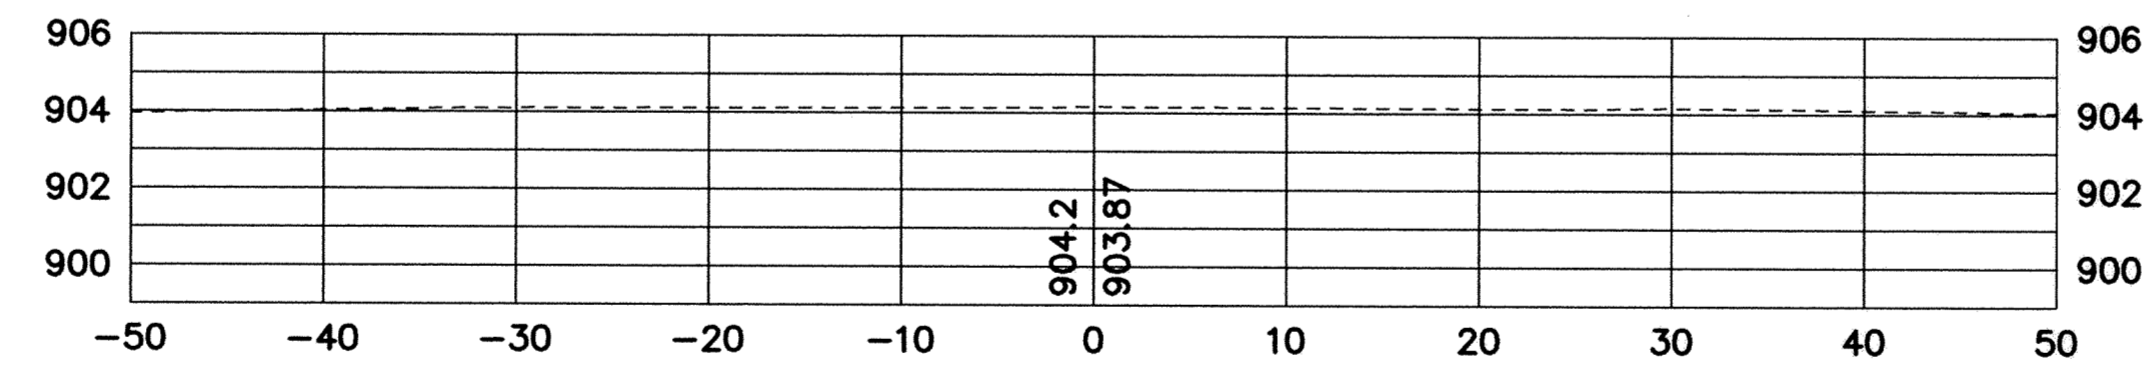

RECORD PLAN
APRIL 2004

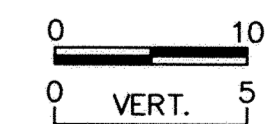

DESIGNED BY: DESIGNED BY DRAWN BY: RKM
 APPROVED BY: APPROVED BY JOB NUMBER 818980J
 CAD DATE: April 14, 2003 11:17:07 a.m.
 CAD FILE: 818980J\Dwg\C\CT-X15.DWG (RMONJEA)

I HEREBY CERTIFY THAT THIS PLAN, SPECIFICATION, OR REPORT WAS PREPARED BY ME OR UNDER MY DIRECT SUPERVISION AND THAT I AM A DULY LICENSED PROFESSIONAL ENGINEER UNDER THE LAWS OF THE STATE OF MINNESOTA.
 SIGNATURE _____ DATE _____
 PRINTED NAME KRISTINA J. THOMPSON LIC. NO. 42350

NO.	DATE	BY	REVISION DESCRIPTION

1326 ENERGY PARK DRIVE
 ST. PAUL, MINNESOTA 55108
 (651) 644-4389

 Howard R. Green Company

2003 STREET IMPROVEMENTS
CITY OF ELK RIVER

CROSS SECTIONS
MORTON AVENUE (NORTH OF 4TH STREET)
0+00 TO 1+50

SHEET NO.
39

Xref: XSect-BASE.DWG