

MORTON AVENUE

STATION	AREAS Square Feet		VOLUMES Cubic Yards		CUMULATIVE VOLUMES Cubic Yards	
	CUT	FILL	CUT	FILL	CUT	FILL
0+00	0.00	0.00	20.24	0.00	20.24	0.00
0+14.50	75.39	0.00	77.70	0.00	97.94	0.00
0+50	42.79	0.00	85.21	0.03	183.15	0.04
1+00	49.23	0.03	24.95	0.01	208.09	0.05
1+15	40.58	0.00	7.74	0.00	215.84	0.05
1+20	43.05	0.00	45.54	0.18	261.38	0.23
1+50	38.93	0.33	50.44	0.42	311.82	0.65
1+85	38.90	0.32	21.62	0.35	333.44	1.00
2+00	38.92	0.94	42.73	0.40	376.17	1.40
2+23	61.40	0.00	59.67	0.00	435.84	1.40
2+50	57.93	0.00	100.18	0.00	536.02	1.40
3+00	50.26	0.00	39.46	0.00	575.48	1.40
3+20	56.29	0.00	37.44	0.00	612.92	1.40
3+38	56.03	0.00	22.68	0.00	635.60	1.40
3+50	46.05	0.00	56.05	0.52	691.65	1.92
3+85	40.43	0.80	20.00	0.72	711.66	2.64
4+00	31.58	1.78	19.12	1.14	730.78	3.78
4+17	29.15	1.83	31.81	5.89	762.59	9.66
4+50	22.90	7.80	41.22	12.83	803.81	22.49
5+00	21.62	6.06	14.29	3.47	818.10	25.96
5+30.90	3.36	0.00	1.21	0.00	819.31	25.96
5+50.34	0.00	0.00	0.00	0.00	819.31	25.96

MORTON AVENUE (NORTH OF FOURTH STREET)


STATION	AREAS Square Feet		VOLUMES Cubic Yards		CUMULATIVE VOLUMES Cubic Yards	
	CUT	FILL	CUT	FILL	CUT	FILL
0+00	0.32	0.00	26.38	2.98	26.38	2.98
0+50	28.17	3.21	26.09	2.98	52.47	5.95
1+00	0.00	0.00	0.00	0.00	52.47	5.95

**RECORD PLAN
APRIL 2004**

Xref: XSECT-BASE.DWG
 DESIGNED BY: DESIGNED BY DRAWN BY: RKM
 APPROVED BY: APPROVED BY JOB NUMBER 818980J
 CAD DATE: March 31, 2004 7:43:41 a.m.
 CAD FILE: 818980J\As-built\CT-XVOL2.DWG (TELGAAR)

I HEREBY CERTIFY THAT THIS PLAN, SPECIFICATION, OR REPORT WAS PREPARED BY ME OR UNDER MY DIRECT SUPERVISION AND THAT I AM A DULY LICENSED PROFESSIONAL ENGINEER UNDER THE LAWS OF THE STATE OF MINNESOTA.
 SIGNATURE _____ DATE _____
 PRINTED NAME KRISTINA J THOMPSON LIC. NO. 42350

NO.	DATE	BY	REVISION DESCRIPTION

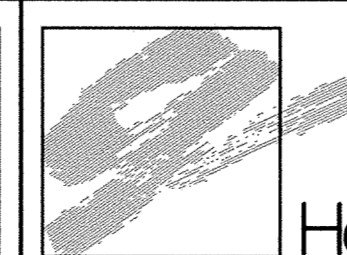

1326 ENERGY PARK DRIVE
ST. PAUL, MINNESOTA 55108
(651) 644-4389
Howard R. Green Company

**2003 STREET IMPROVEMENTS
CITY OF ELK RIVER**

CROSS SECTIONS
VOLUMES

SHEET NO.
41