


SDCO PRODUCTS • NEW UPR, MINNESOTA  
REVISION BY PART NUMBER 652

SDCO PRODUCTS • NEW UPR, MINNESOTA  
REVISION BY PART NUMBER 652

SDCO PRODUCTS • NEW UPR, MINNESOTA  
REVISION BY PART NUMBER 652

SDCO PRODUCTS • NEW UPR, MINNESOTA  
REVISION BY PART NUMBER 652

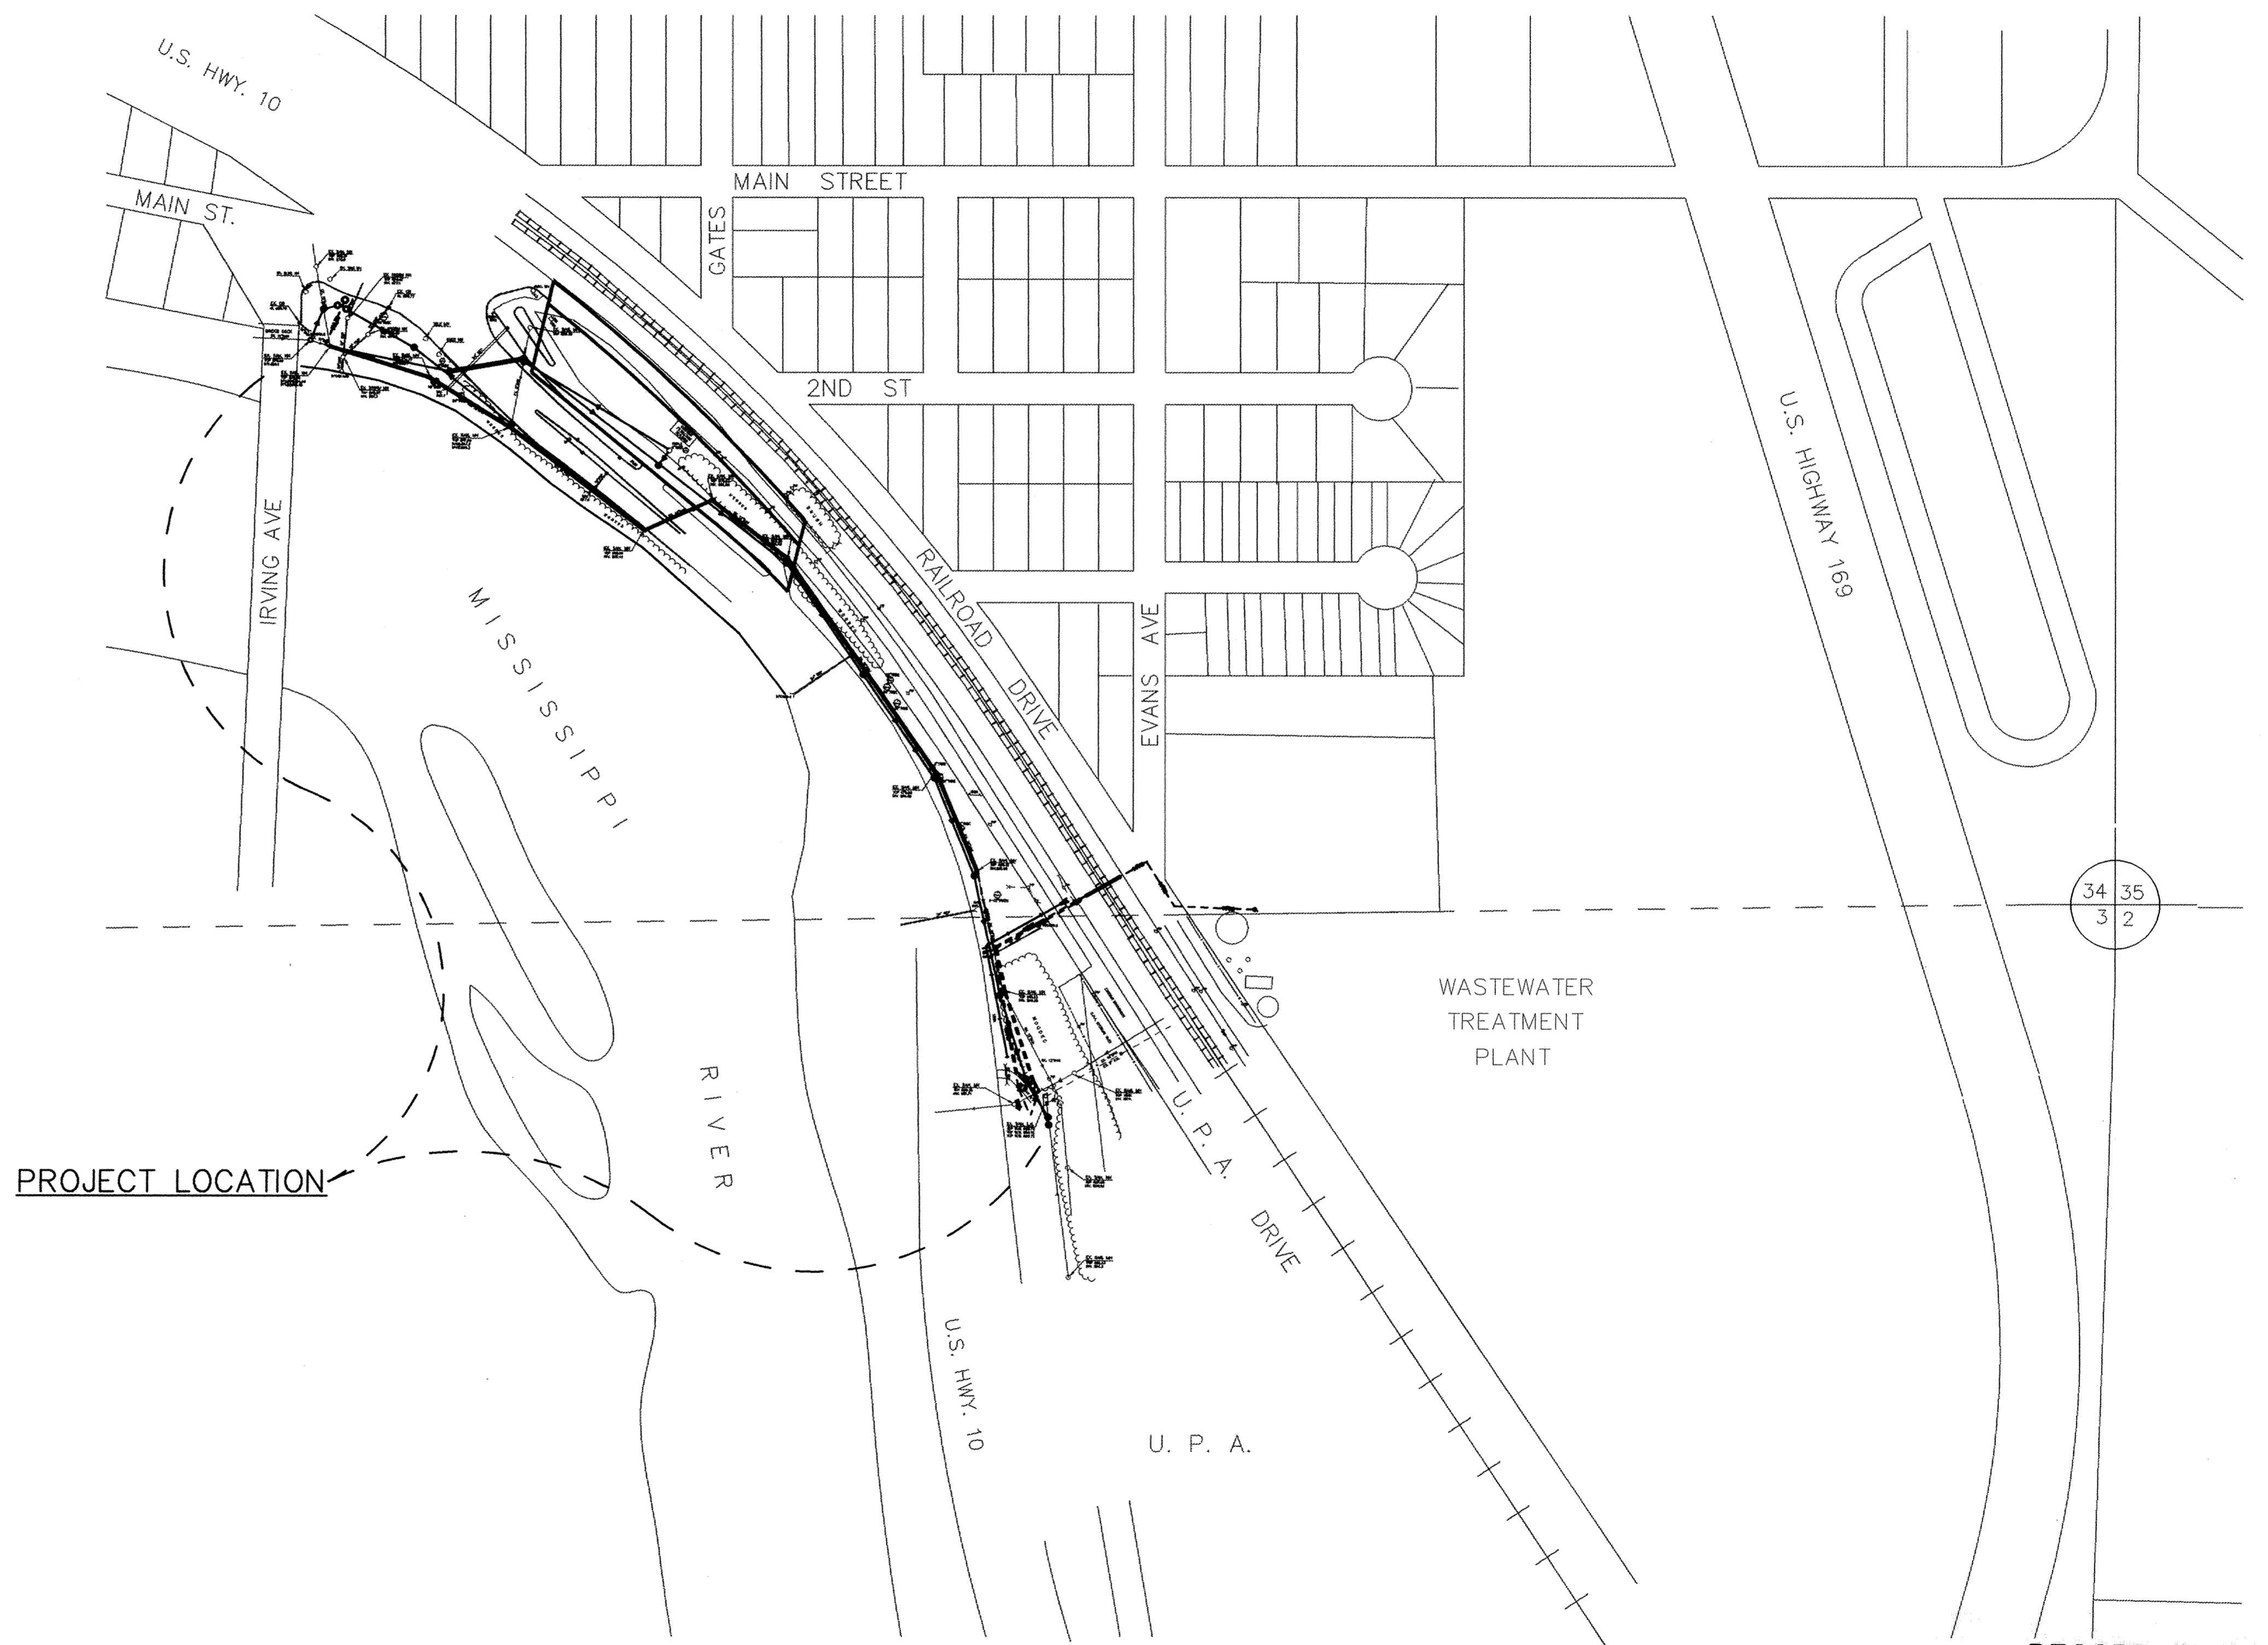

RECORD PLAN  
JUNE 1994

I HEREBY CERTIFY THAT THIS PLAN, SPECIFICATION, OR REPORT WAS PREPARED BY ME OR UNDER MY DIRECT SUPERVISION AND THAT I AM A DULY REGISTERED PROFESSIONAL ENGINEER UNDER THE LAWS OF THE STATE OF MINNESOTA.

*Paul A. Davis*  
DATE 8/24/93 REG. NO. 14974

**MS&A** CONSULTING ENGINEERS  
Maier Stewart & Associates Inc.

1959 SLOAN PLACE (612) 774-6021 ST. PAUL, MINNESOTA 55117  
9800 SHELARD PARKWAY (612) 546-0432 MINNEAPOLIS, MINNESOTA 55441

DATE	DESCRIPTION	DESIGNED	CHECKED	DRAWN

REVISIONS

CITY OF ELK RIVER  
HIGHWAY 10 LIFT STATION  
LOCATION MAP

GRAPHIC SCALE  
HORIZ. NA  
VERT. NA

DATE AUG 1993 SHEET 2 OF 20 SHEETS PROJECT NO. 230-178