


NOTE:
PROTECT ALL BURIED UTILITIES
DURING CONSTRUCTION

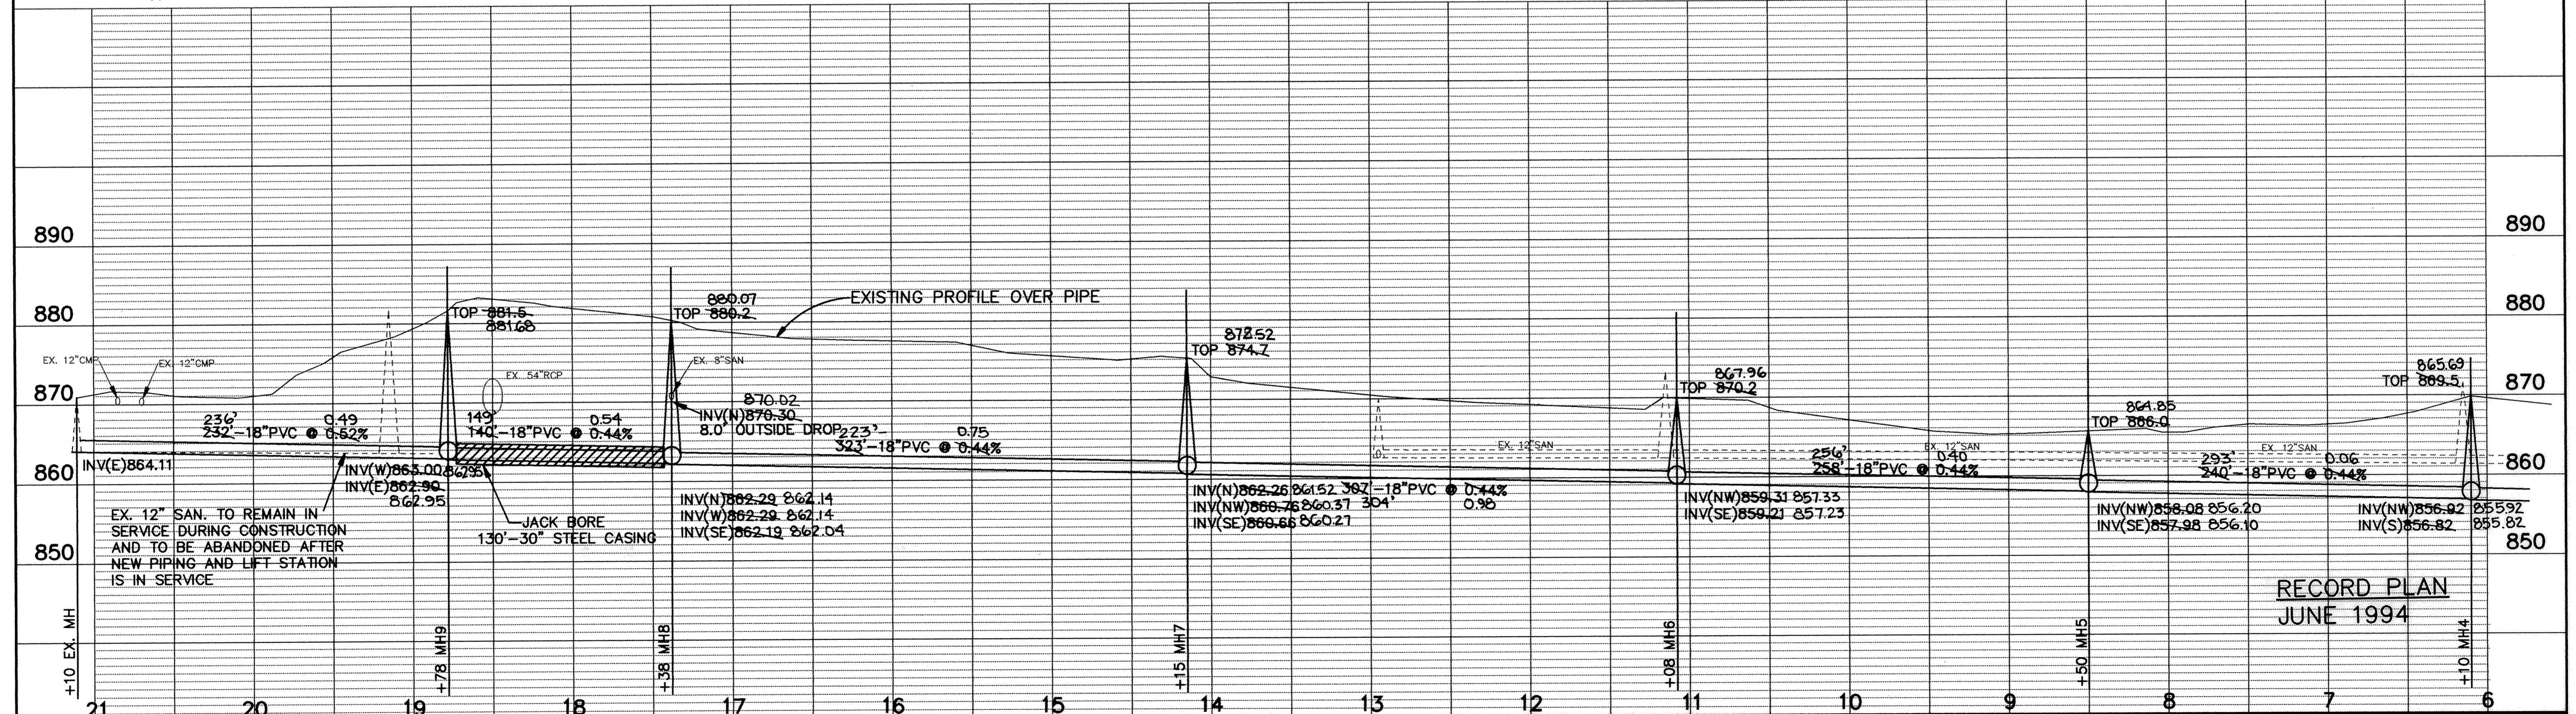

RECORD PLAN
JUNE 1994

I HEREBY CERTIFY THAT THIS PLAN, SPECIFICATION, OR REPORT WAS PREPARED BY ME OR UNDER MY DIRECT SUPERVISION AND THAT I AM A DULY REGISTERED PROFESSIONAL ENGINEER UNDER THE LAWS OF THE STATE OF MINNESOTA. <i>Paul A. Davis</i> DATE 8/24/93 REG. NO. 14974	CONSULTING ENGINEERS Maier Stewart & Associates Inc. 1959 SLOAN PLACE (612) 774-6021 ST. PAUL, MINNESOTA 55117 9800 SHELDAR PARKWAY (612) 546-0432 MINNEAPOLIS, MINNESOTA 55441	DATE _____ DESCRIPTION _____ DESIGNED _____ CHECKED _____ DRAWN _____ GRAPHIC SCALE 0 HORIZ. 50 0 VERT. 5	CITY OF ELK RIVER HIGHWAY 10 LIFT STATION ALTERNATE 2 SHEET 1
		REVISIONS DATE _____ DESCRIPTION _____	DATE AUG 1993 SHEET 8 OF 20 SHEETS PROJECT NO. 230-178