

DRAWING NUMBER  
165AV/88  
1

DRAWING NUMBER  
165AV/88  
1

DRAWING NUMBER  
165AV/88  
1

DRAWING NUMBER  
165AV/88  
1

SAVED PRODUCTS • NEW HIRE, MINNESOTA  
REGISTERED BY PLAN NUMBER 0553

# STORM DRAINAGE AND STREET IMPROVEMENTS

## 165TH AVENUE


I HEREBY CERTIFY THAT THIS PLAN, SPECIFICATION, OR REPORT  
WAS PREPARED BY ME OR UNDER MY DIRECT SUPERVISION AND I  
AM A DULY REGISTERED PROFESSIONAL ENGINEER UNDER THE  
LAWS OF THE STATE OF MINNESOTA.

Terry J. Maier  
DATE 7/20/88 MINNESOTA REGISTRATION NO. 15314

**MSA** CONSULTING ENGINEERS  
**Maier Stewart & Associates Inc.**  
1959 SLOAN PLACE (612) 774-6021 ST. PAUL, MINNESOTA 55117



DEC 88 RECORD PLAN

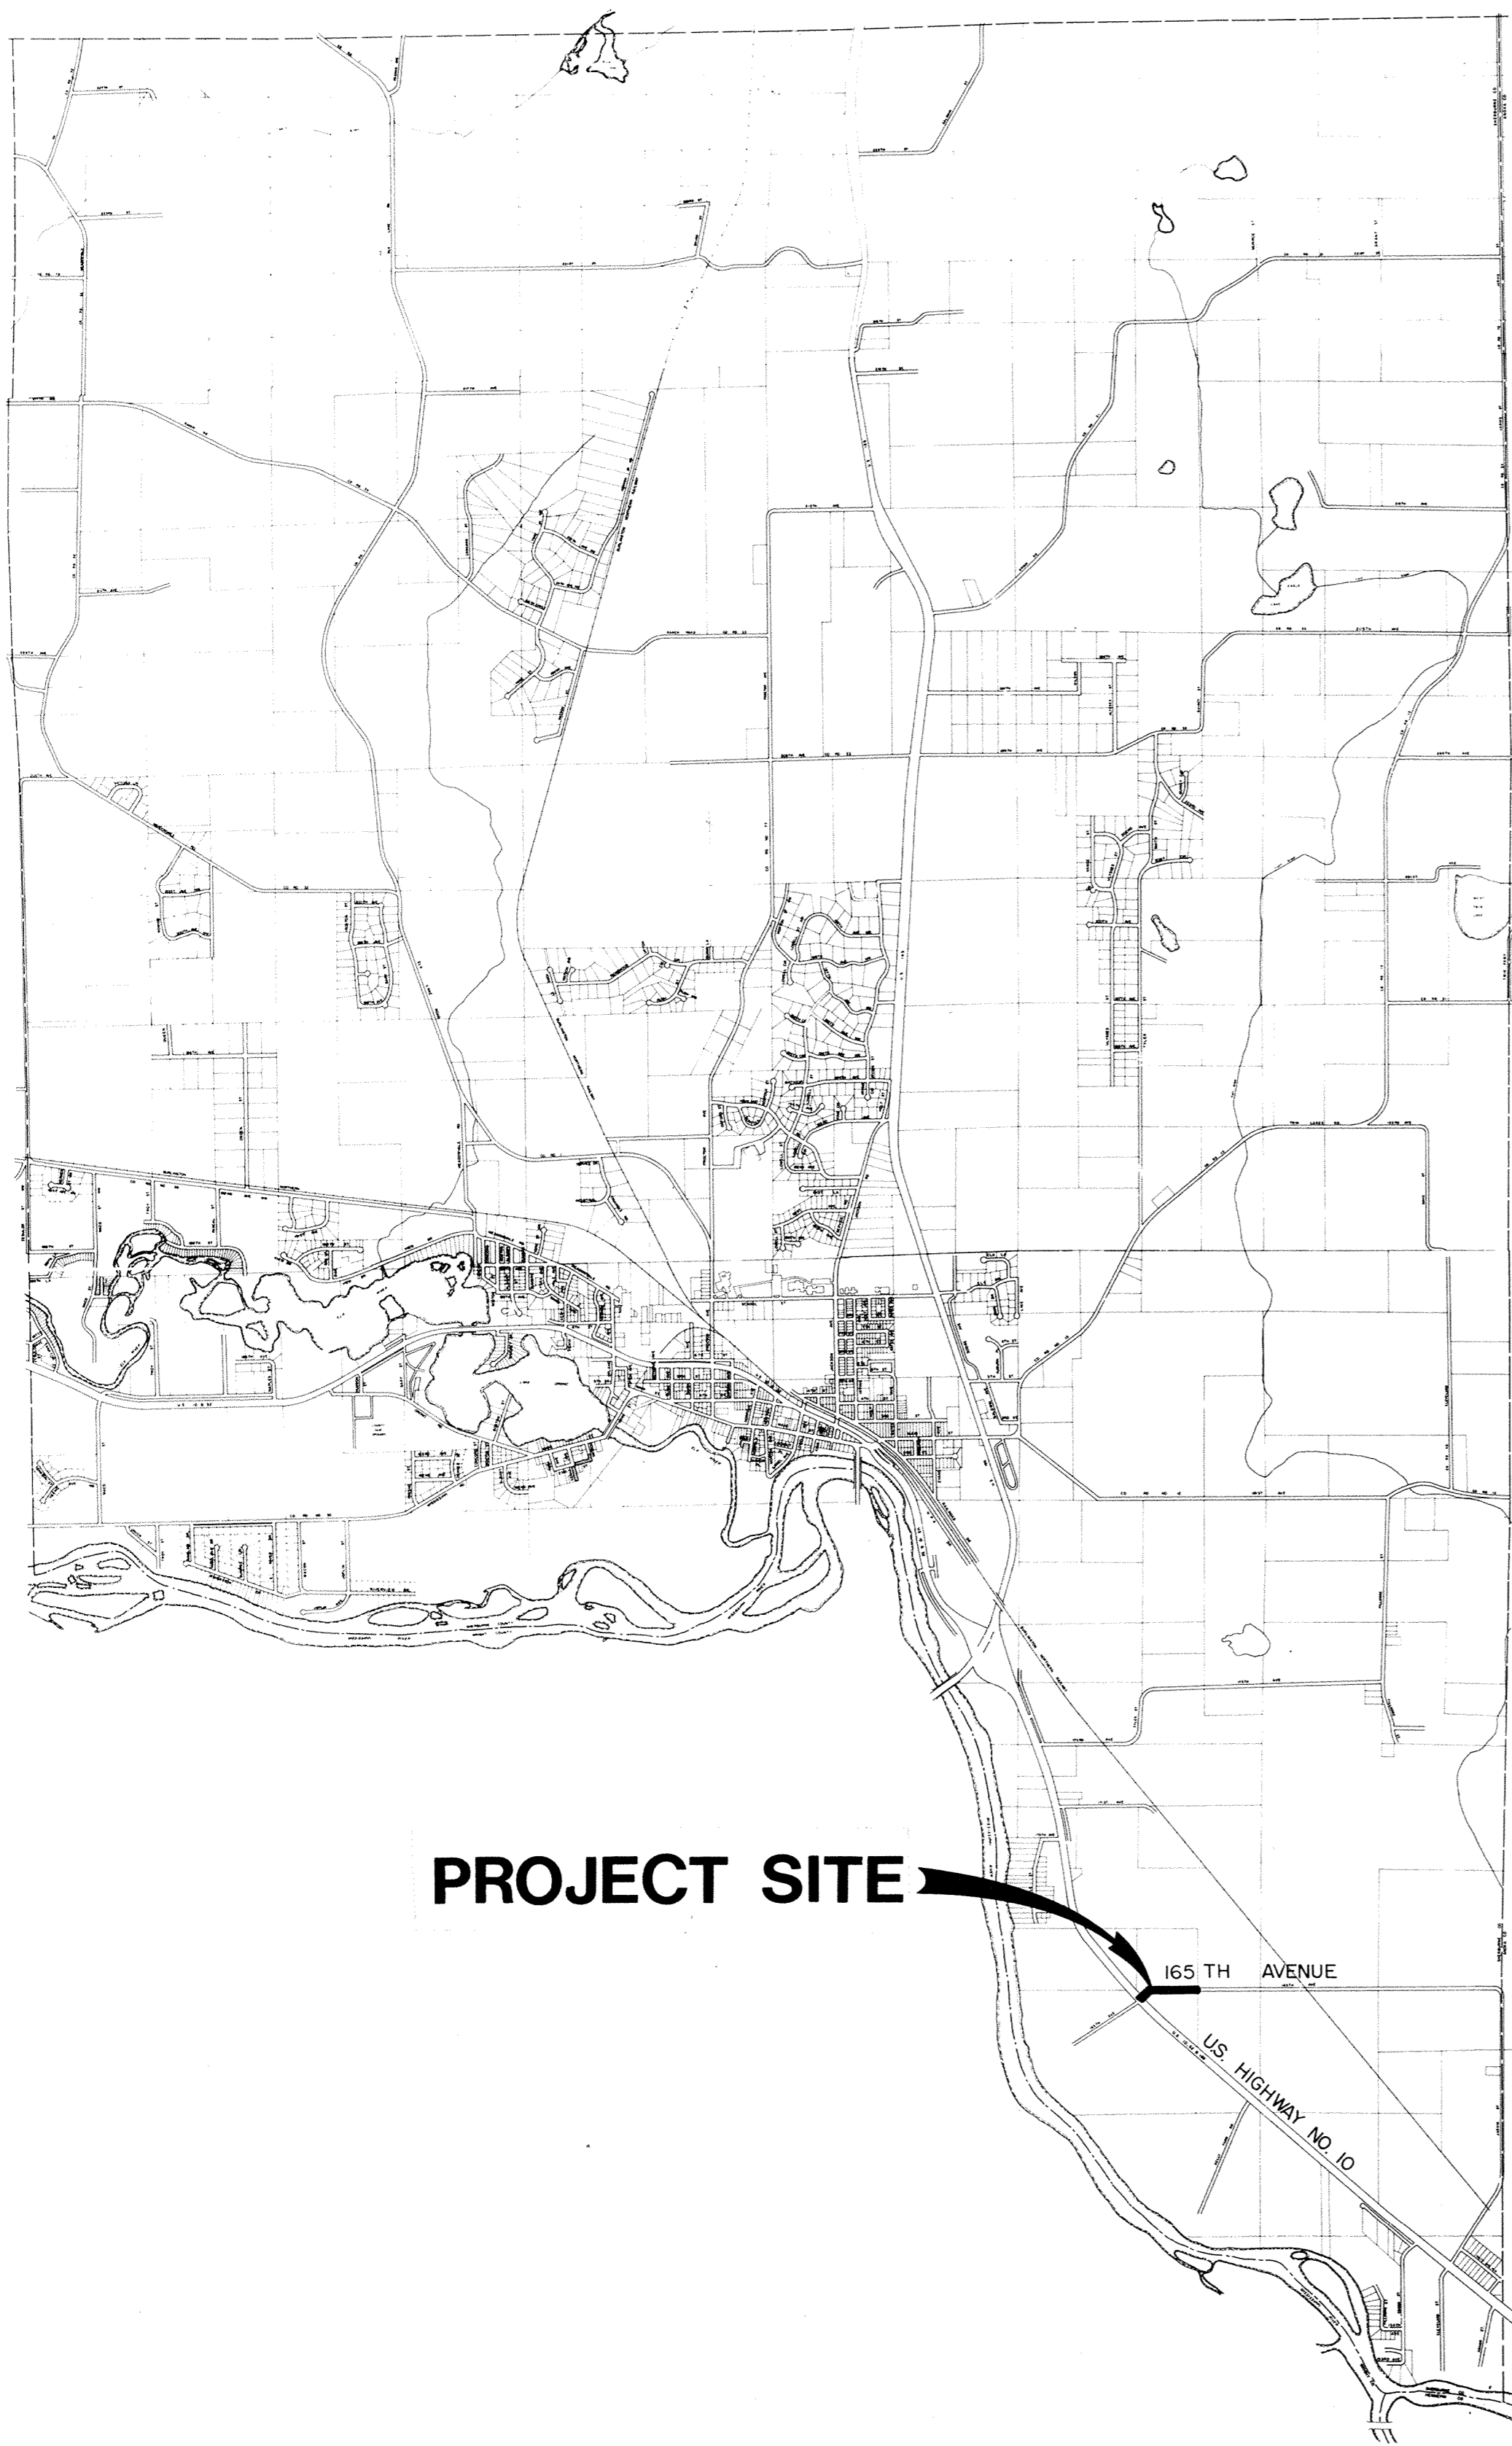

ELK RIVER  
165TH AVE  
Pg. 228-232