
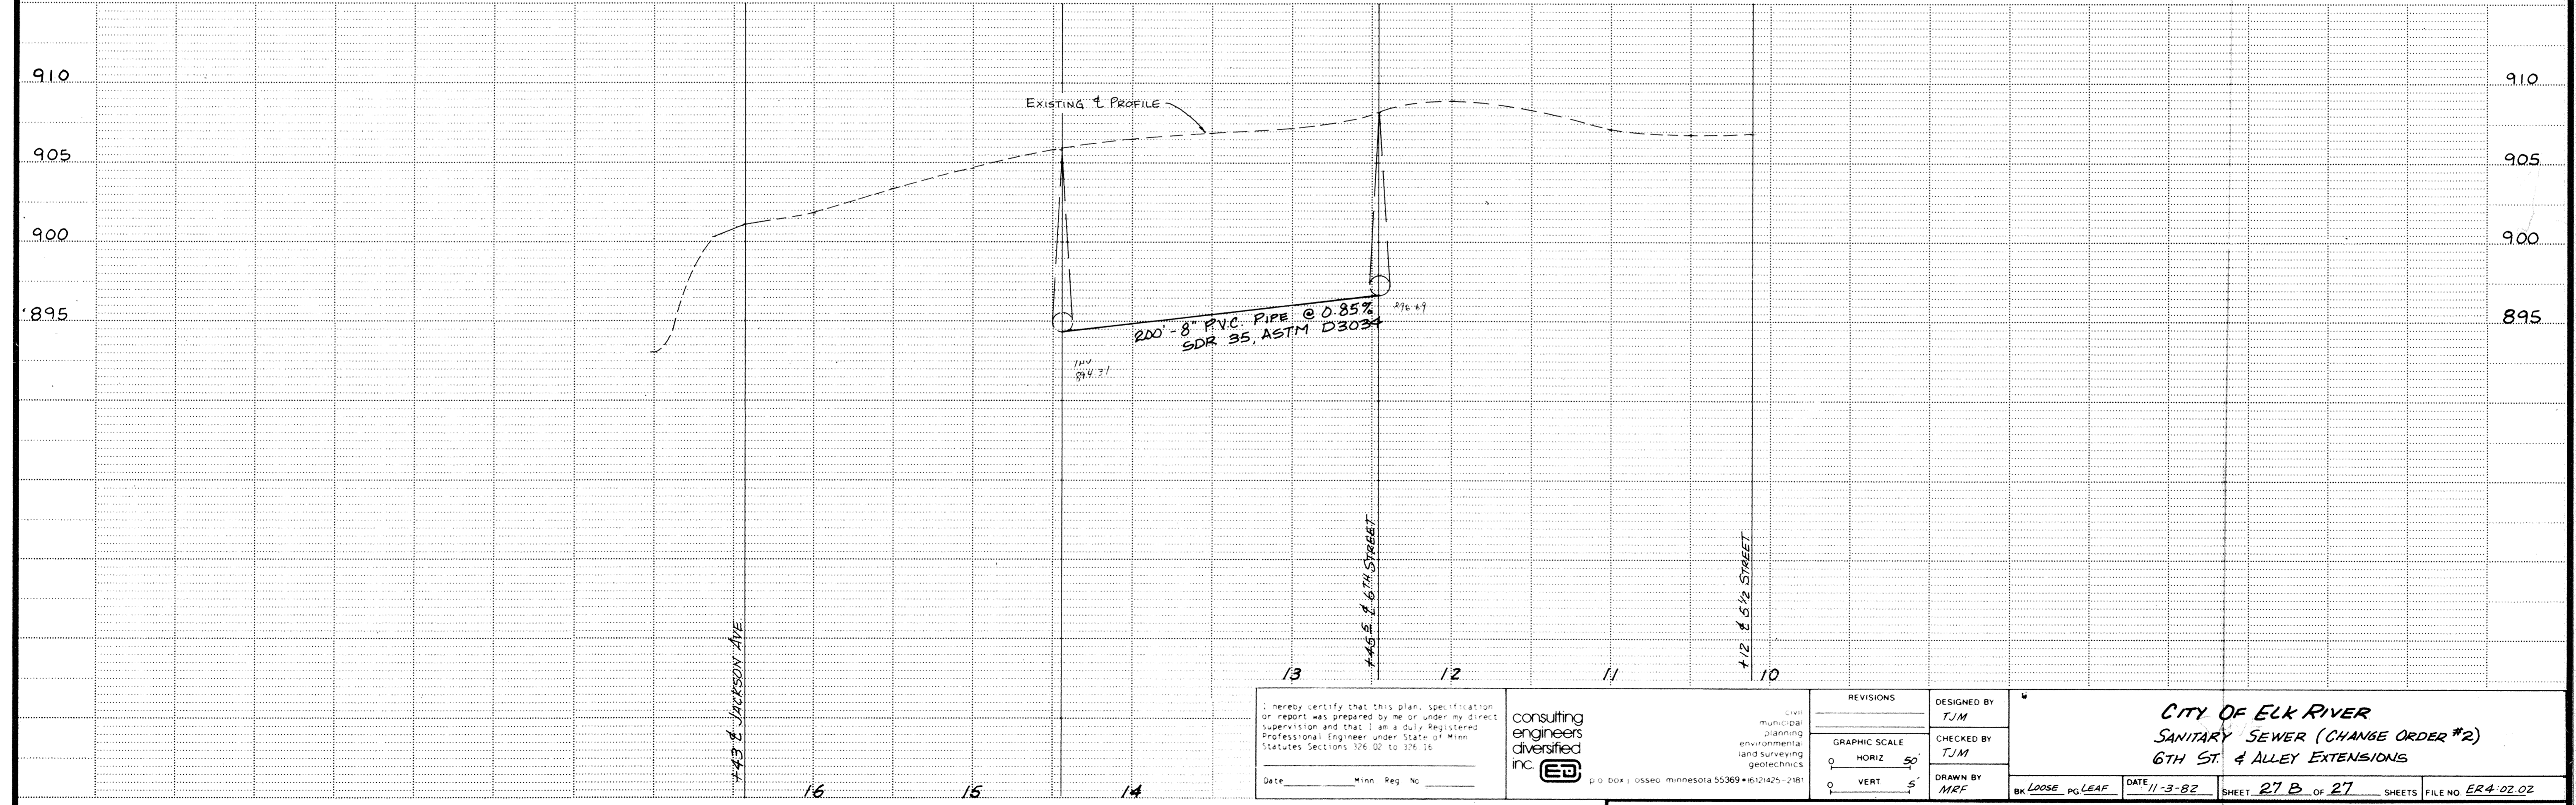
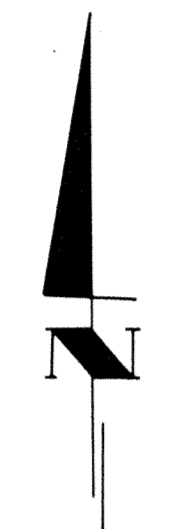


6TH STREET & IRVING AVENUE

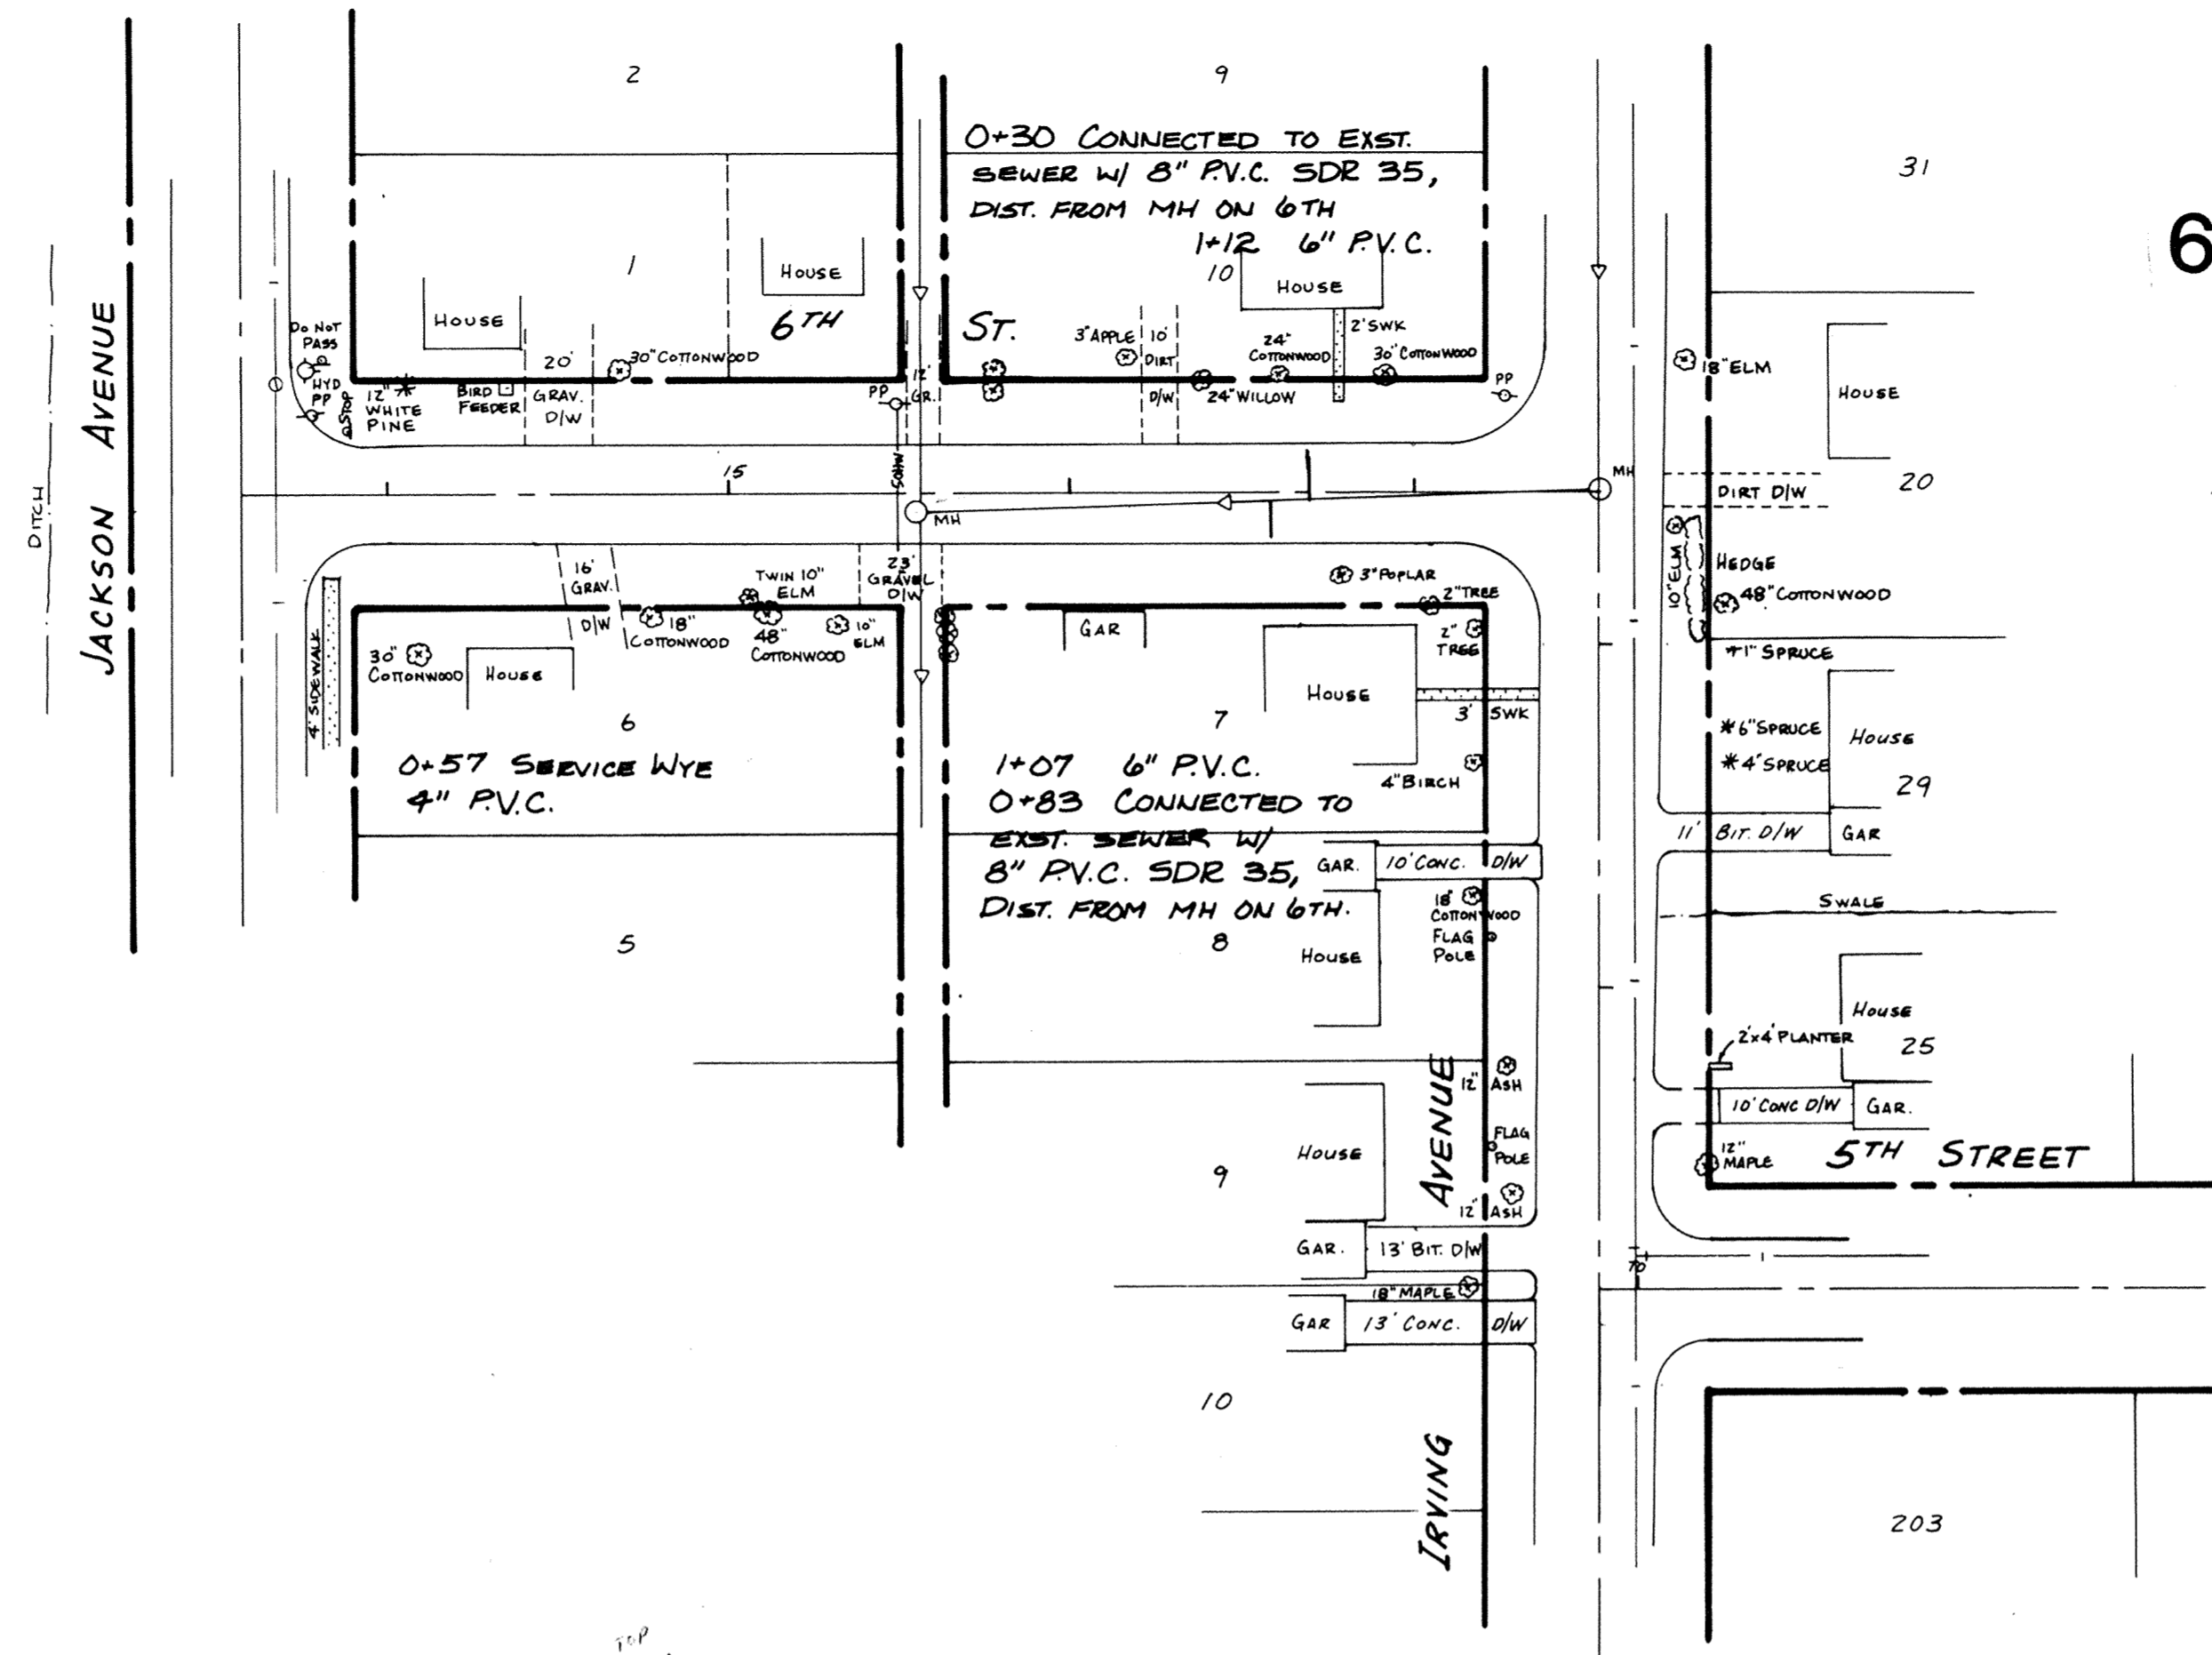

I hereby certify that this plan, specification or report was prepared by me or under my direct supervision and that I am a duly Registered Professional Engineer under State of Minn. Statutes Sections 326.02 to 326.16. Date _____ Minn. Reg. No. _____	consulting engineers diversified inc. P.O. Box 1, Osseo, Minnesota 55369 • 612/425-2181	REVISIONS _____ _____ _____	DESIGNED BY TJM	CITY OF ELK RIVER SANITARY SEWER (CHANGE ORDER #2) 6TH ST. & ALLEY EXTENSIONS
		GRAPHIC SCALE 0' 50' 0' 5' 0' 1'	CHECKED BY TJM	
		BK LOOSE PG LEAF		SHEET 27 B OF 27 SHEETS FILE NO. ER4-02-02