
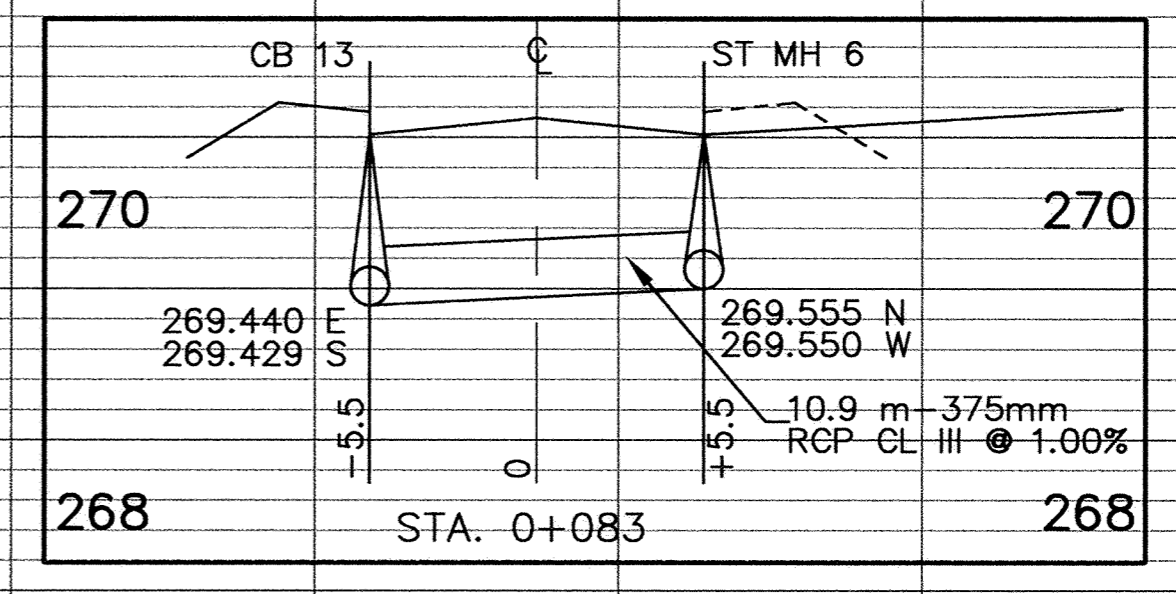
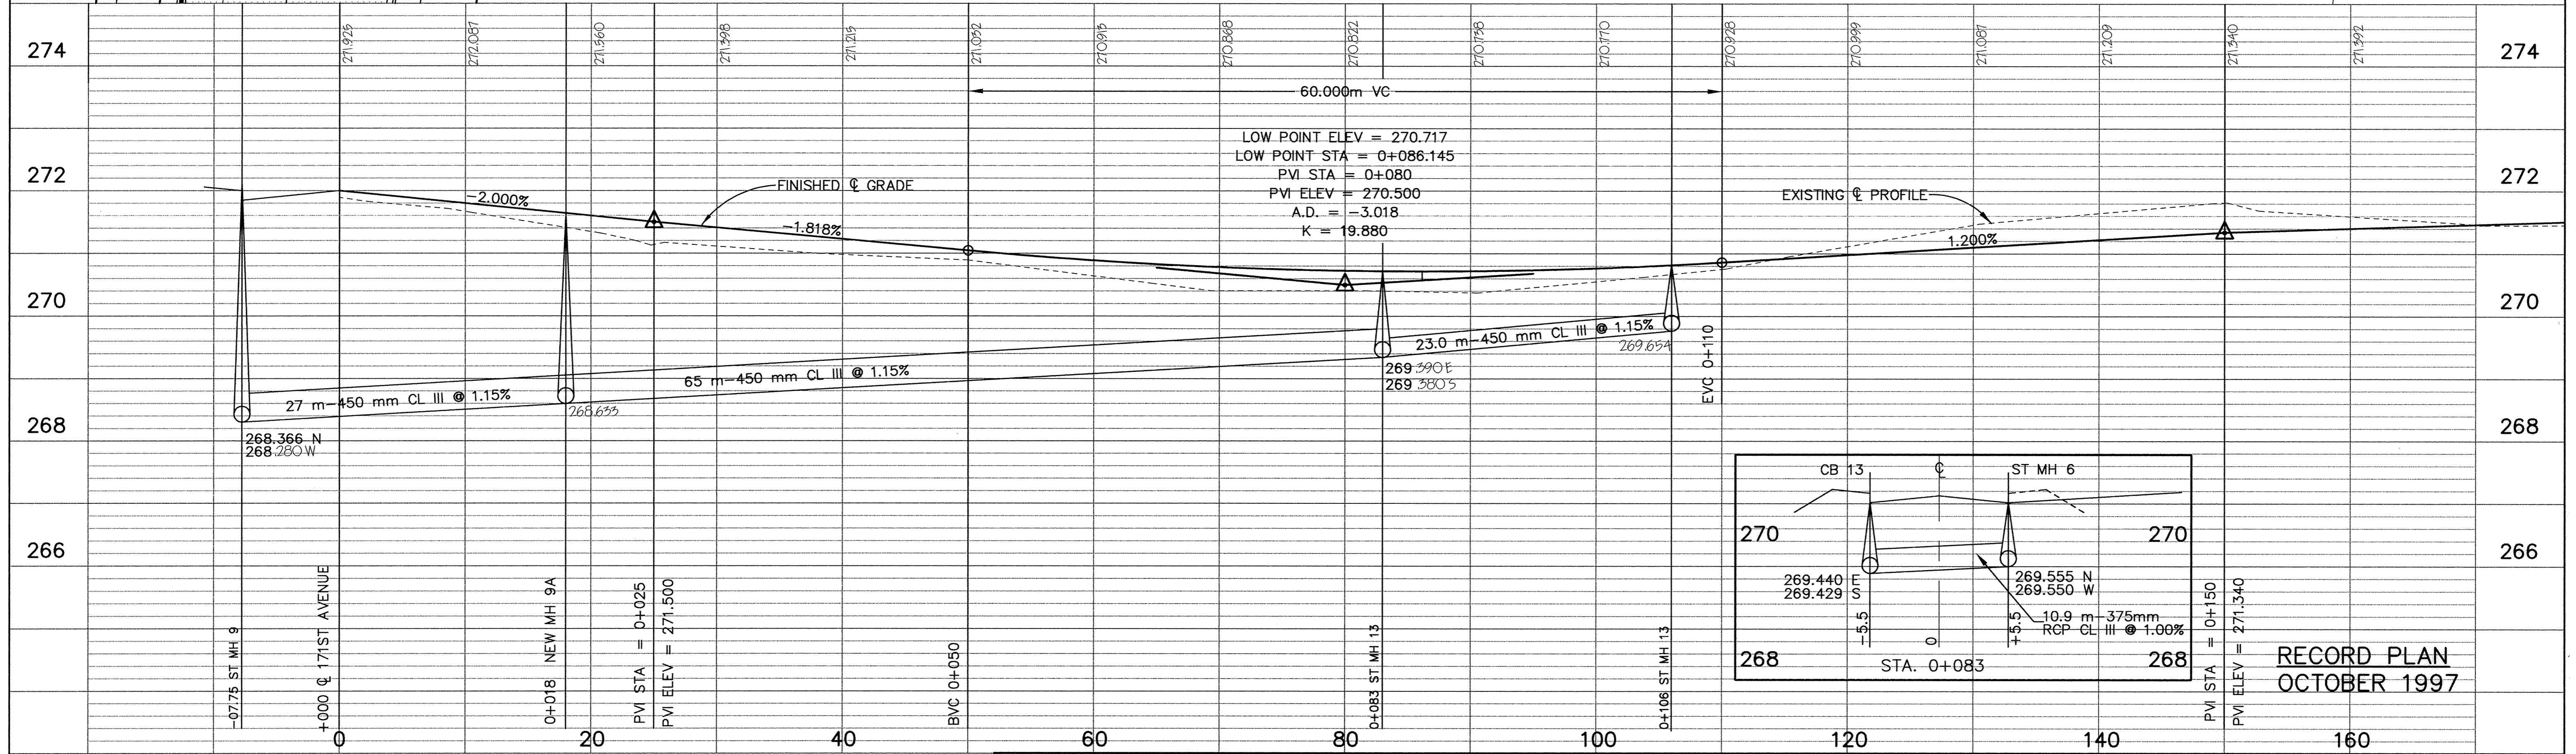


ULYSSES STREET

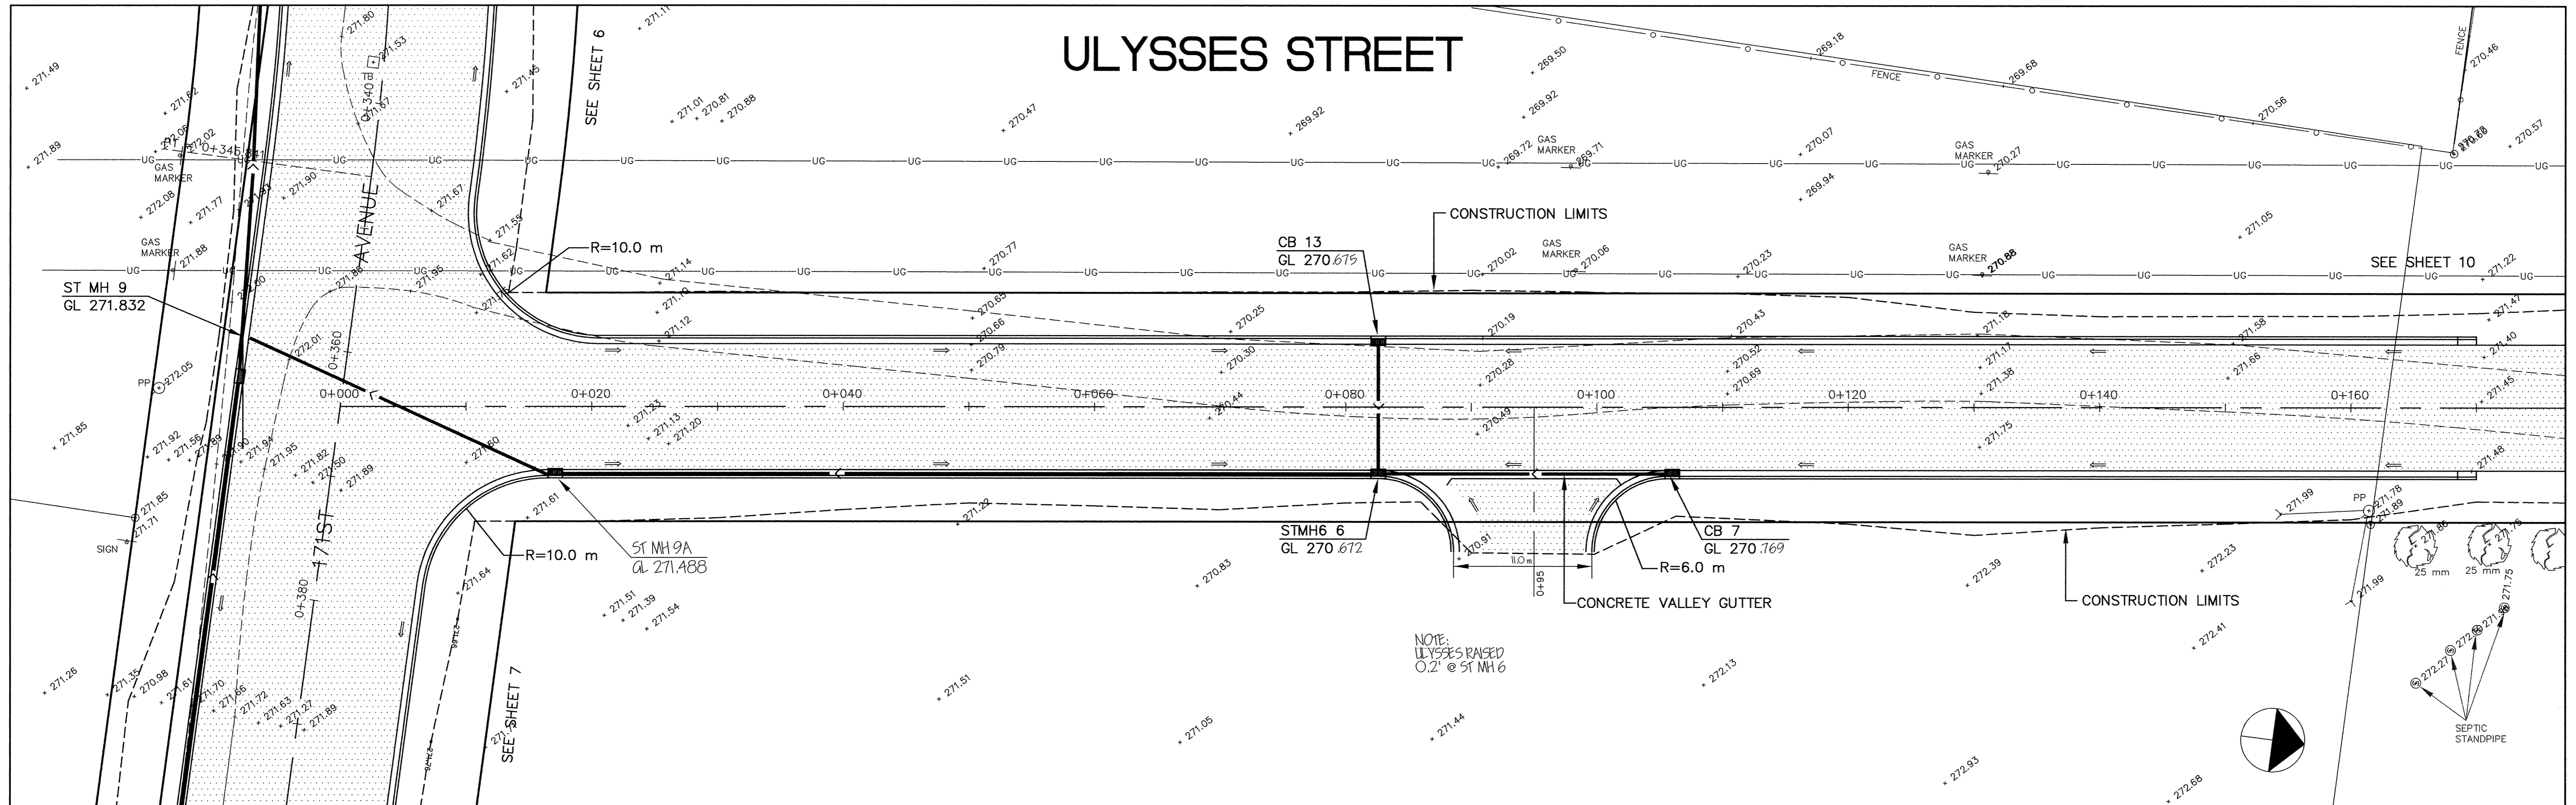

RECORD PLAN
OCTOBER 1997

I HEREBY CERTIFY THAT THIS PLAN, SPECIFICATION, OR REPORT WAS PREPARED BY ME OR UNDER MY DIRECT SUPERVISION AND THAT I AM A DULY REGISTERED PROFESSIONAL ENGINEER UNDER THE LAWS OF THE STATE OF MINNESOTA.

Law of M... ..

DATE 7/23/96 REG. NO. 15316



1326 ENERGY PARK DRIVE
ST. PAUL, MINNESOTA 55108
(612) 644-4389

DATE	DESCRIPTION	DESIGN	DRAWN
9/30/96	CL GRADE @ 171ST AVE.	CHECKED	

GRAPHIC SCALES	
0	HORIZ (M) 10
1:250	
0	VERT (M) 2
1:50	

CITY OF ELK RIVER
171ST AVENUE
STORM SEWER AND STREET CONSTRUCTION
ULYSSES STREET

S.A.P. 204-132-01 STA 0+000 TO STA 0+160

DATE JULY 1996 SHEET 9 OF 25 SHEETS PROJECT NO. 230-313-20