
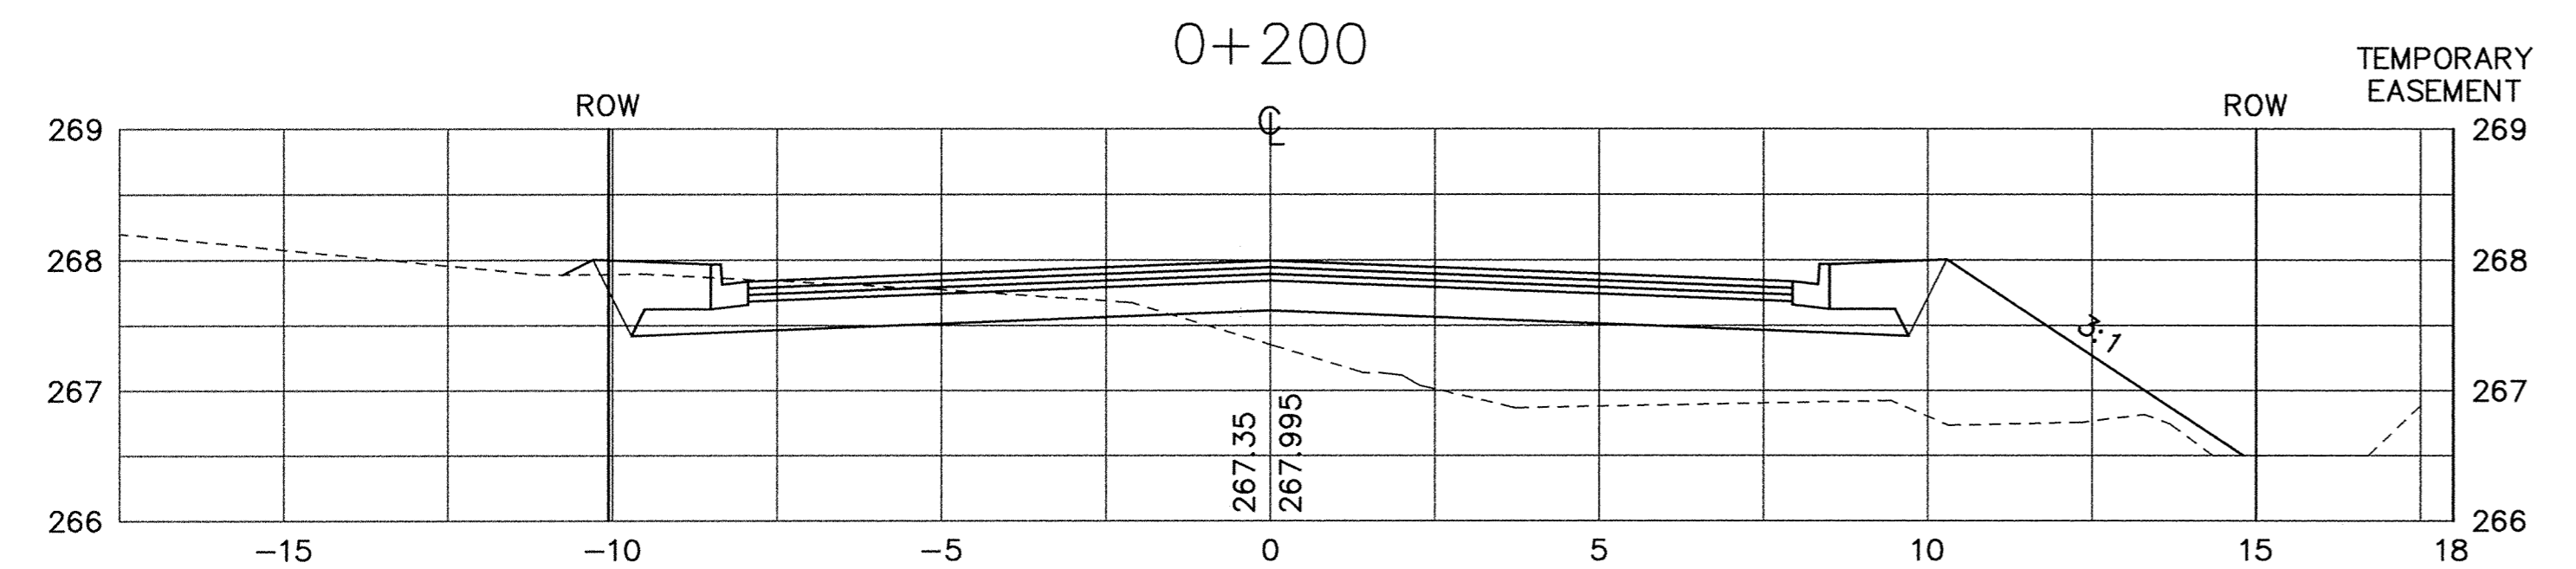
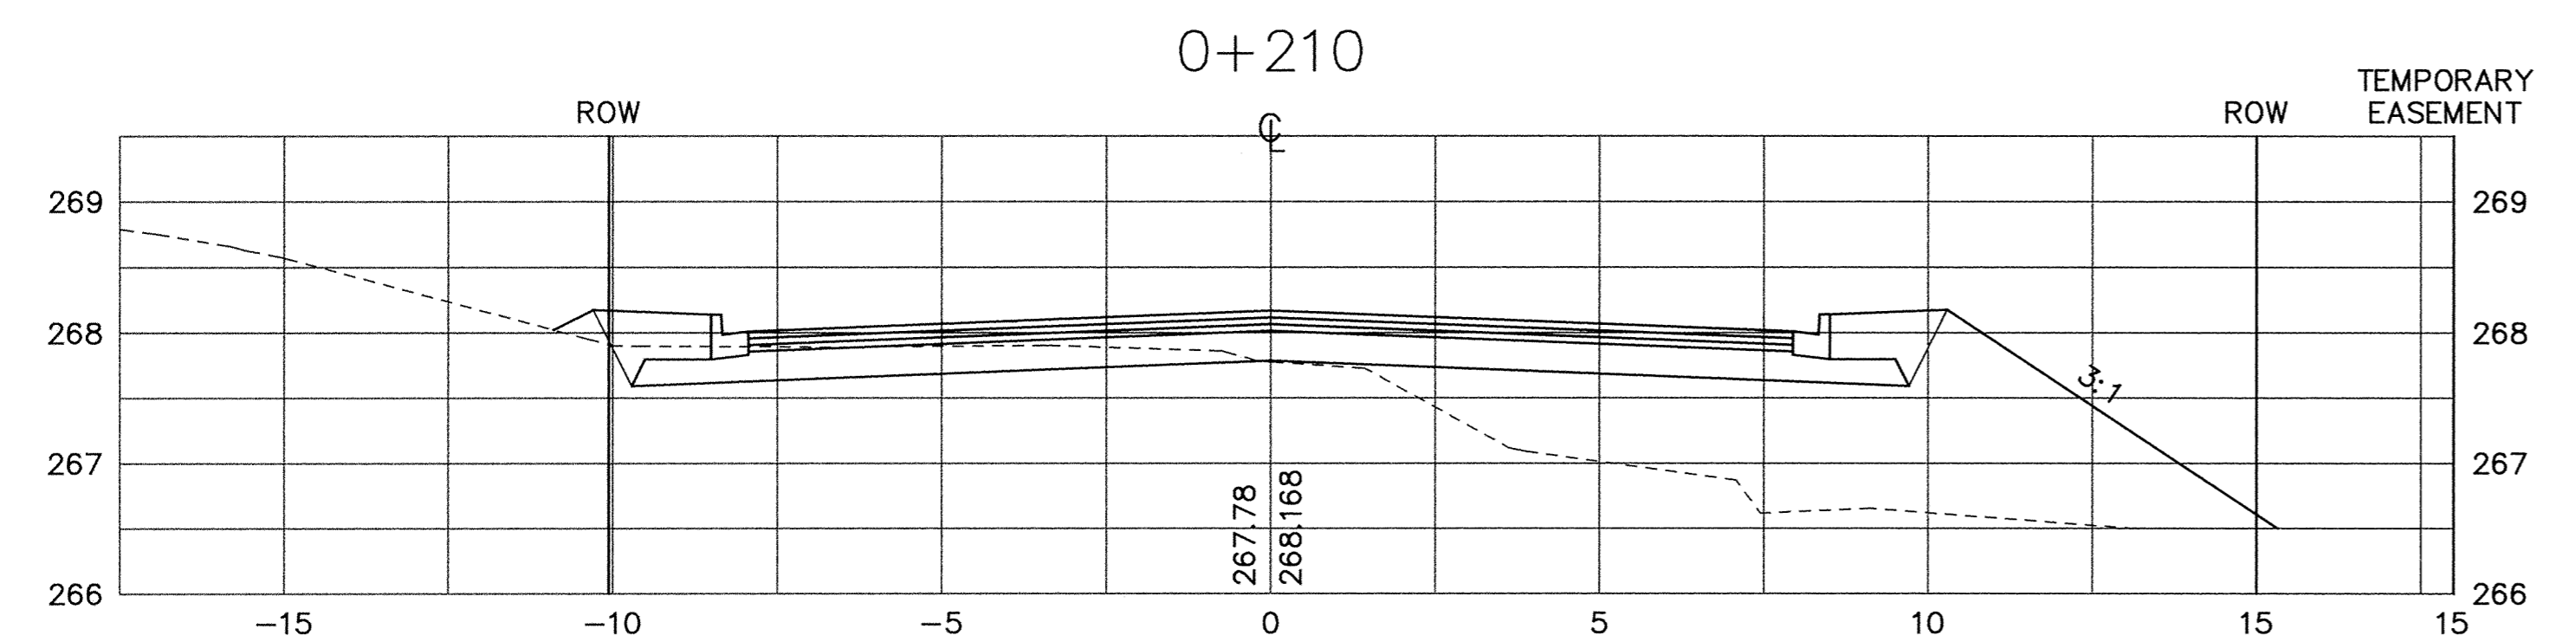
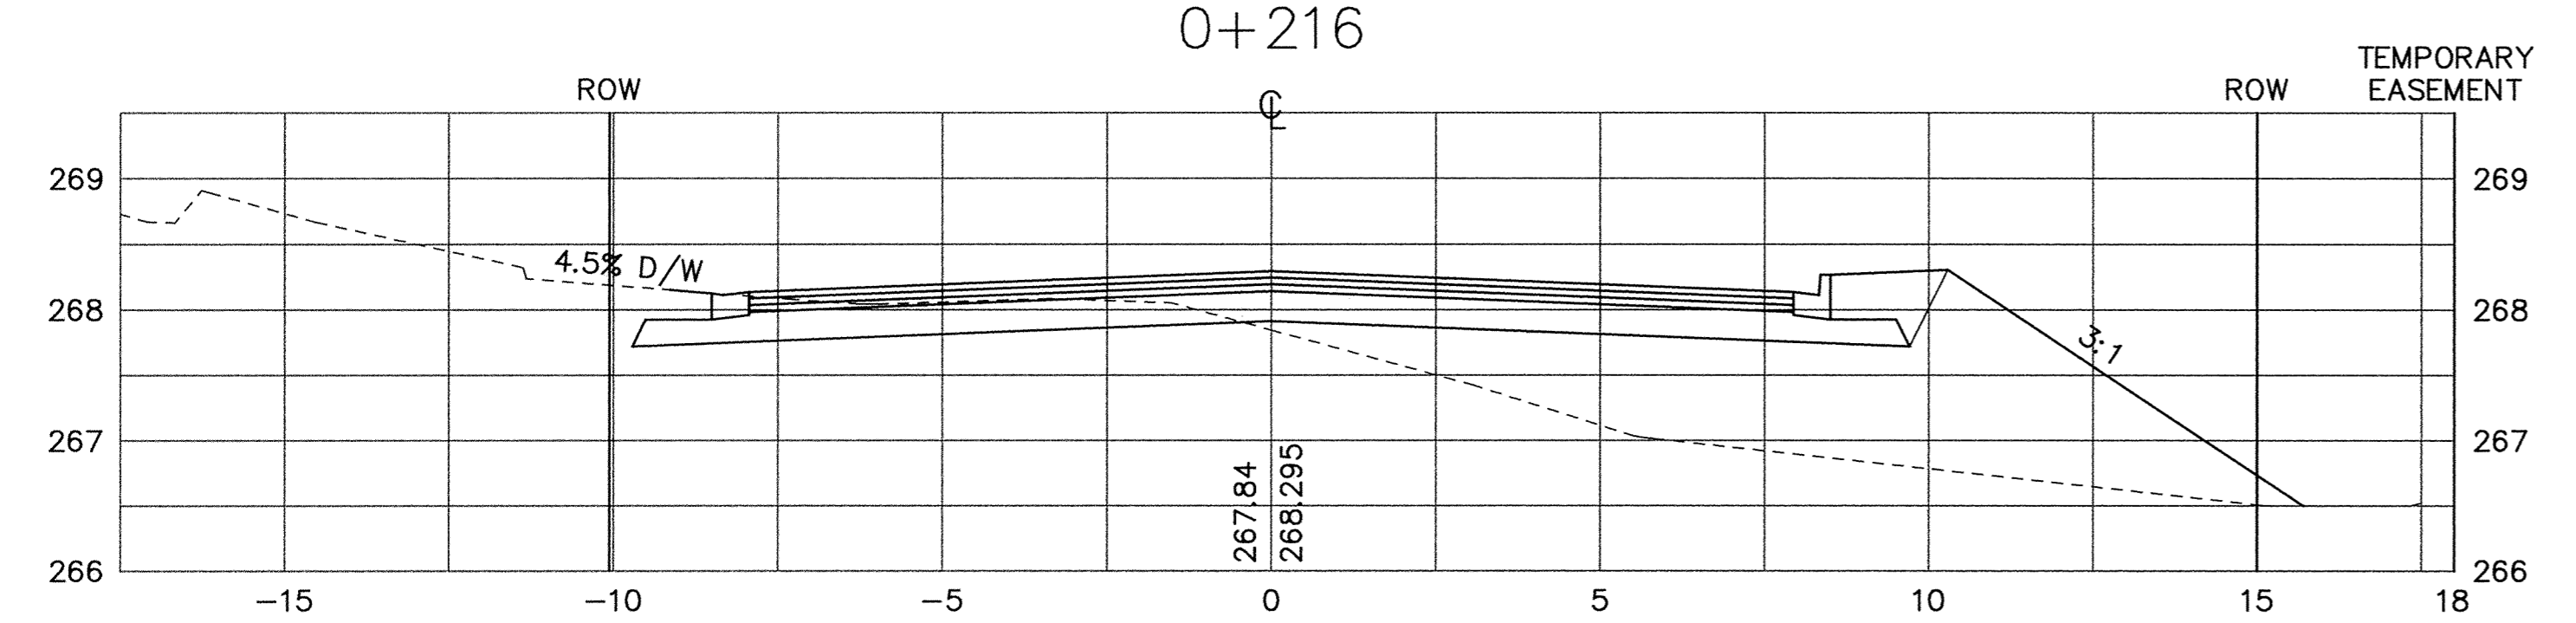
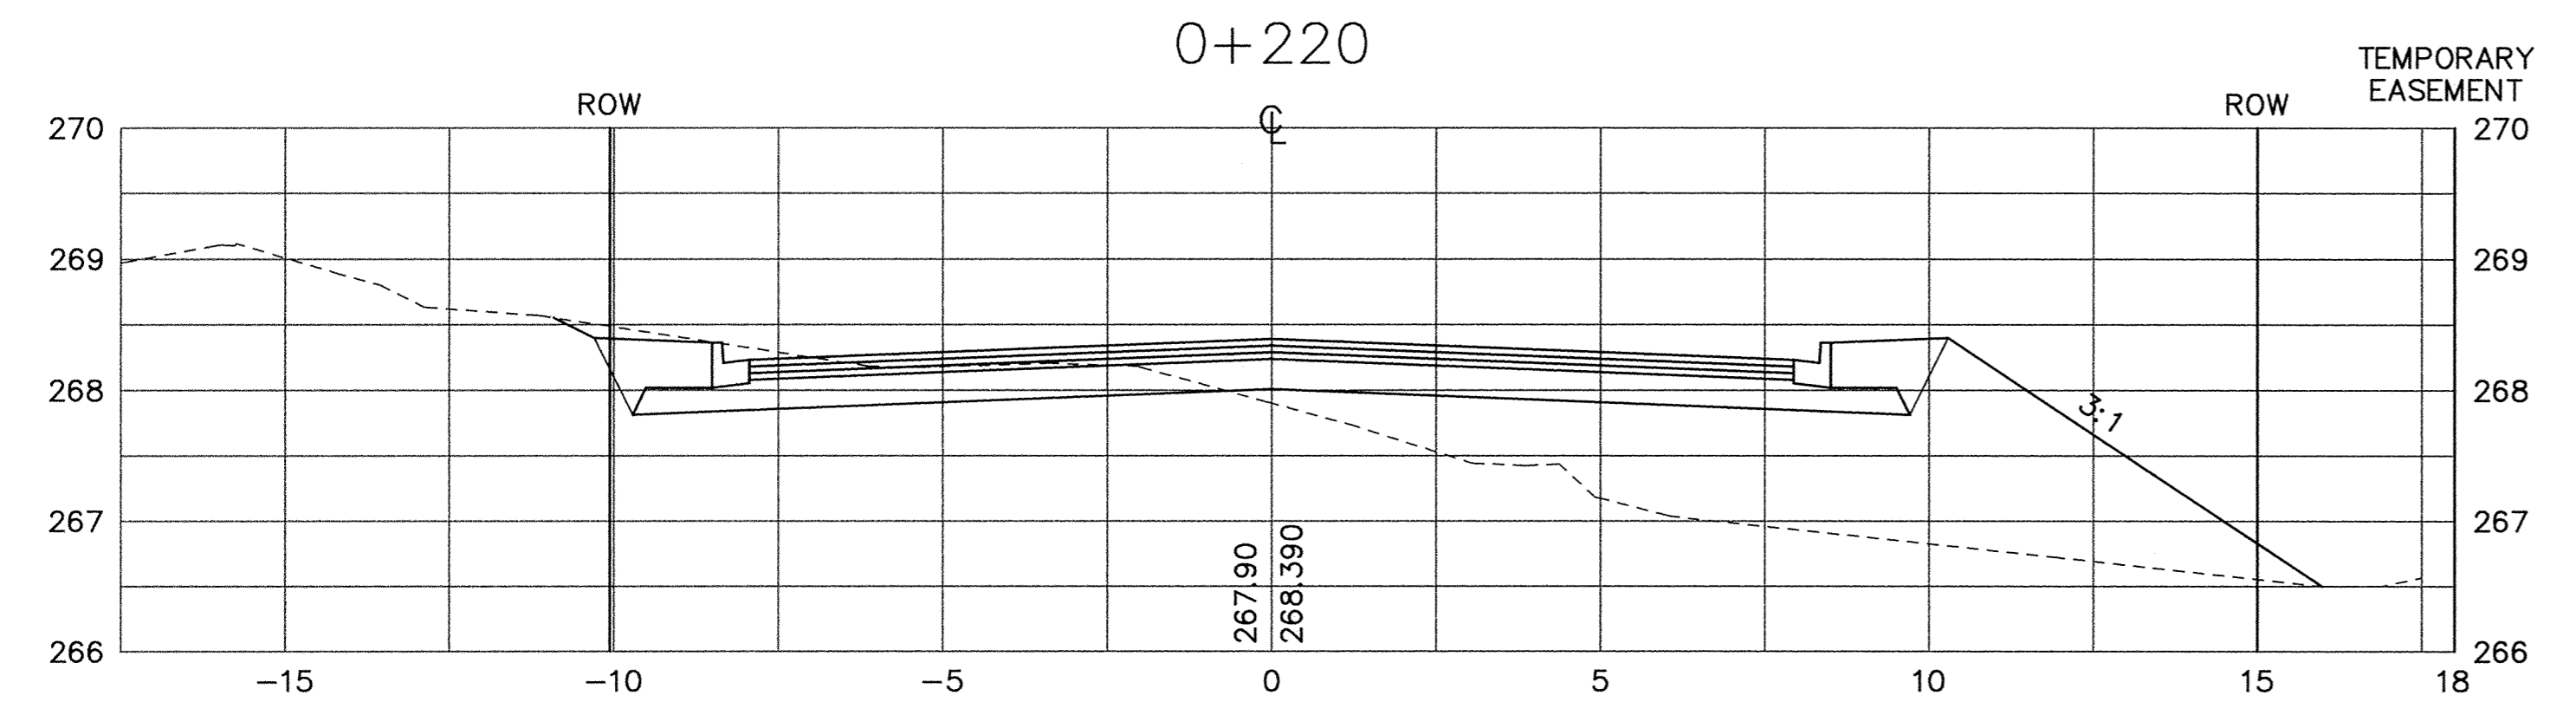
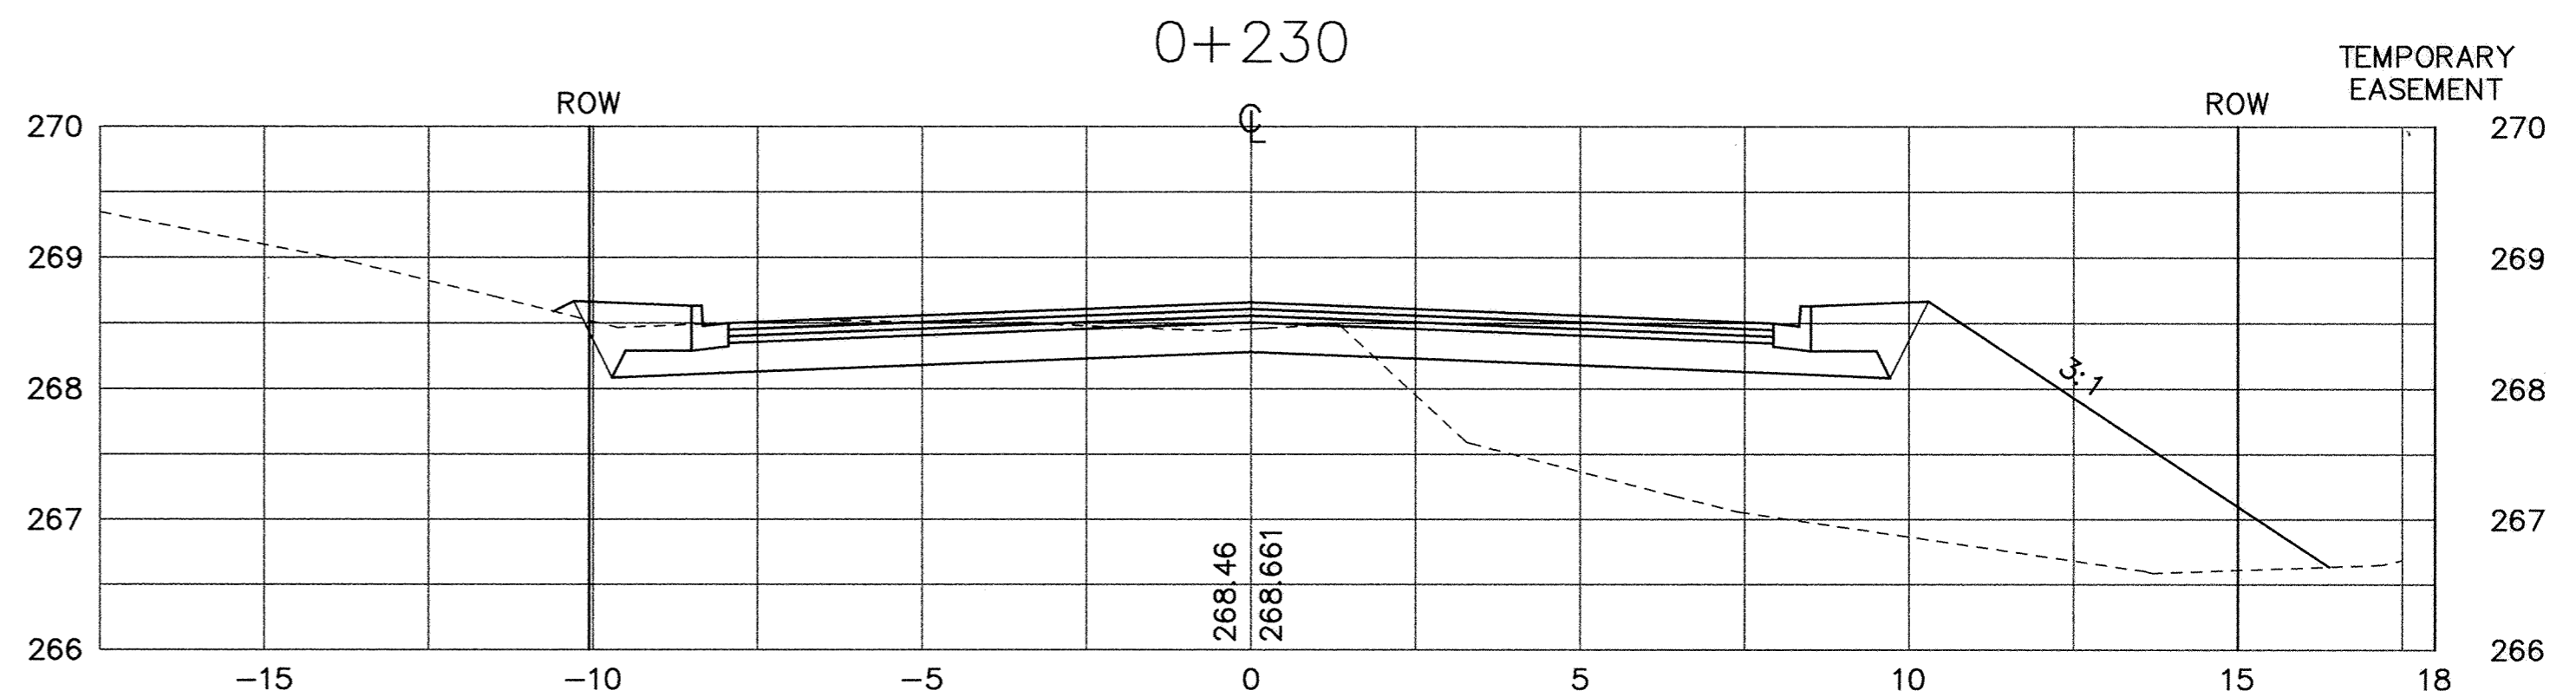
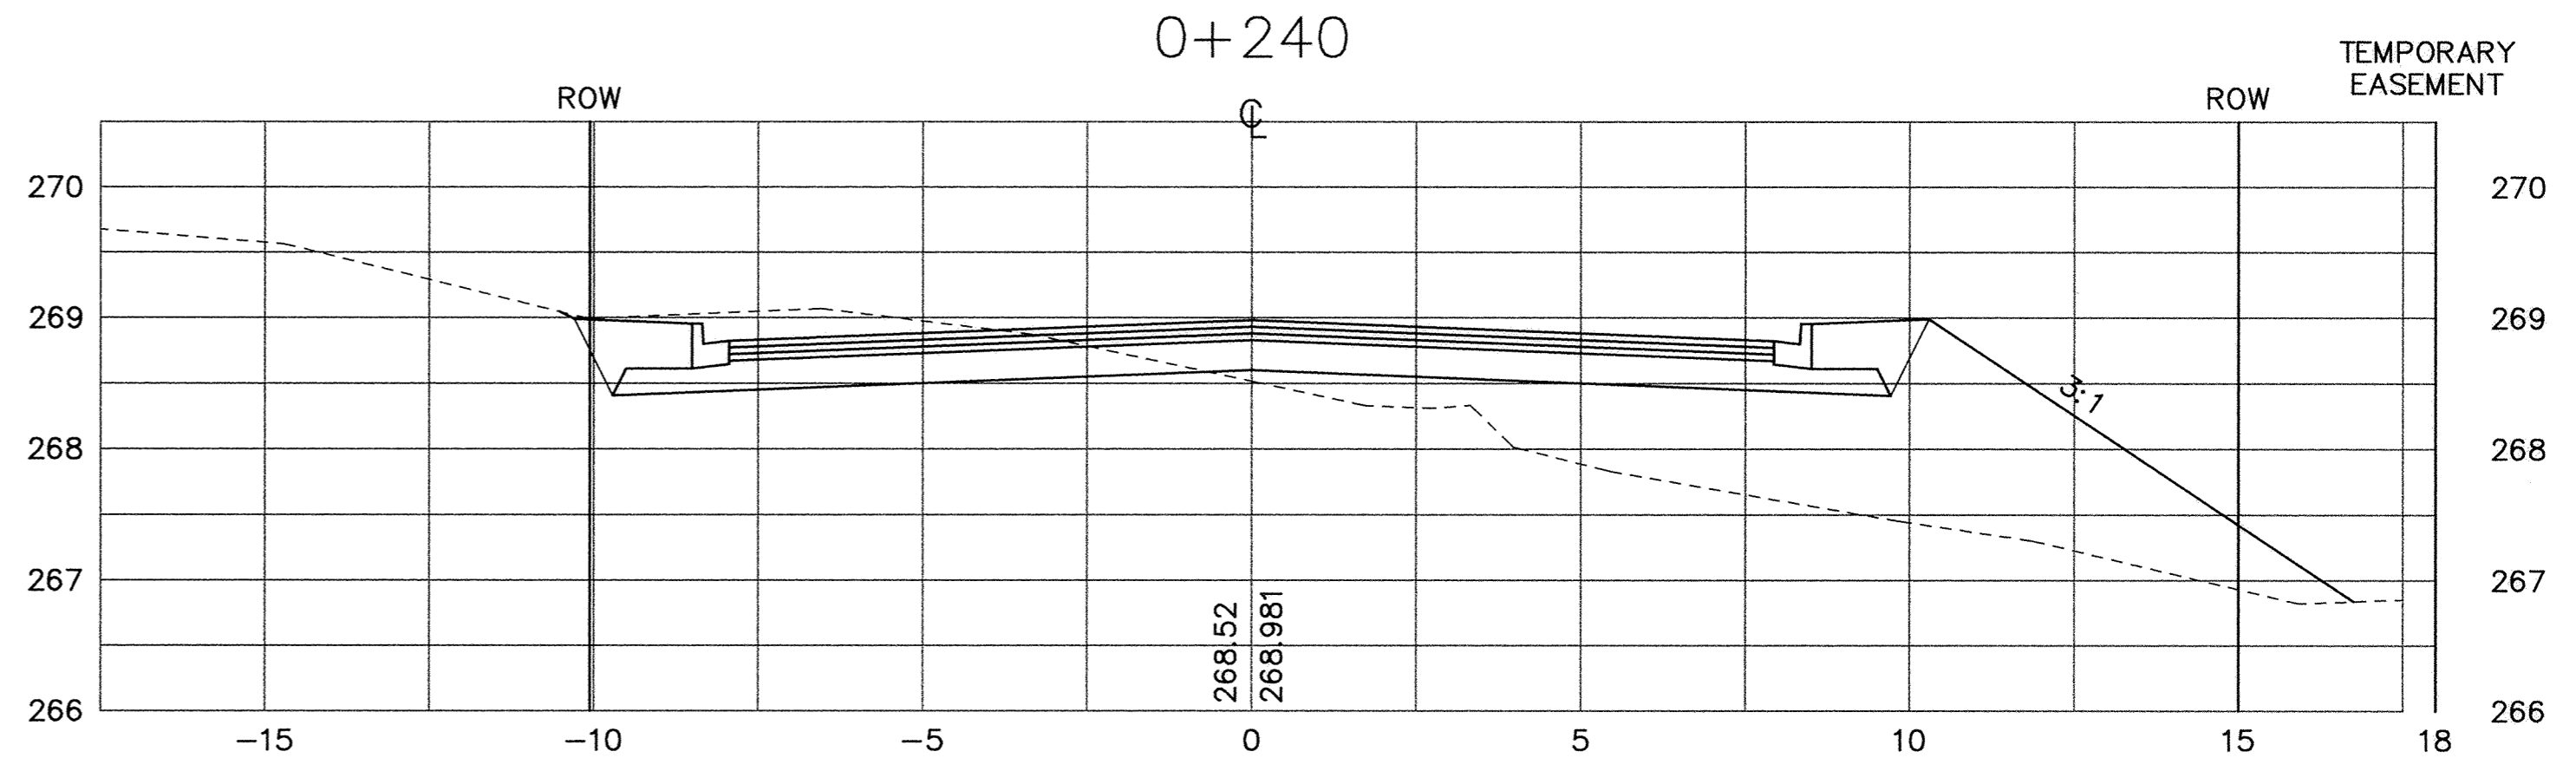
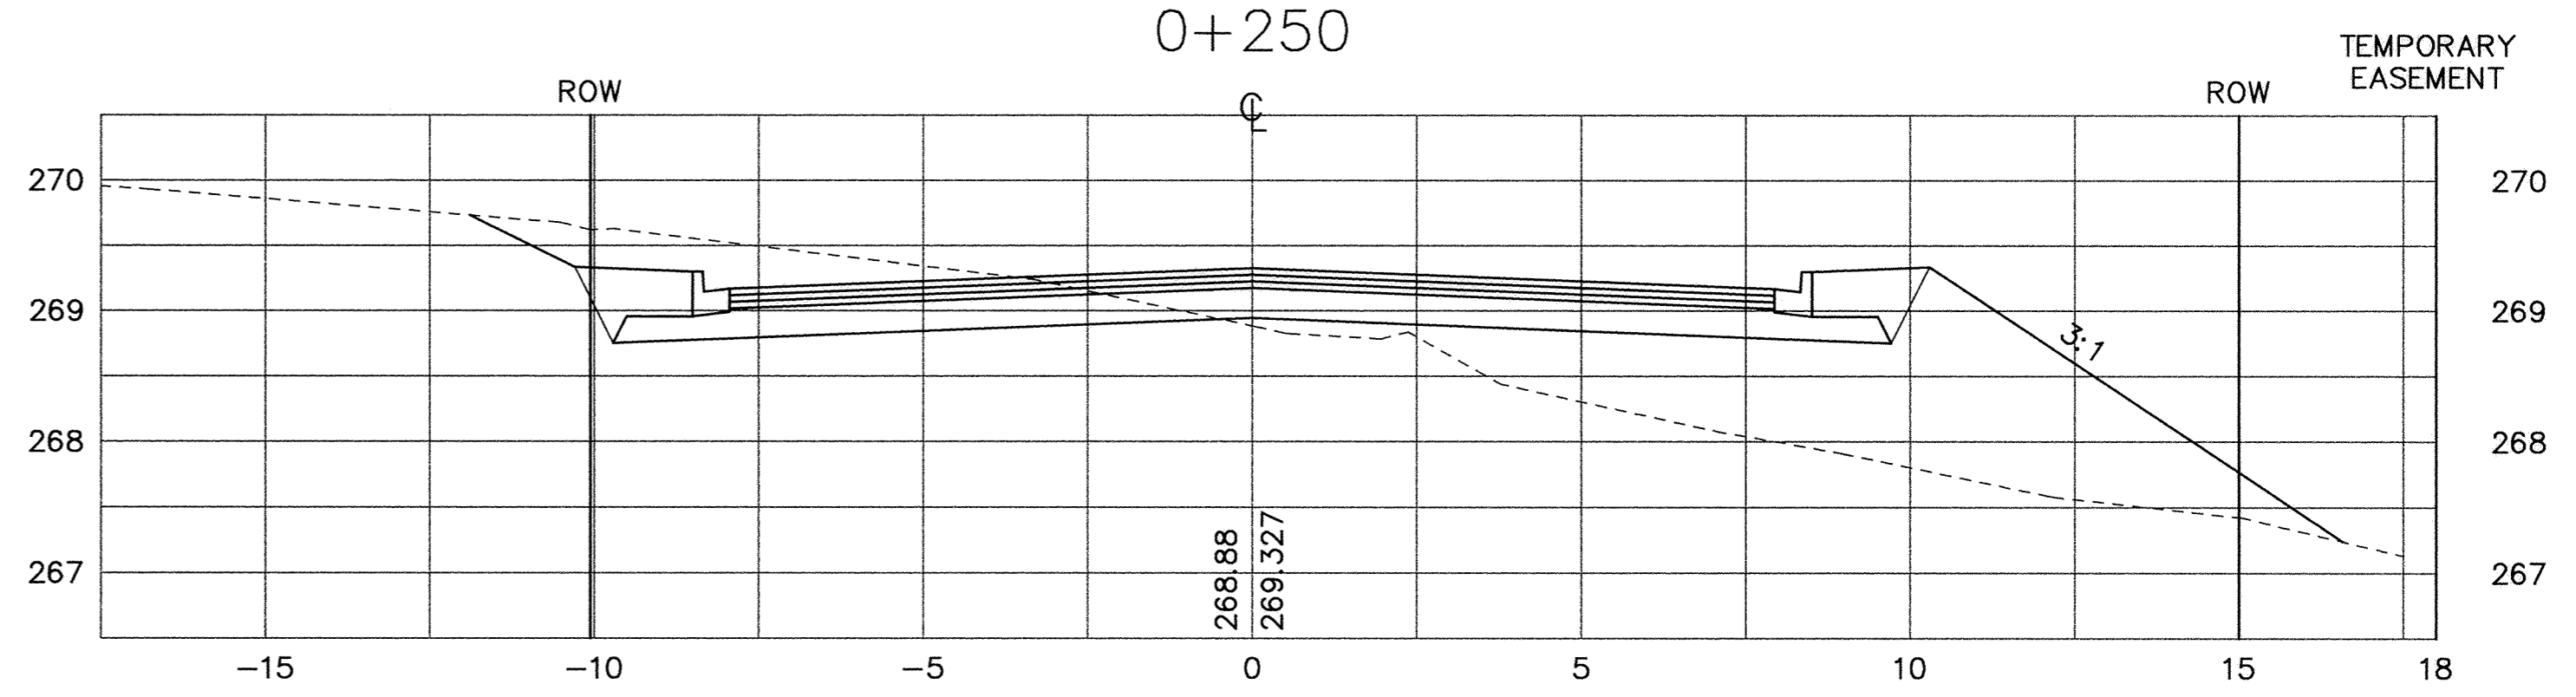



SAFCO PRODUCTS • NEW HOPE, MINNESOTA
REVISIONS BY PART NUMBER 0502
REVISIONS BY PART NUMBER 0502
REVISIONS BY PART NUMBER 0502
REVISIONS BY PART NUMBER 0502

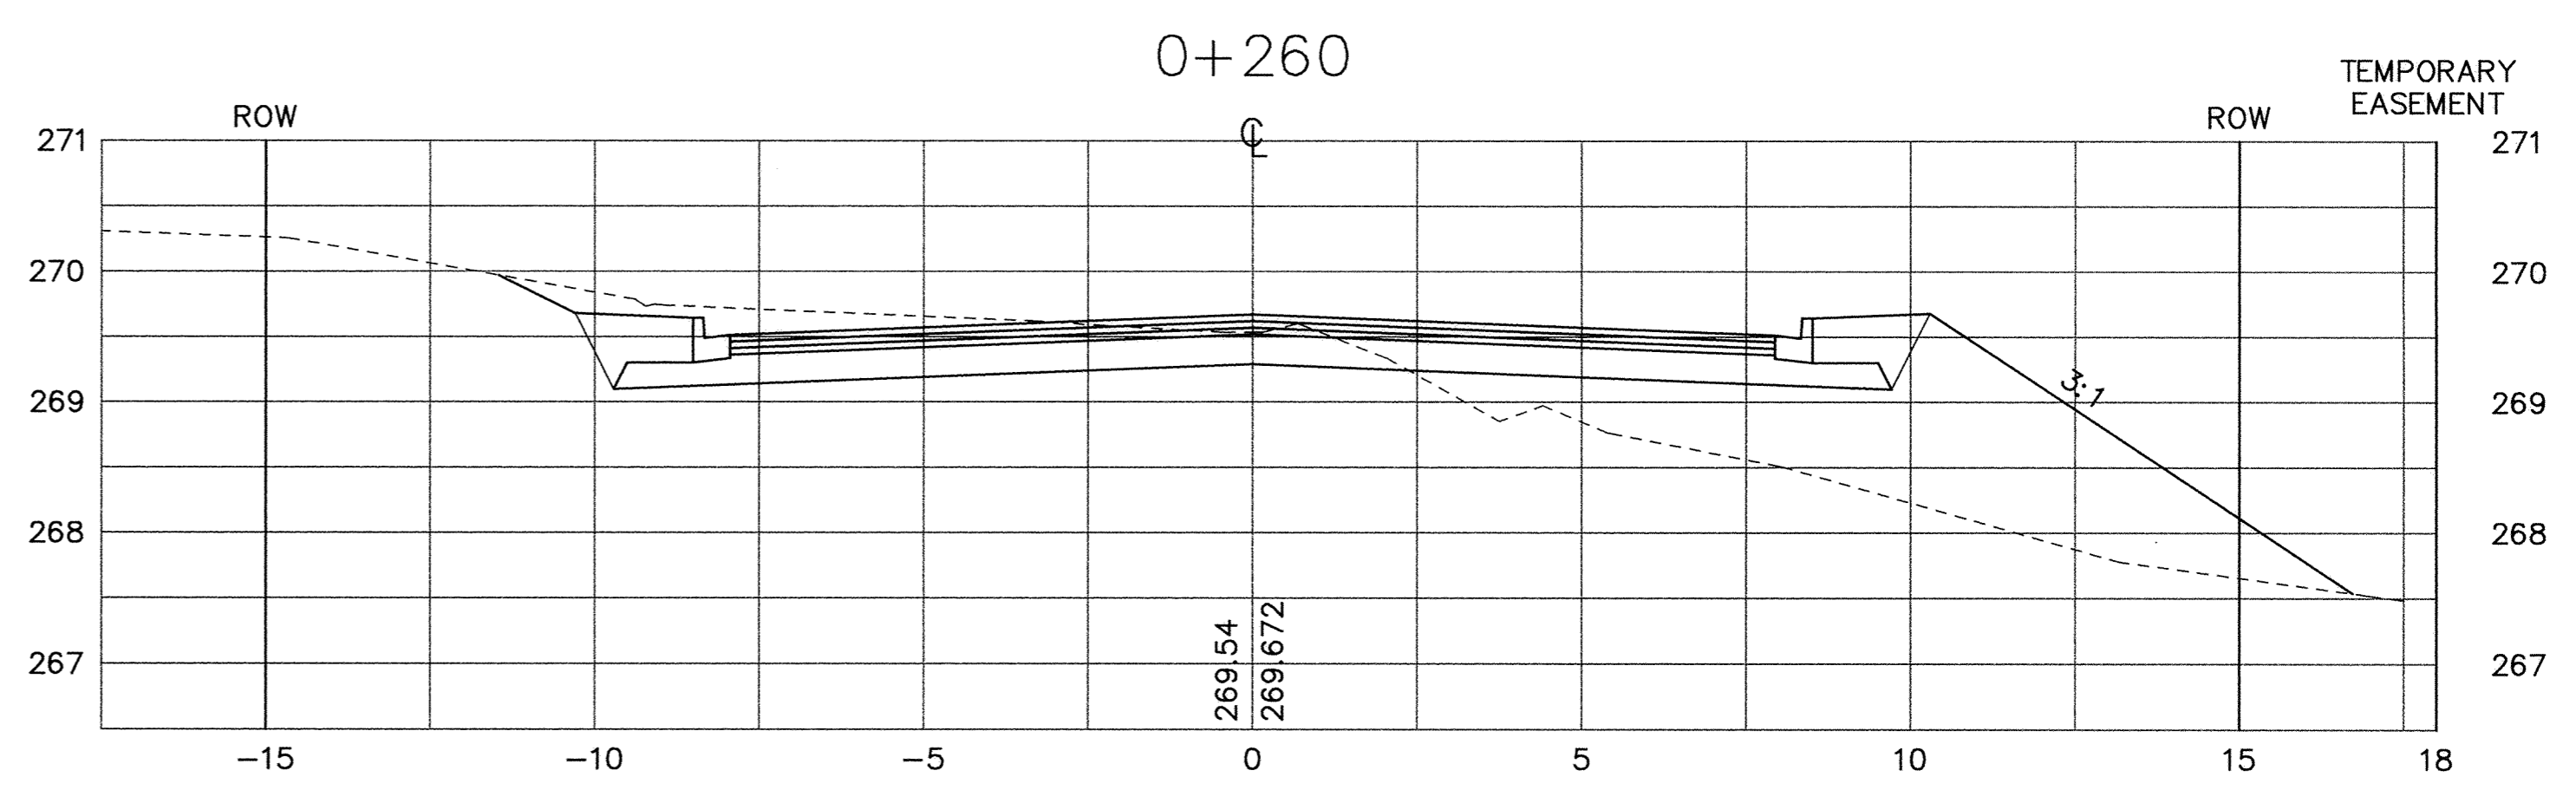

RECORD PLAN
OCTOBER 1997

I HEREBY CERTIFY THAT THIS PLAN, SPECIFICATION, OR REPORT WAS PREPARED BY ME OR UNDER MY DIRECT SUPERVISION AND THAT I AM A DULY REGISTERED PROFESSIONAL ENGINEER UNDER THE LAWS OF THE STATE OF MINNESOTA.

Ken J. Mowbray
DATE 7/23/96 REG. NO. 15316

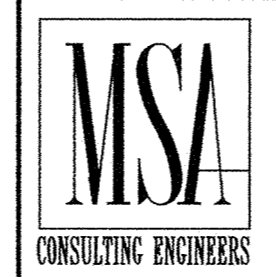

1326 ENERGY PARK DRIVE
ST. PAUL, MINNESOTA 55108
(612) 644-4389

REVISIONS	DATE	DESCRIPTION	DESIGN	DRAWN

CITY OF ELK RIVER 171ST AVENUE CROSS SECTIONS 171ST AVENUE		S.A.P. 204-132-01		STA 0+200 TO STA 0+260	
DATE	JULY 1996	SHEET	14	OF	25 SHEETS
PROJECT NO.			230-313-20		

C:\CAD\ELK RIVER\ER313\ER313-X3.dwg Sun Dec 14 12:00:27 1997