
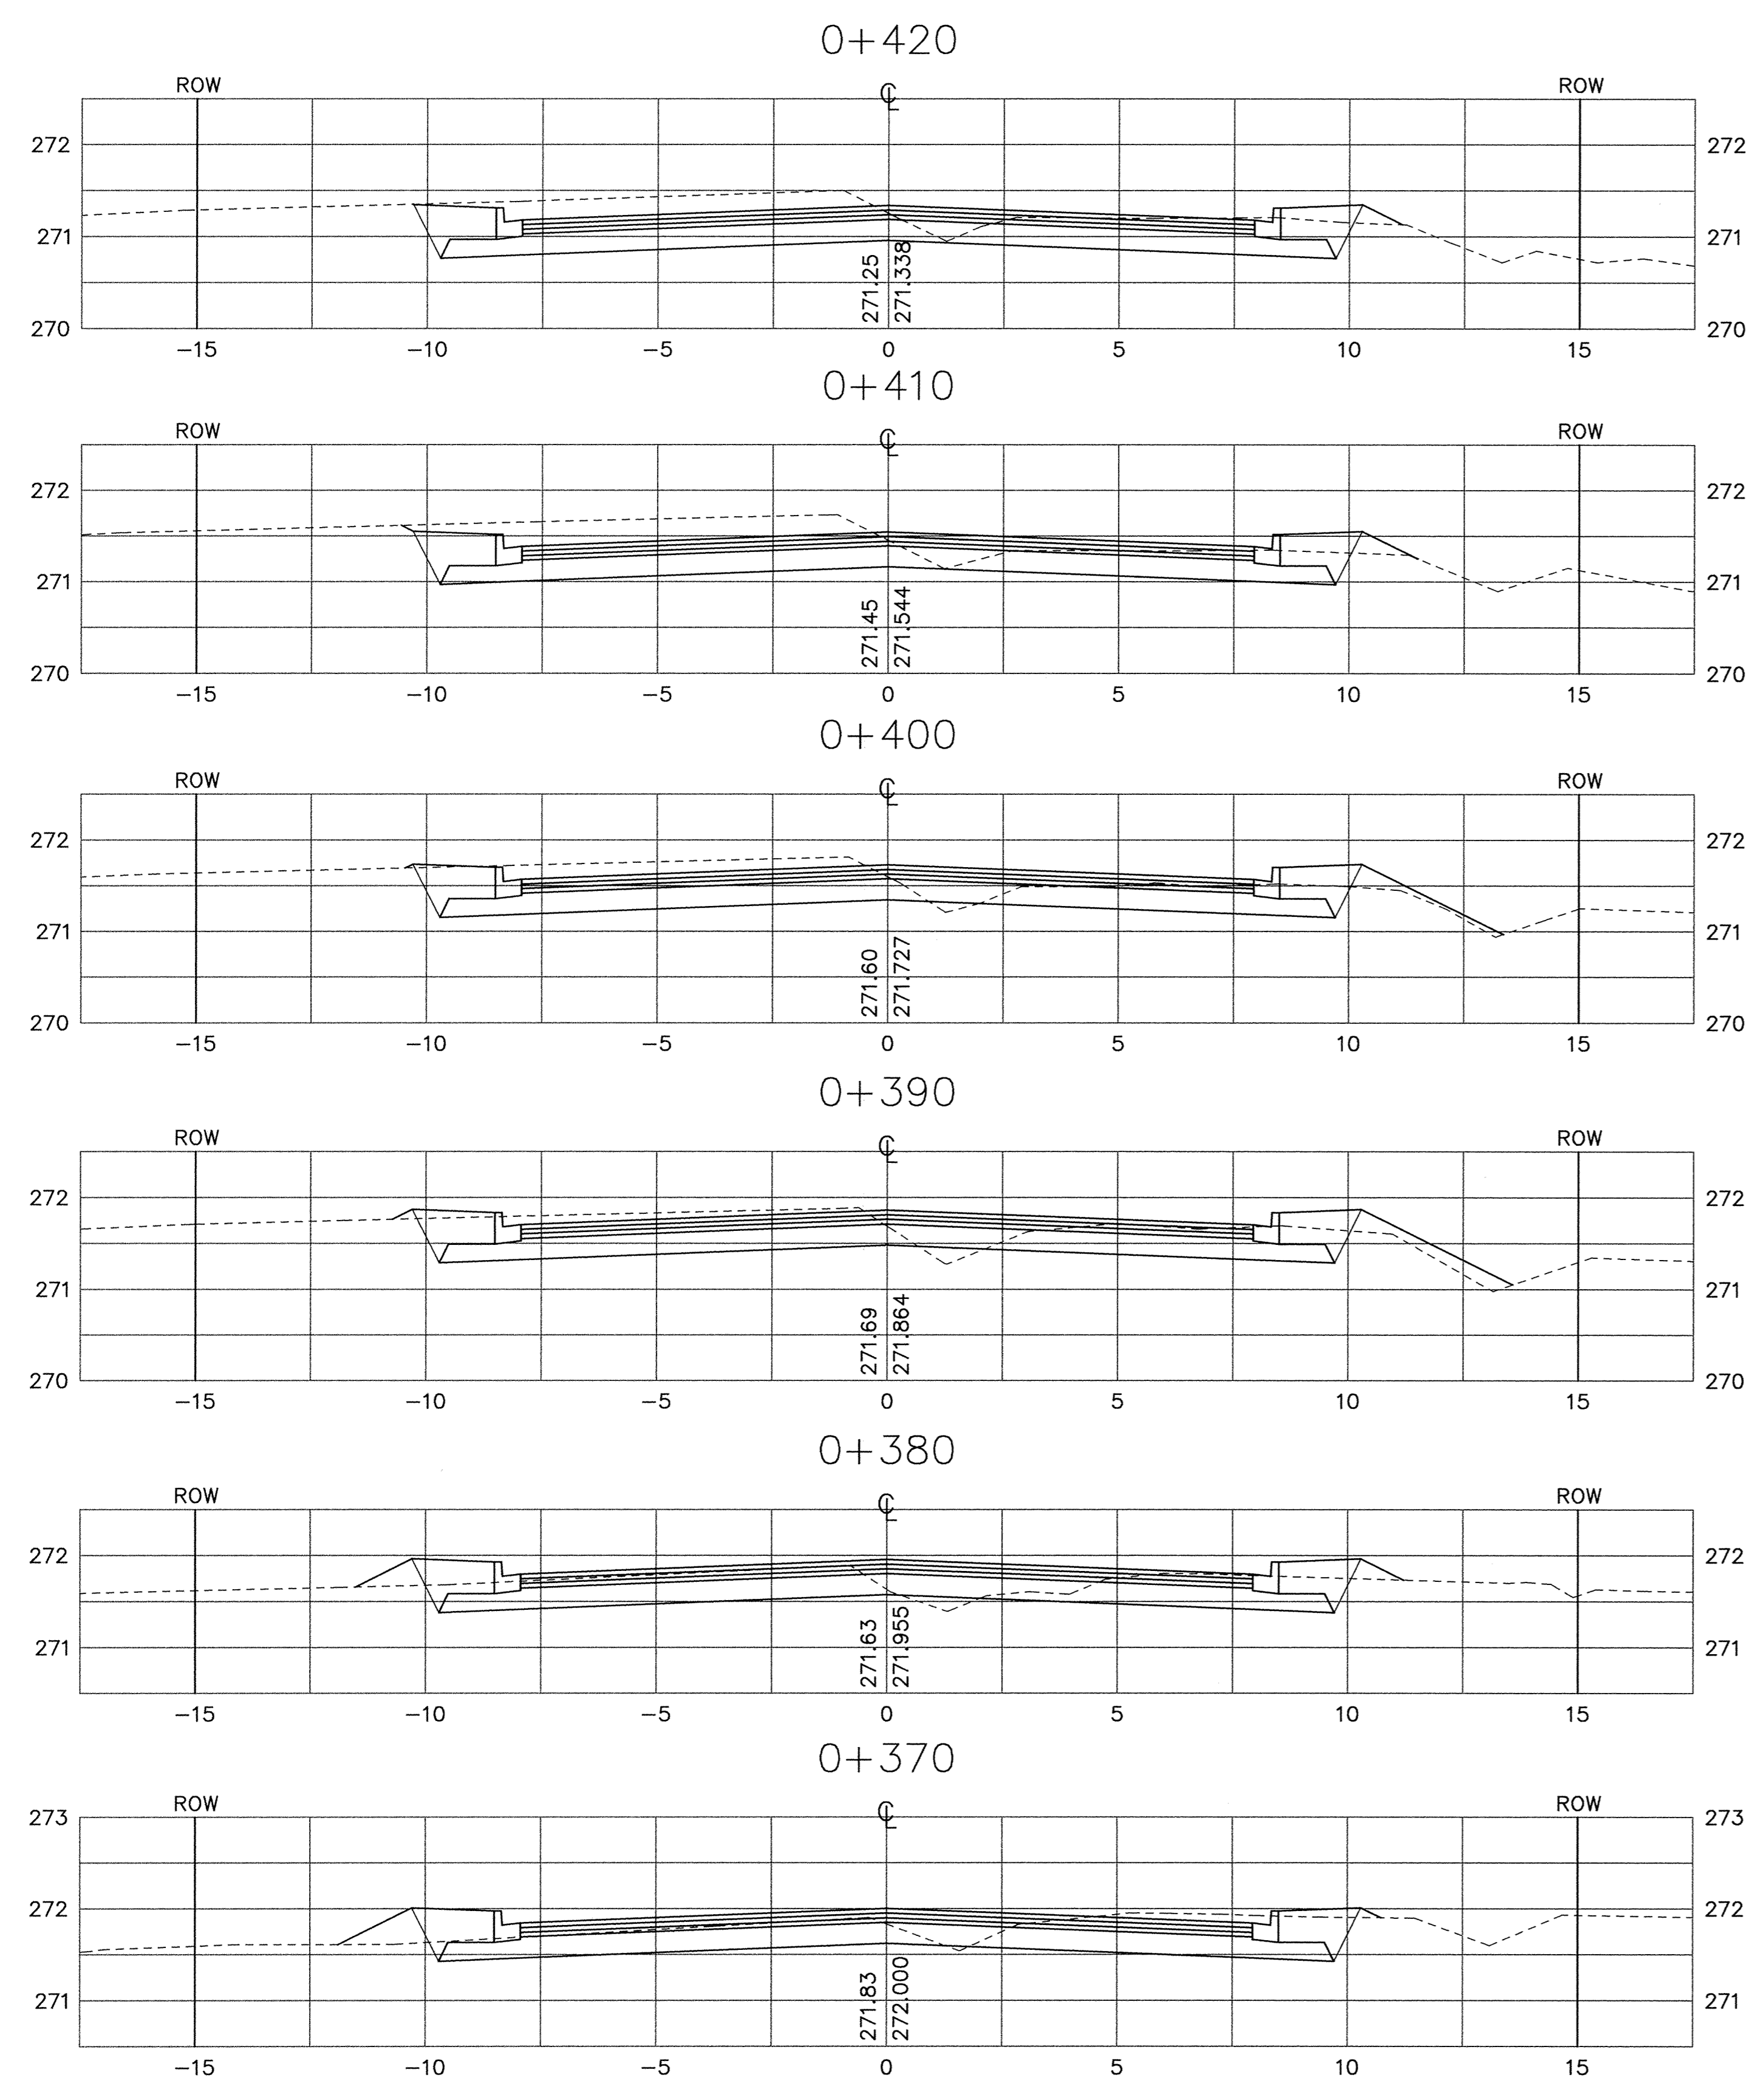


30 PRODUCTS • NEW HOPE, MINNESOTA
REVISIONS OF SHEET NO. 1164
SACO PRODUCTS • NEW HOPE, MINNESOTA
REVISIONS OF SHEET NO. 1164
SACO PRODUCTS • NEW HOPE, MINNESOTA
REVISIONS OF SHEET NO. 1164
SACO PRODUCTS • NEW HOPE, MINNESOTA
REVISIONS OF SHEET NO. 1164

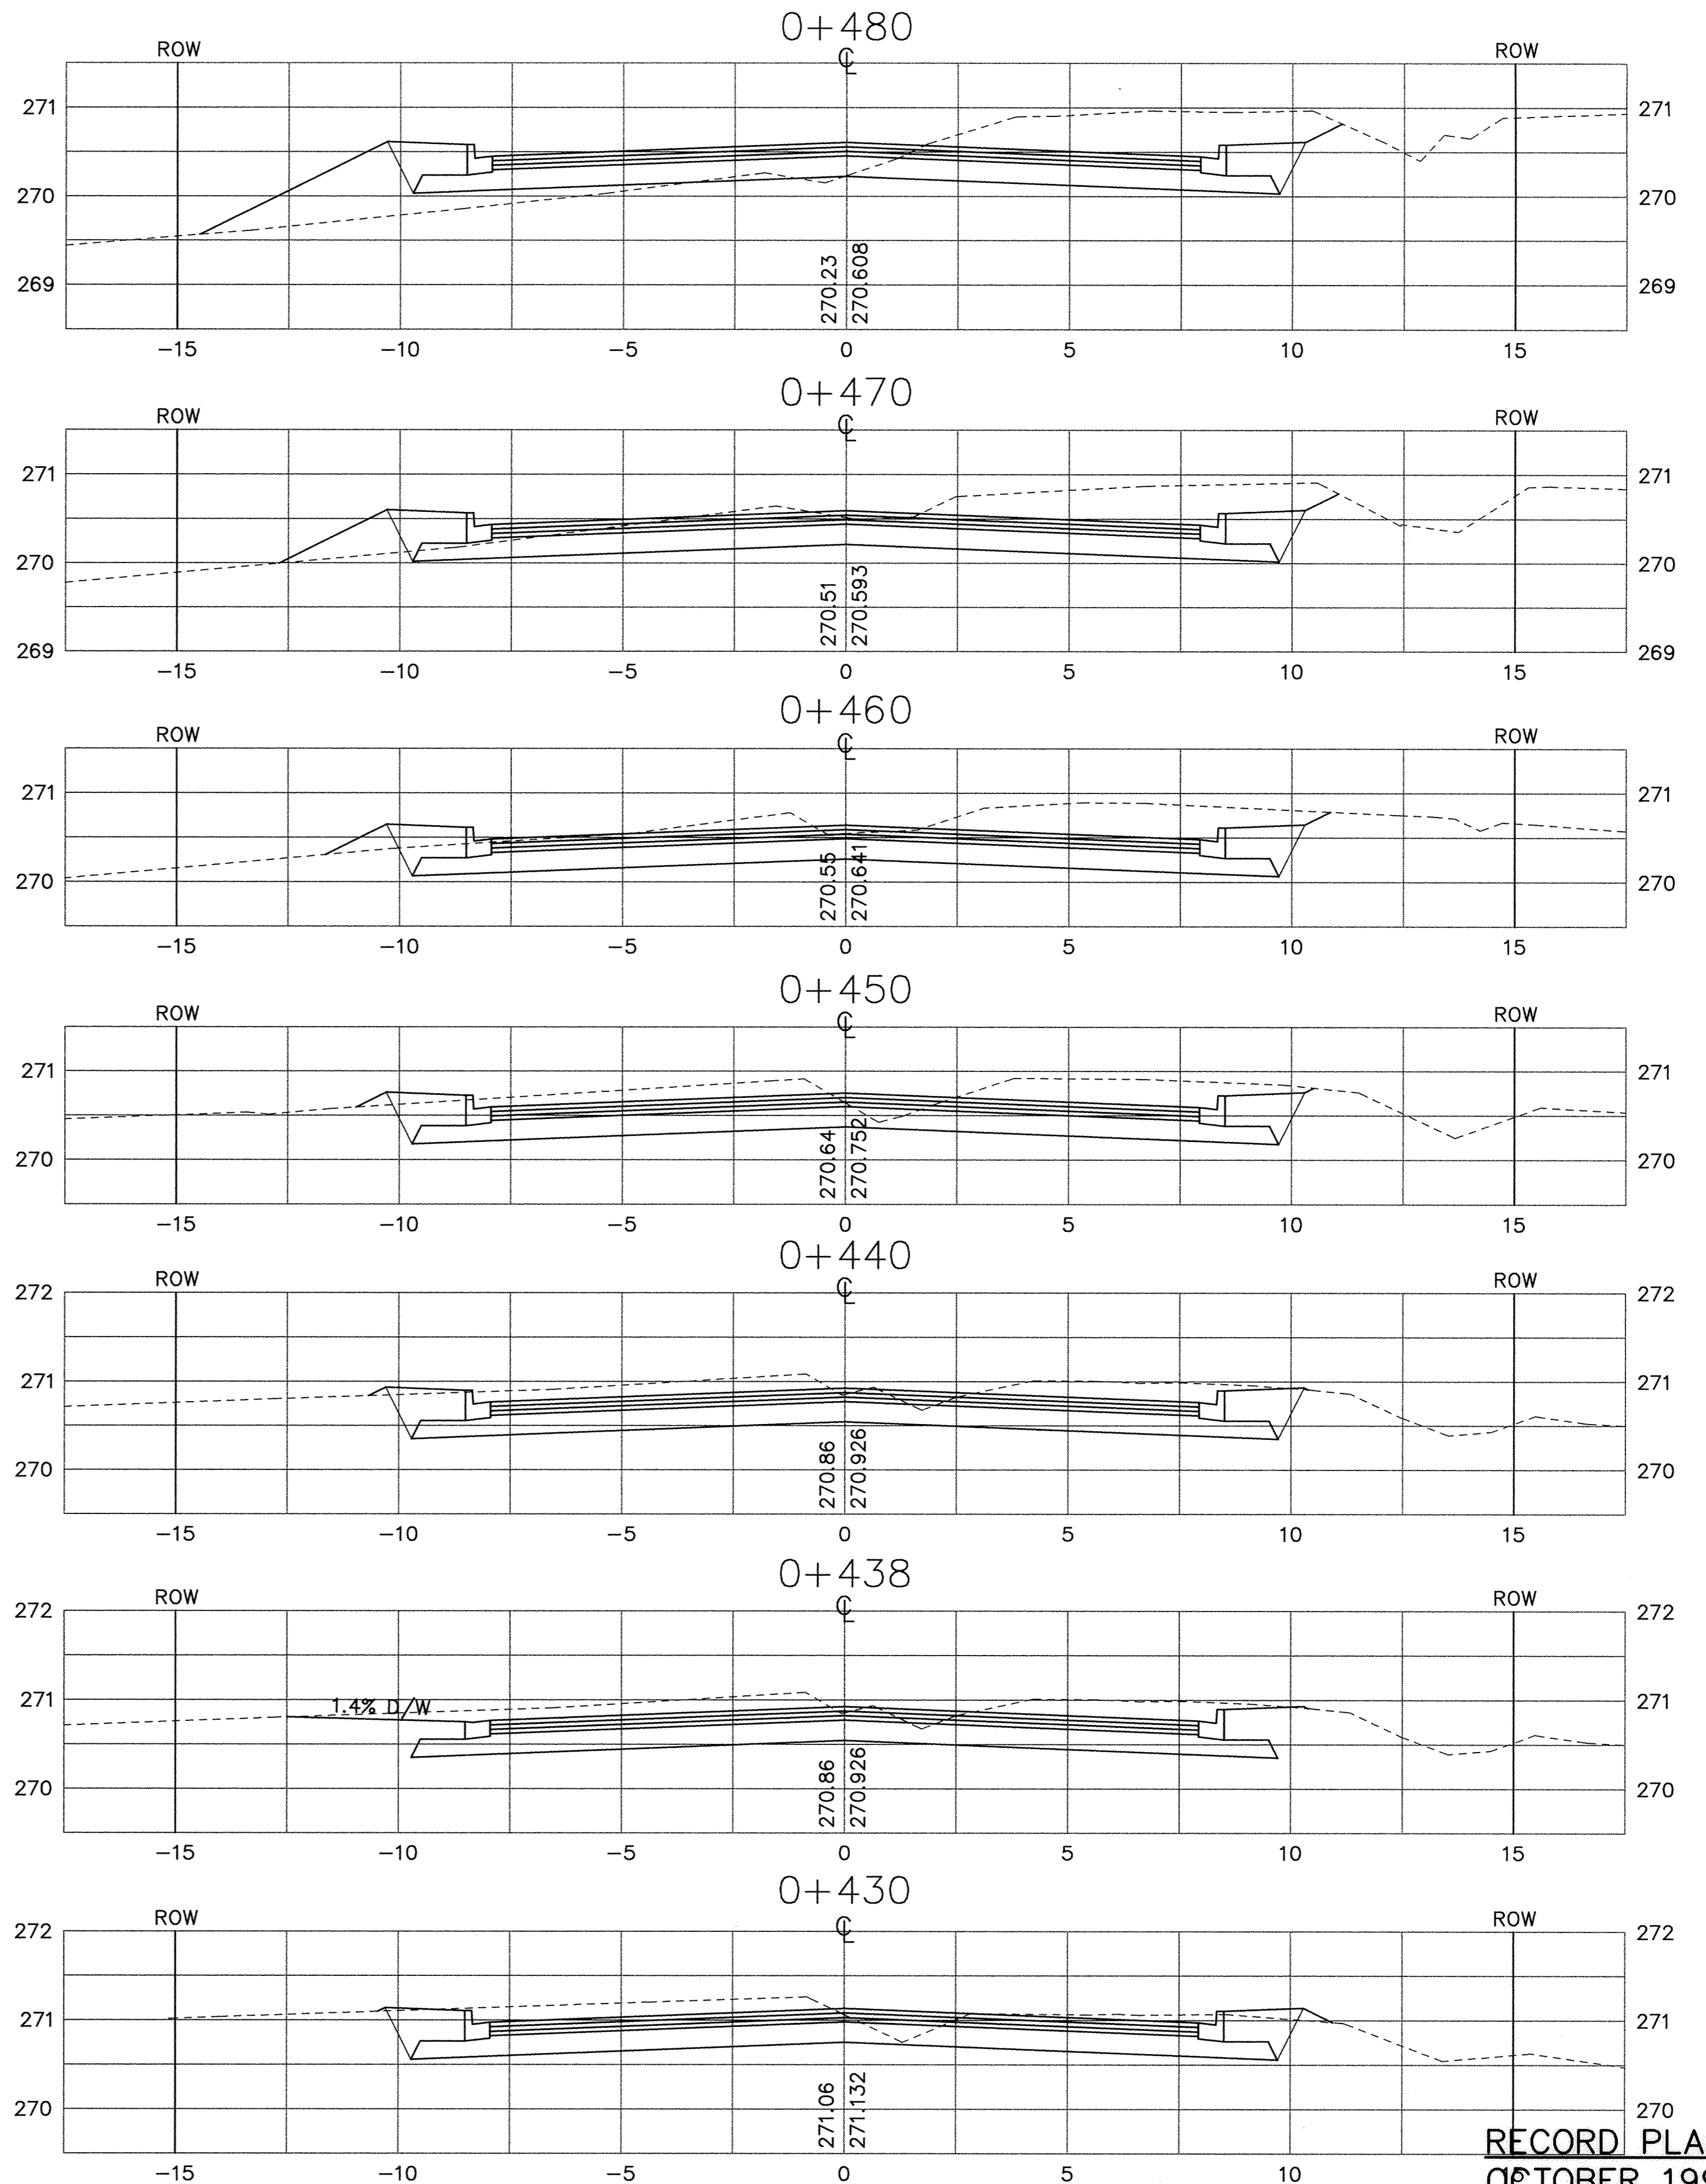

RECORD PLAN
OCTOBER 1997

CITY OF ELK RIVER
171ST AVENUE
CROSS SECTIONS
171ST AVENUE


S.A.P. 204-132-01
DATE JULY 1996
SHEET 16 OF 25 SHEETS
PROJECT NO. 230-313-20

STA 0+370 TO STA 0+480

DESIGN	DRAWN
CHECKED	
GRAPHIC SCALES	
0	HORIZ (M) 4
1:250	
0	VERT (M) 2
1:50	

REVISIONS	DATE	DESCRIPTION

1326 ENERGY PARK DRIVE
ST. PAUL, MINNESOTA 55108
(612) 644-4389

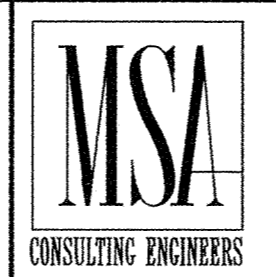

I HEREBY CERTIFY THAT THIS PLAN, SPECIFICATION, OR REPORT WAS PREPARED BY ME OR UNDER MY DIRECT SUPERVISION AND THAT I AM A DULY REGISTERED PROFESSIONAL ENGINEER UNDER THE LAWS OF THE STATE OF MINNESOTA.

David M. Mauer
DATE 7/23/97 REG. NO. 15316