



S&CO PRODUCTS • NEW HOPE, MINNESOTA
 REVISIONS CHECKED BY: []
 S&CO PRODUCTS • NEW HOPE, MINNESOTA
 REVISIONS CHECKED BY: []
 S&CO PRODUCTS • NEW HOPE, MINNESOTA
 REVISIONS CHECKED BY: []
 S&CO PRODUCTS • NEW HOPE, MINNESOTA
 REVISIONS CHECKED BY: []

ULYSSES STREET

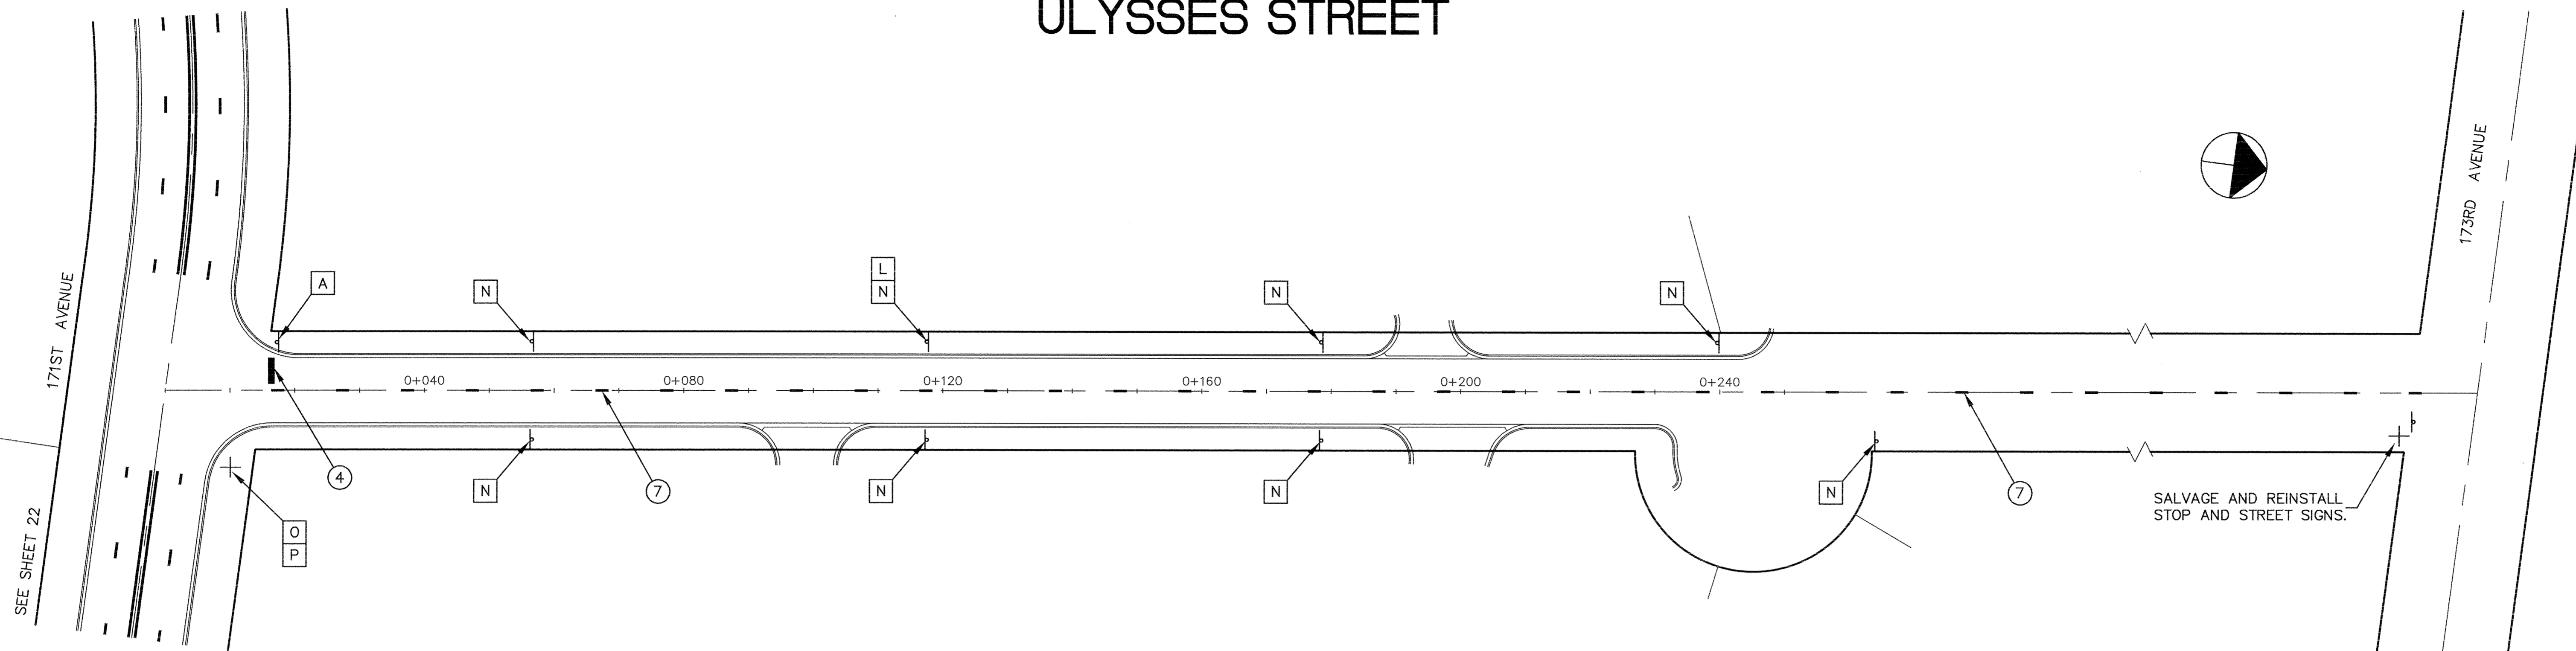

TRUNK HIGHWAY NO. 10

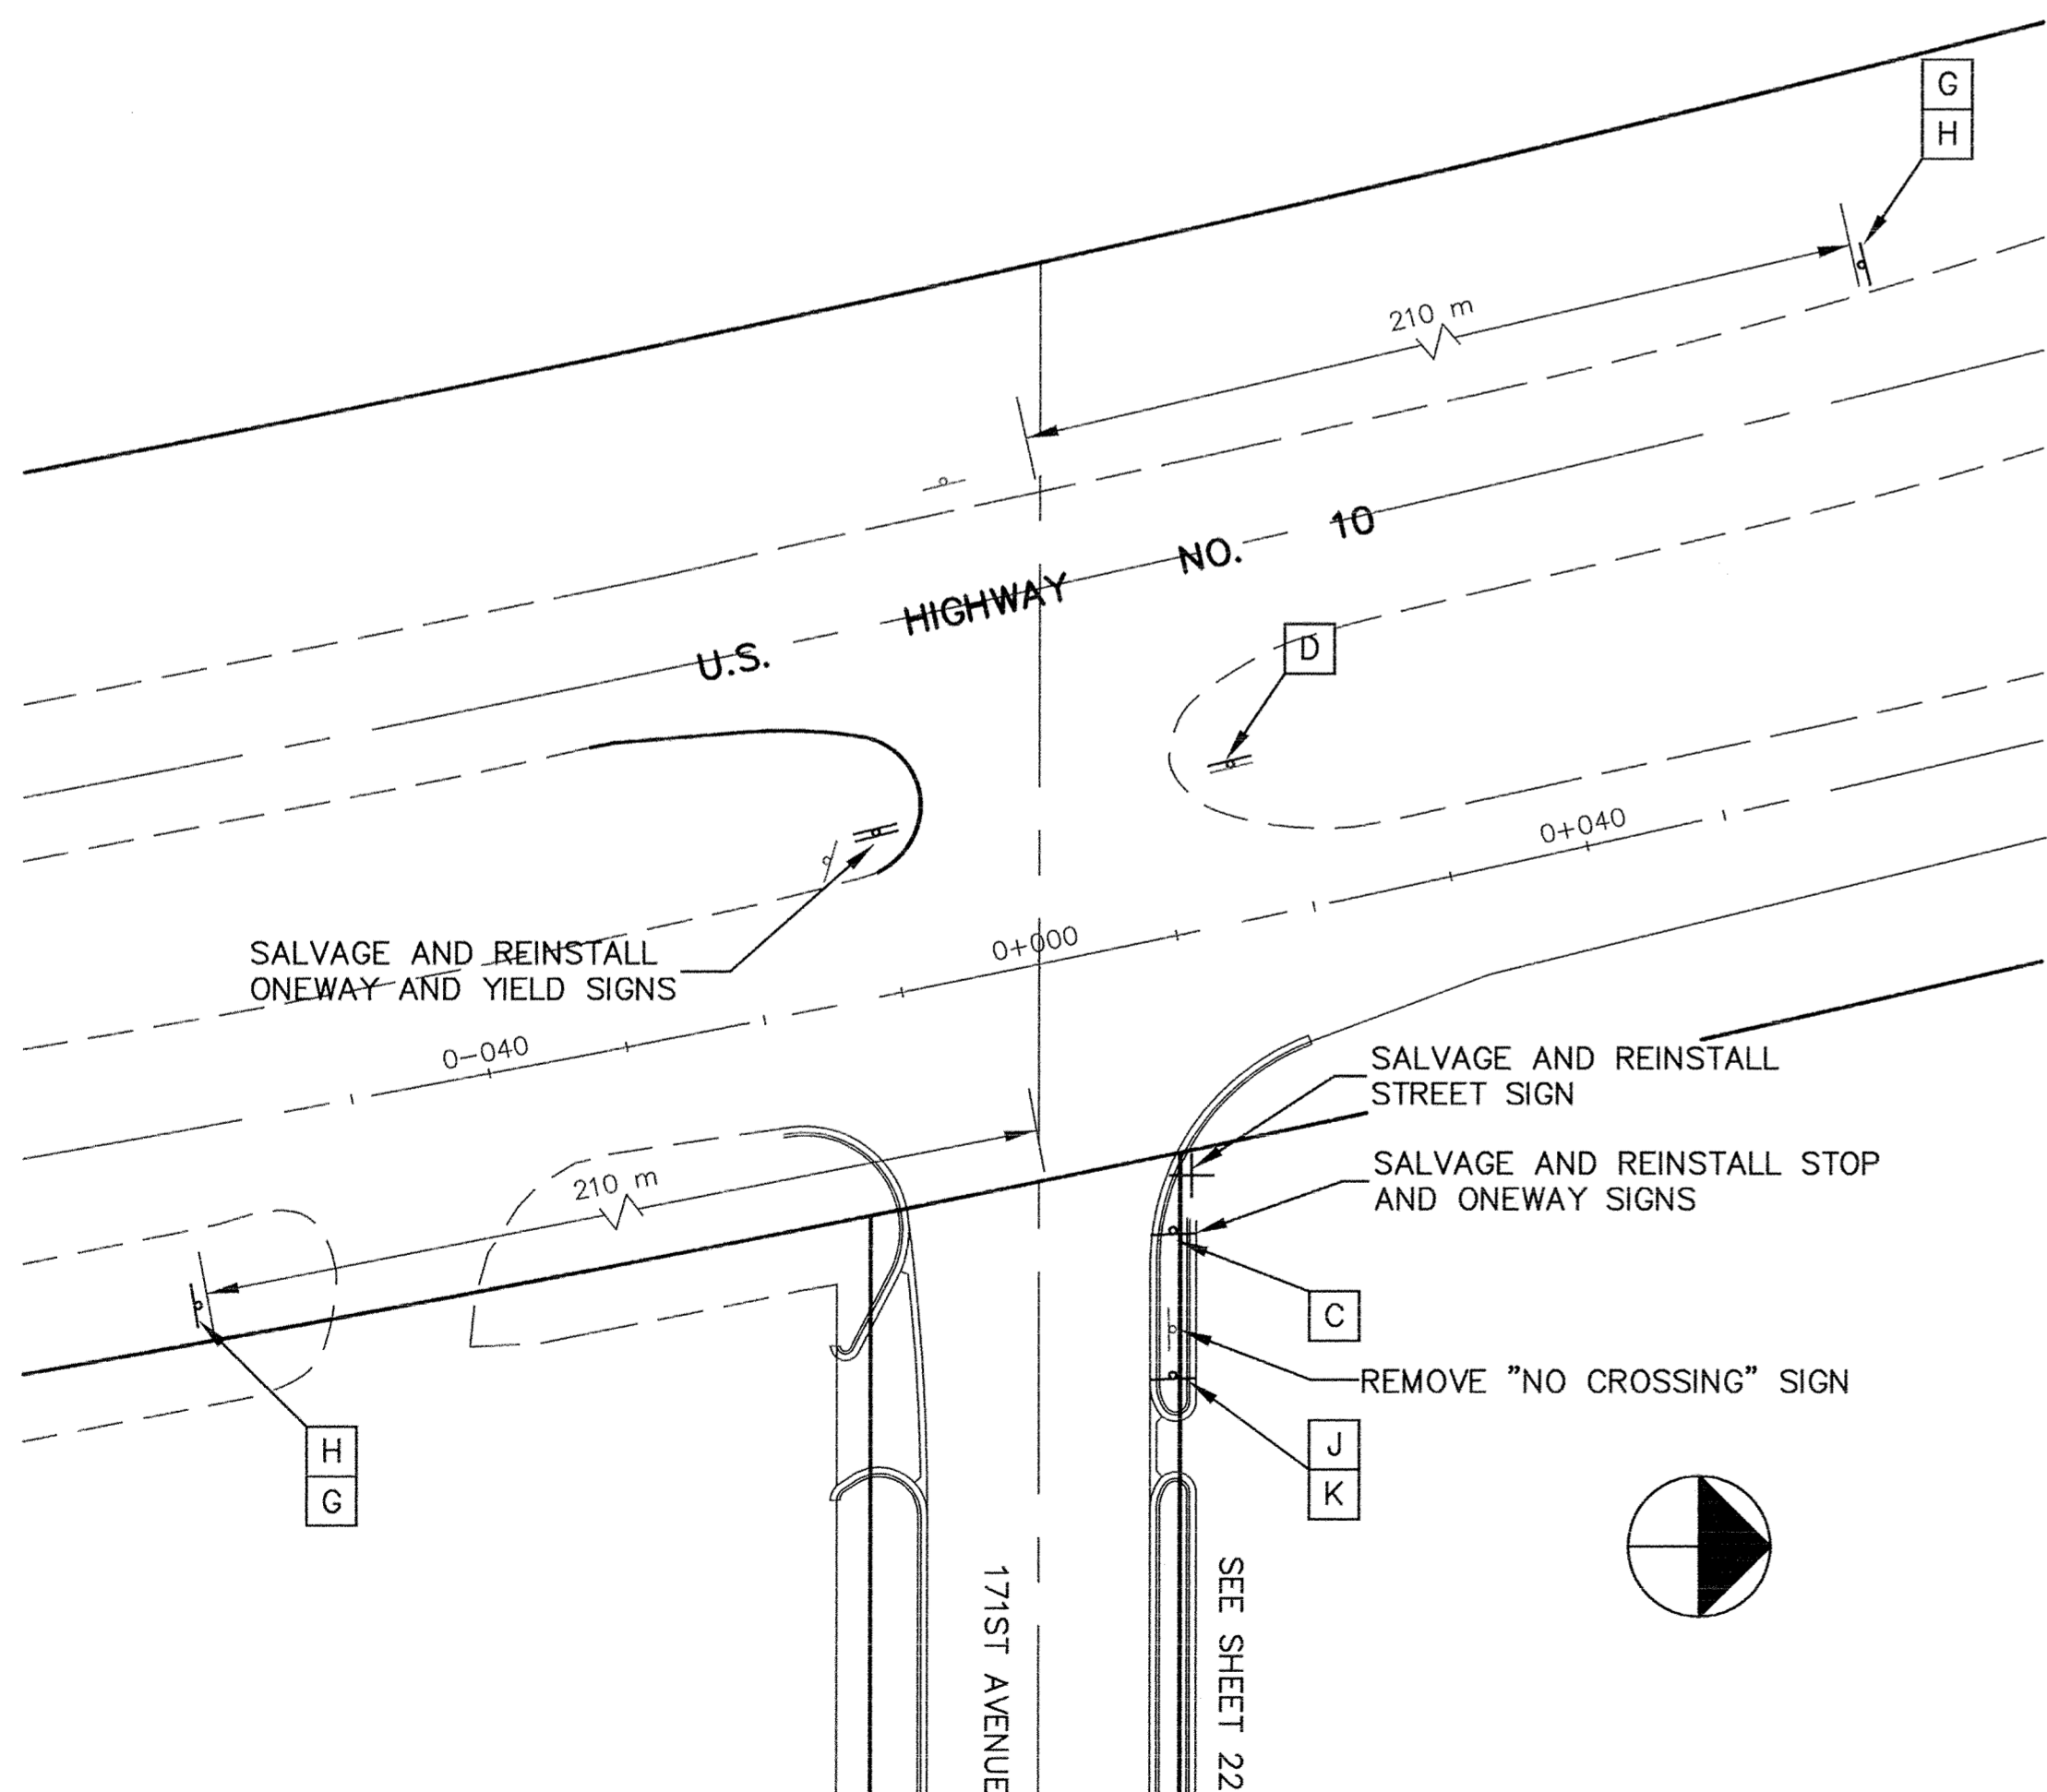

PERMANENT SIGNS				
KEY	WORDING/SYMBOL	SIZE	PLATE CODE	QUANTITY THIS SHEET
A	STOP	750 mm X 750 mm	R1-1	1
B	LARGE ARROW SIGN	1200 mm X 600 mm	W1-7	0
C	DIVIDED HIGHWAY	600 mm X 450 mm	R6-3	1
D	ONE WAY (LEFT)	900 mm X 300 mm	R6-1	1
E	EXIT ONLY	300 mm X 200 mm		0
F	DO NOT ENTER	750 mm X 750 mm	R5-1	0
G	TEE (SIDE)	750 mm X 750 mm	W2-2	2
H	171ST AVENUE	900 mm X 300 mm	D-3	2
I	BARRICADES TYPE III	1.5 m X 2.4 m	MNDOT PLATE 8002G	0
J	LEFT/RIGHT TURNS ONLY	900 mm X 750 mm	R3-8B	1
K	U.S. HIGHWAY 10	600 mm X 600 mm	M1-4	1
L	TEE STRAIGHT AHEAD	750 mm X 750 mm	W2-4	1
M	SPEED LIMIT 35 MPH	600 mm X 750 mm	R2-1	0
N	NO PARKING	300 mm X 450 mm	R8-3	8
O	171ST AVENUE	150 mm X 600 mm	D-3	2
P	ULYSSES STREET	150 mm X 600 mm	D-3	2

PERMANENT STRIPING				
KEY	DESCRIPTION	WIDTH	COLOR	REMARKS
①	LANE LINE	100 mm	WHITE	7.6 m SOLID STRIPE @ 45° ANGLE
②	LANE LINE	100 mm	WHITE	SKIP - 2 m STRIPE, 8 m SPACE
③	CENTER STRIPE	100 mm	YELLOW	SOLID DOUBLE
④	STOP BAR	600 mm	WHITE	SOLID
⑤	LEFT TURN ARROW	250 mm X 2.5 m	WHITE	SOLID
⑥	RIGHT TURN ARROW	250 mm X 2.5 m	WHITE	SOLID
⑦	CENTER STRIPE	100 mm	YELLOW	SKIP - 2 m STRIPE, 8 m SPACE

I HEREBY CERTIFY THAT THIS PLAN, SPECIFICATION, OR REPORT WAS PREPARED BY ME OR UNDER MY DIRECT SUPERVISION AND THAT I AM A DULY REGISTERED PROFESSIONAL ENGINEER UNDER THE LAWS OF THE STATE OF MINNESOTA.

Kevin Mauer
 DATE 7/23/96 REG. NO. 15316



1326 ENERGY PARK DRIVE
 ST. PAUL, MINNESOTA 55108
 (612) 644-4389

DATE	DESCRIPTION	DESIGN	DRAWN
		CHECKED	
		GRAPHIC SCALES	
		0	20
		HORIZ (M)	
		0	2
		VERT (M)	
		0	2
		HORIZ (M)	
		0	2
		VERT (M)	

CITY OF ELK RIVER
 171ST AVENUE
 SIGNING AND STRIPING PLAN
 171ST AVENUE / T.H. 10 / ULYSSES STREET
 S.A.P. 204-132-01(171ST AVE.) S.A.P. 204-010-04(TH 10)

DATE JULY 1996 SHEET 23 OF 25 SHEETS PROJECT NO. 230-313-20

RECORD PLAN
 OCTOBER 1997