



S&D PRODUCTS • NEW HARBURG, MINNESOTA
DESIGNED BY JOHN ANDERSON, LIC. 15316
S&D PRODUCTS • NEW HARBURG, MINNESOTA
DESIGNED BY JOHN ANDERSON, LIC. 15316
S&D PRODUCTS • NEW HARBURG, MINNESOTA
DESIGNED BY JOHN ANDERSON, LIC. 15316
S&D PRODUCTS • NEW HARBURG, MINNESOTA
DESIGNED BY JOHN ANDERSON, LIC. 15316

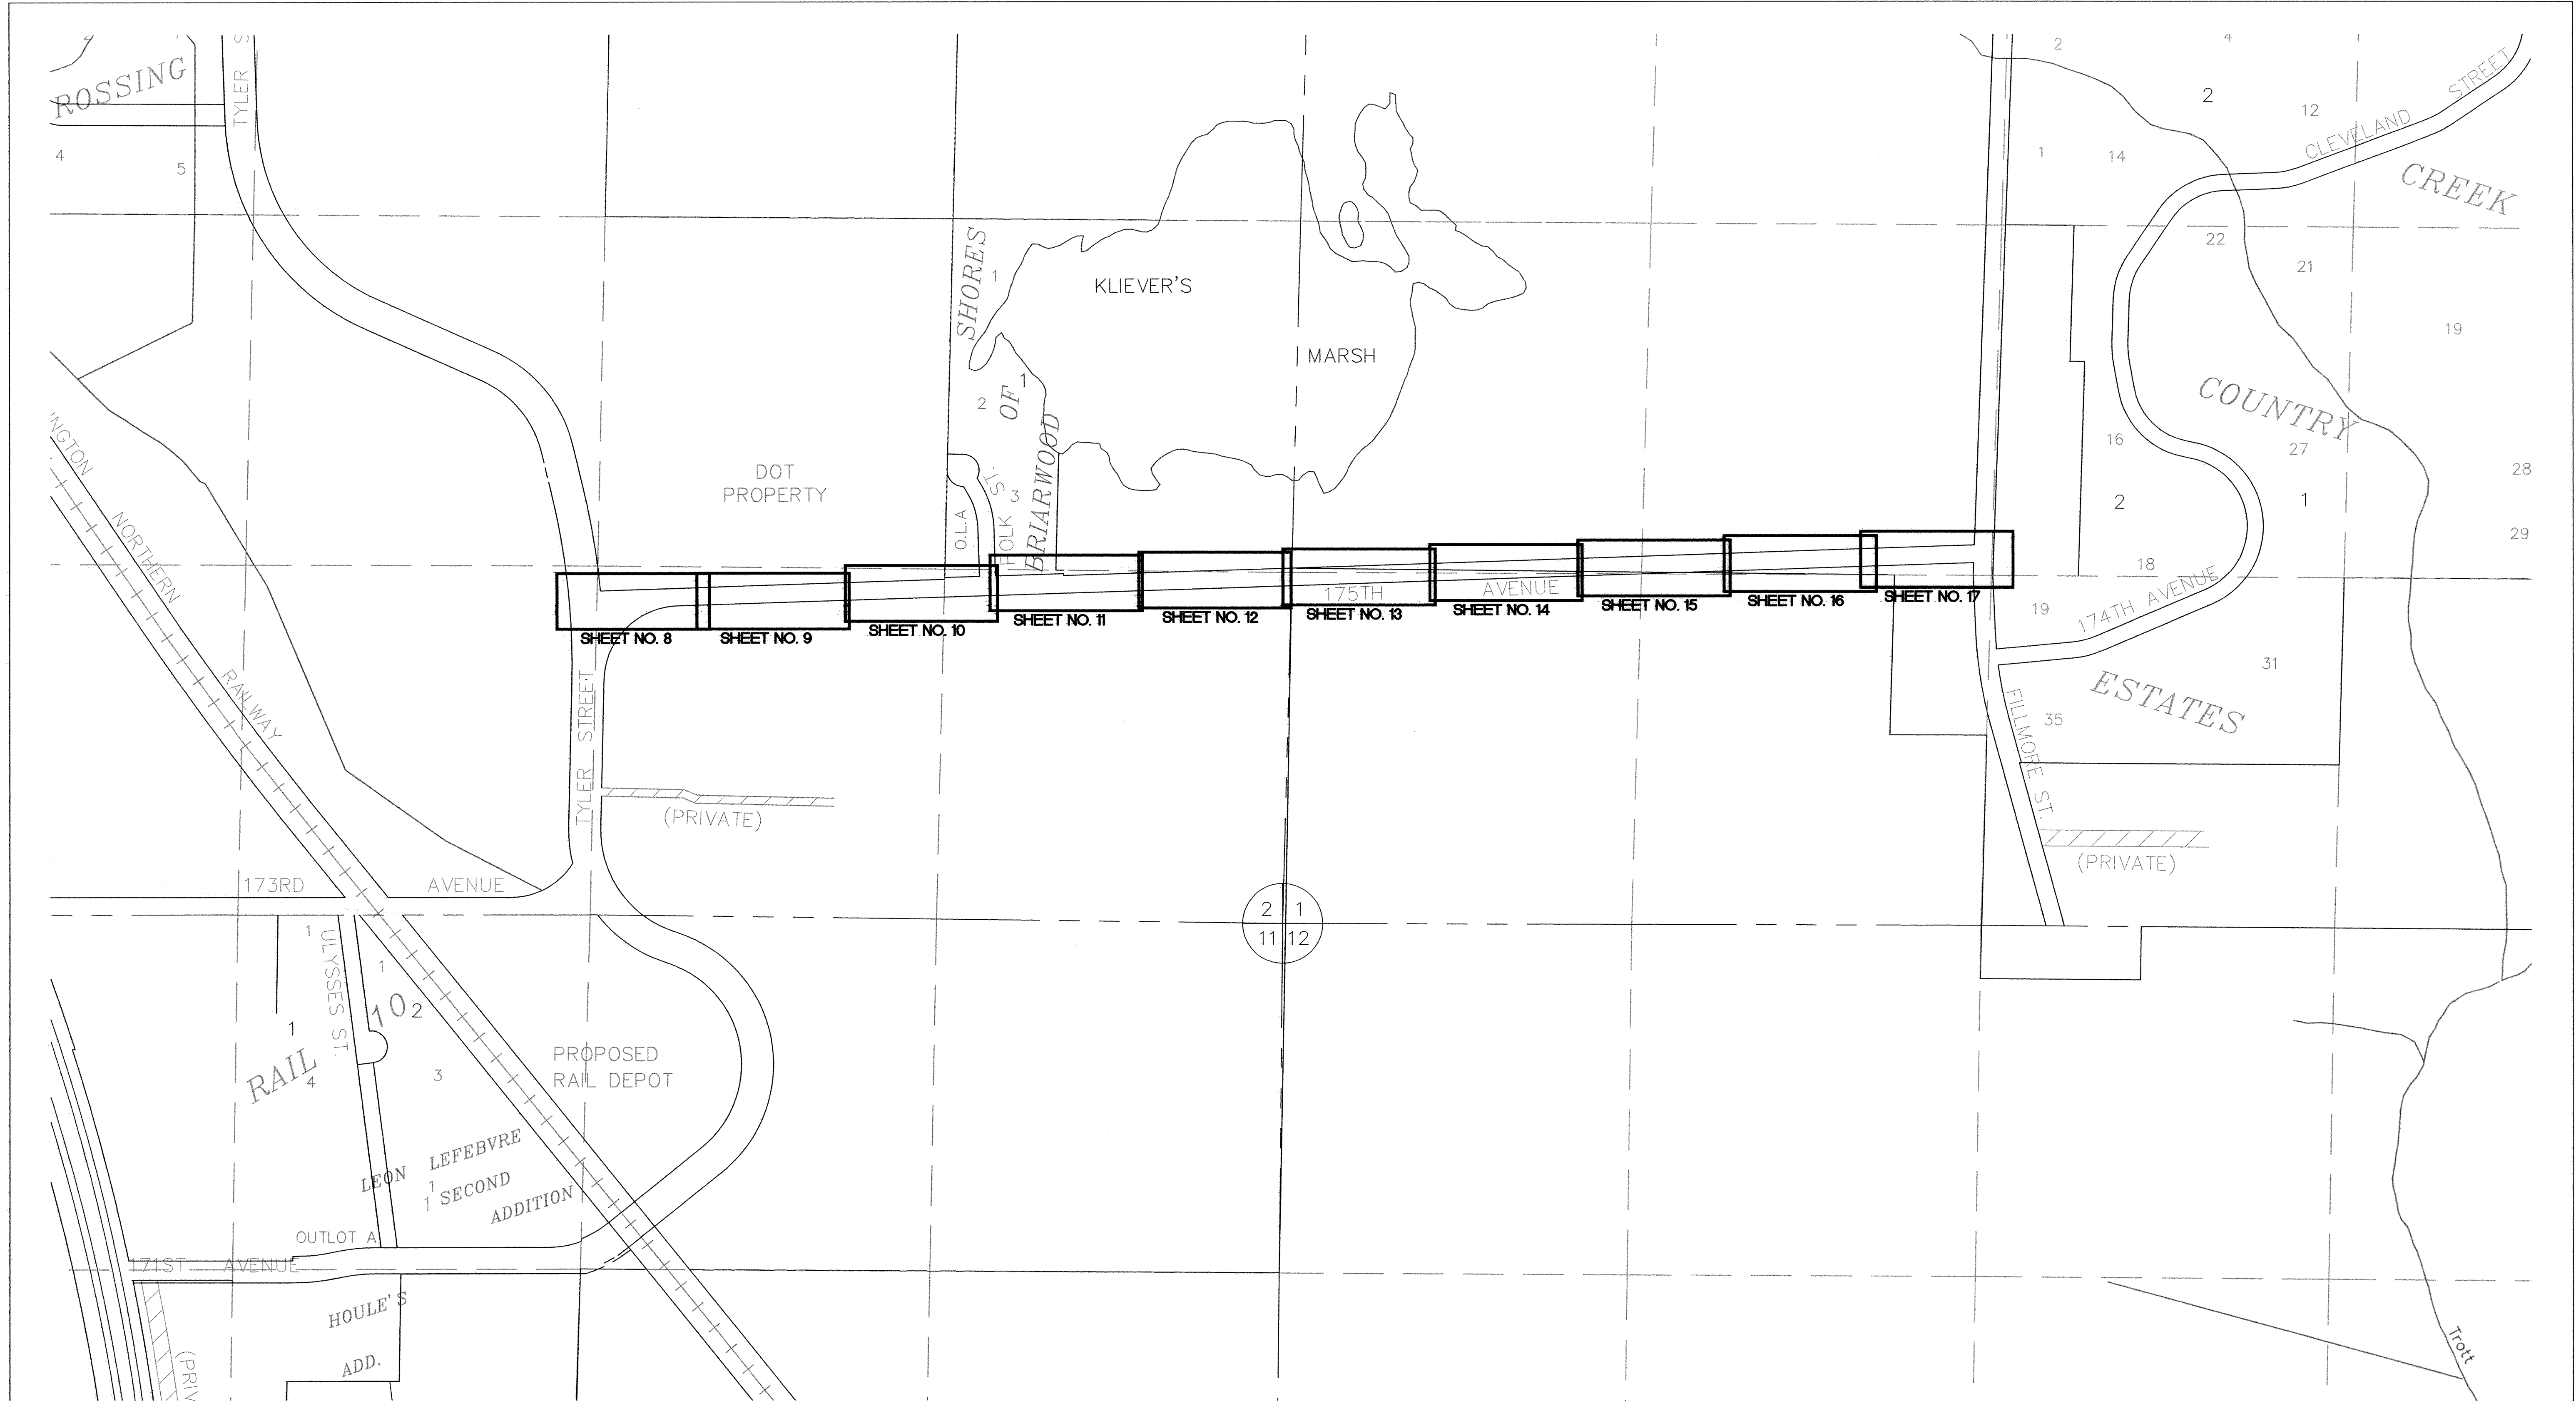

RECORD PLAN
JANUARY 2005

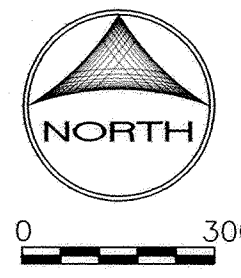

DESIGNED BY: KJT DRAWN BY: RKM
APPROVED: TJM JOB NUMBER 806550J
CAD DATE: January 28, 2005 10:19:29 a.m.
CAD FILE: 806550J\AS-BUILT\MISC\LOCATION.DWG (JOUNIN)

I HEREBY CERTIFY THAT THIS PLAN, SPECIFICATION, OR REPORT WAS PREPARED BY ME OR UNDER MY DIRECT SUPERVISION AND THAT I AM A DULY LICENSED PROFESSIONAL ENGINEER UNDER THE LAWS OF THE STATE OF MINNESOTA.

DATE _____
JOHN M. ANDERSON LIC. 15316

NO.	DATE	BY	REVISION DESCRIPTION

Howard R. Green Company
CONSULTING ENGINEERS

1326 ENERGY PARK DRIVE
ST. PAUL, MINNESOTA 55108
(651) 644-4389

CITY OF ELK RIVER

STREET IMPROVEMENTS
175TH AVENUE

S.P. 204-111-04

SHEET NO.
2