
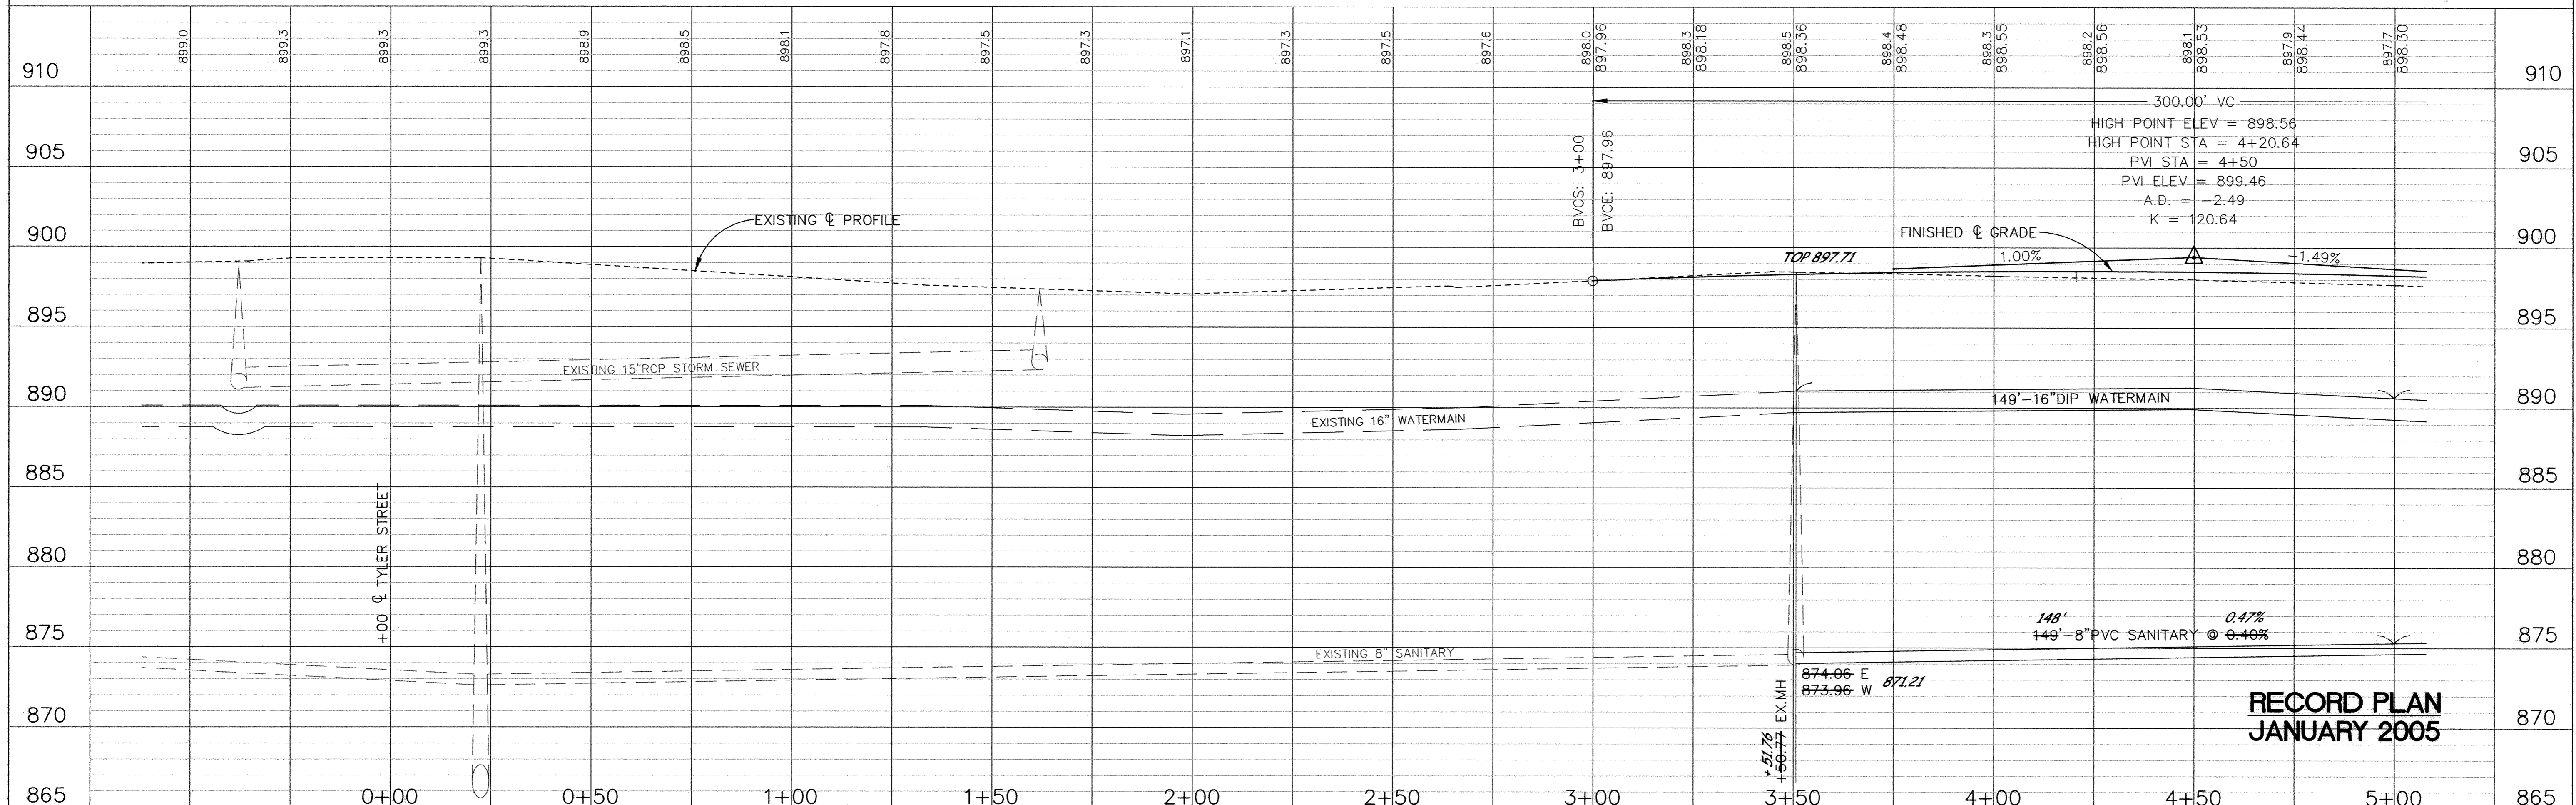
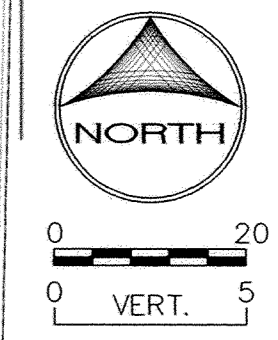


# 175TH AVENUE

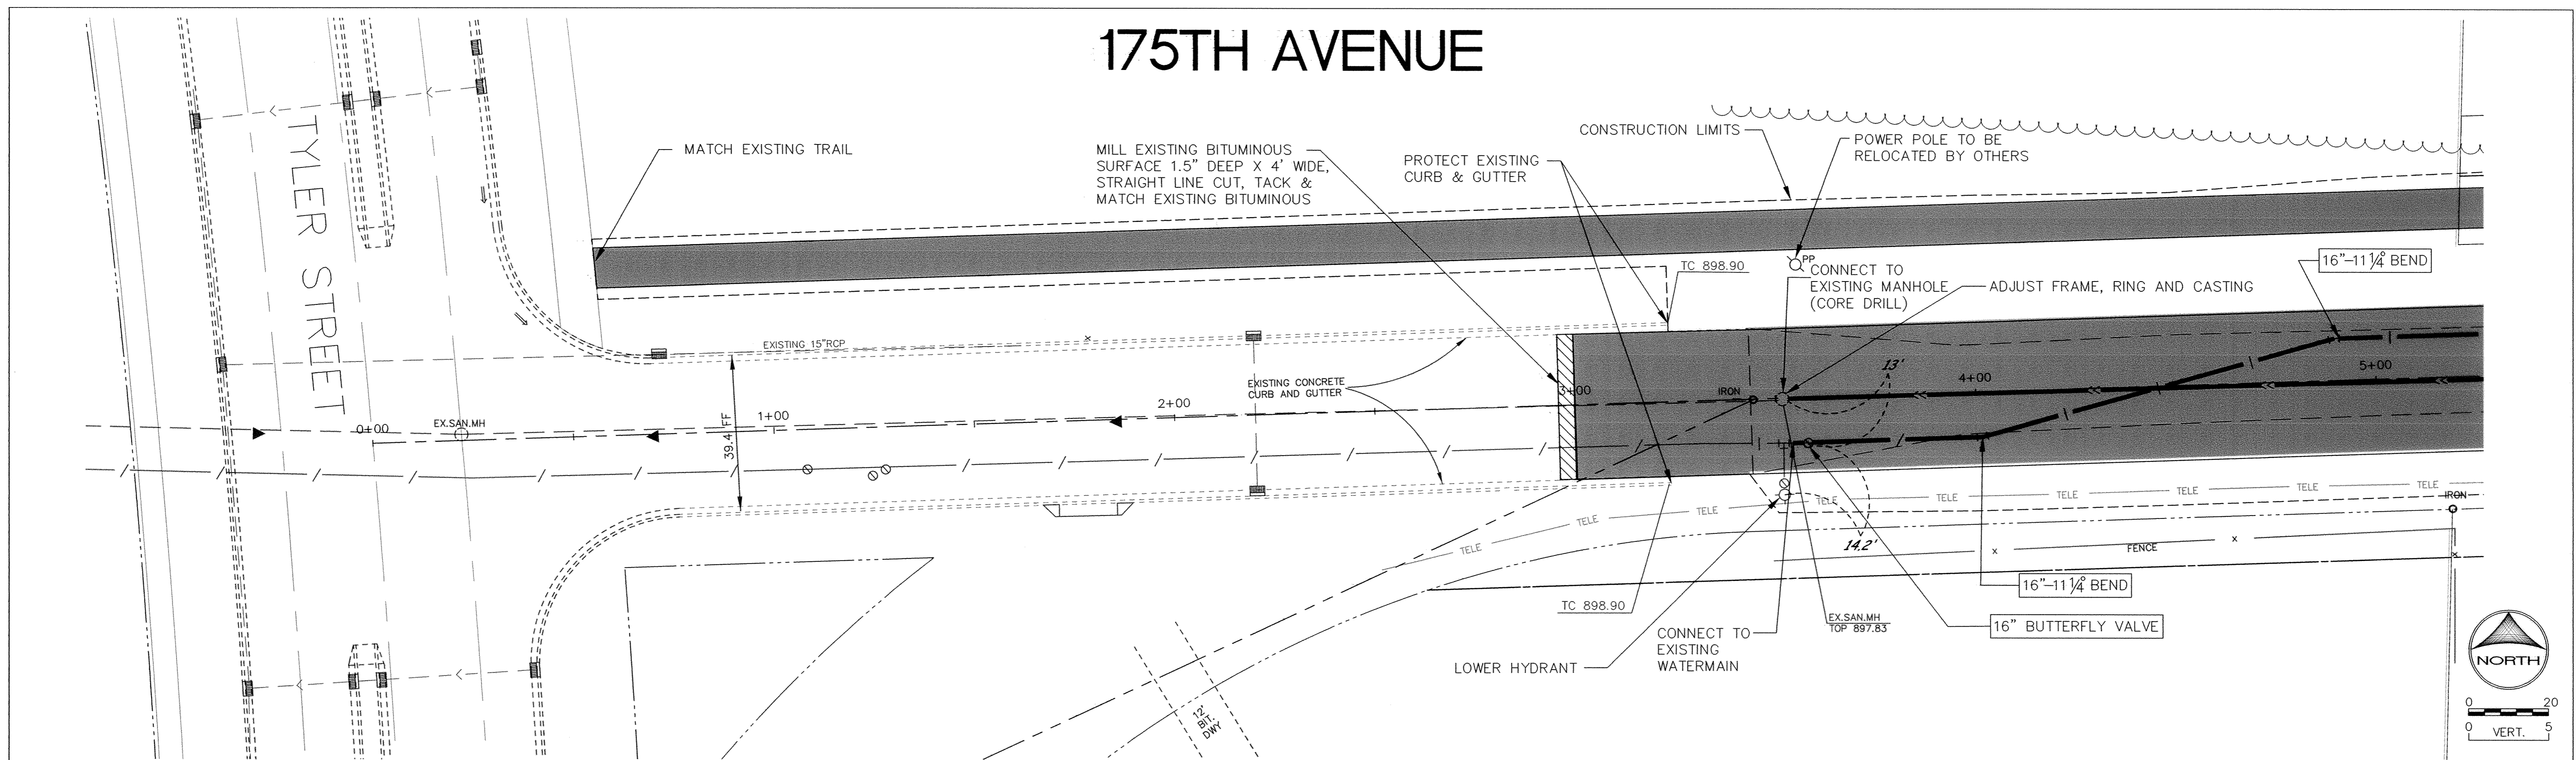

**RECORD PLAN  
JANUARY 2005**

DESIGNED BY: KJT DRAWN BY: RKM  
 APPROVED: TJM JOB NUMBER 806550J  
 CAD DATE: January 28, 2005 10:35:13 a.m.  
 CAD FILE: 806550J\AS-BUILT\01N\_R14.DWG (JCUNNIN)

I HEREBY CERTIFY THAT THIS PLAN, SPECIFICATION, OR REPORT WAS PREPARED BY ME OR UNDER MY DIRECT SUPERVISION AND THAT I AM A DULY LICENSED PROFESSIONAL ENGINEER UNDER THE LAWS OF THE STATE OF MINNESOTA.  
 JSM/MLM DATE 2/2/05  
 JERRY M. ANDERSON LIC. 25889

NO.	DATE	BY	REVISION DESCRIPTION

1326 ENERGY PARK DRIVE  
 ST. PAUL, MINNESOTA 55108  
 (651) 644-4389

**Howard R. Green Company**  
 CONSULTING ENGINEERS

**175TH AVENUE**  
 CITY OF ELK RIVER  
 175TH AVENUE

STREET IMPROVEMENTS

SP. 204-111-04

0+00 TO 5+00

SHEET NO.  
**8**