



175TH AVENUE



F & I 30'-15" CMP W/ 6:1 SAFETY APRONS AT EACH END. LOCATION TO BE VERIFIED IN THE FIELD BY ENGINEER

HYD w/VALVE 24"-6" LEAD 16"X6" TEE

- NOTE:
1. GEOTEXTILE FABRIC SHALL BE PLACED UNDER RIP RAP AND WILL BE CONSIDERED INCIDENTAL TO THE ITEM.
 2. SERVICE LOCATIONS TO BE DETERMINED IN THE FIELD BY THE ENGINEER.
 3. INSTALL 4" INSULATION AT ALL HYDRANT LEAD LOCATIONS.

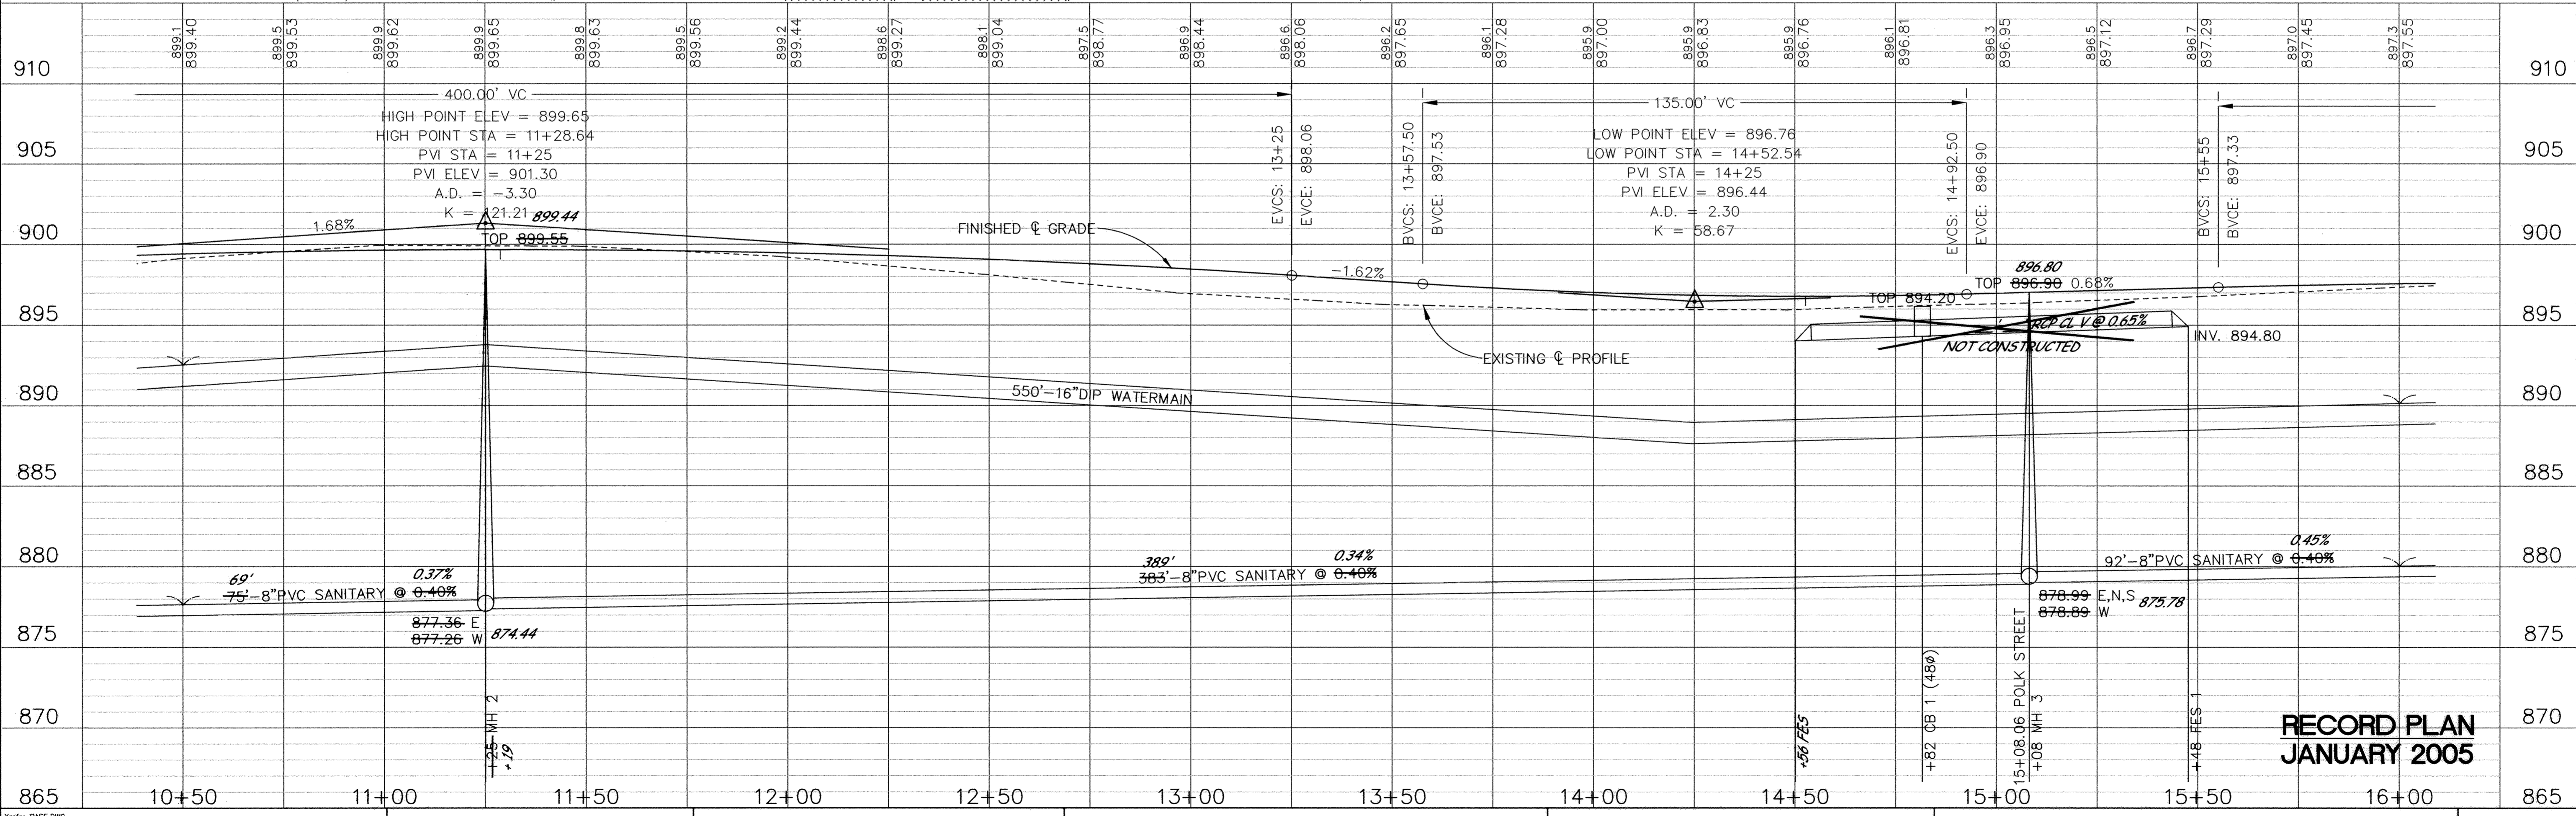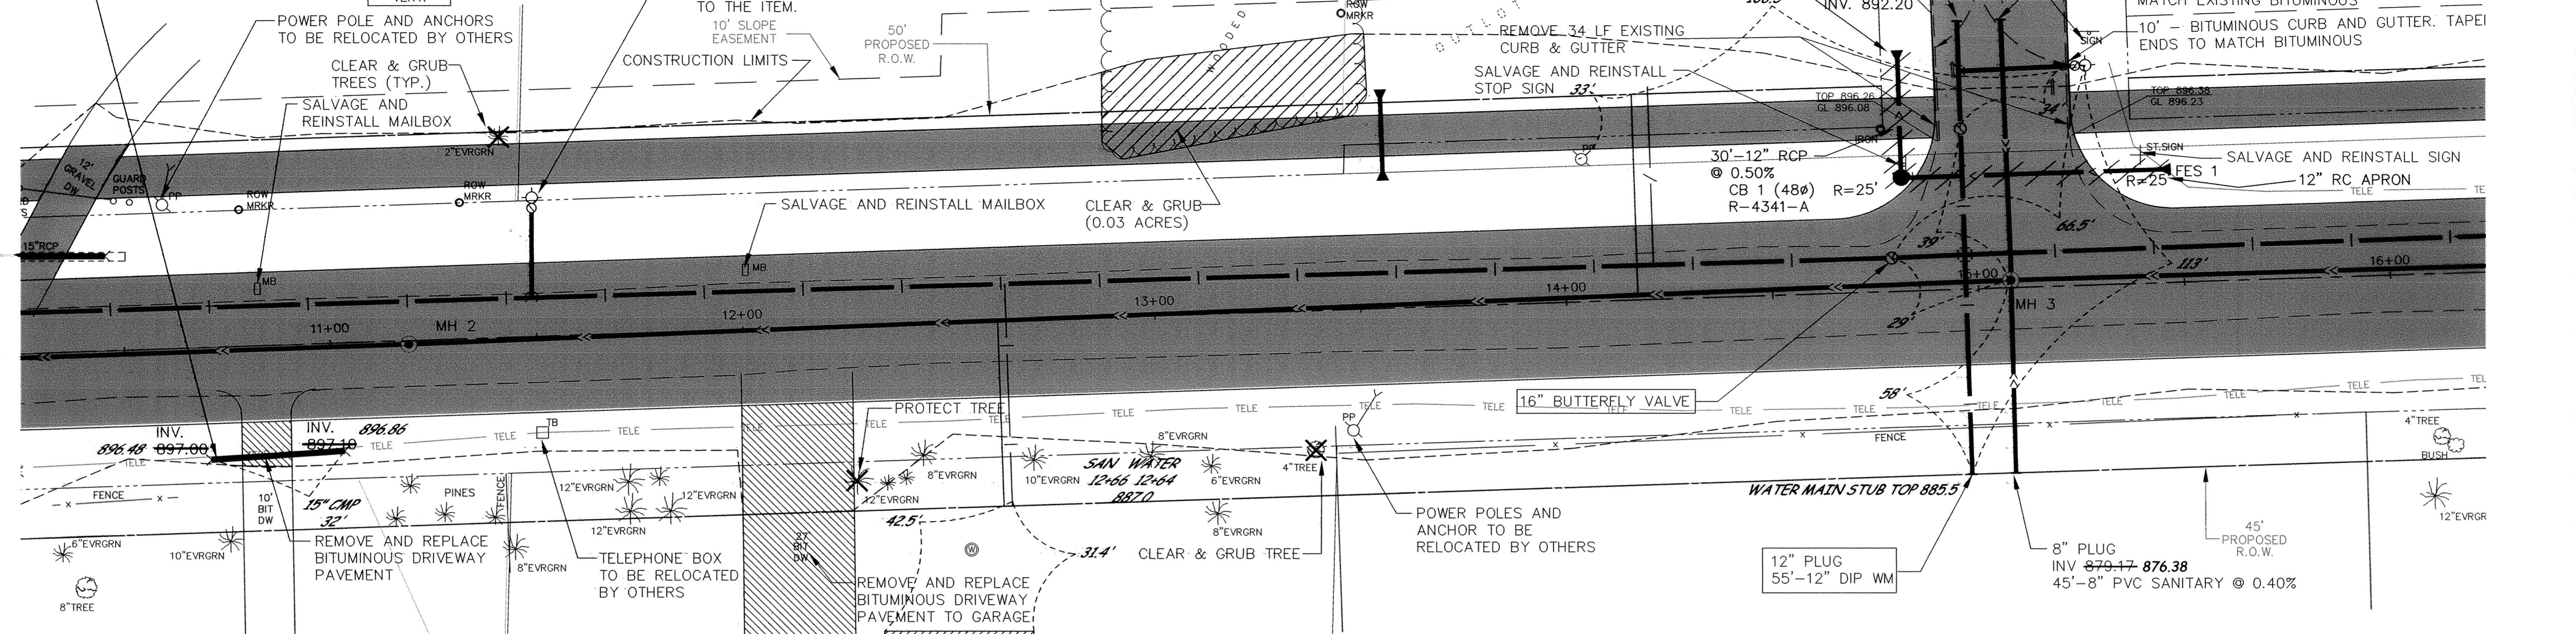

DESIGNED BY: KJT DRAWN BY: RKM
 APPROVED: TJM JOB NUMBER 806550J
 CAD DATE: January 28, 2005 10:44:10 a.m.
 CAD FILE: 806550J\AS-BUILT\03N_R14.DWG (JCUNNIN)

I HEREBY CERTIFY THAT THIS PLAN, SPECIFICATION, OR REPORT WAS PREPARED BY ME OR UNDER MY DIRECT SUPERVISION AND THAT I AM A DULY LICENSED PROFESSIONAL ENGINEER UNDER THE LAWS OF THE STATE OF MINNESOTA.
 JOHN M. ANDERSON LIC. 25889

NO.	DATE	BY	REVISION DESCRIPTION

1326 ENERGY PARK DRIVE
 ST. PAUL, MINNESOTA 55108
 (651) 644-4389
Howard R. Green Company
 CONSULTING ENGINEERS

175TH AVENUE
 CITY OF ELK RIVER
 175TH AVENUE

S.P. 204-111-04
 STREET IMPROVEMENTS
 10+50 TO 16+00

SHEET NO.
10

RECORD PLAN
JANUARY 2005