

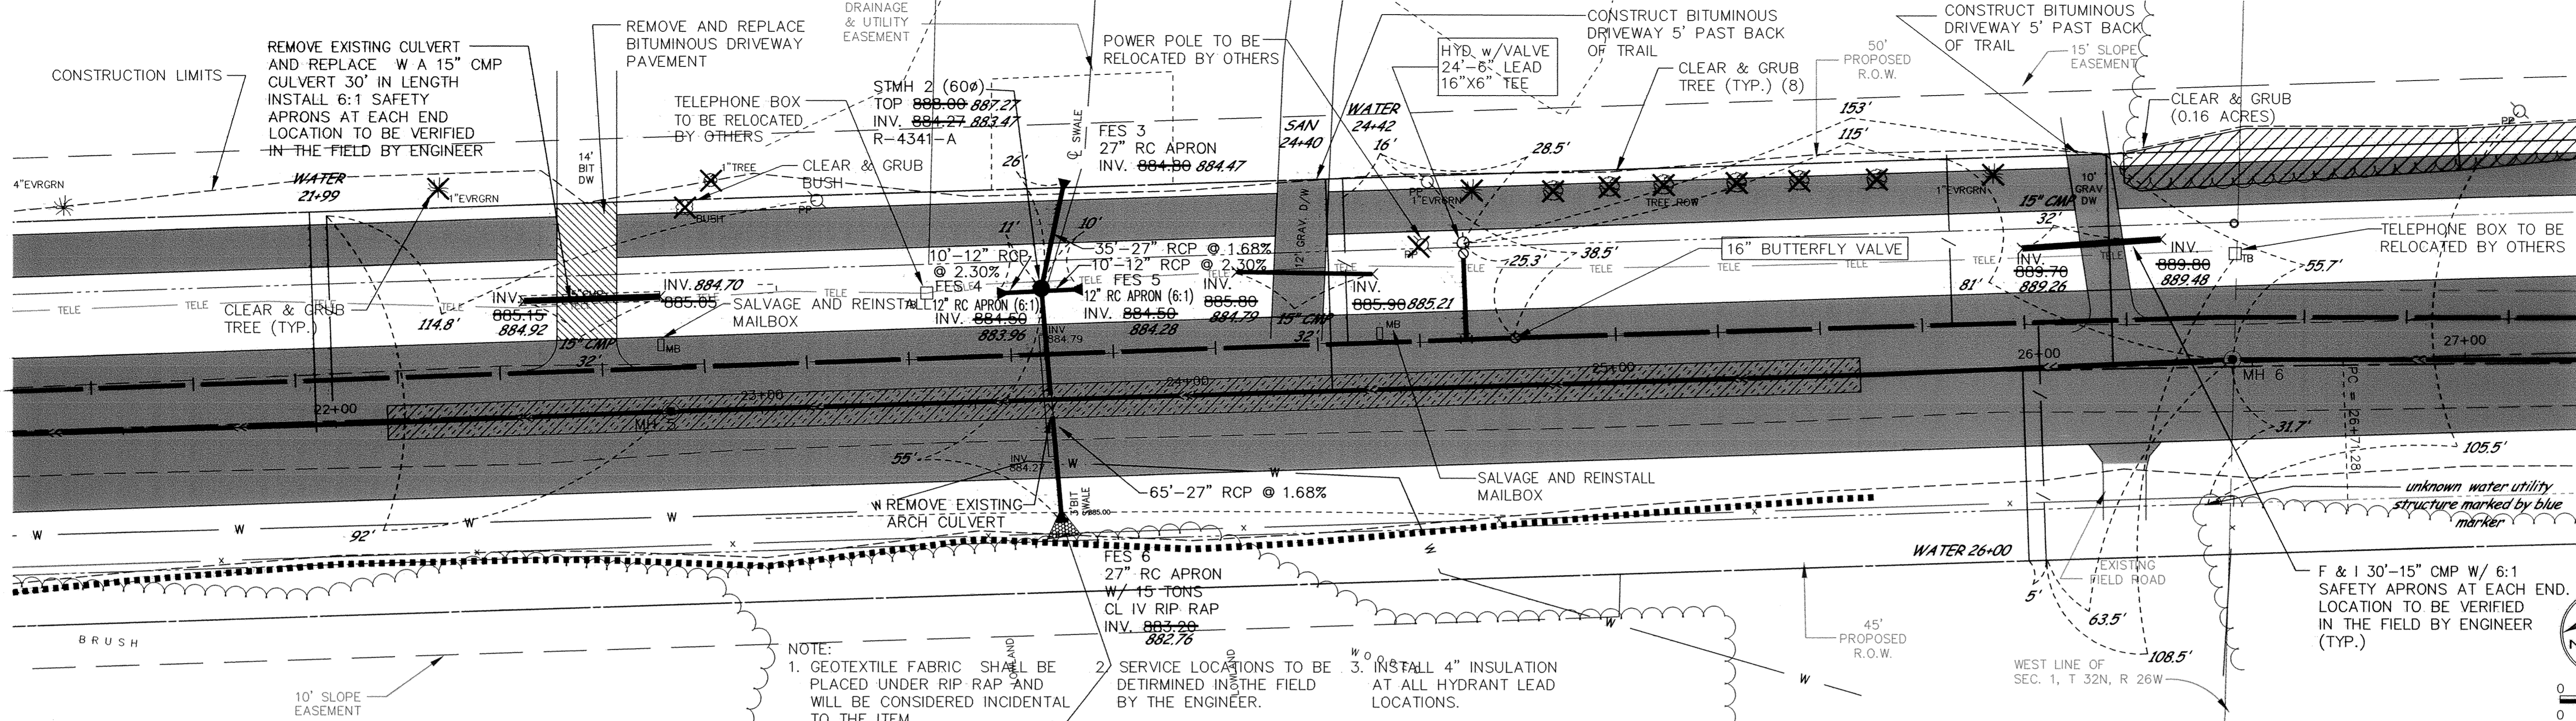


# 175TH AVENUE

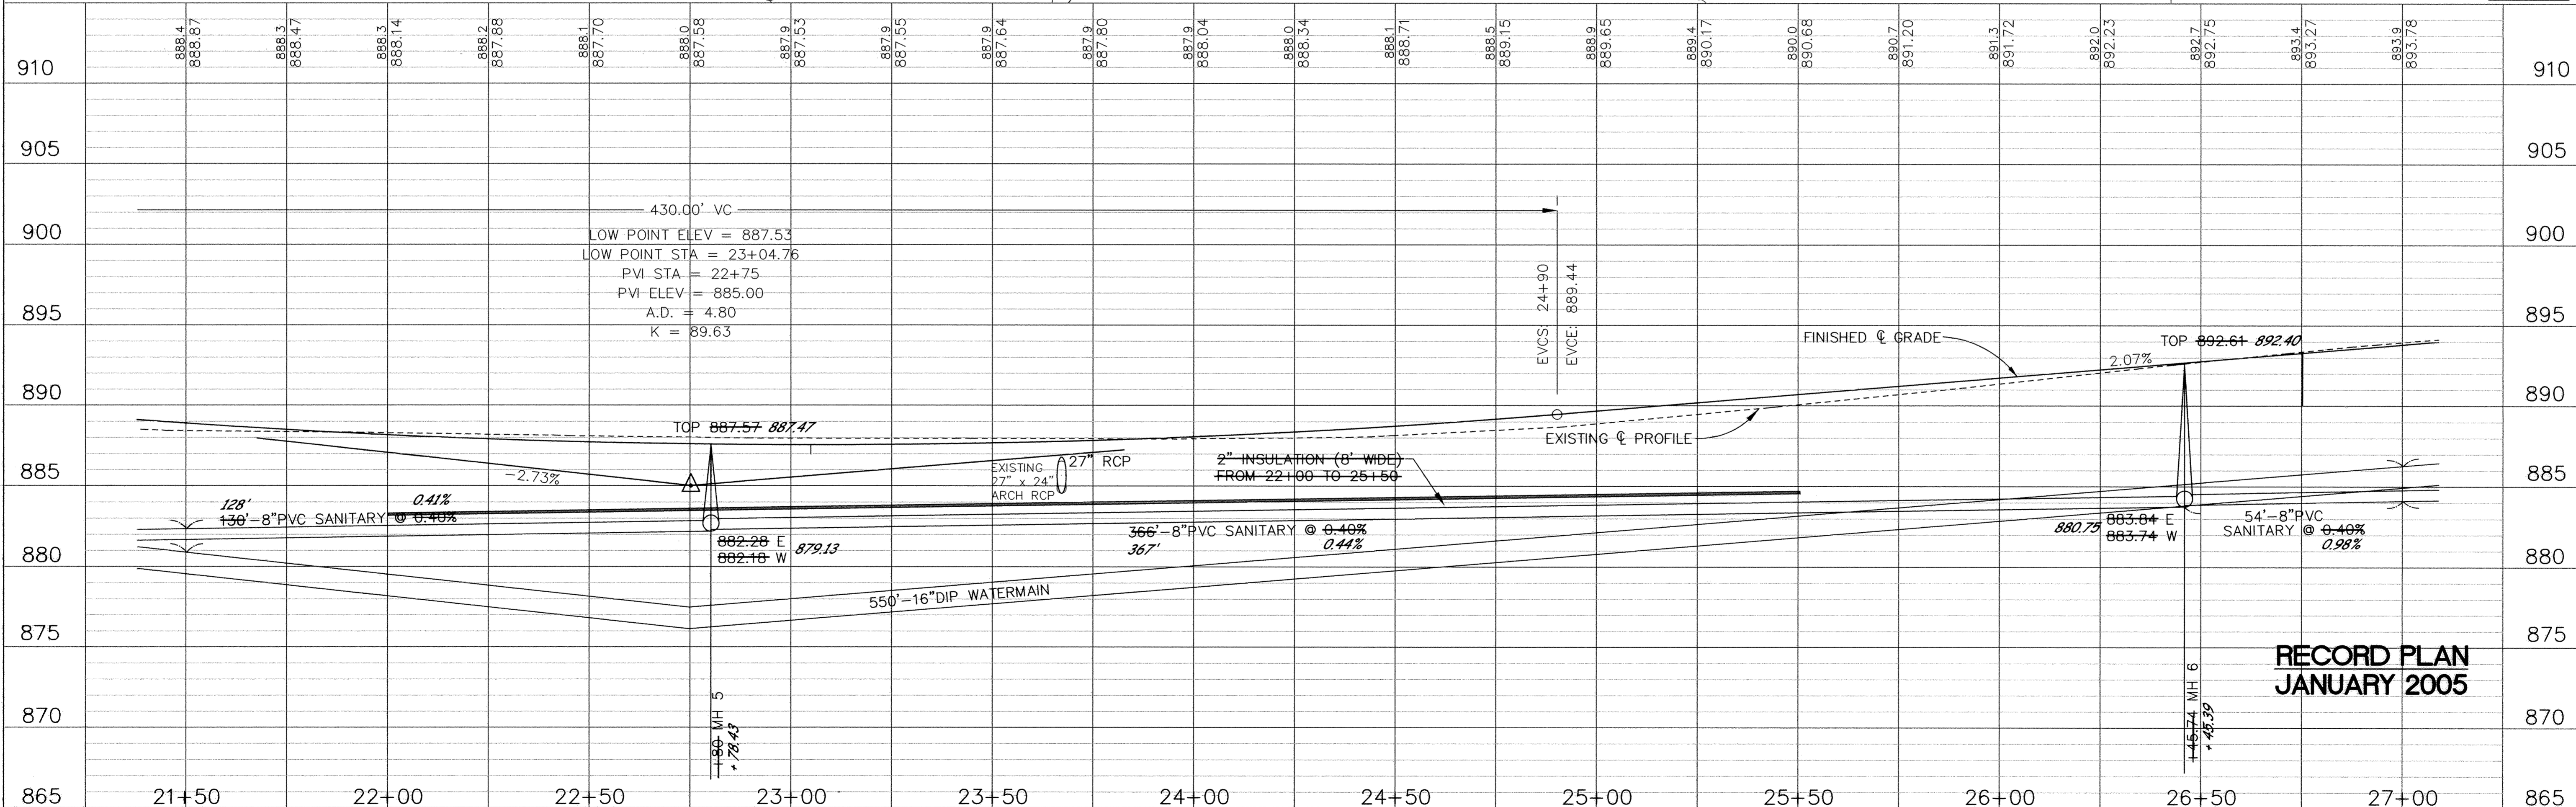

- NOTE:
1. GEOTEXTILE FABRIC SHALL BE PLACED UNDER RIP RAP AND WILL BE CONSIDERED INCIDENTAL TO THE ITEM.
  2. SERVICE LOCATIONS TO BE DETERMINED IN THE FIELD BY THE ENGINEER.
  3. INSTALL 4" INSULATION AT ALL HYDRANT LEAD LOCATIONS.

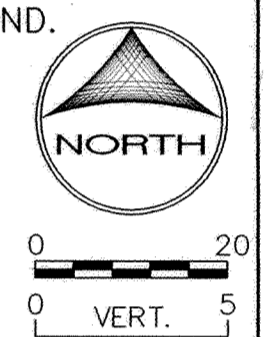

**RECORD PLAN  
JANUARY 2005**

DESIGNED BY: KJT DRAWN BY: RKM  
 APPROVED: TJM JOB NUMBER 806550J  
 CAD DATE: January 28, 2005 10:02:24 a.m.  
 CAD FILE: 806550J\AS-BUILT\05N\_R14.DWG (JCUNNIN)

I HEREBY CERTIFY THAT THIS PLAN, SPECIFICATION, OR REPORT WAS PREPARED BY ME OR UNDER MY DIRECT SUPERVISION AND THAT I AM A DULY LICENSED PROFESSIONAL ENGINEER UNDER THE LAWS OF THE STATE OF MINNESOTA.  
 JOHN M. ANDERSON, LIC. 25889

NO.	DATE	BY	REVISION DESCRIPTION
1	7/05/02	EY	SANITARY SEWER, WATERMAIN

1326 ENERGY PARK DRIVE  
 ST. PAUL, MINNESOTA 55108  
 (651) 644-4389  
**Howard R. Green Company**  
 CONSULTING ENGINEERS

**175TH AVENUE**  
 CITY OF ELK RIVER  
 175TH AVENUE

STREET IMPROVEMENTS  
 S.P. 204-111-04  
 21+50 TO 27+00

SHEET NO.  
**12**

DRAWING NUMBER 175AV.05  
 DRAWING NUMBER 12  
 DRAWING NUMBER 12  
 DRAWING NUMBER 12