

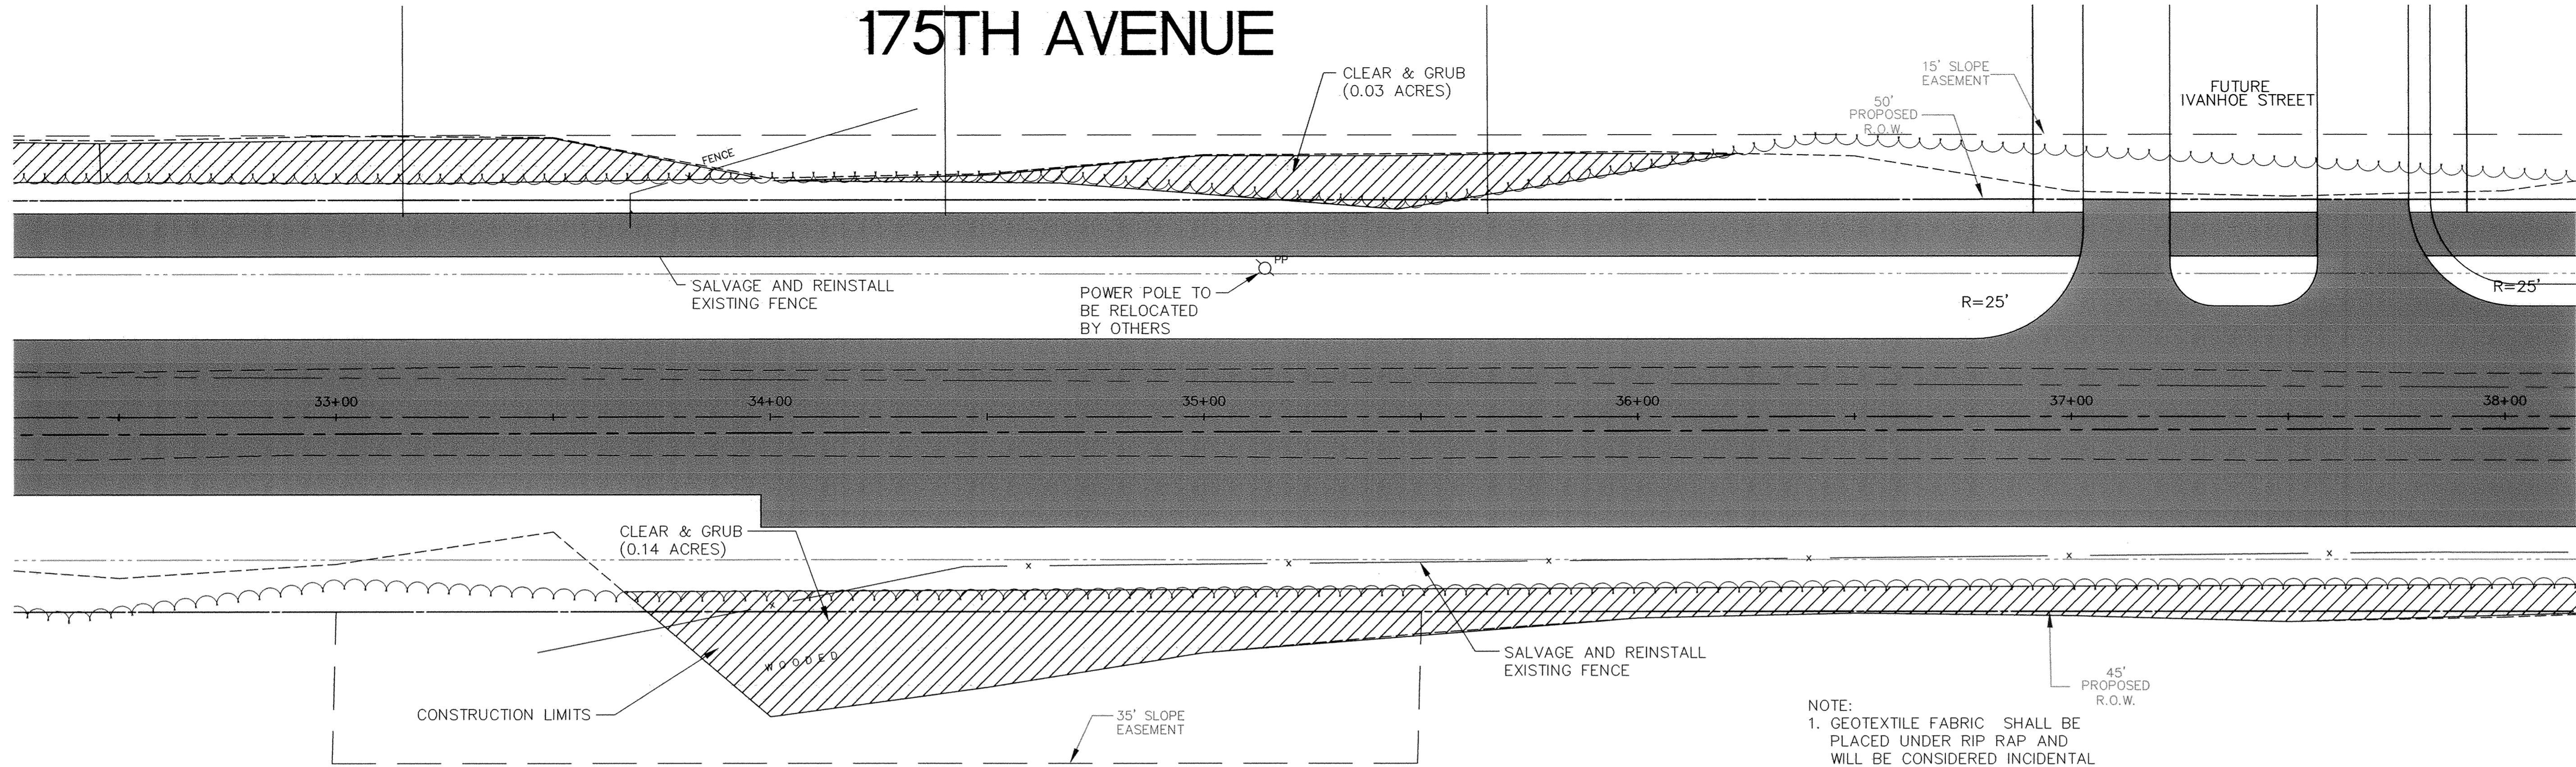


# 175TH AVENUE

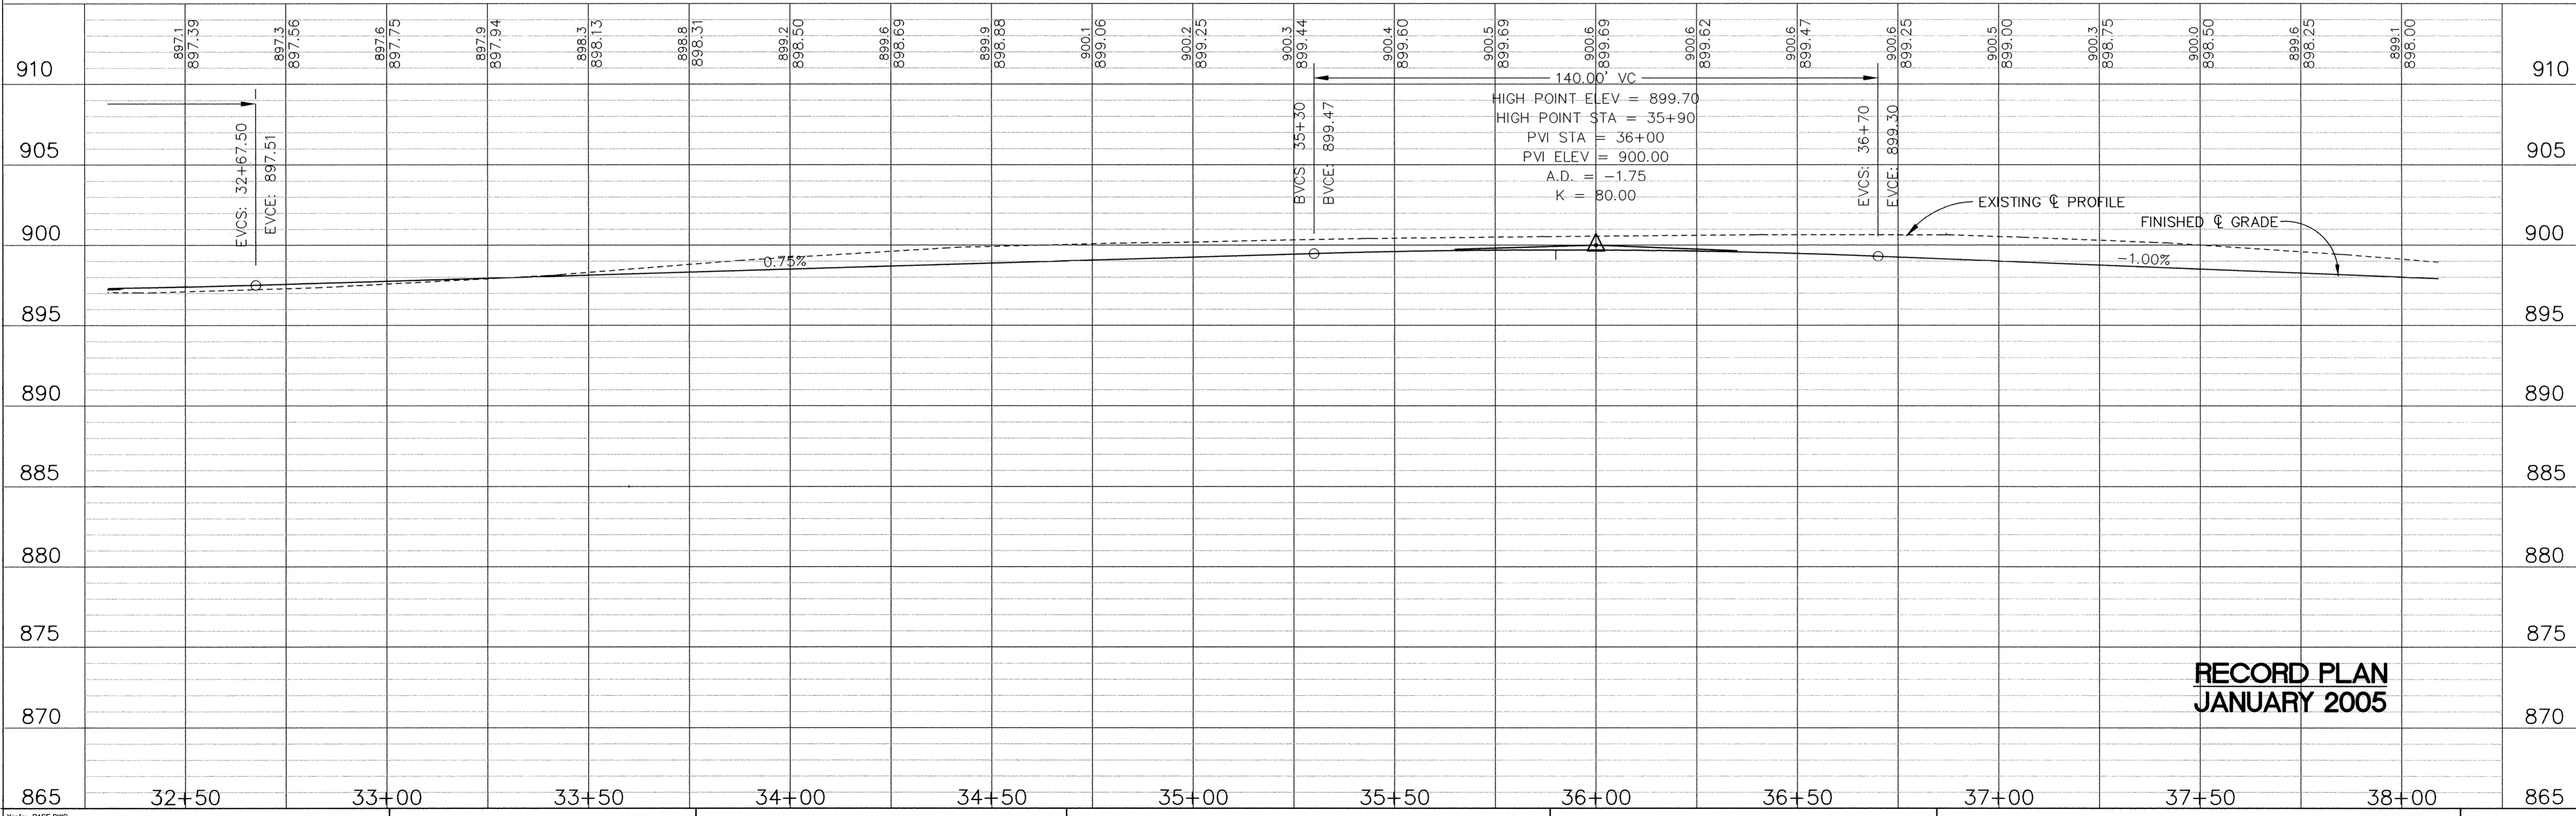

NOTE:  
1. GEOTEXTILE FABRIC SHALL BE PLACED UNDER RIP RAP AND WILL BE CONSIDERED INCIDENTAL TO THE ITEM.

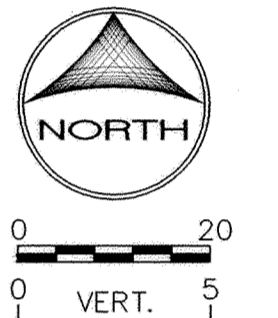

**RECORD PLAN  
JANUARY 2005**

DESIGNED BY: KJT DRAWN BY: RKM  
APPROVED: TJM JOB NUMBER 806550J  
CAD DATE: January 28, 2005 10:54:09 a.m.  
CAD FILE: 806550J\AS-BUILT\07N\_R14.DWG (JCUNNIN)

I HEREBY CERTIFY THAT THIS PLAN, SPECIFICATION, OR REPORT WAS PREPARED BY ME OR UNDER MY DIRECT SUPERVISION AND THAT I AM A DULY LICENSED PROFESSIONAL ENGINEER UNDER THE LAWS OF THE STATE OF MINNESOTA.  
DATE: 2/2/05  
JOHN M. ANDERSON, LIC. 25889

NO.	DATE	BY	REVISION DESCRIPTION
1	7/9/02	EY	CONSTRUCTION LIMITS

1326 ENERGY PARK DRIVE  
ST. PAUL, MINNESOTA 55108  
(651) 644-4389  
**Howard R. Green Company**  
CONSULTING ENGINEERS

**175TH AVENUE**  
CITY OF ELK RIVER  
175TH AVENUE

STREET IMPROVEMENTS  
SP. 204-111-04  
32+50 TO 38+00

SHEET NO.  
**14**

DRAWING NUMBER 175AV/05 14  
SANDO PRODUCTS • NEW HOPE, MINNESOTA  
REGISTERED BY PART NUMBER 8552  
PROFESSIONAL ENGINEER UNDER THE LAWS OF THE STATE OF MINNESOTA