
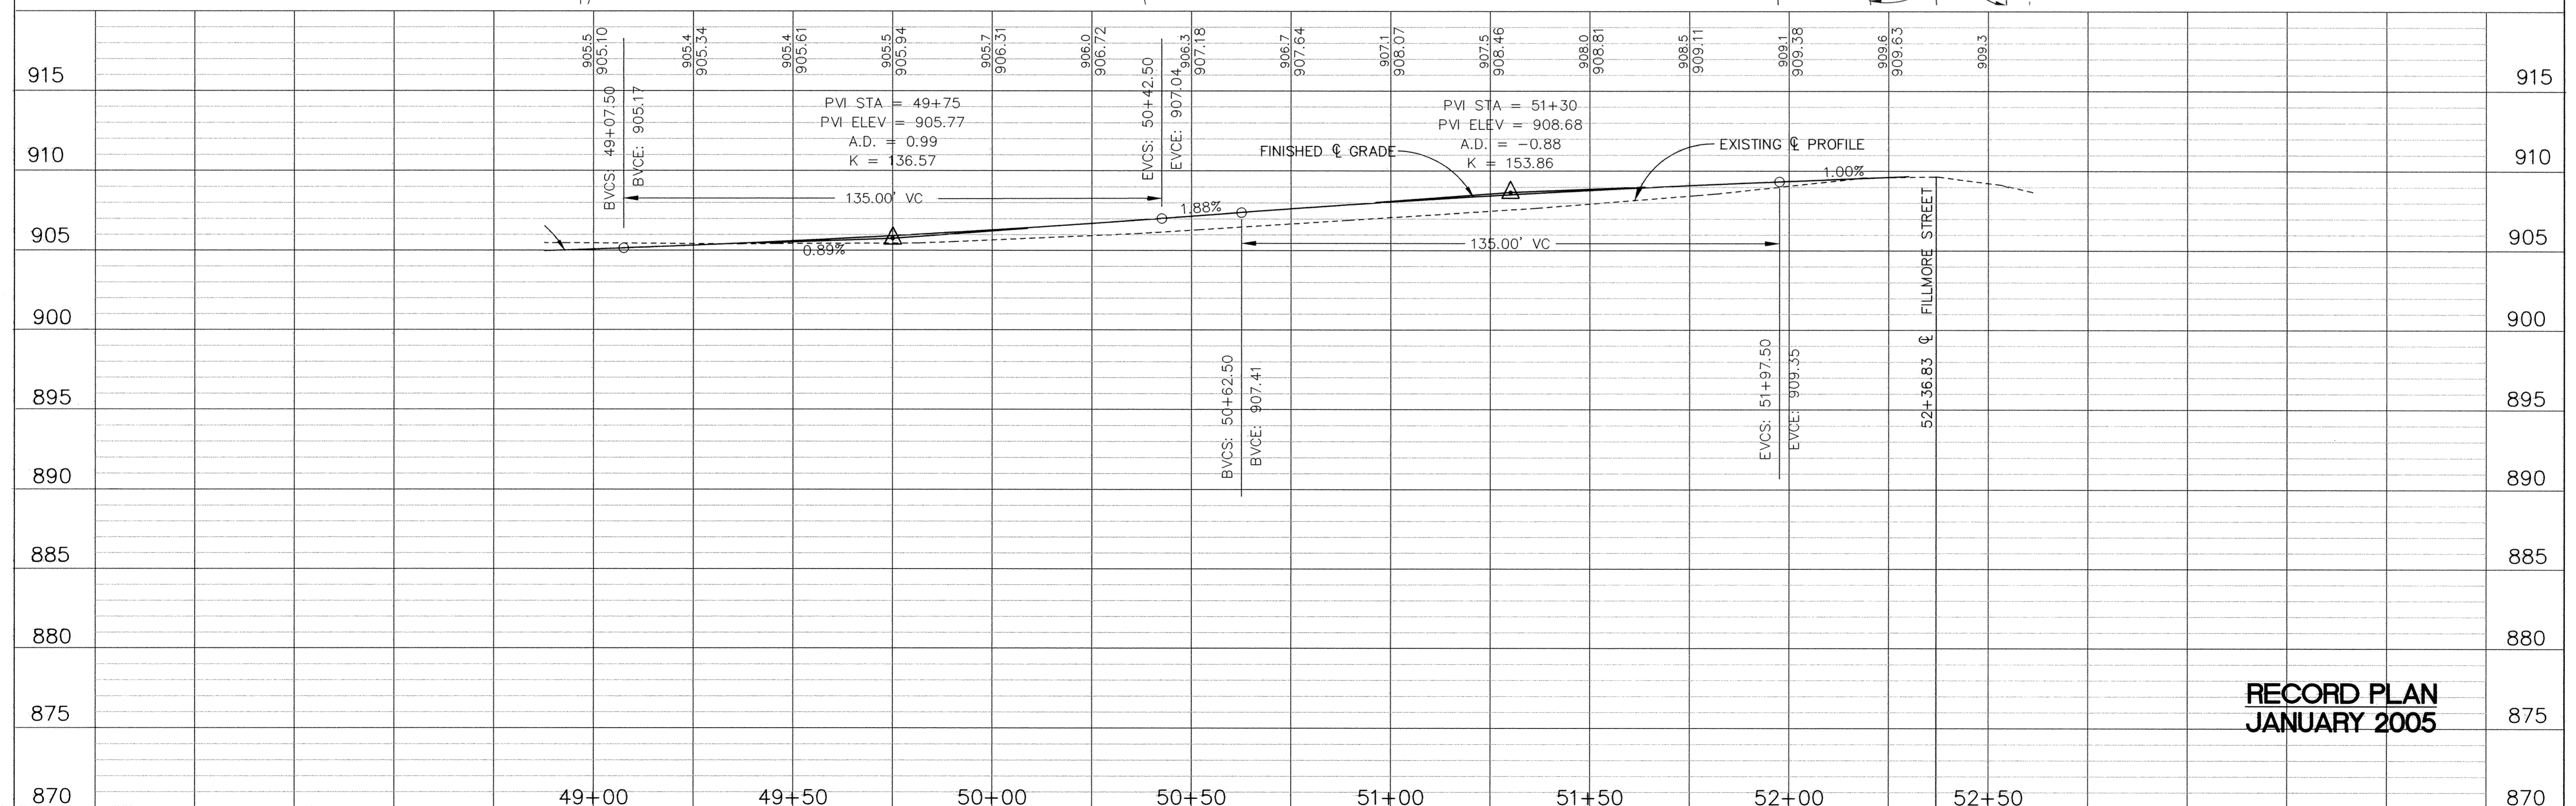
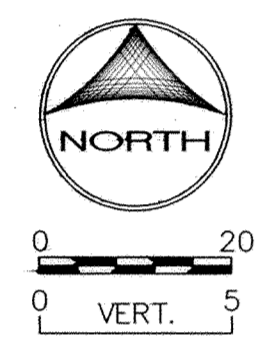


175TH AVENUE

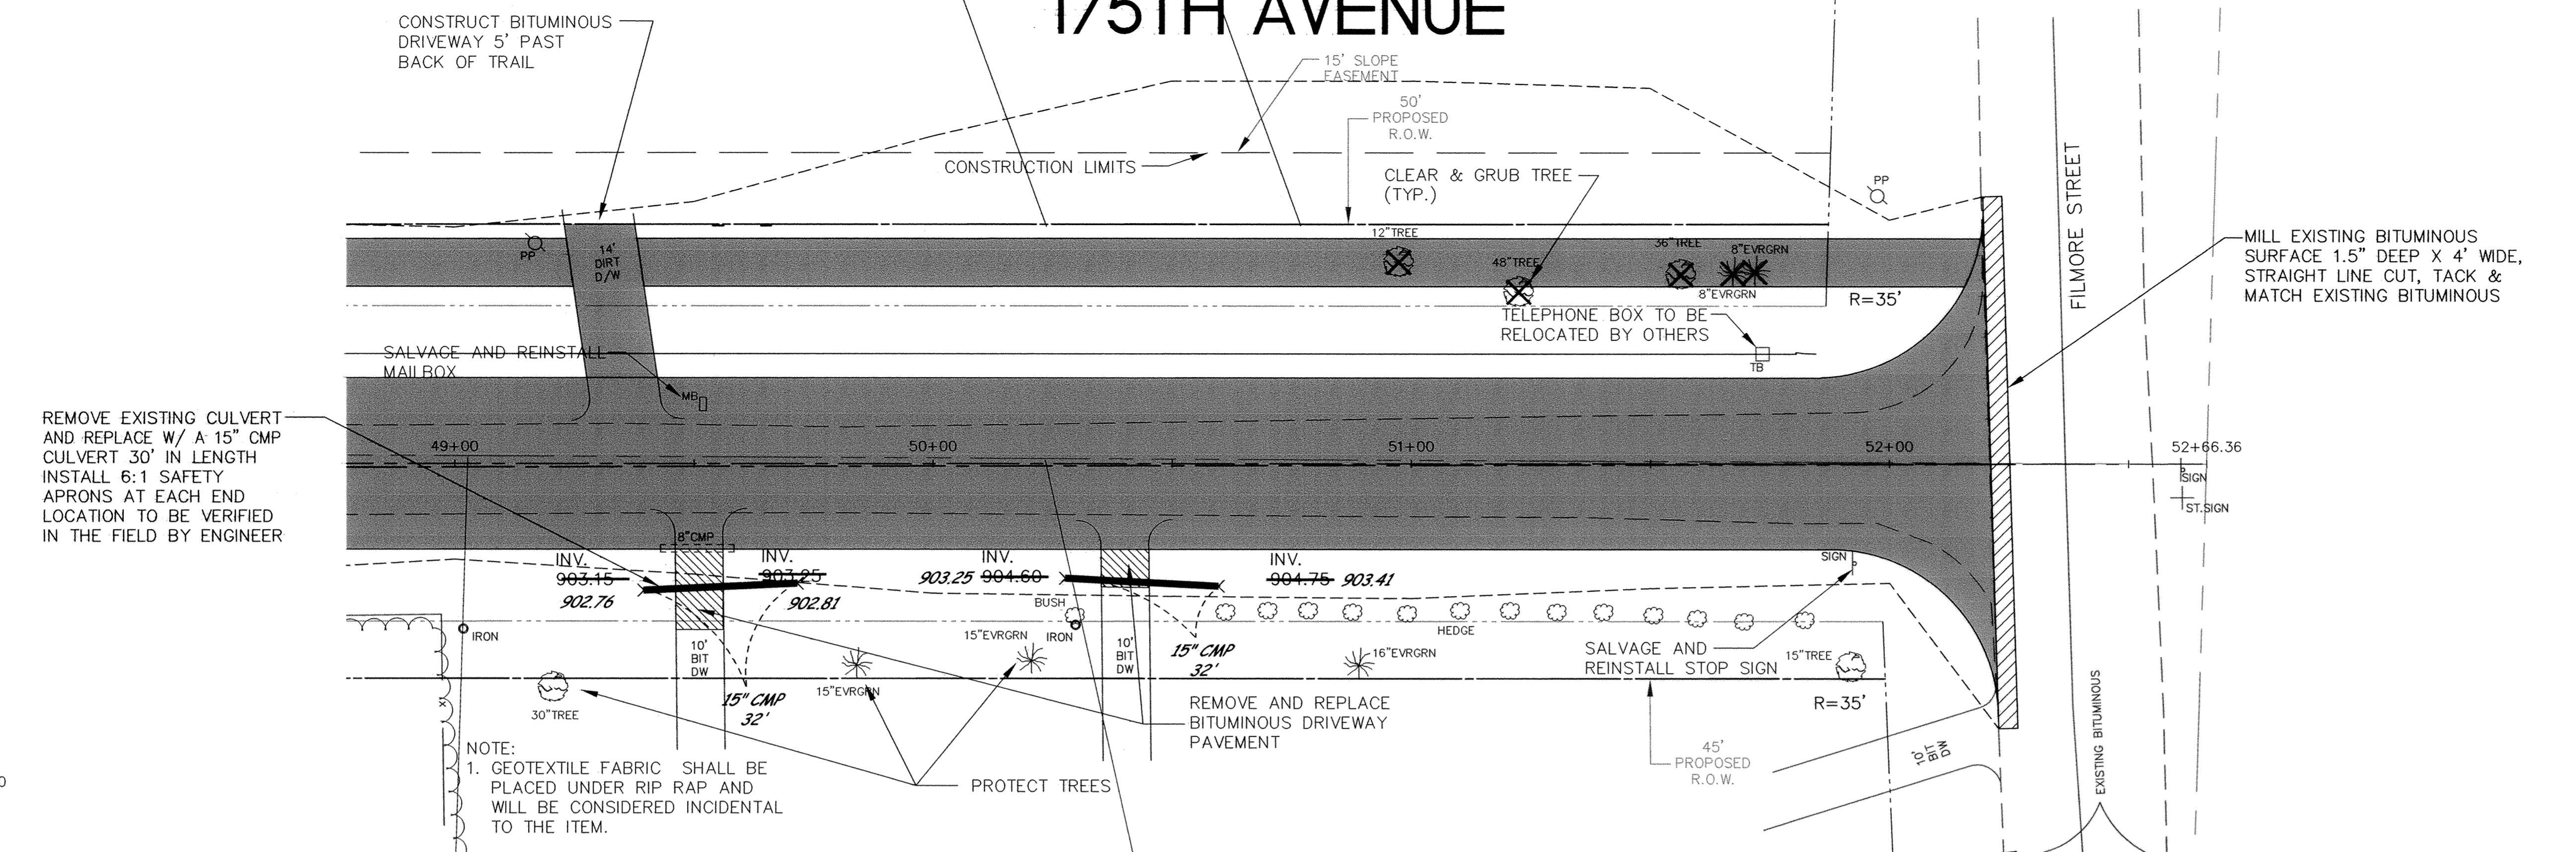

**RECORD PLAN
JANUARY 2005**

DESIGNED BY: KJT DRAWN BY: RKM
 APPROVED: TJM JOB NUMBER 806550J
 CAD DATE: January 28, 2005 11:02:55 a.m.
 CAD FILE: 806550J_AS-BUILT\10N_R14.DWG (JCUNNIN)

I HEREBY CERTIFY THAT THIS PLAN, SPECIFICATION, OR REPORT WAS PREPARED BY ME OR UNDER MY DIRECT SUPERVISION AND THAT I AM A DULY LICENSED PROFESSIONAL ENGINEER UNDER THE LAWS OF THE STATE OF MINNESOTA.
 DATE 2/2/05
 JOHN M. ANDERSON LIC. 25889

NO.	DATE	BY	REVISION DESCRIPTION

1326 ENERGY PARK DRIVE
 ST. PAUL, MINNESOTA 55108
 (651) 644-4389

Howard R. Green Company
 CONSULTING ENGINEERS

175TH AVENUE
 CITY OF ELK RIVER
 175TH AVENUE

S.P. 204-111-04
STREET IMPROVEMENTS
 49+00 TO 52+66.36

SHEET NO.
17