

SAFCD PRODUCTS • NEW HOPE, MINNESOTA  
REORDER BY PART NUMBER 6582

# 185TH AVE.


RT. CURB CURVE DATA  
 $\Delta = 43^{\circ}41'57''$   
R = 297.29' TO FACE  
T = 119.21'  
L = 226.74'

RT. CURB CURVE DATA  
 $\Delta = 32^{\circ}00'51''$   
R = 337.00' TO FACE  
T = 96.68'  
L = 188.30'

LT. CURB CURVE DATA  
 $\Delta = 43^{\circ}41'57''$   
R = 302.71' TO FACE  
T = 121.38'  
L = 230.87'


CL. CURVE DATA  
 $\Delta = 75^{\circ}42'49''$   
R = 300.00'  
T = 233.18'  
L = 396.44'

LT. CURB CURVE DATA  
 $\Delta = 32^{\circ}00'53''$   
R = 263.00' TO FACE  
T = 75.45'  
L = 146.95'

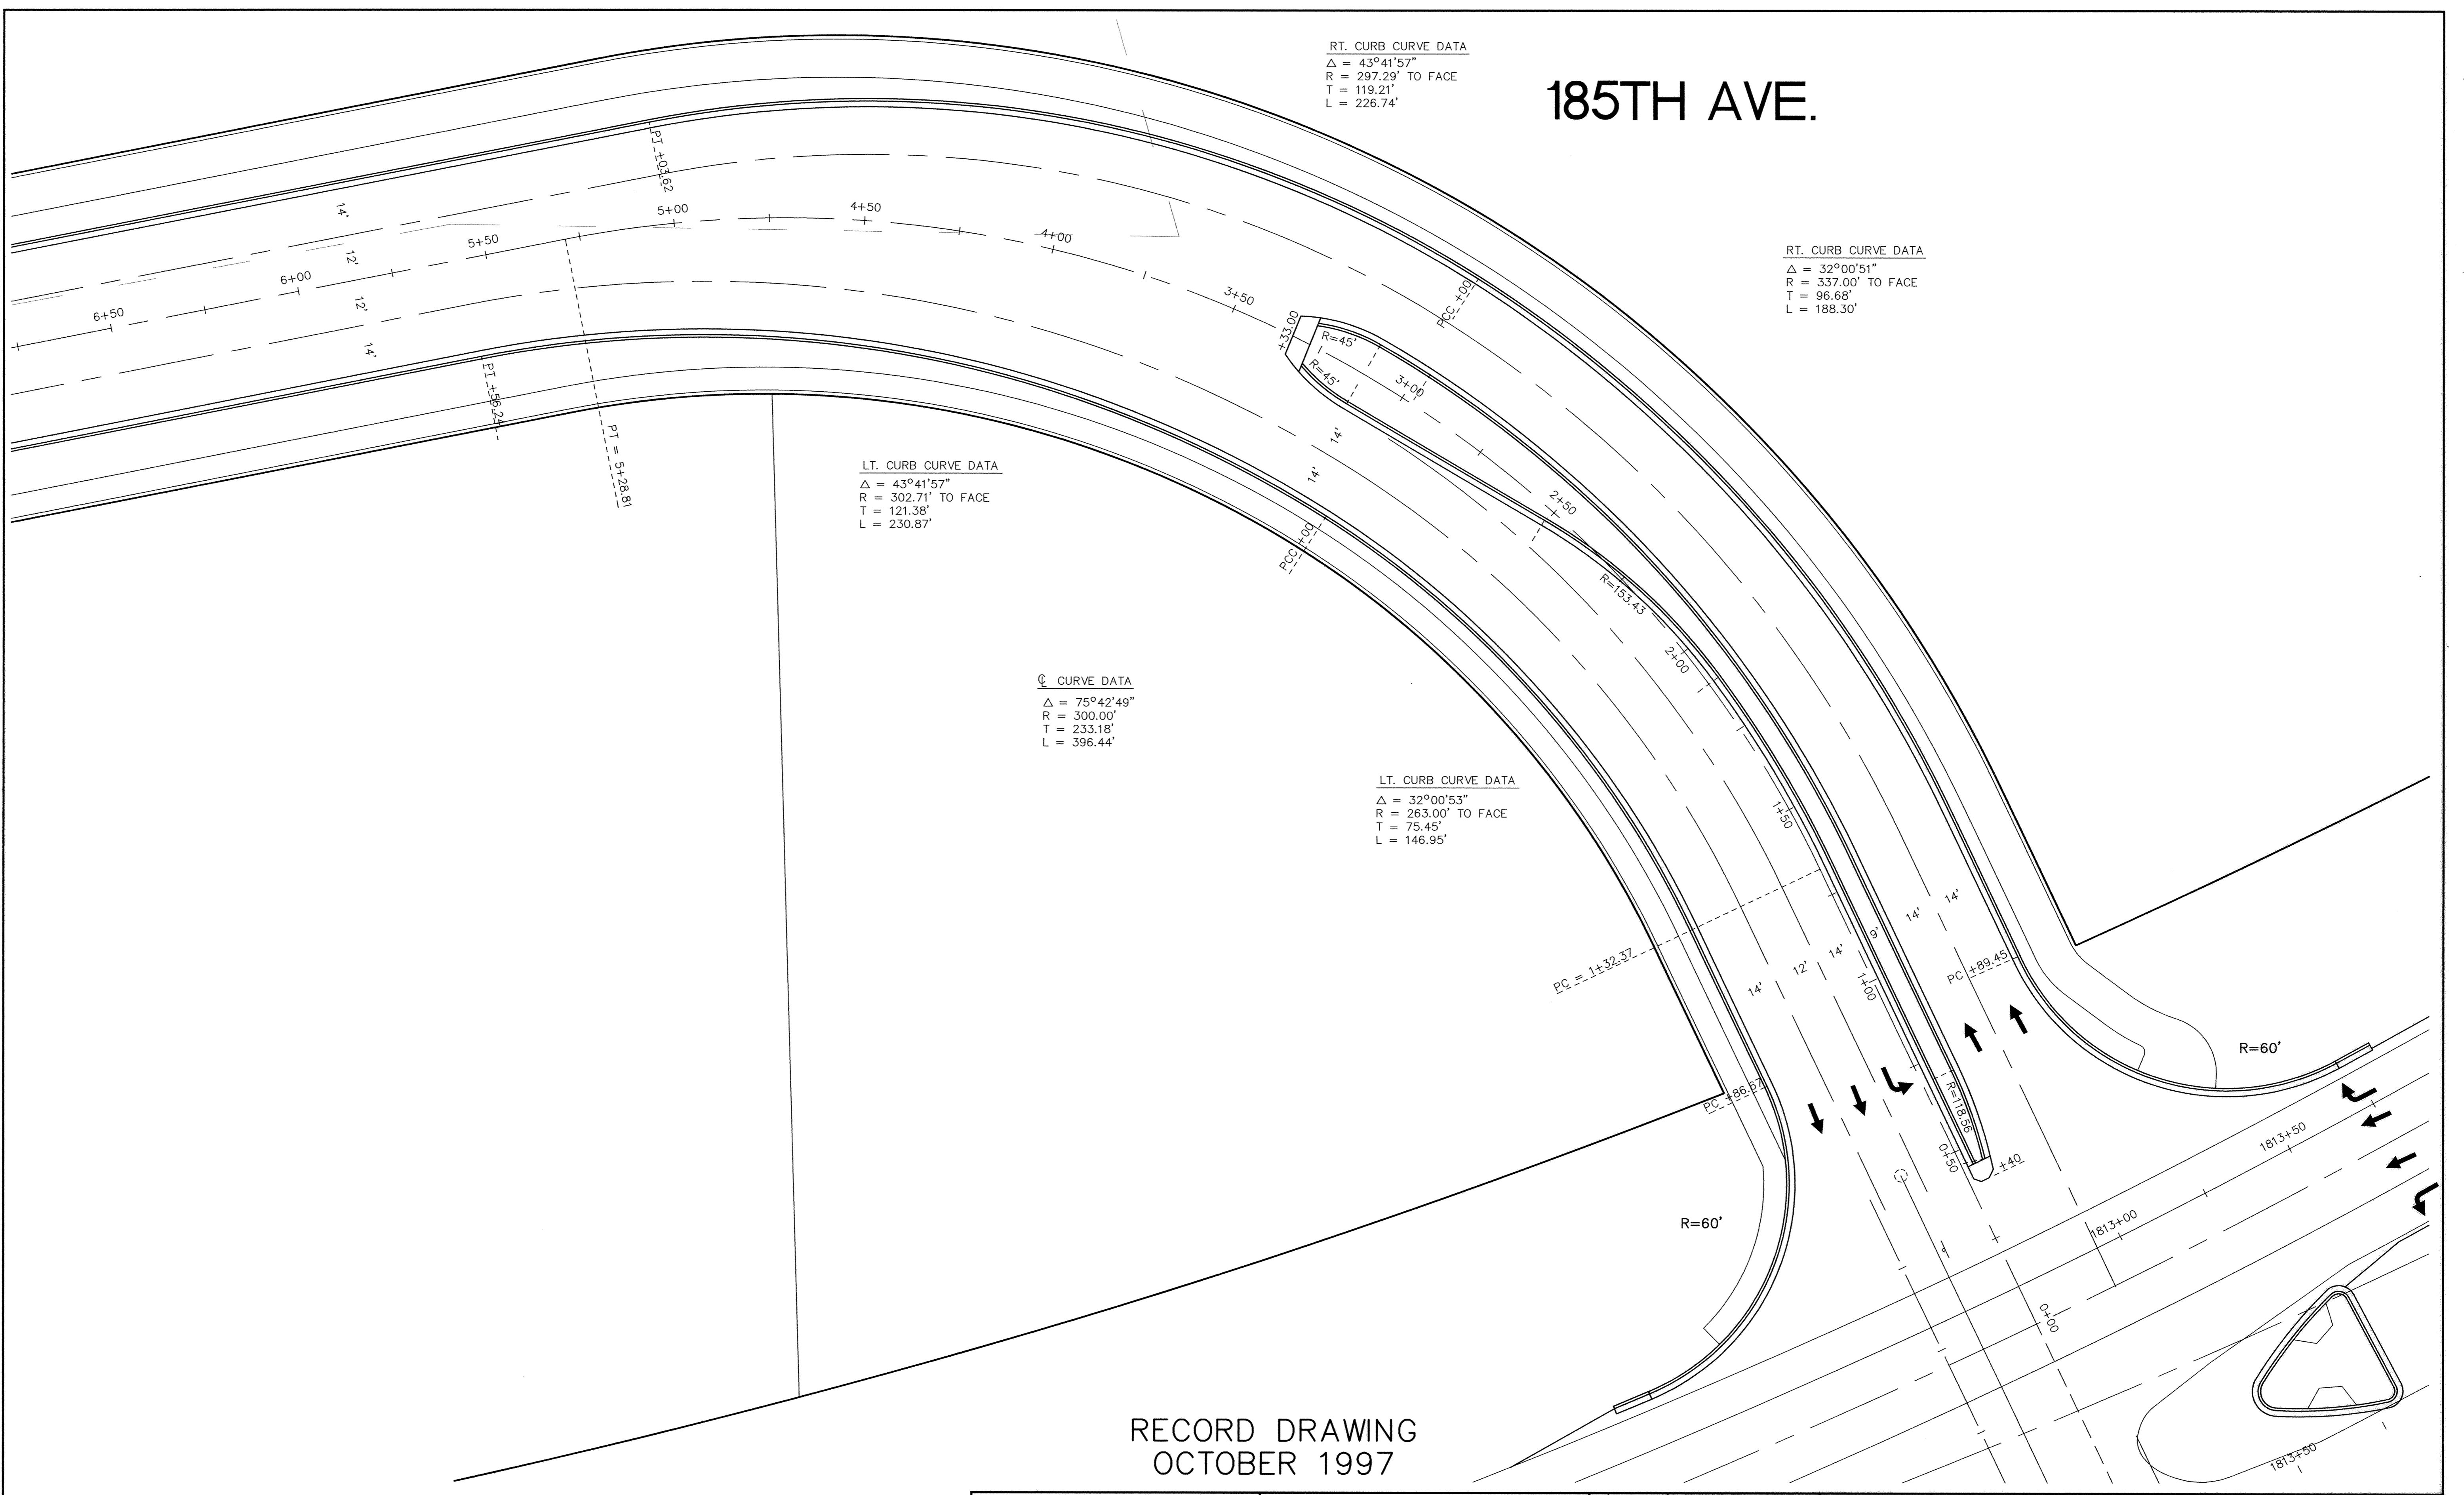

RECORD DRAWING  
OCTOBER 1997

I HEREBY CERTIFY THAT THIS PLAN, SPECIFICATION, OR REPORT WAS PREPARED BY ME OR UNDER MY DIRECT SUPERVISION AND THAT I AM A DULY REGISTERED PROFESSIONAL ENGINEER UNDER THE LAWS OF THE STATE OF MINNESOTA.  
*[Signature]*  
DATE 3/29/96 REG. NO. 15316

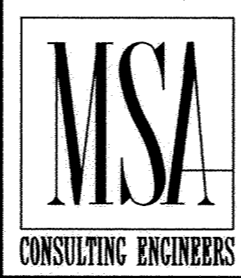

1326 ENERGY PARK DRIVE  
ST. PAUL, MINNESOTA 55108  
(612) 644-4389  
5075 WAYZATA BLVD. SUITE #225  
MINNEAPOLIS, MINNESOTA 55416  
(612) 546-0432

REVISIONS	DATE	DESCRIPTION	DESIGNED	CHECKED	DRAWN

GRAPHIC SCALE  
0 20  
0 VERT. N/A

CITY OF ELK RIVER  
185TH AVENUE / TRUNK HIGHWAY 10  
CURVE DATA PLAN  
S.P. 7102-87(TH 10)  
DATE JAN 1996 SHEET 11 OF 41 SHEETS PROJECT NO. 230-277