
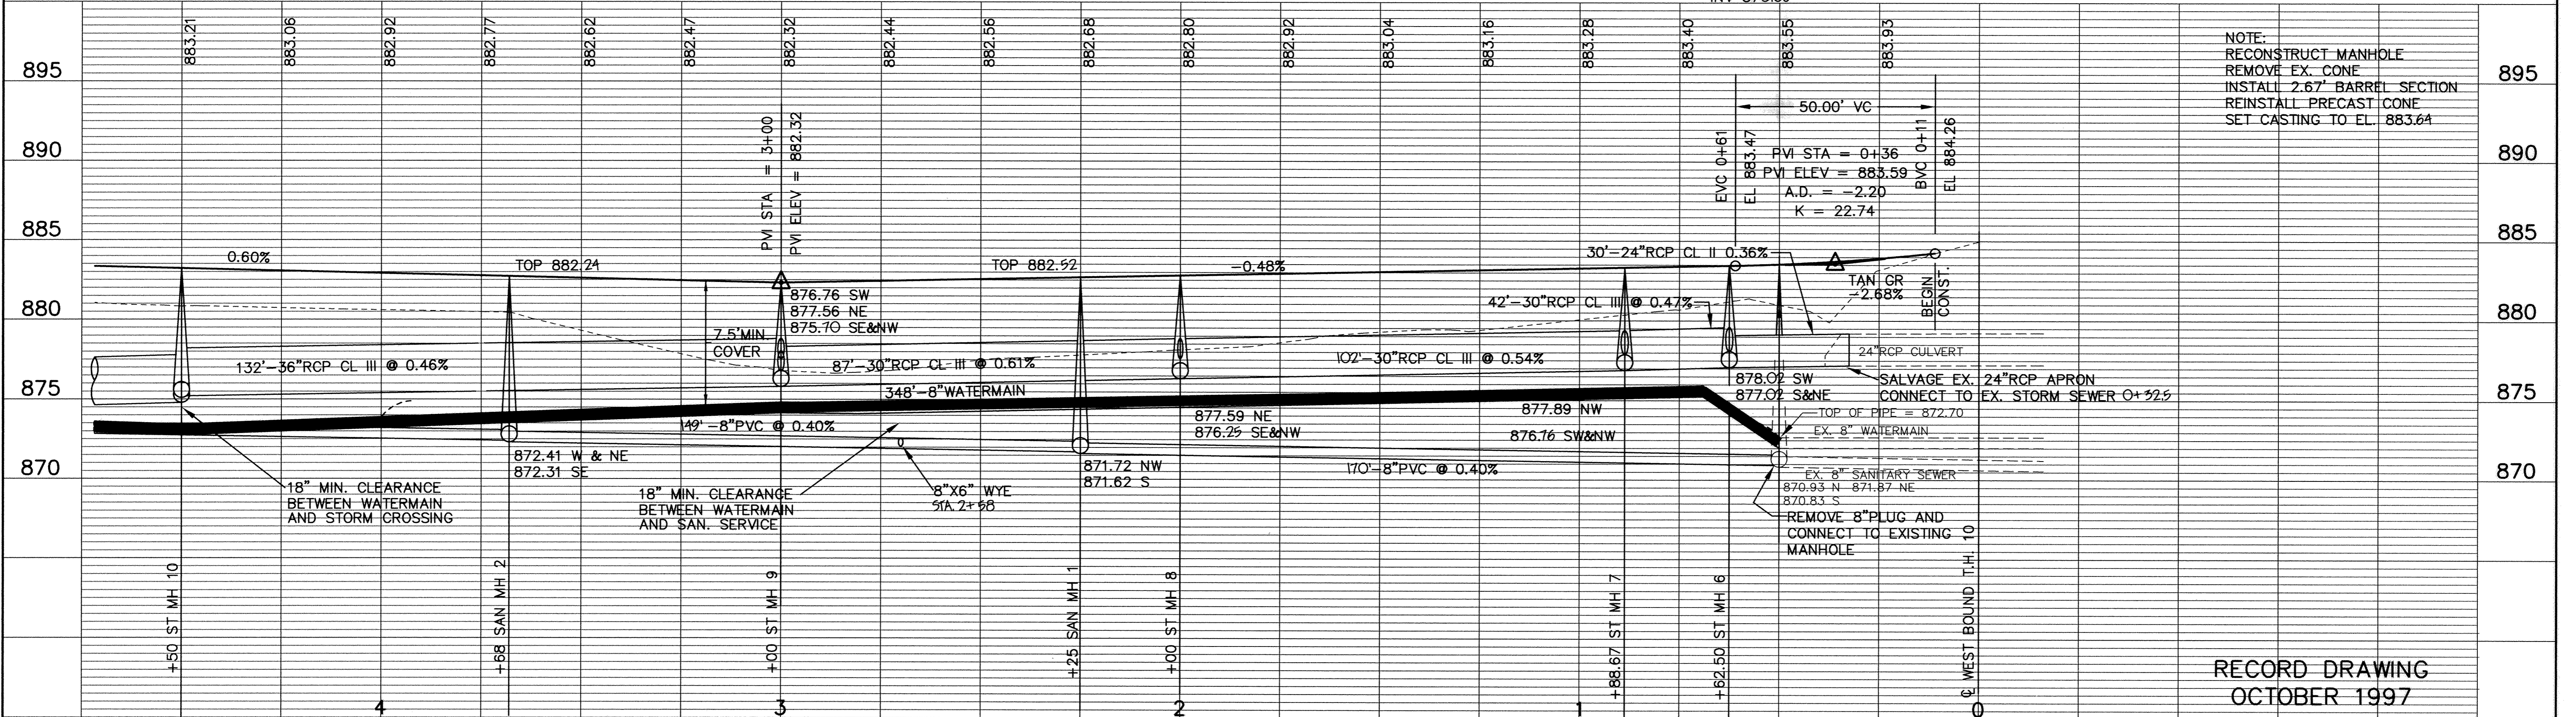


185th AVENUE

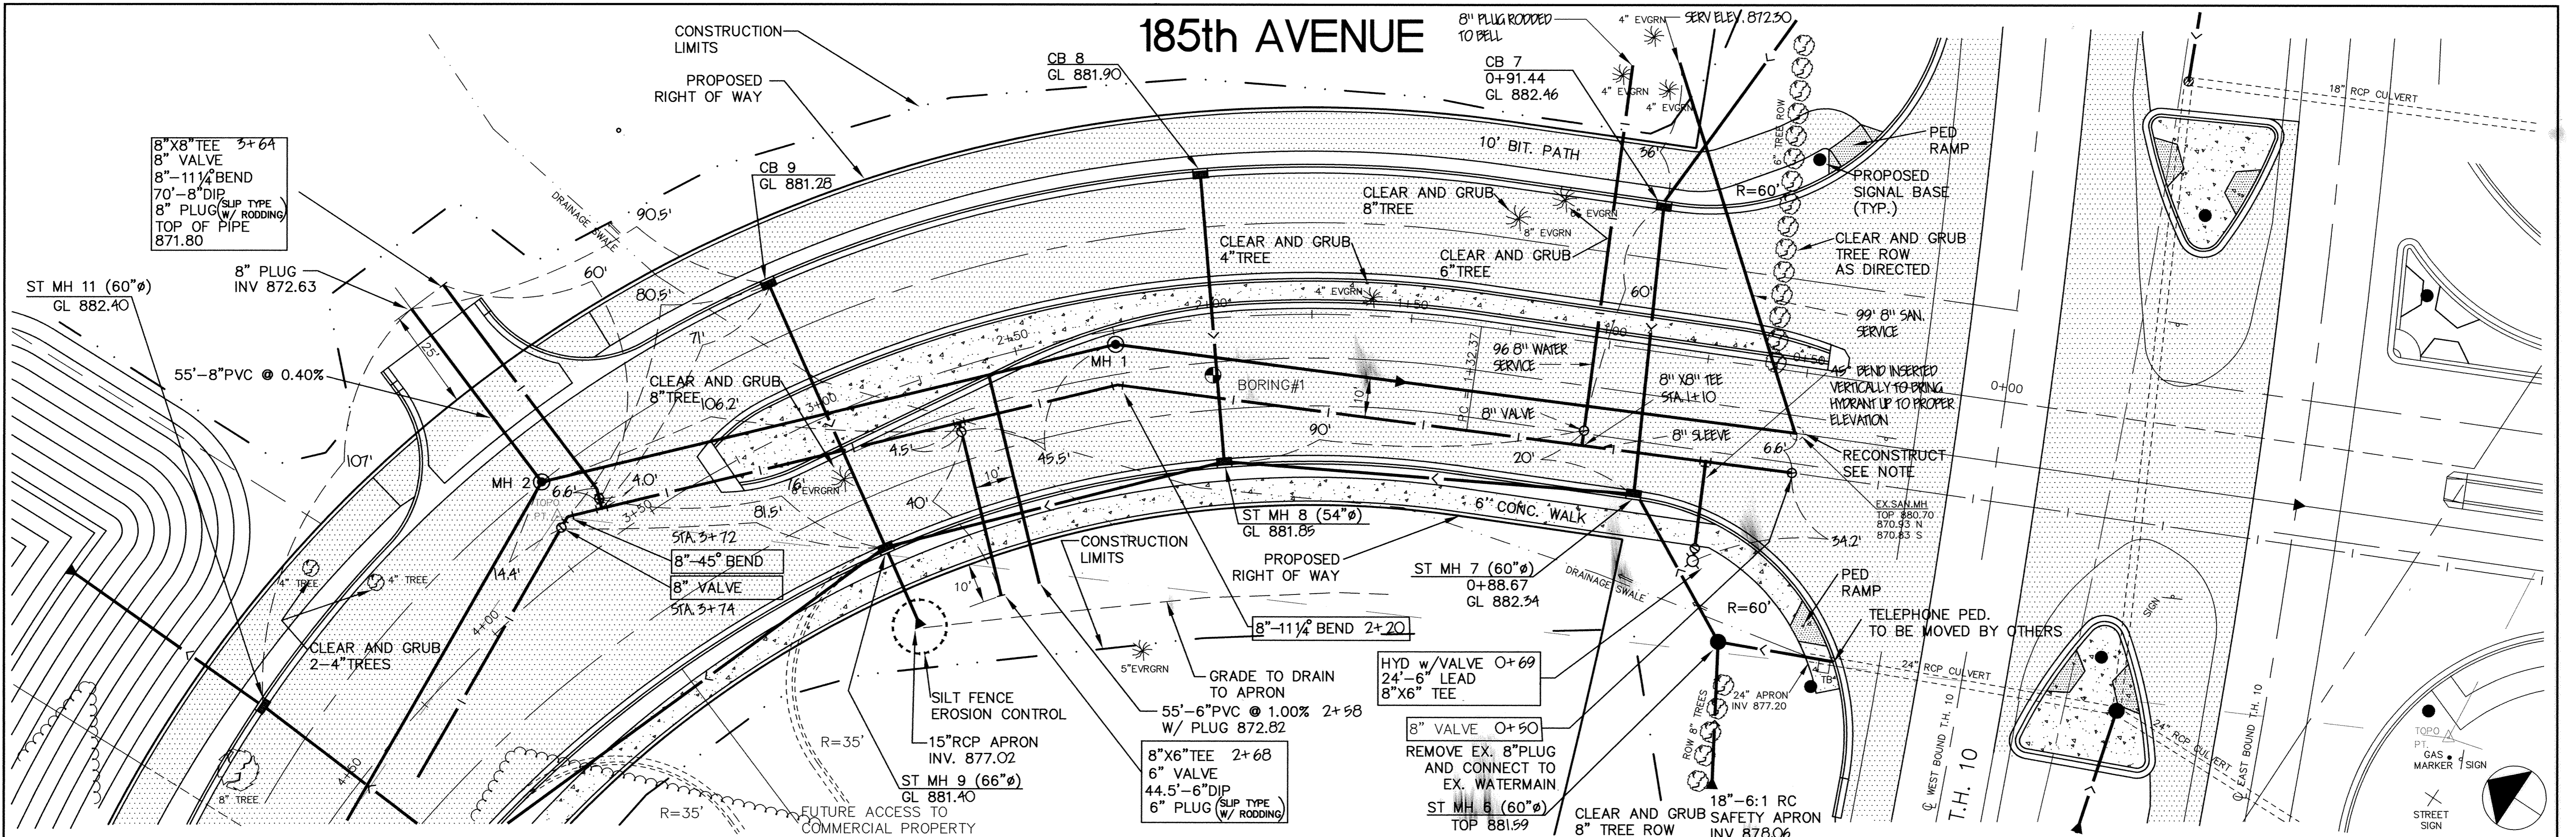

RECORD DRAWING
OCTOBER 1997

<p>1. I HEREBY CERTIFY THAT THIS PLAN, SPECIFICATION, OR REPORT WAS PREPARED BY ME OR UNDER MY DIRECT SUPERVISION AND THAT I AM A DULY REGISTERED PROFESSIONAL ENGINEER UNDER THE LAWS OF THE STATE OF MINNESOTA.</p> <p style="text-align: center;"><i>Sam Mauer</i> DATE <u>3/28/96</u> REG. NO. <u>15316</u></p>	<p>MSA CONSULTING ENGINEERS</p>	<p>1326 ENERGY PARK DRIVE ST. PAUL, MINNESOTA 55108 (612) 644-4389</p> <p>5075 WAYZATA BLVD. SUITE #225 MINNEAPOLIS, MINNESOTA 55416 (612) 546-0432</p>	<p>DATE _____</p> <p>REVISIONS _____</p>	<p>DESIGNED _____</p> <p>CHECKED _____</p> <p>DRAWN _____</p>	<p>CITY OF ELK RIVER 185th AVENUE STREET CONSTRUCTION T.H. 10 TO NAPLES ST.</p> <p>S.P. 7102-87(T.H. 10) 0+00 TO 4+00</p> <p>DATE <u>JAN 1996</u> SHEET <u>13</u> OF <u>41</u> SHEETS PROJECT NO. <u>230-277</u></p>
---	--	---	--	---	---