
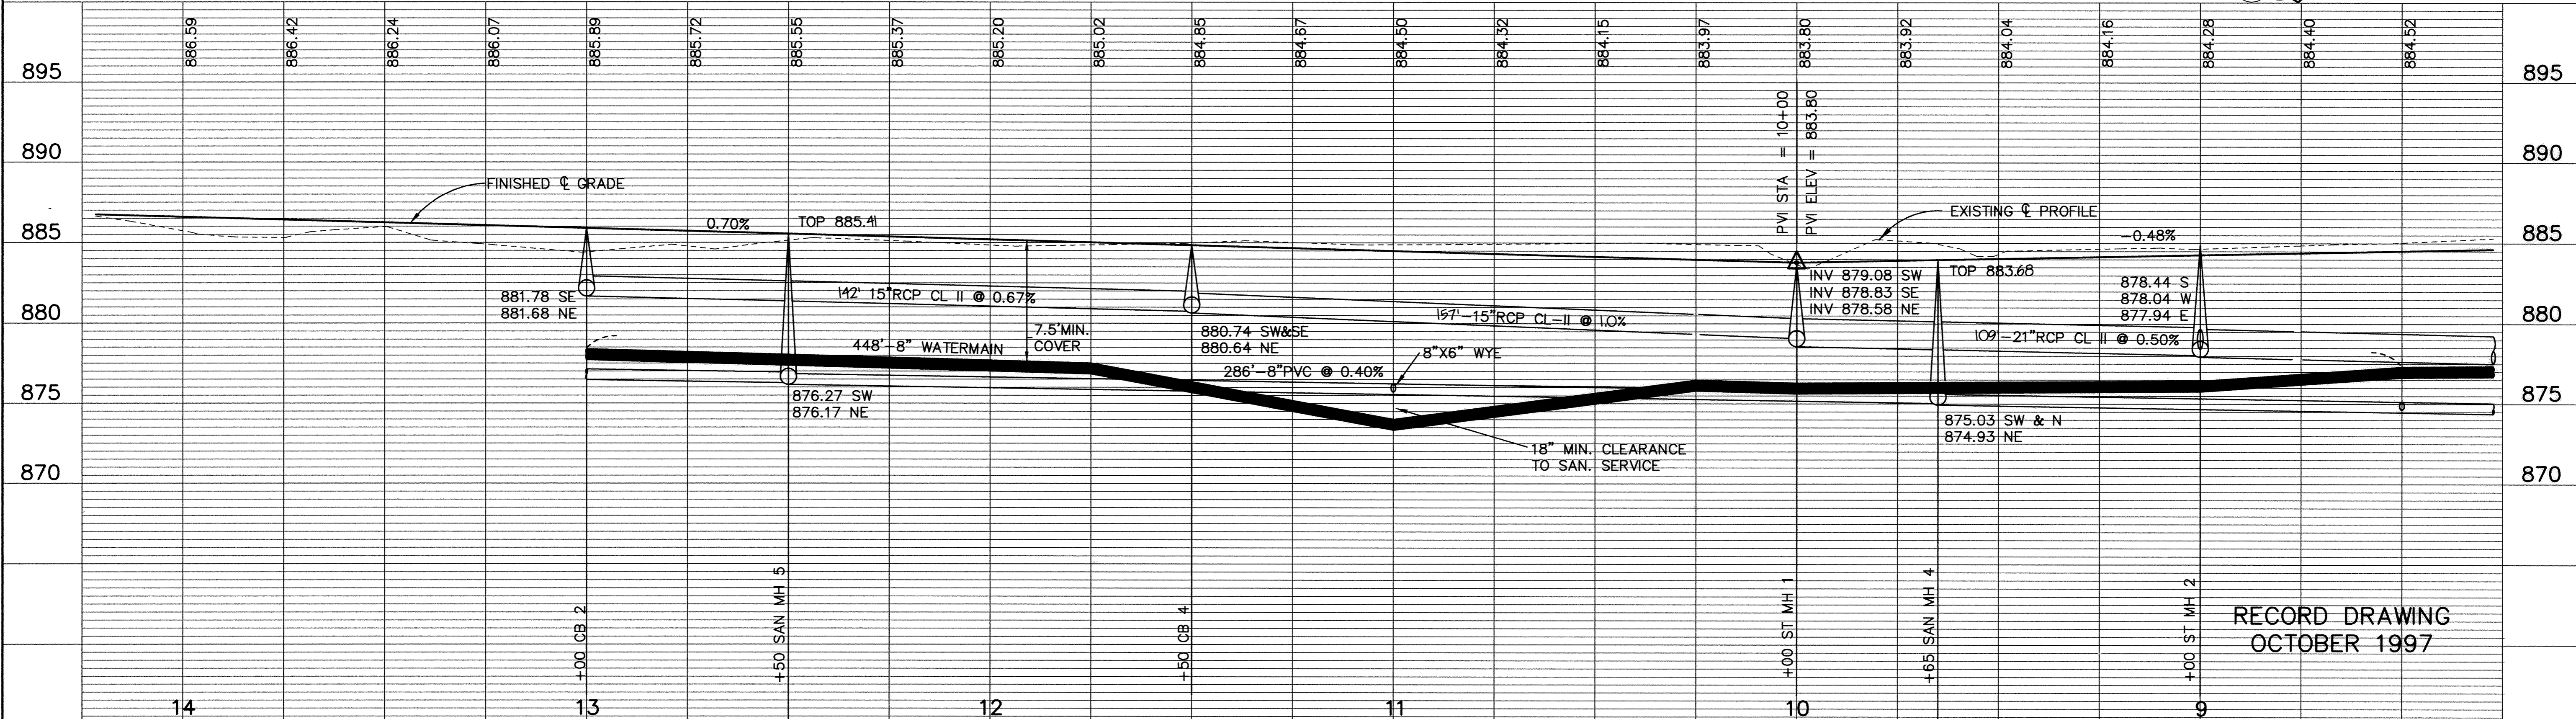


185TH AVENUE

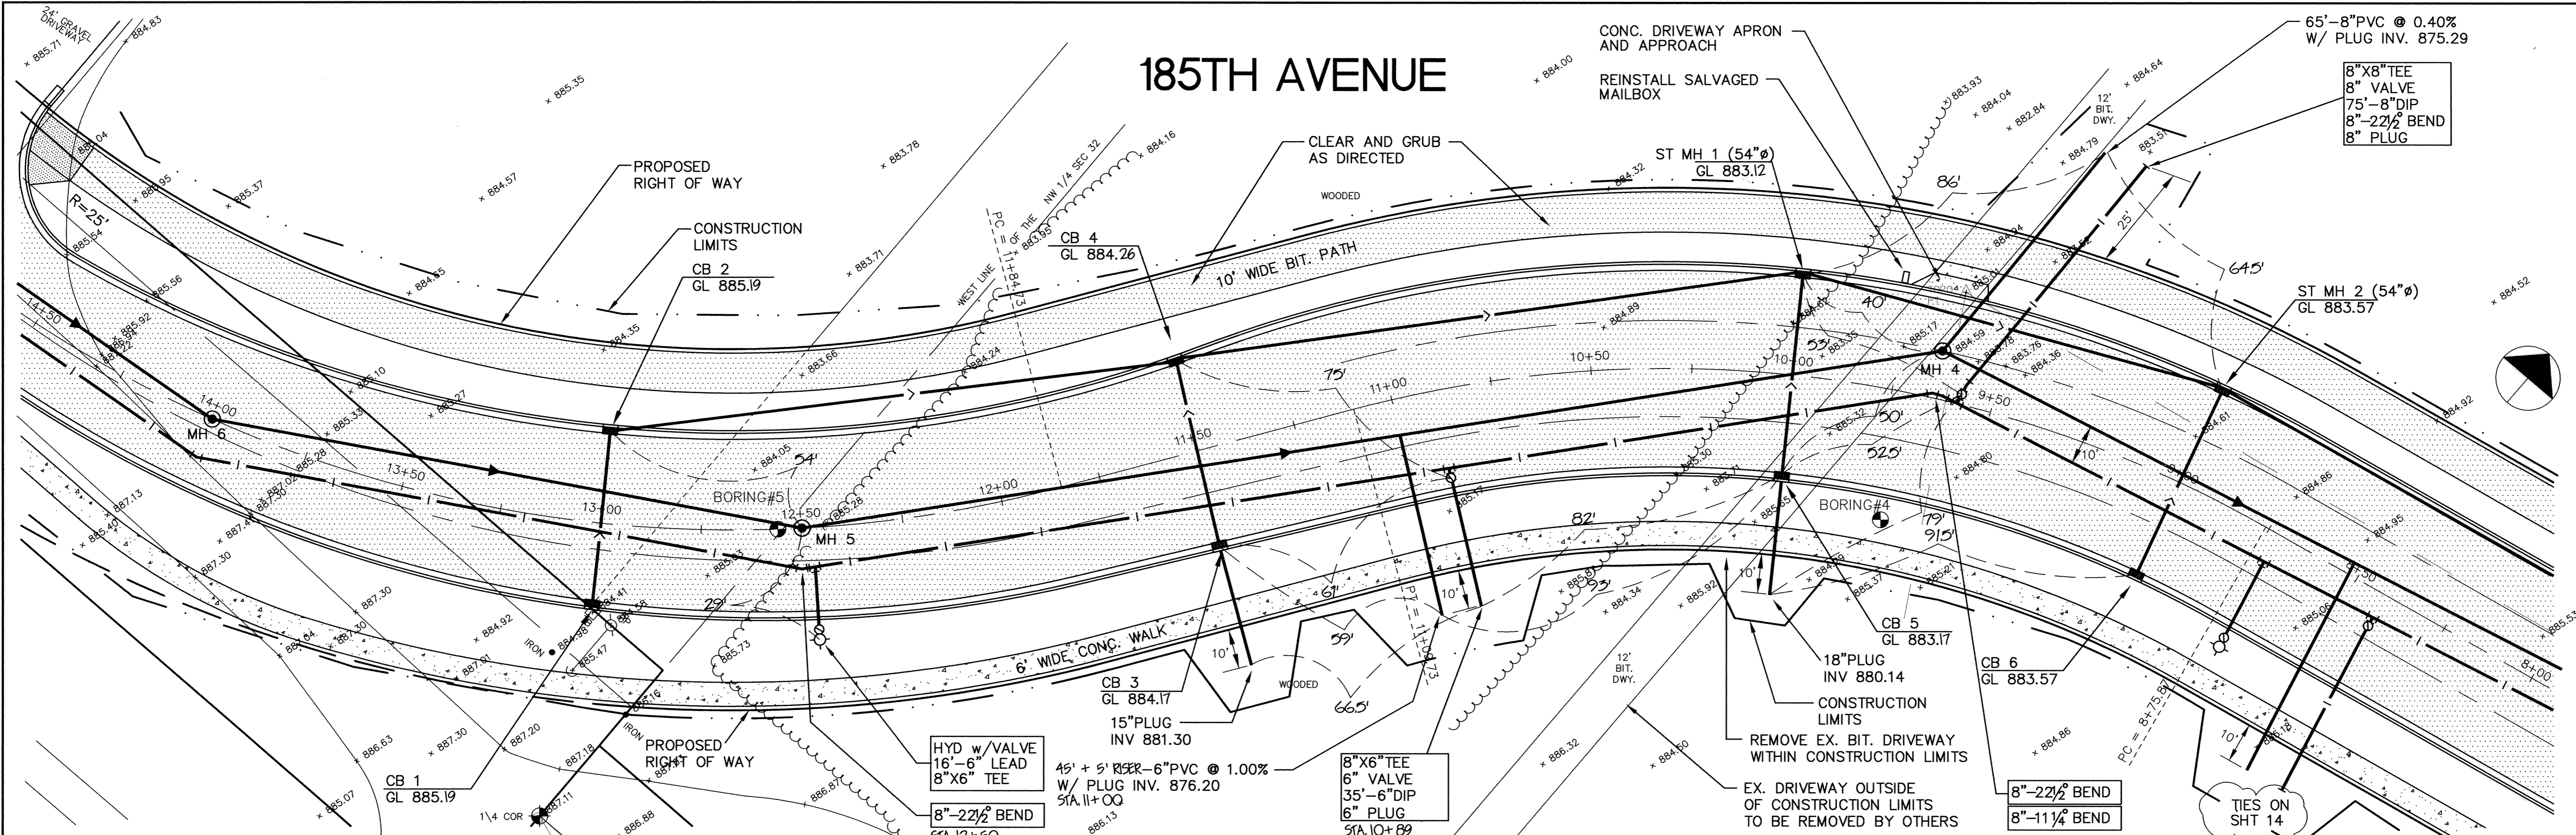

<p>ER277-3</p>		<p>I HEREBY CERTIFY THAT THIS PLAN, SPECIFICATION, OR REPORT WAS PREPARED BY ME OR UNDER MY DIRECT SUPERVISION AND THAT I AM A DULY REGISTERED PROFESSIONAL ENGINEER UNDER THE LAWS OF THE STATE OF MINNESOTA.</p> <p><i>Conroy Mauer</i> DATE 3/29/96 REG. NO. 15316</p>		<p>MSA CONSULTING ENGINEERS</p> <p>1326 ENERGY PARK DRIVE ST. PAUL, MINNESOTA 55108 (612) 644-4389</p> <p>5075 WAYZATA BLVD. SUITE #225 MINNEAPOLIS, MINNESOTA 55416 (612) 546-0432</p>		<table border="1"> <tr> <th>DATE</th> <th>DESCRIPTION</th> </tr> <tr> <td> </td> <td> </td> </tr> <tr> <td> </td> <td> </td> </tr> </table>		DATE	DESCRIPTION					<table border="1"> <tr> <td>DESIGNED</td> <td> </td> </tr> <tr> <td>CHECKED</td> <td> </td> </tr> <tr> <td>DRAWN</td> <td> </td> </tr> <tr> <td>GRAPHIC SCALE</td> <td> </td> </tr> <tr> <td>0</td> <td>20</td> </tr> <tr> <td>0</td> <td>5</td> </tr> <tr> <td>VERT.</td> <td> </td> </tr> </table>		DESIGNED		CHECKED		DRAWN		GRAPHIC SCALE		0	20	0	5	VERT.		<p>RECORD DRAWING OCTOBER 1997</p> <p>CITY OF ELK RIVER 185TH AVENUE STREET CONSTRUCTION T.H. 10 TO NAPLES ST.</p> <p>S.P. 7102-87 (TH 10) 9+00 TO 14+00</p> <p>DATE JAN 1996 SHEET 15 OF 41 SHEETS PROJECT NO. 230-277</p>	
DATE	DESCRIPTION																														
DESIGNED																															
CHECKED																															
DRAWN																															
GRAPHIC SCALE																															
0	20																														
0	5																														
VERT.																															

DRAWING NUMBER 185AV/96
 DRAWING NUMBER 15
 DRAWING NUMBER 1232
 SAFCO PRODUCTS • NEW HOPE, MINNESOTA
 REORDER BY PART NUMBER 6522
 MINNESOTA STATE BOARD OF PROFESSIONAL ENGINEERS
 MINNESOTA STATE BOARD OF PROFESSIONAL ENGINEERS
 MINNESOTA STATE BOARD OF PROFESSIONAL ENGINEERS