


SAICO PRODUCTS • NEW HOPE, MINNESOTA
FURNISHED BY PART NUMBER 8582

SAICO PRODUCTS • NEW HOPE, MINNESOTA
FURNISHED BY PART NUMBER 8582

SAICO PRODUCTS • NEW HOPE, MINNESOTA
FURNISHED BY PART NUMBER 8582


SAICO PRODUCTS • NEW HOPE, MINNESOTA
FURNISHED BY PART NUMBER 8582

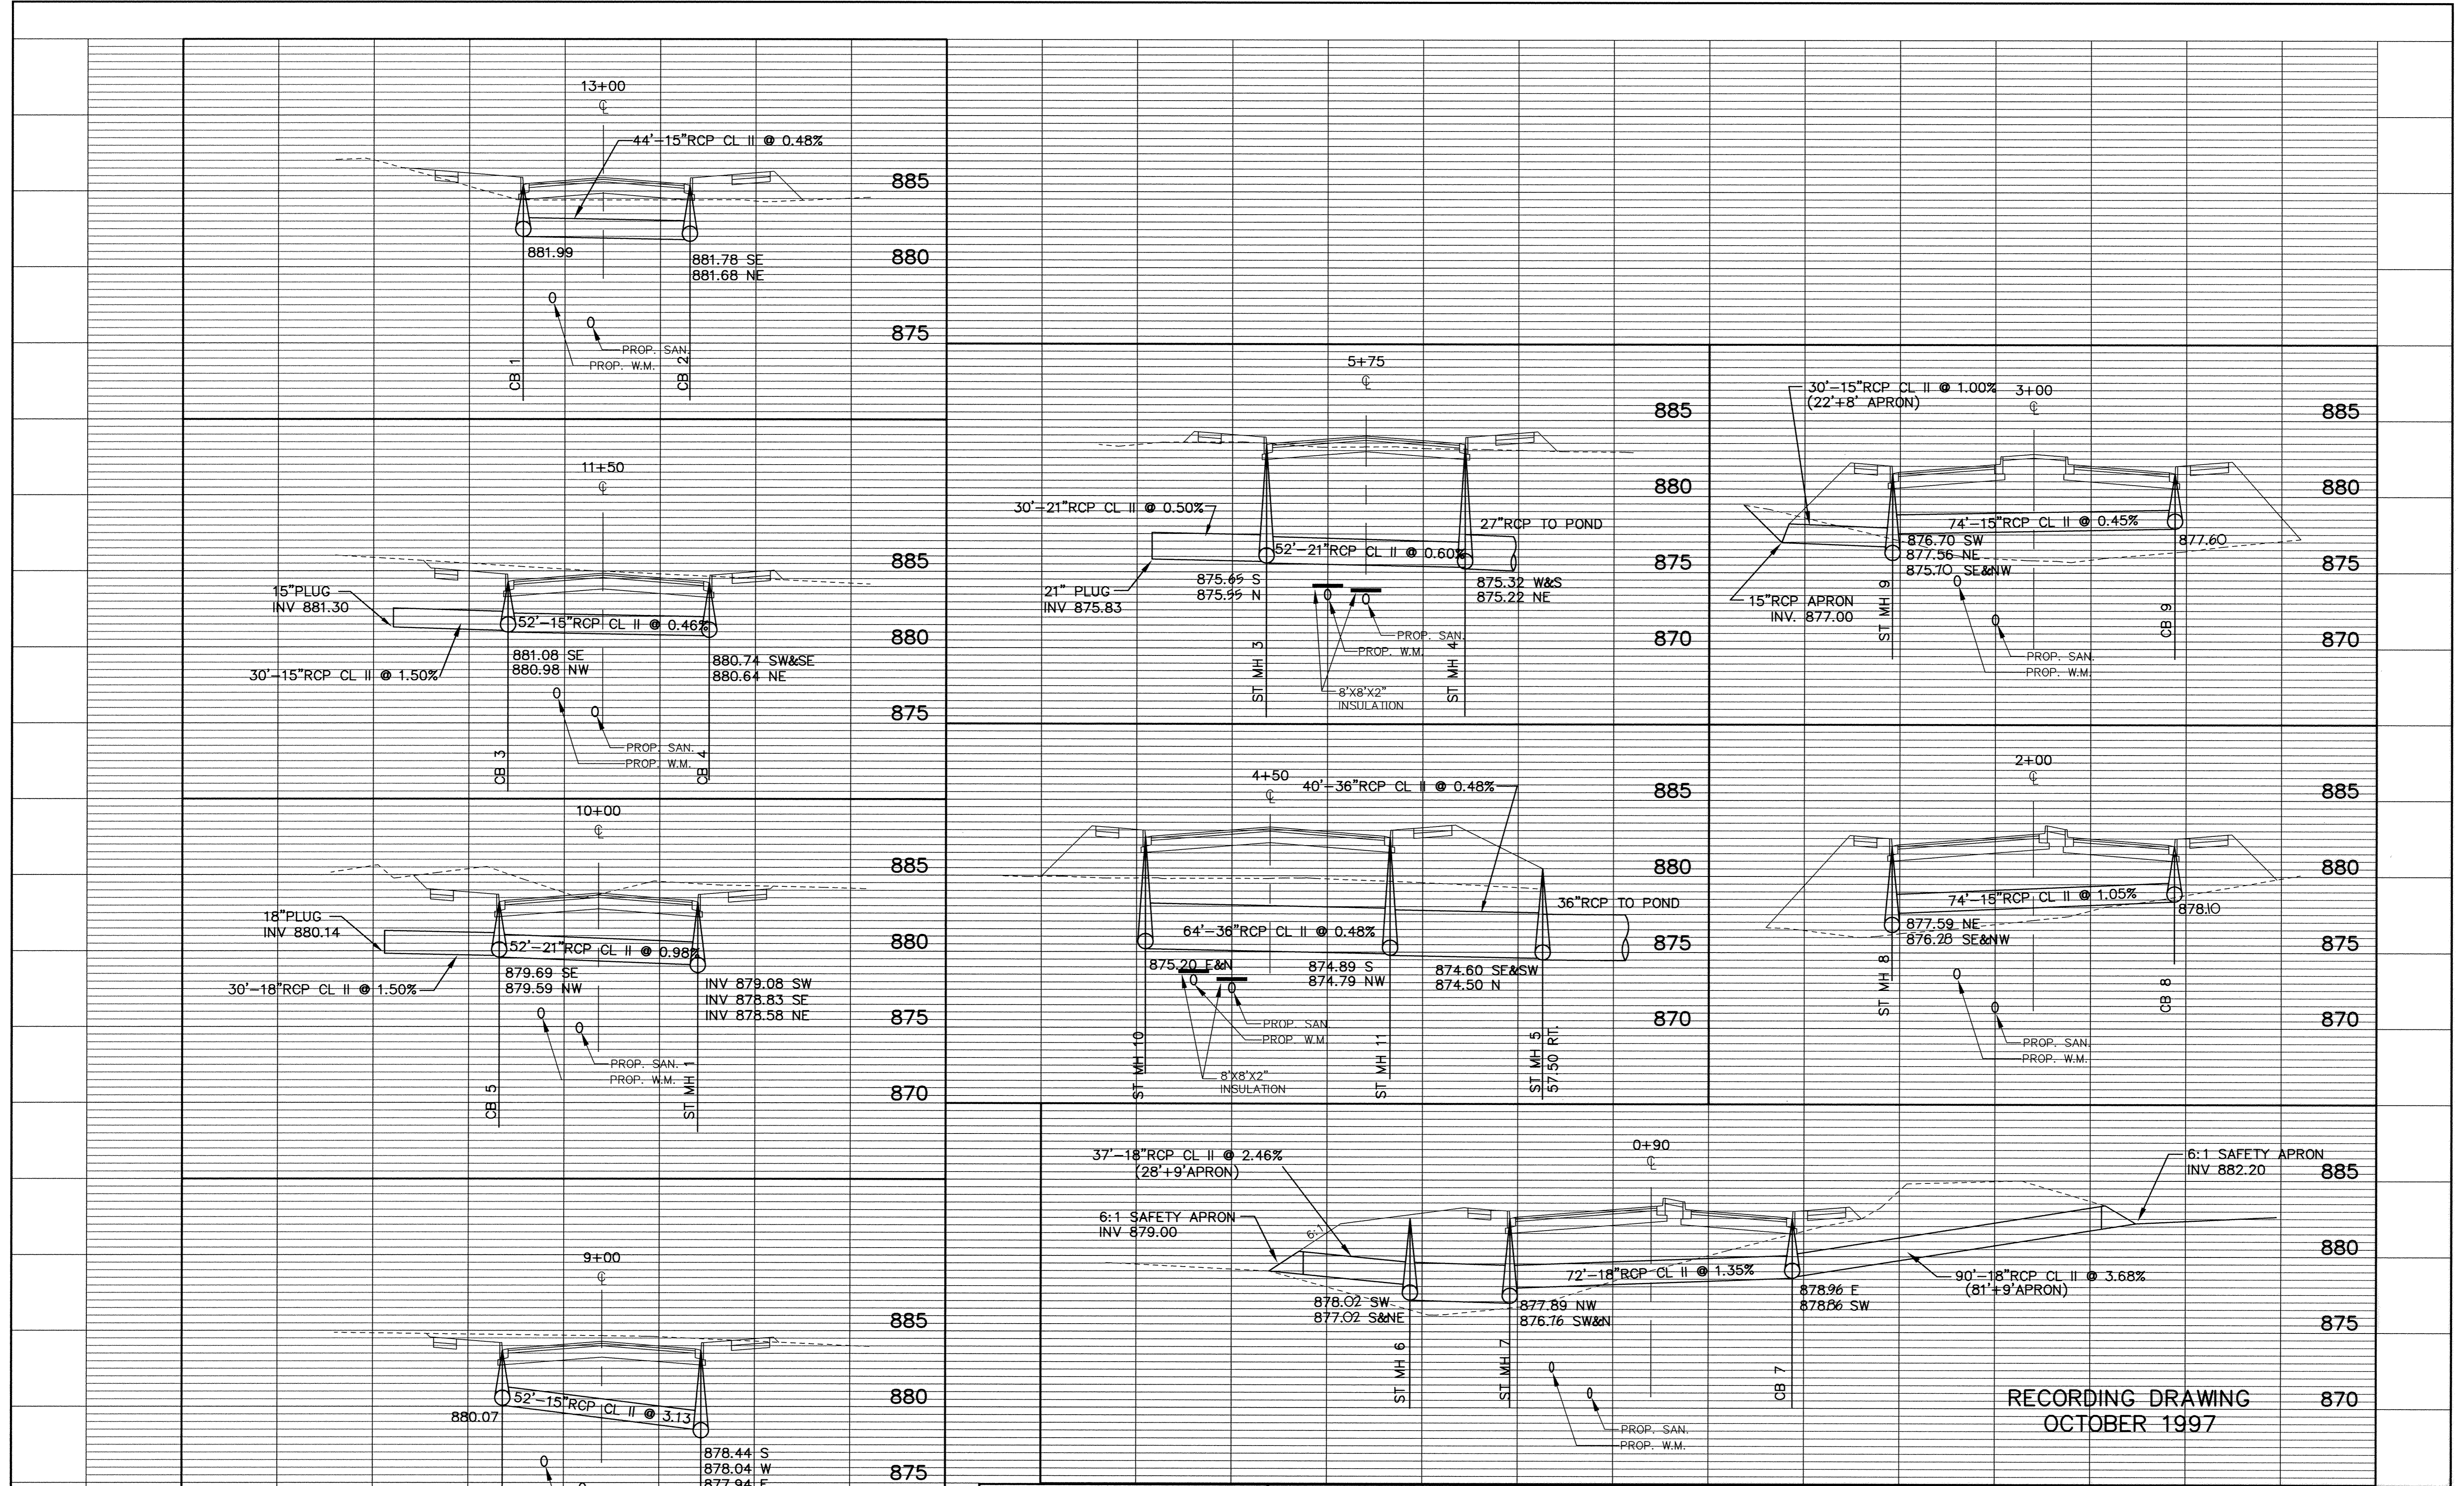

RECORDING DRAWING
OCTOBER 1997

I HEREBY CERTIFY THAT THIS PLAN, SPECIFICATION, OR REPORT WAS PREPARED BY ME OR UNDER MY DIRECT SUPERVISION AND THAT I AM A DULY REGISTERED PROFESSIONAL ENGINEER UNDER THE LAWS OF THE STATE OF MINNESOTA.

Steve Mauer
DATE 3/29/97 REG. NO. 15316

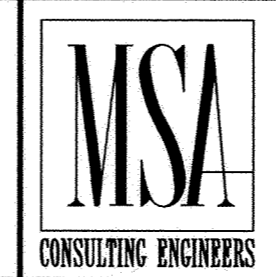

1326 ENERGY PARK DRIVE
ST. PAUL, MINNESOTA 55108
(612) 644-4389

5075 WAYZATA BLVD. SUITE #225
MINNEAPOLIS, MINNESOTA 55416
(612) 546-0432

REVISIONS	DATE	DESCRIPTION

DESIGNED
CHECKED
DRAWN

GRAPHIC SCALE
0 20
0 5
VERT. 5

CITY OF ELK RIVER
185TH AVENUE

STORM SEWER PROFILES
S.P. 7102-87(TH 10)

DATE JAN 1996 SHEET 19 OF 41 SHEETS PROJECT NO. 230-277