




CONCRETE CURB AND GUTTER S518

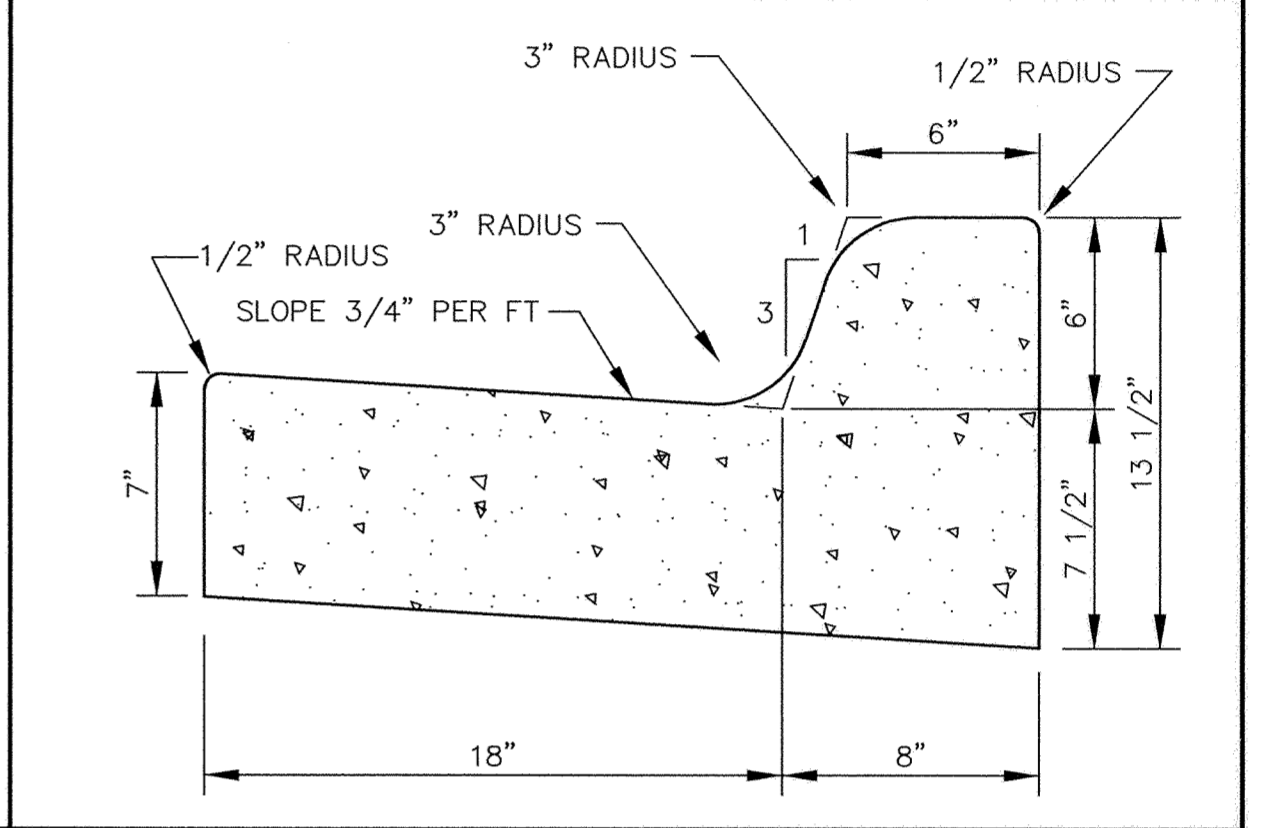


CONCRETE CURB AND GUTTER B618

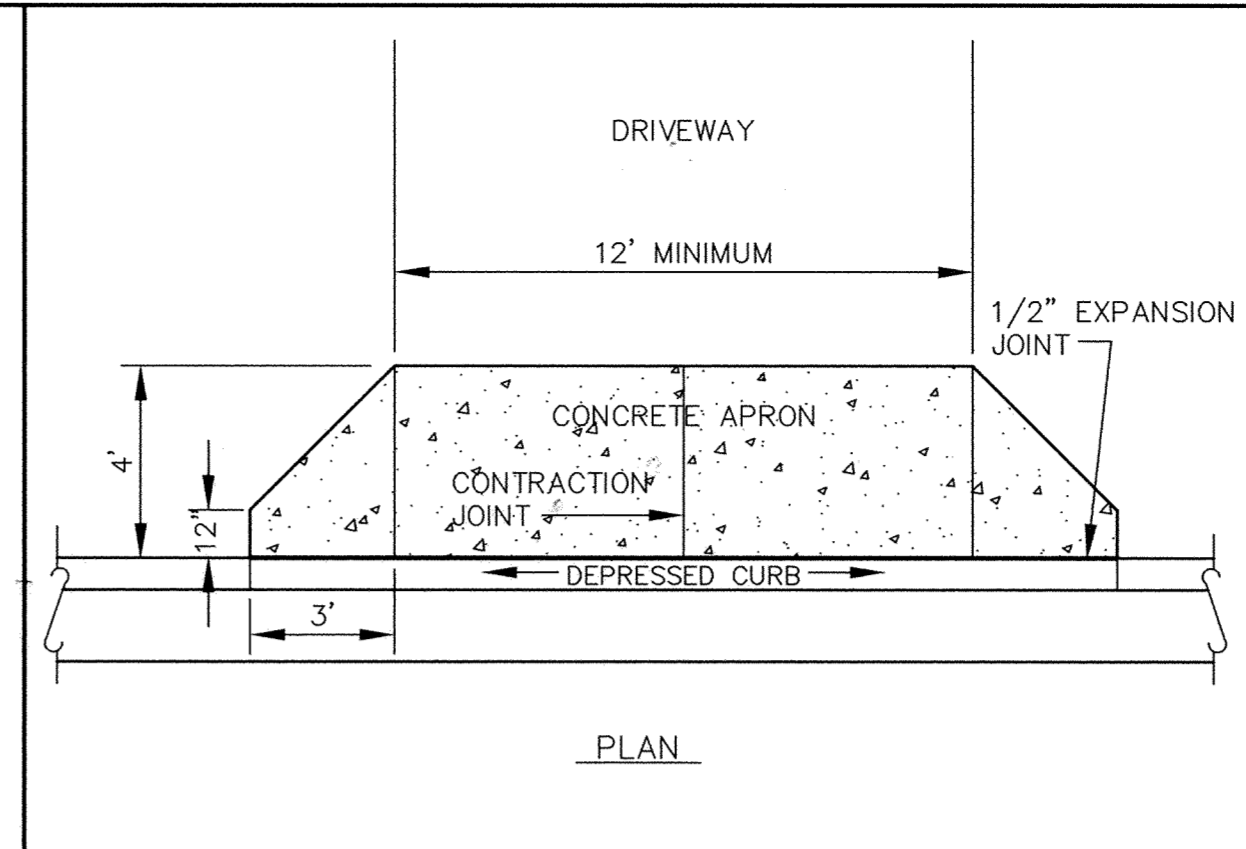


DEPRESSED CURB WITH DRIVEWAY APRON

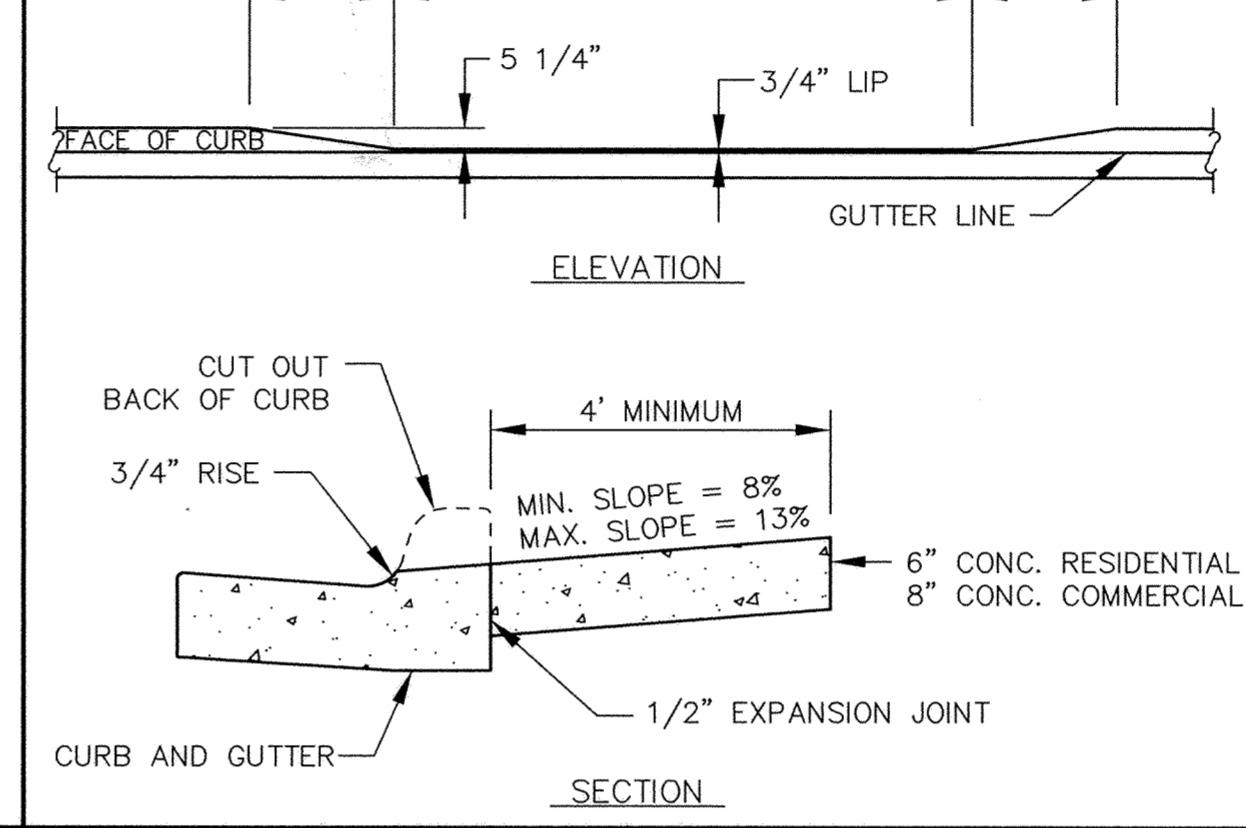


DEPRESSED CURB DETAIL

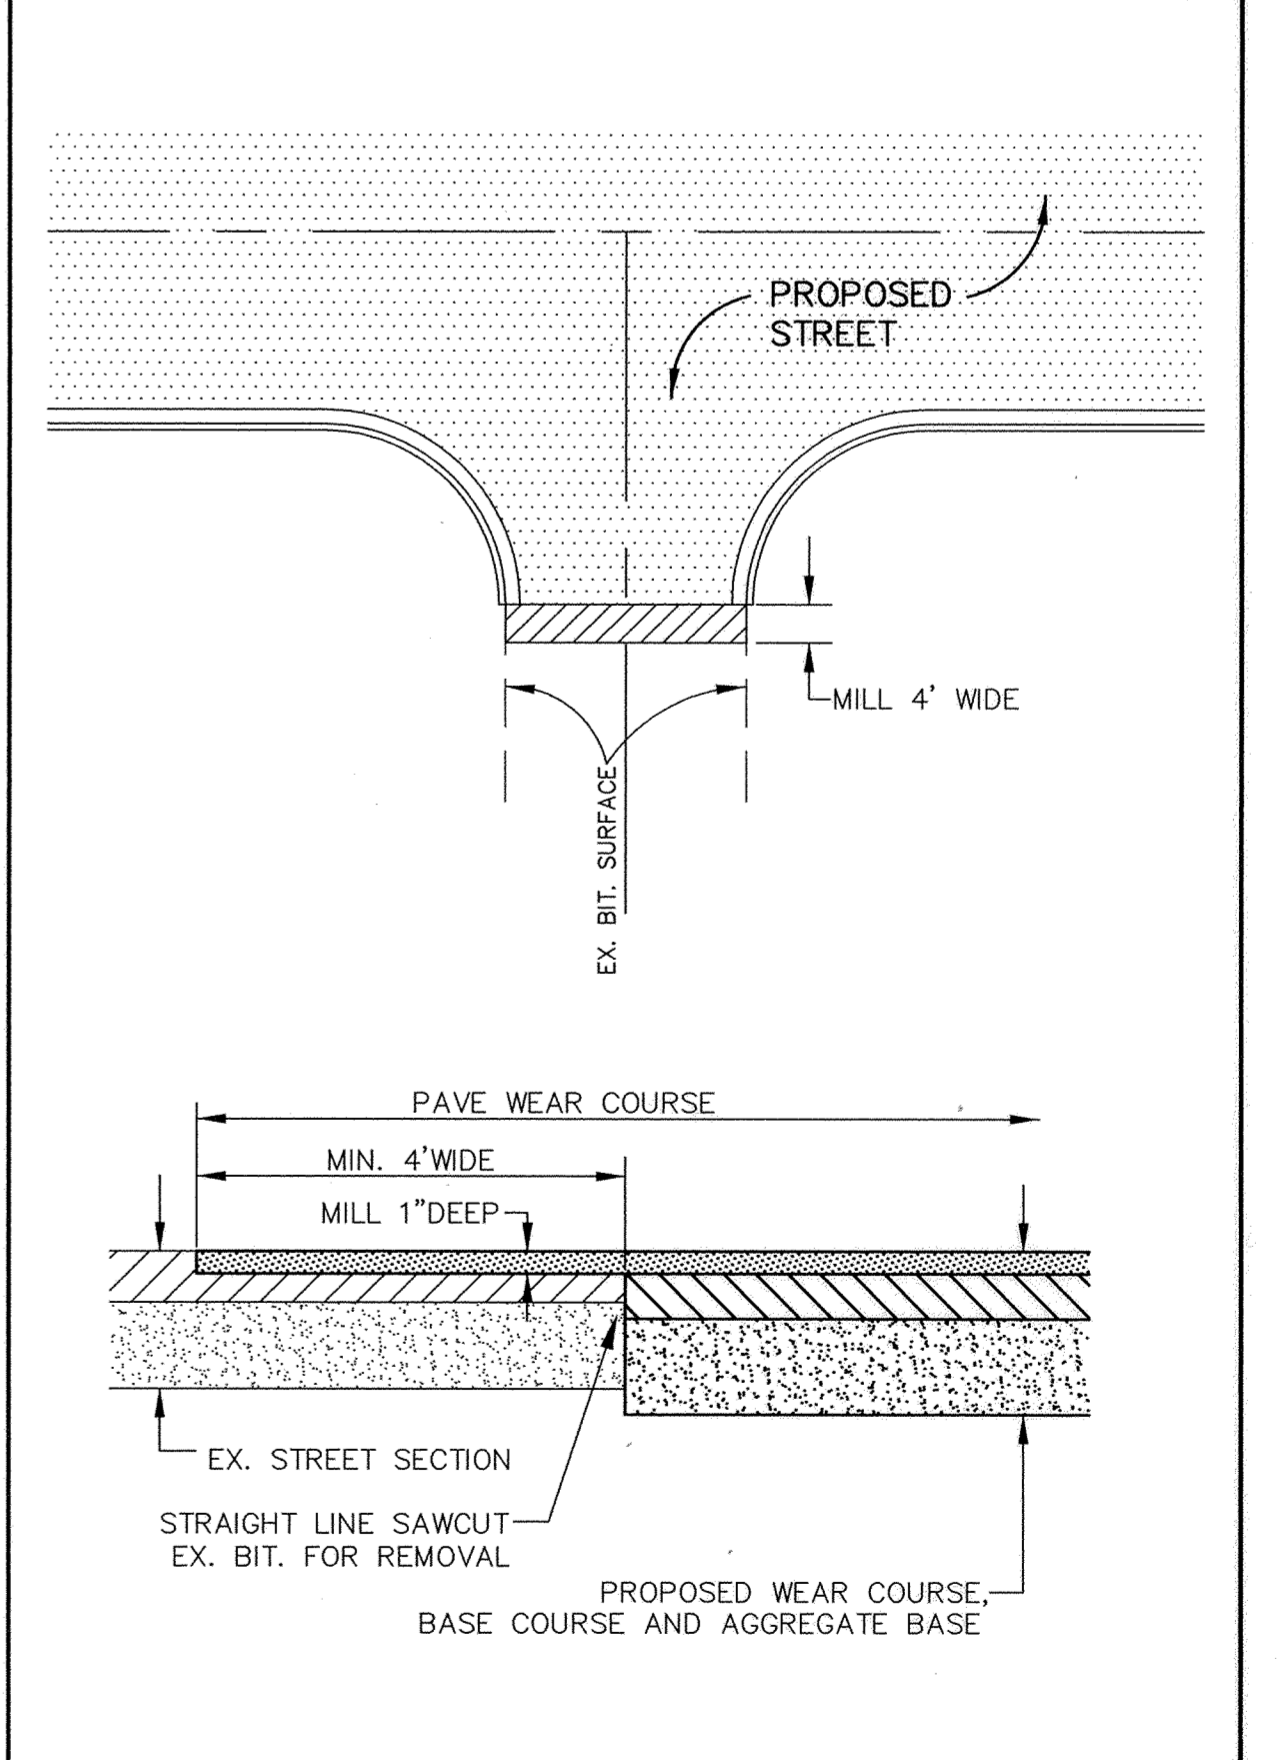


MATCH EXISTING BITUMINOUS SURFACING

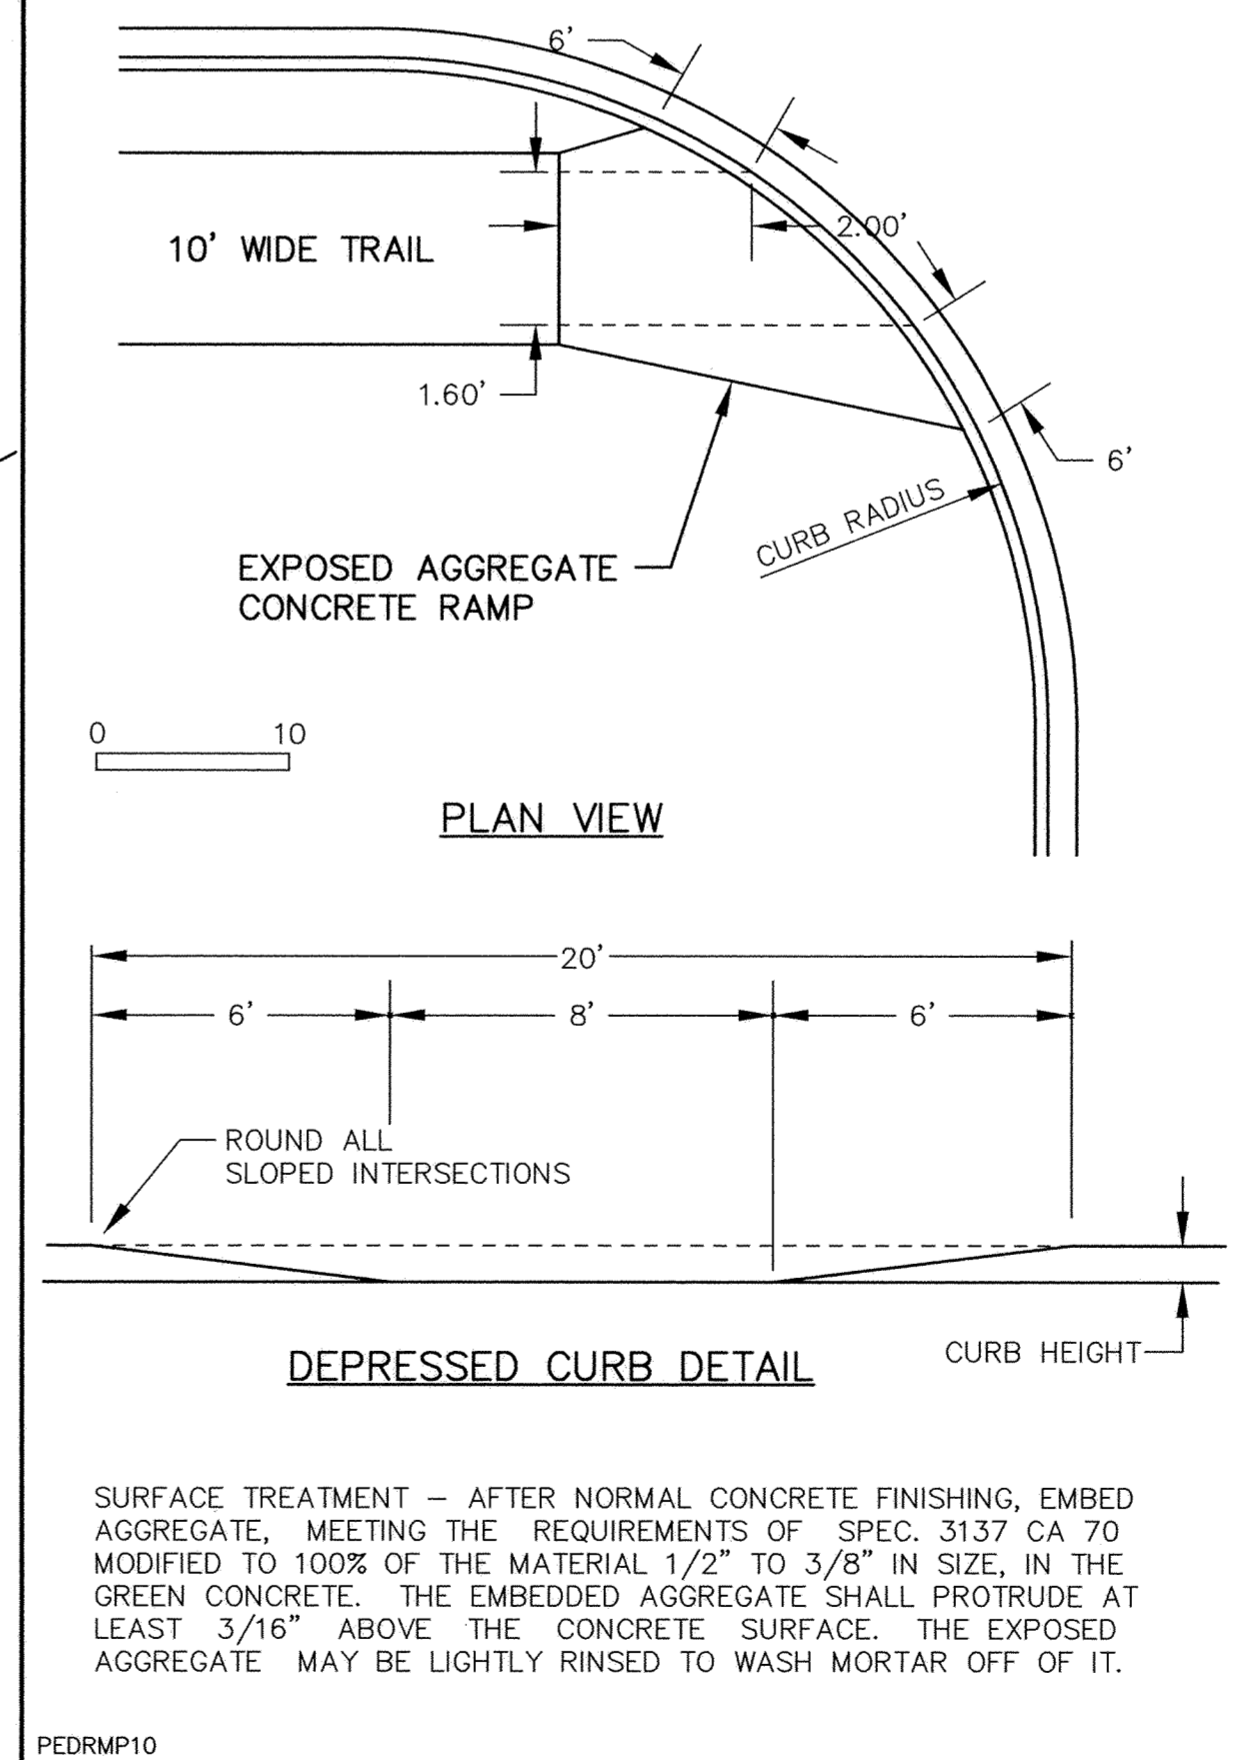


PEDESTRIAN CURB RAMPS

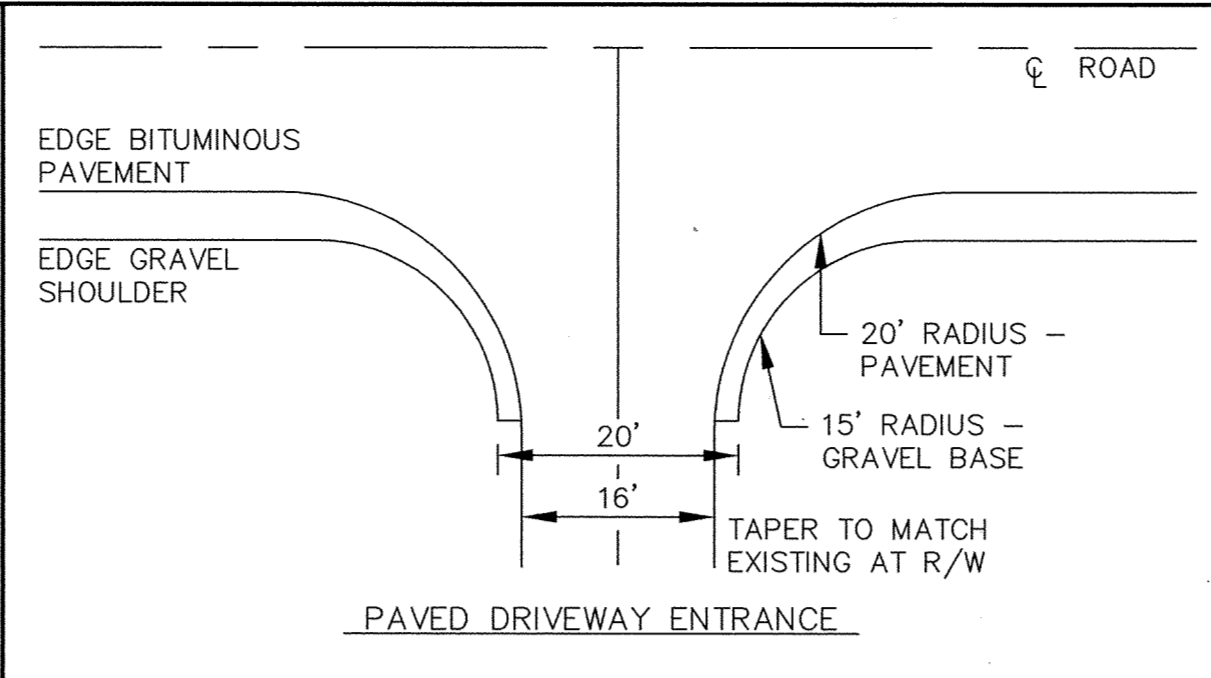


PAVED DRIVEWAY ENTRANCE

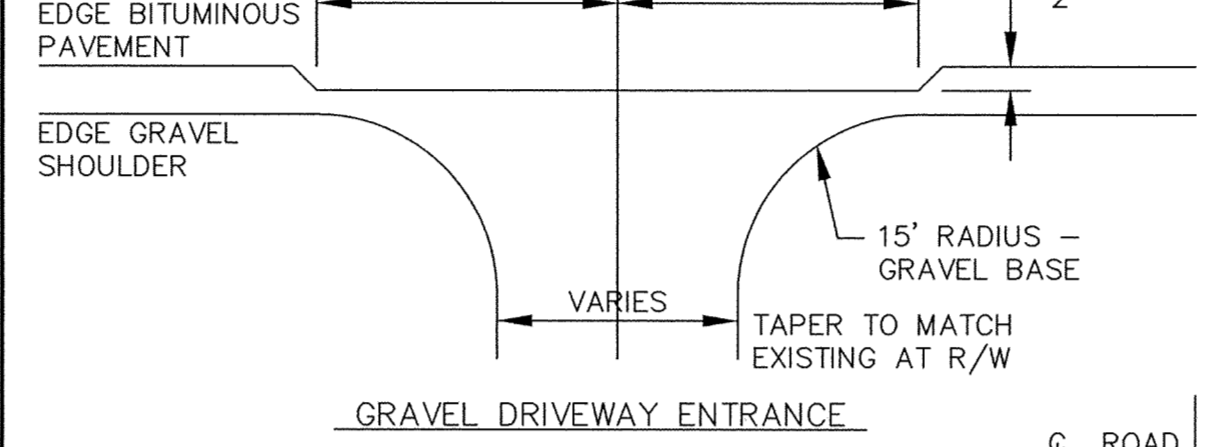


GRAVEL DRIVEWAY ENTRANCE

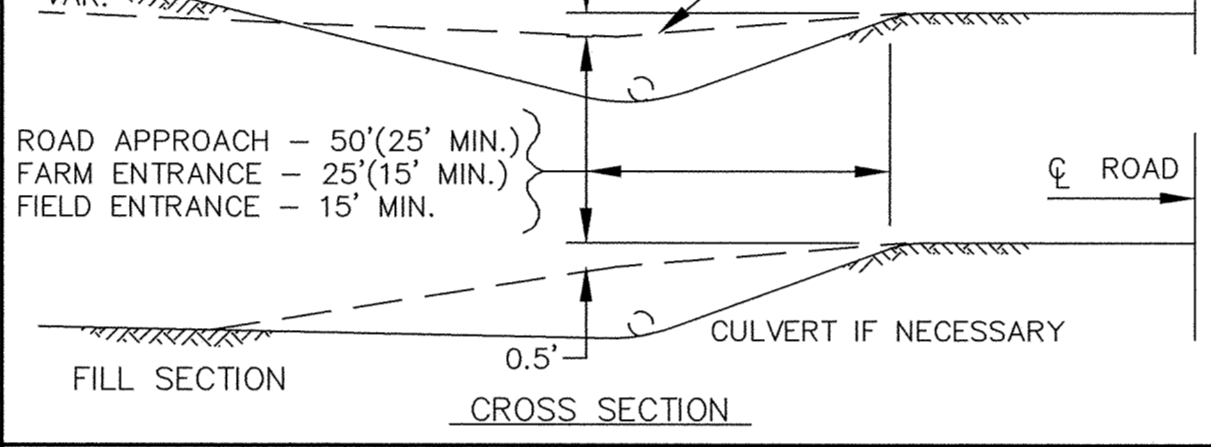


RURAL DRIVEWAY ENTRANCE

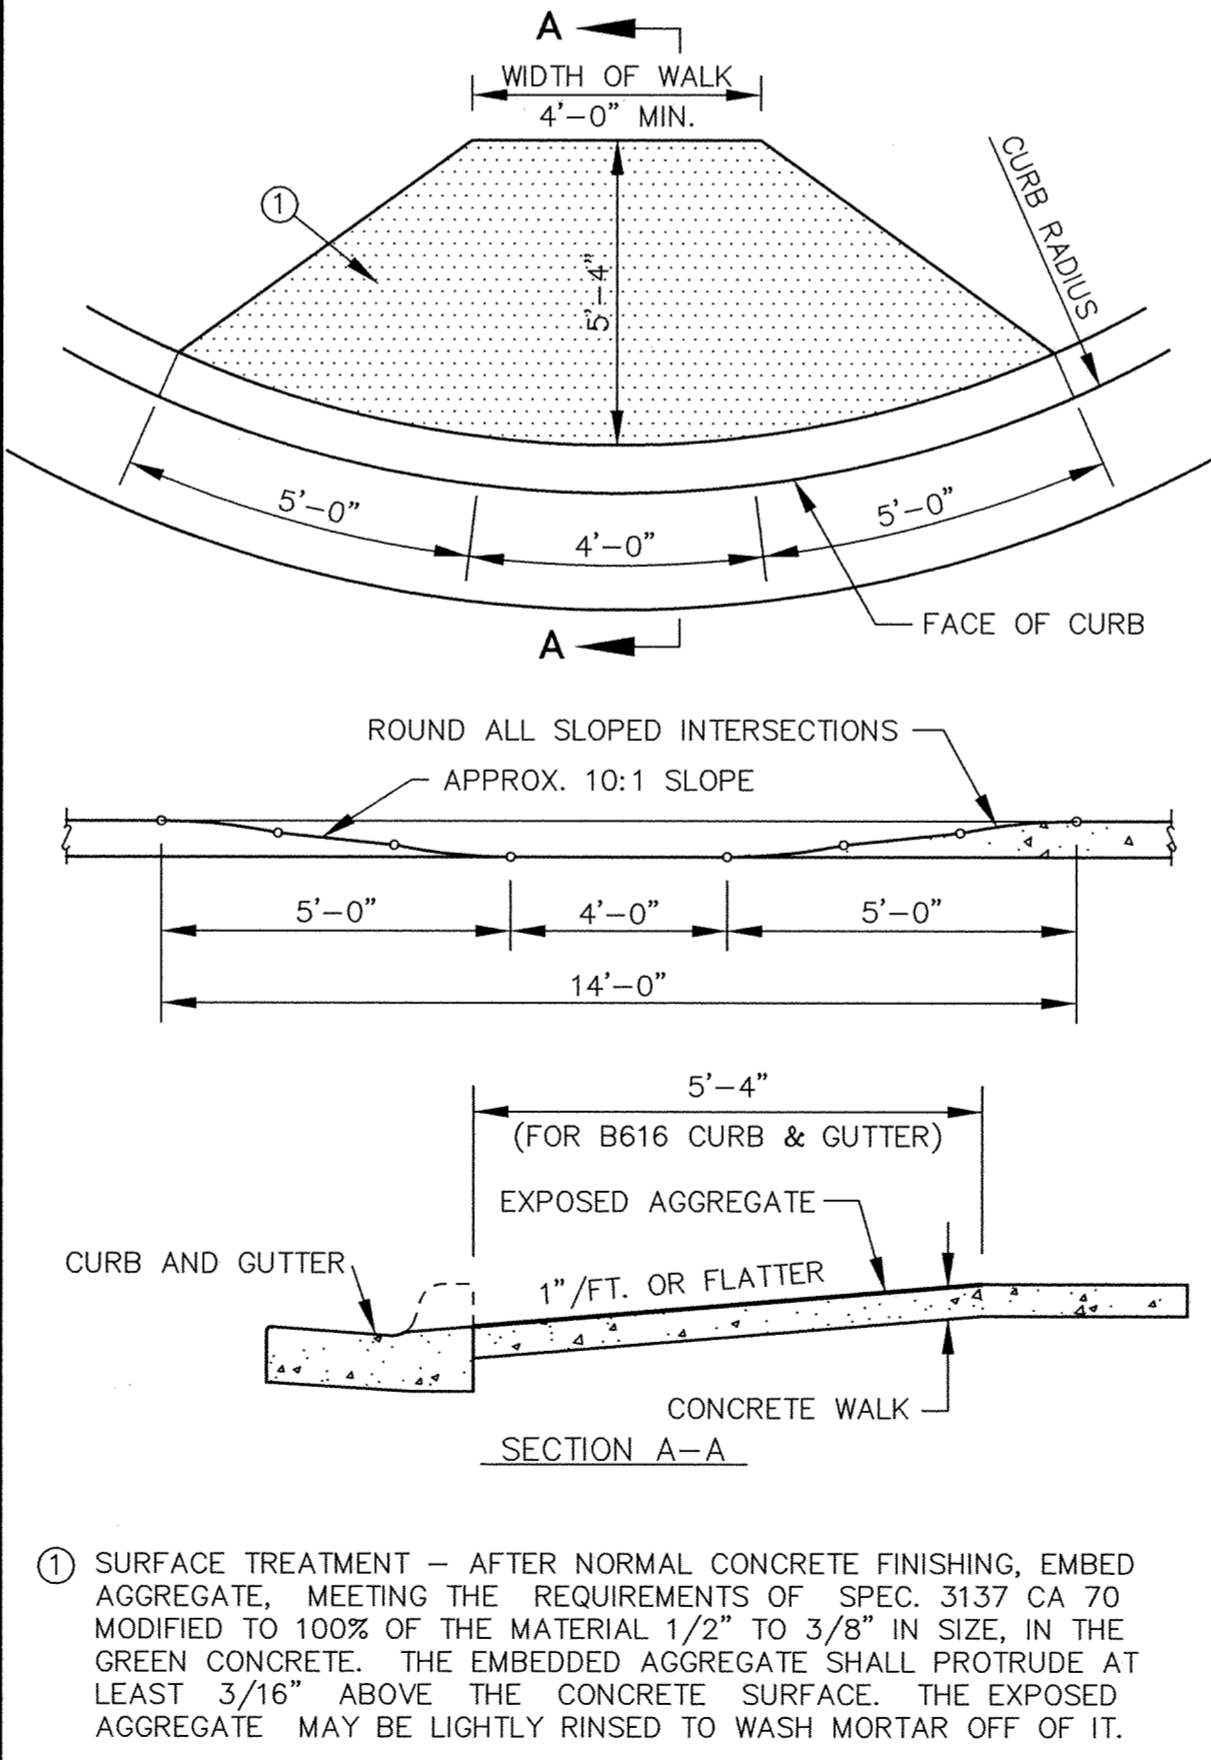


CONCRETE "V" GUTTER

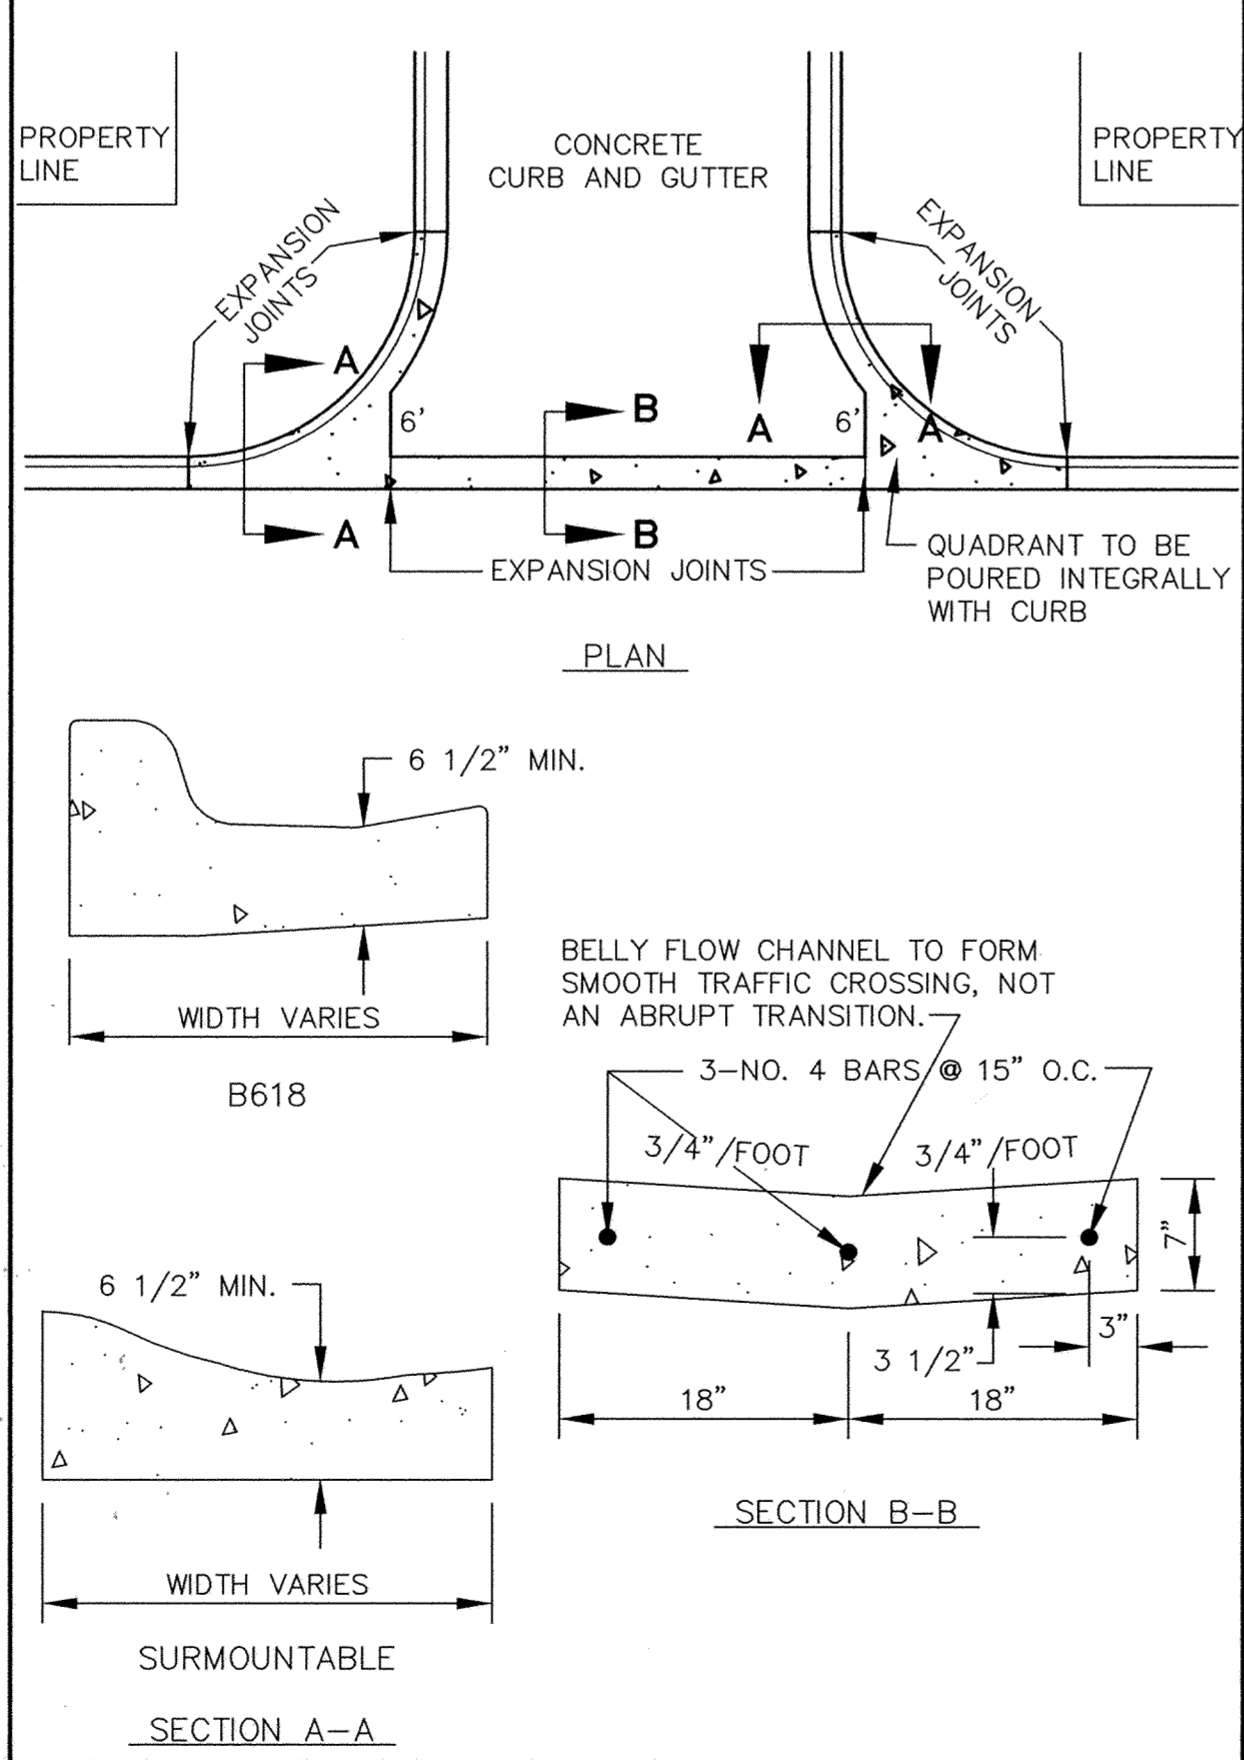


EROSION CONTROL DETAIL

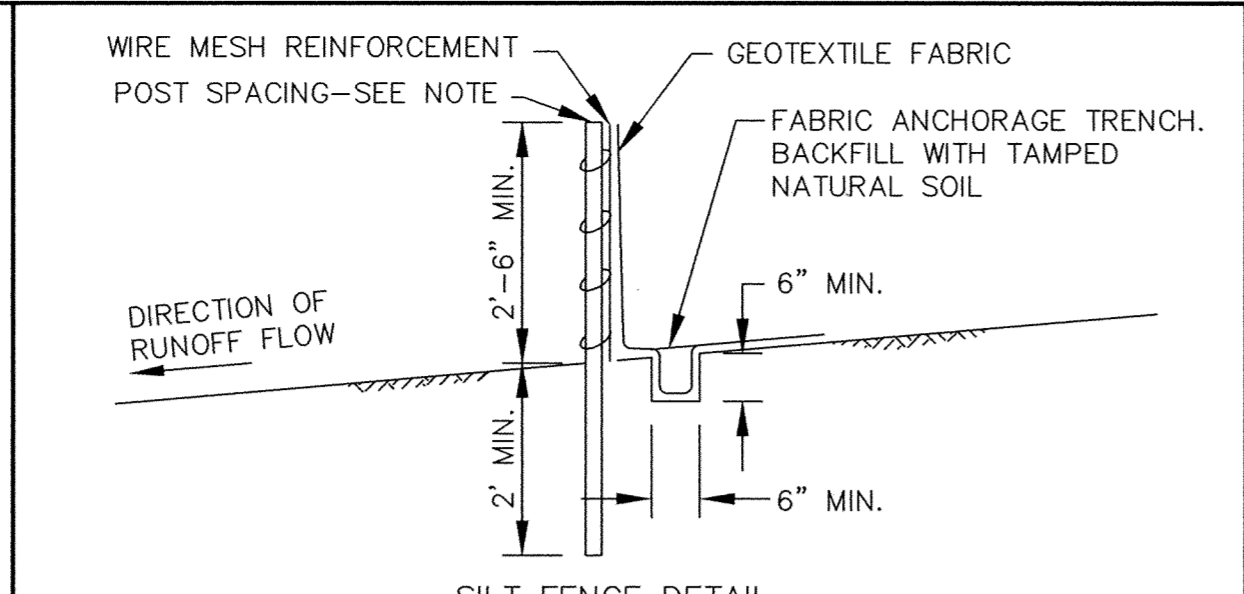


SILT FENCE DETAIL

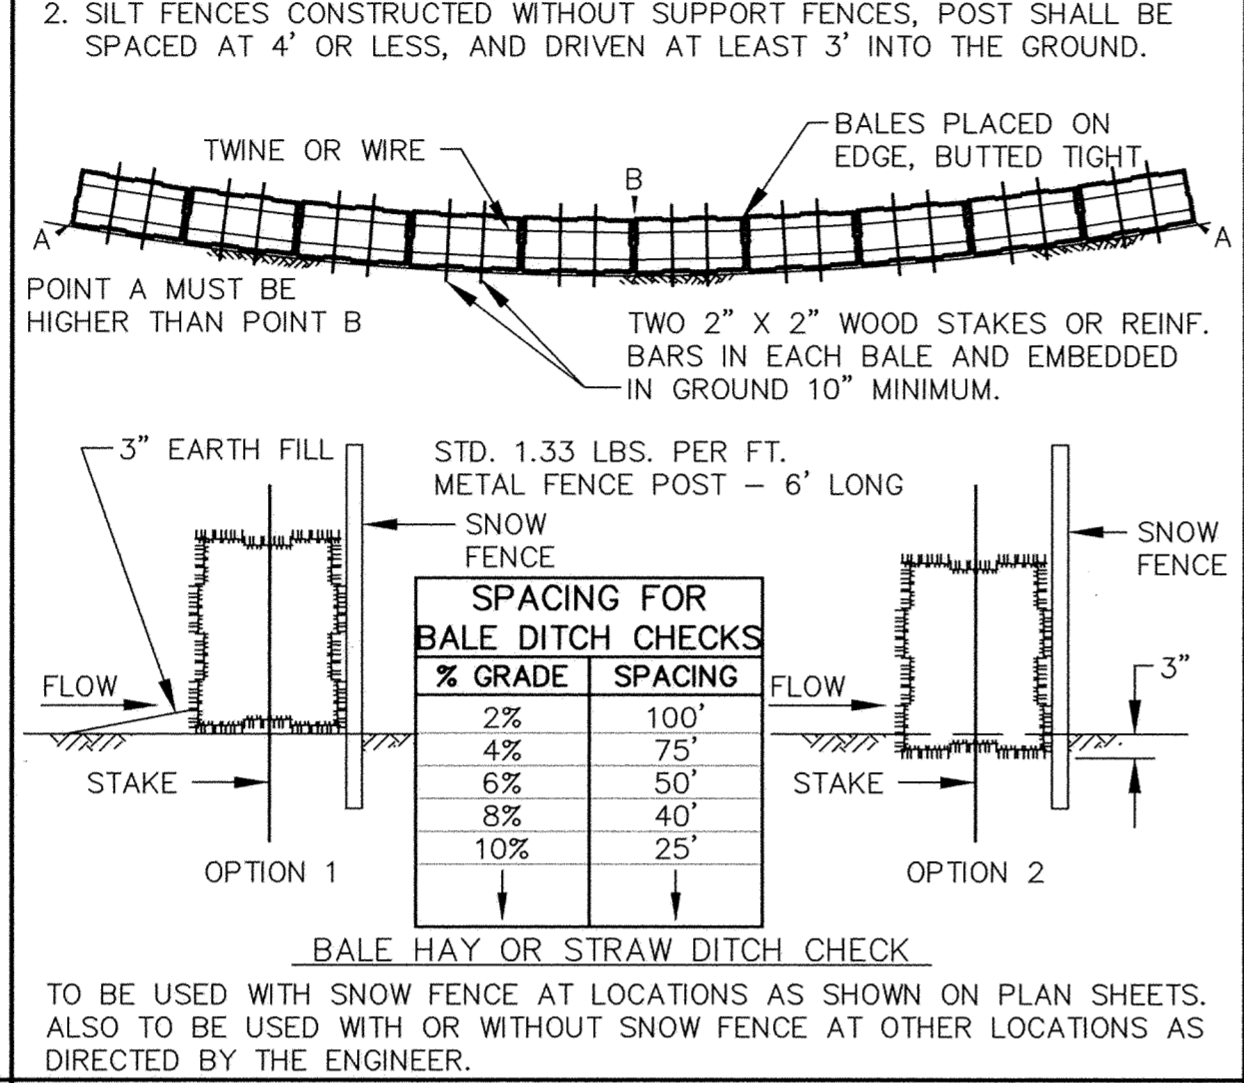


BALE HAY OR STRAW DITCH CHECK

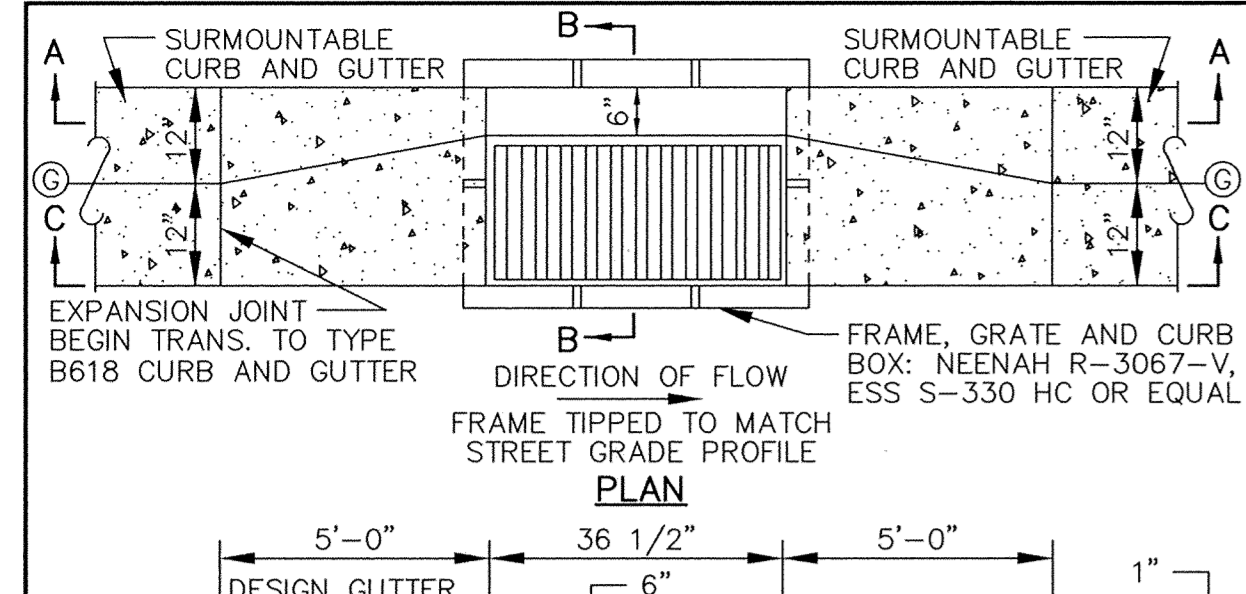

CATCH BASIN FRAME PLACEMENT SURMOUNTABLE CURB AND GUTTER

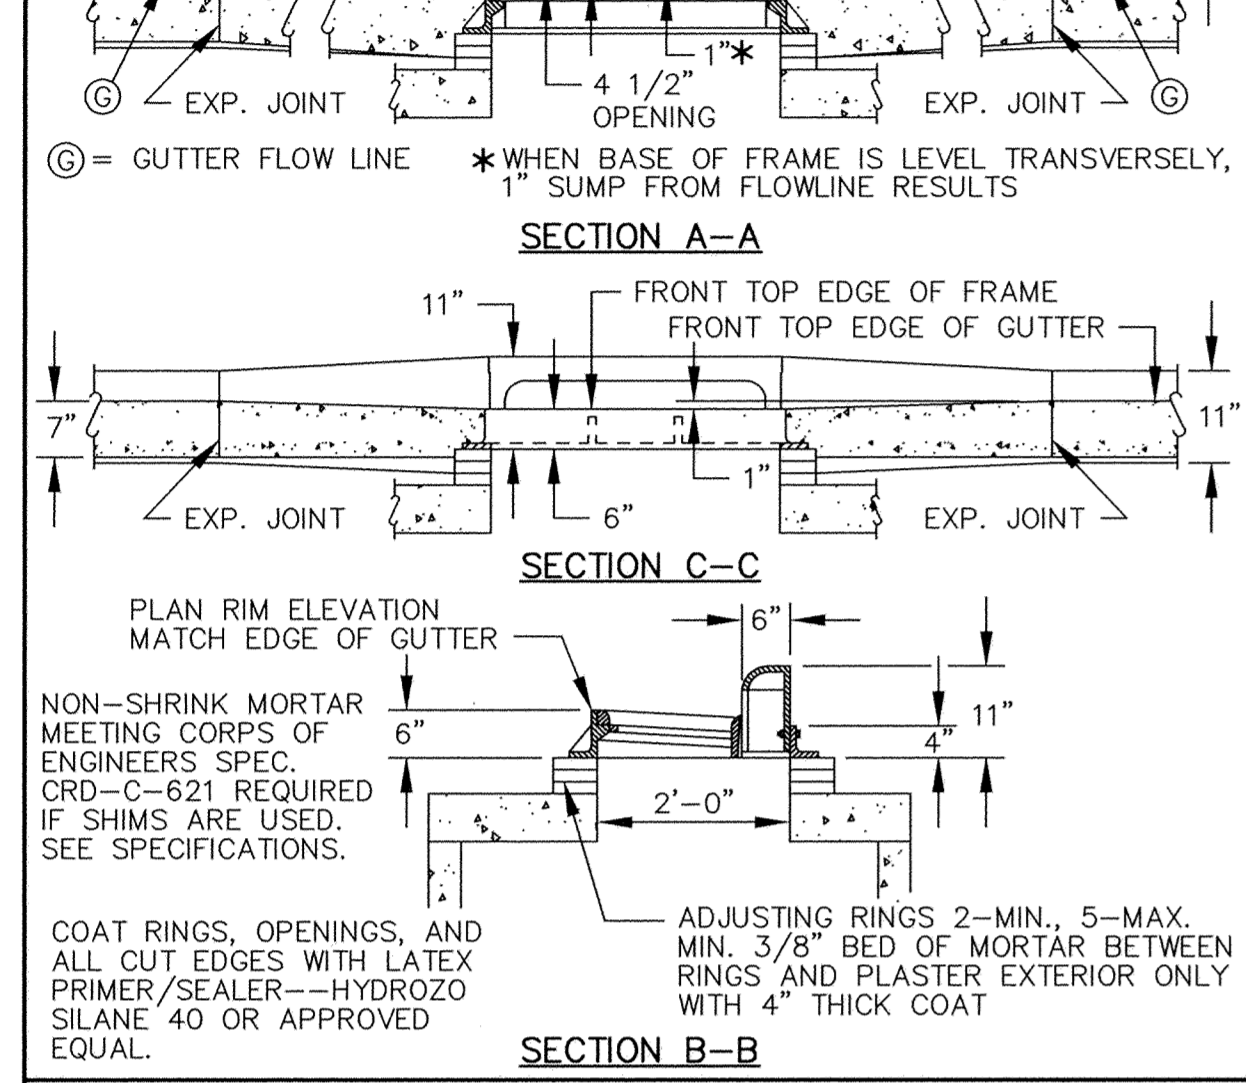

MAIL BOX

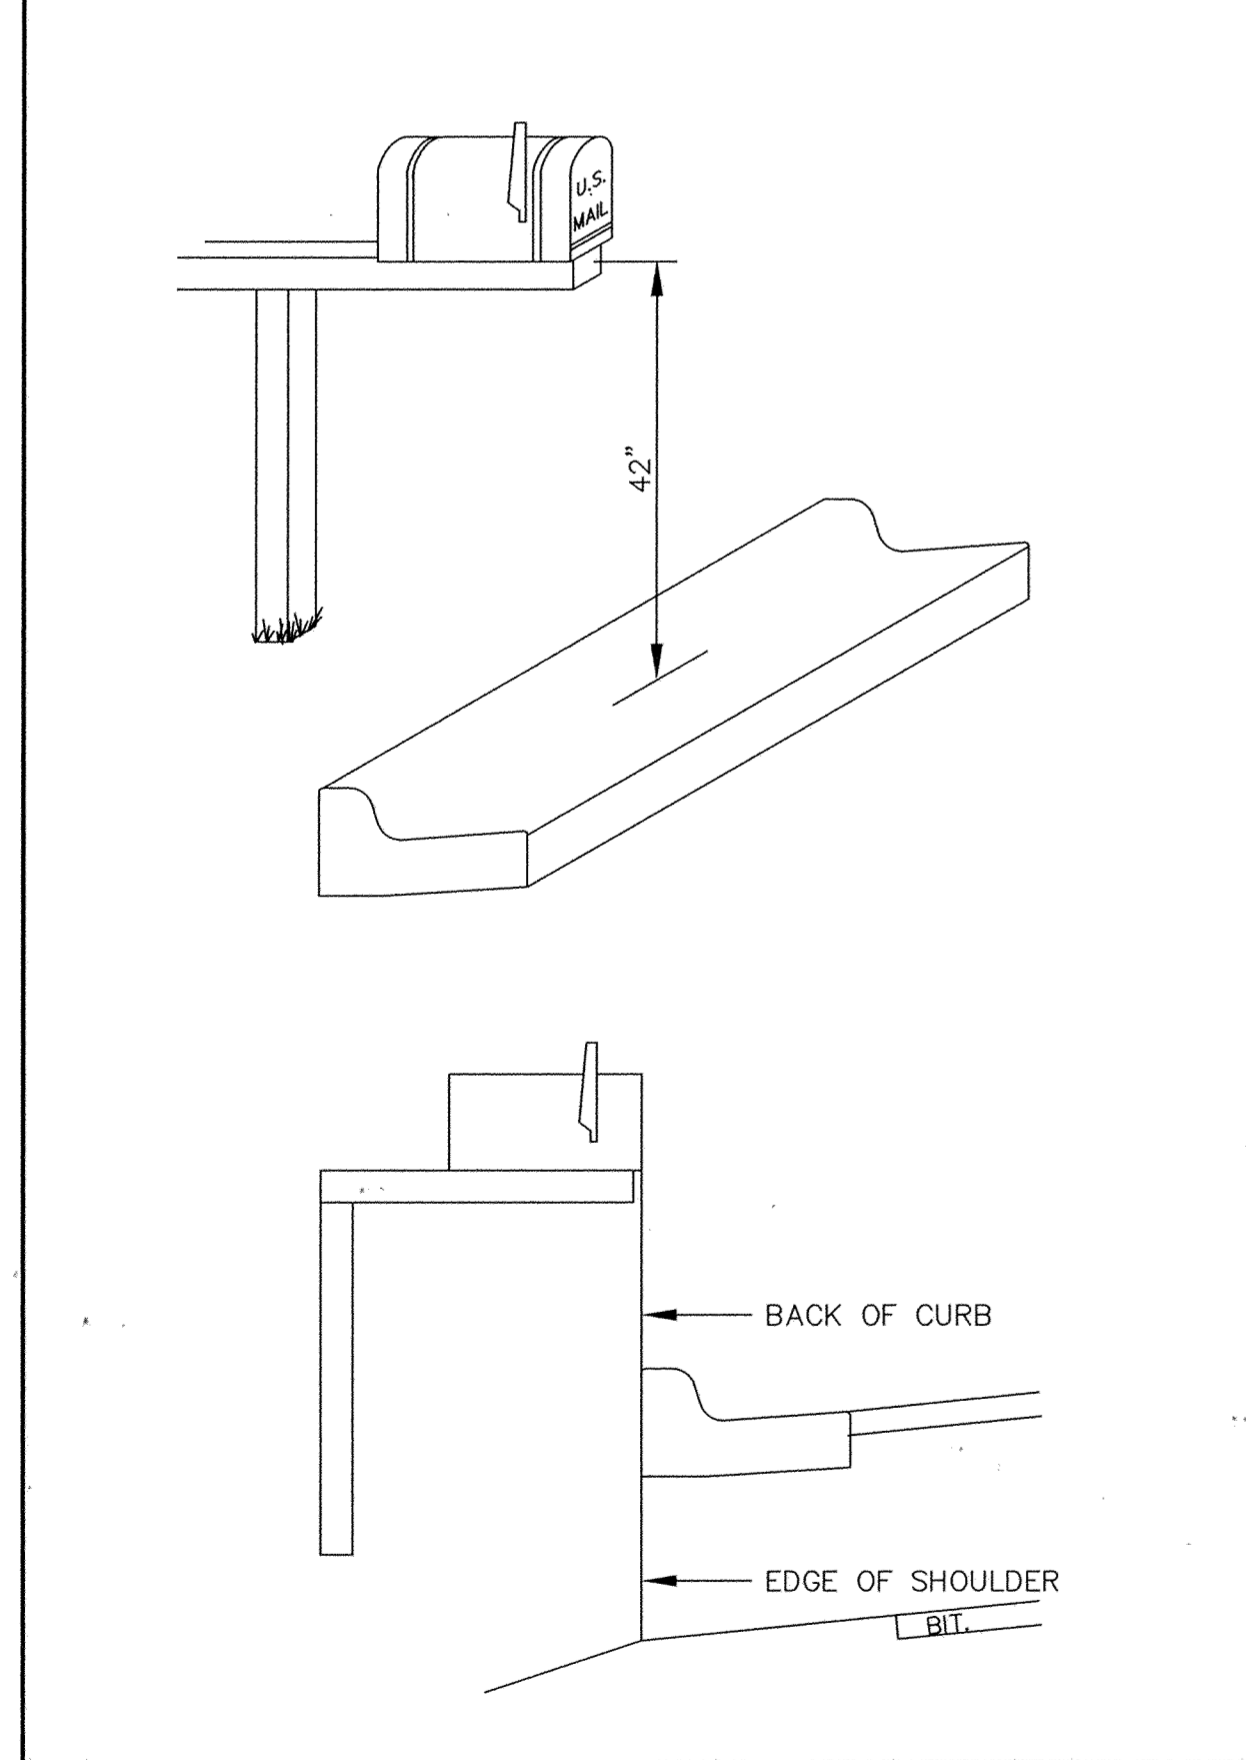

MAIL BOX

RECORD DRAWING
OCTOBER 1997

I HEREBY CERTIFY THAT THIS PLAN, SPECIFICATION, OR REPORT WAS PREPARED BY ME OR UNDER MY DIRECT SUPERVISION AND THAT I AM A DULY REGISTERED PROFESSIONAL ENGINEER UNDER THE LAWS OF THE STATE OF MINNESOTA.
Kevin J. Manan
DATE 3/22/94 REG. NO. 15246



1326 ENERGY PARK DRIVE
ST. PAUL, MINNESOTA 55108
(612) 644-4389
5075 WAYZATA BLVD. SUITE #225
MINNEAPOLIS, MINNESOTA 55416
(612) 546-0432

DATE	DESCRIPTION	DESIGNED

GRAPHIC SCALE
0 HORIZ. N/A
0 VERT. 5

CITY OF ELK RIVER
185TH AVENUE / T.H. 10 TURN LANES
STREET CONSTRUCTION DETAILS
S.P. 7102-8(TH 10)
DATE JAN 1996 SHEET 41 OF 41 SHEETS PROJECT NO. 230-277