



NOTES:

1. CONTRACTOR SHALL BE RESPONSIBLE FOR CONTACTING GOPHER STATE ONE CALL. CONTRACTOR SHALL COORDINATE WITH UTILITY REPRESENTATIVES TO ENSURE THAT THE INTEGRITY OF THE UTILITIES ARE MAINTAINED AND PAY FOR ANY FEES ASSOCIATED WITH THE INSTALLATION WORK. NORTHERN NATURAL GAS REQUIRES NOTIFICATION PRIOR TO ANY CROSSING OF THEIR PIPELINE.

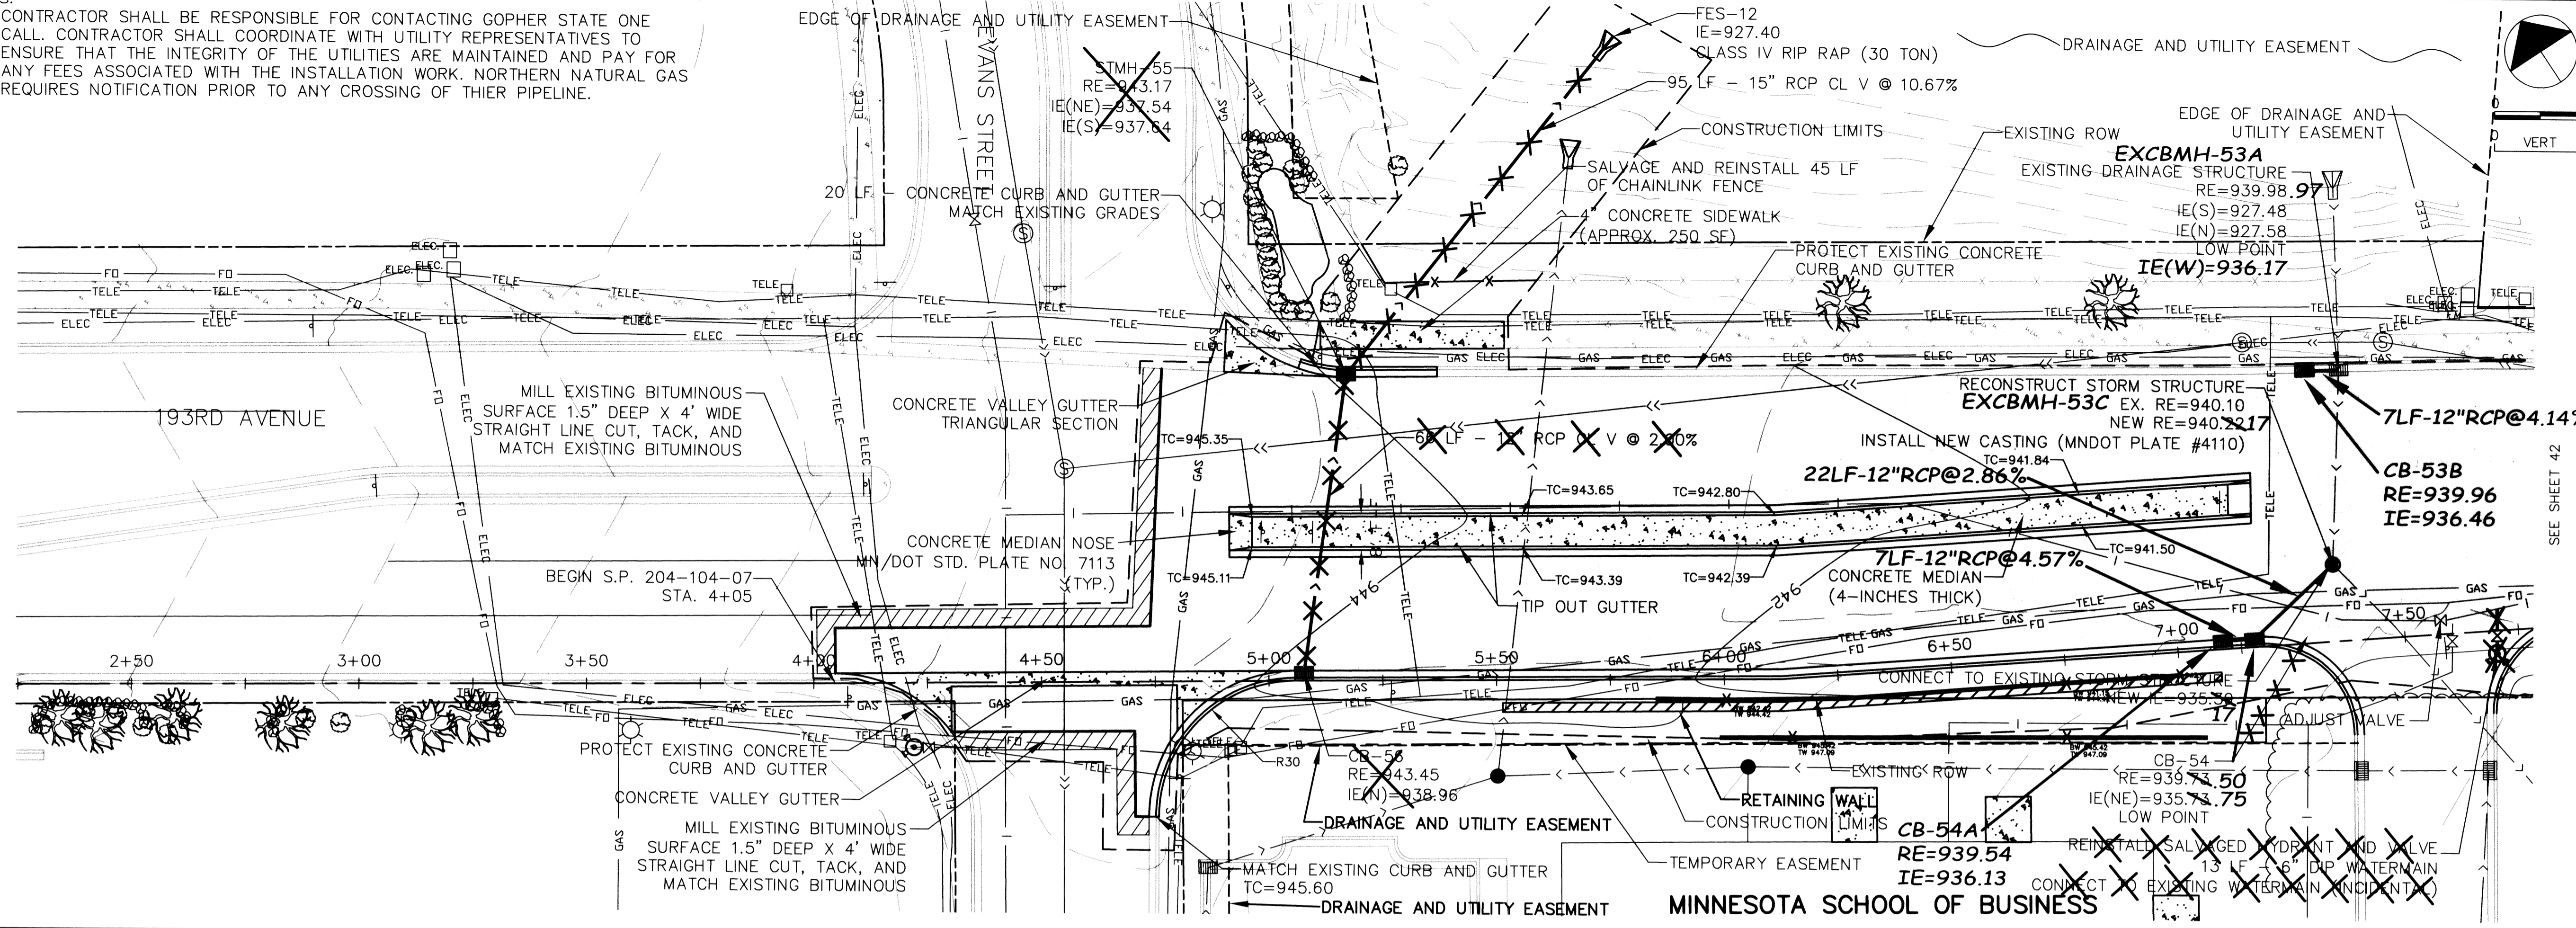


SEE SHEET 42

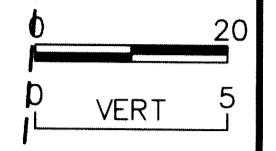

NO.	DATE	DESCRIPTION
1	1/25/10	IA RECORD DRAWING

I HEREBY CERTIFY THAT THIS PLAN, SPECIFICATIONS AND CONTRACT DOCUMENTS WERE PREPARED BY ME OR UNDER MY DIRECT SUPERVISION AND THAT I AM A DULY LICENSED PROFESSIONAL ENGINEER UNDER THE LAWS OF THE STATE OF MINNESOTA.  
 Print Name: JOHN M. ANDERSON  
 Signature: *[Signature]*  
 Date: 07-31-08 License # 256889

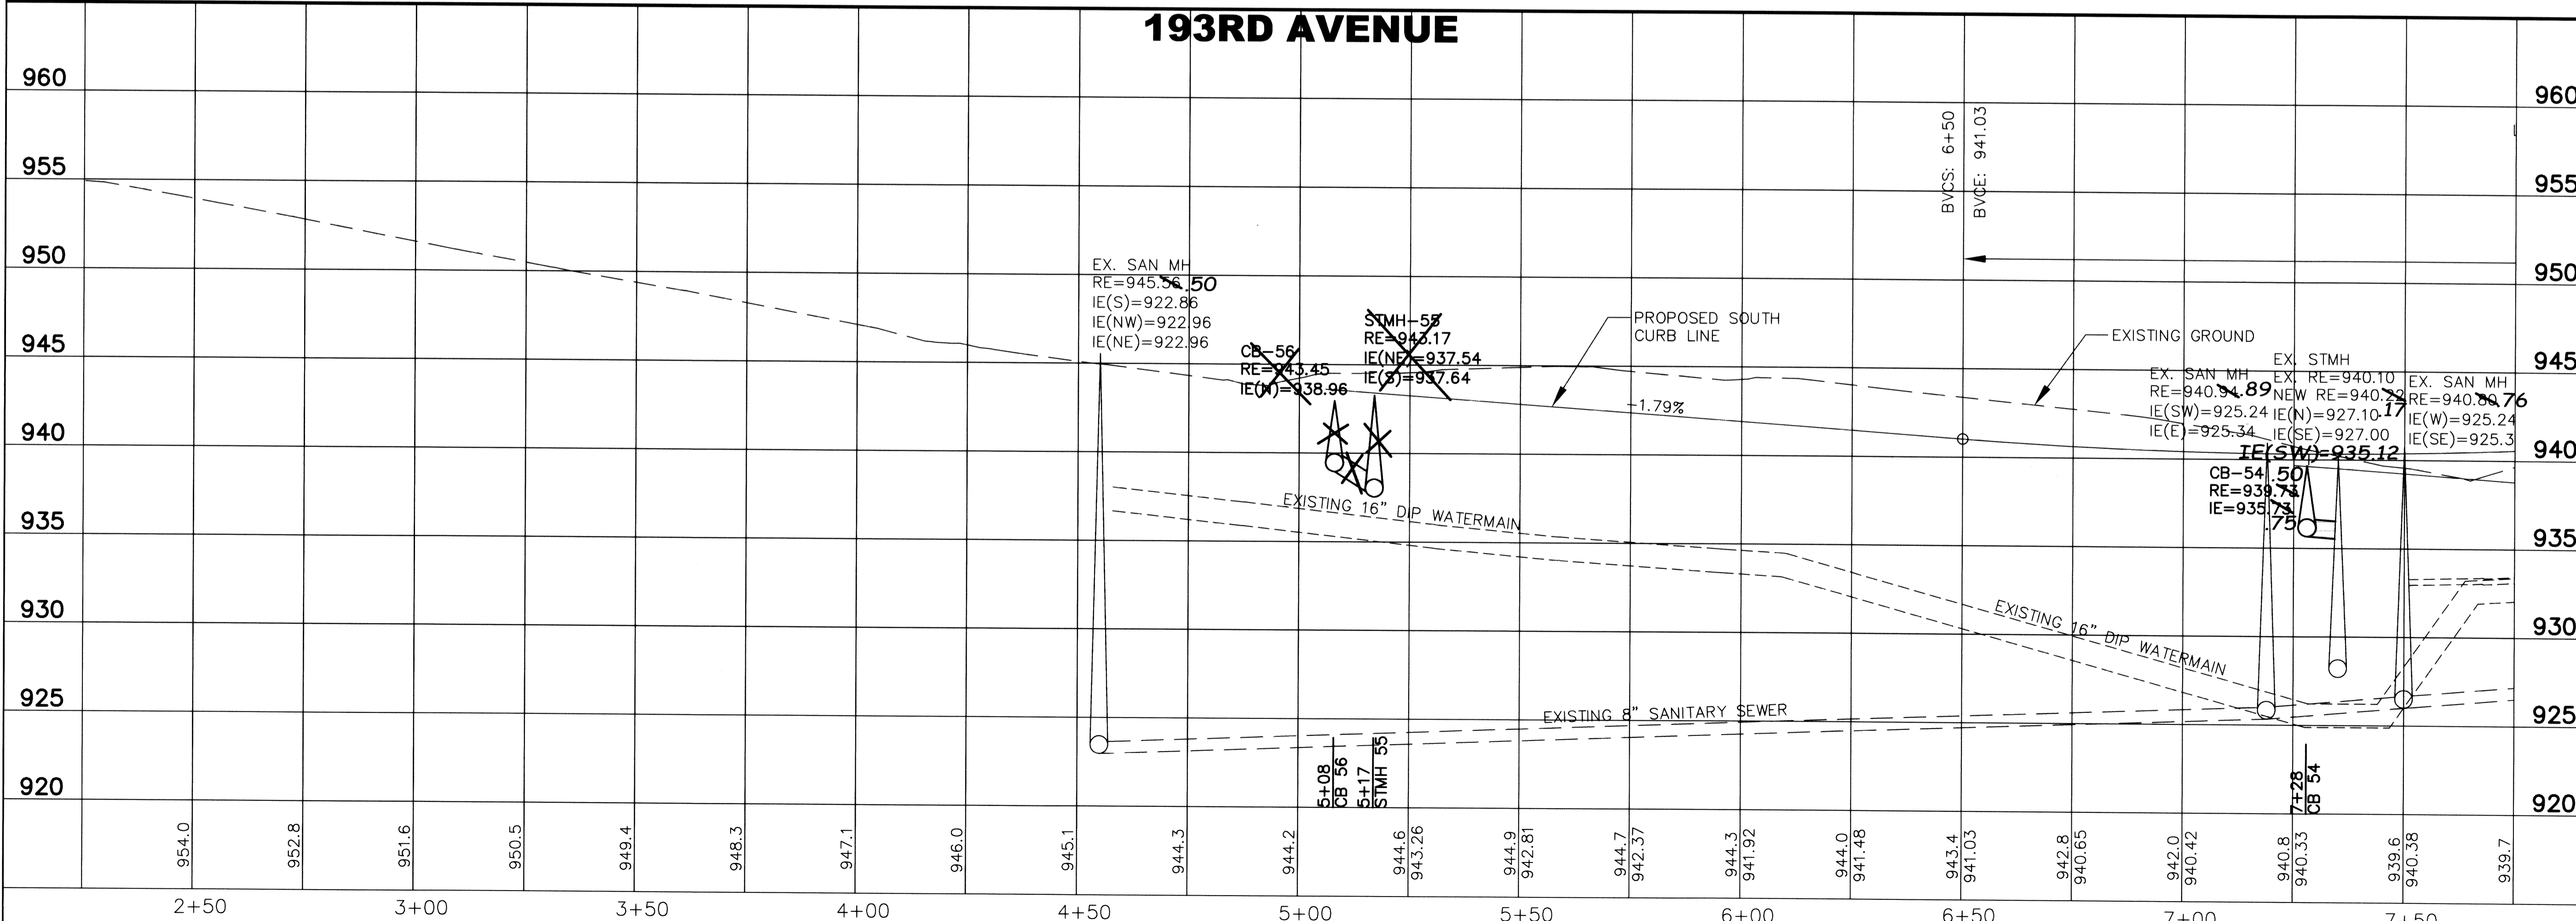

**CITY OF ELK RIVER**  
**193RD AVENUE STREET CONSTRUCTION**  
**STREET AND STORM SEWER**  
**193RD AVENUE/EVANS STREET**  
**RECORD PLAN**

**BDM**  
 CONSULTING ENGINEERS, PLC  
 Engineers and Surveyors  
 11040 183rd Circle NW  
 Elk River, MN 55330  
 Phone: (763) 441-0877  
 Fax: (763) 441-7724  
 bdmce.com

DRAWN BY: NAB  
 CHECKED BY: KJE  
 DESIGNED BY: KJE  
 JOB NO. 226069D