
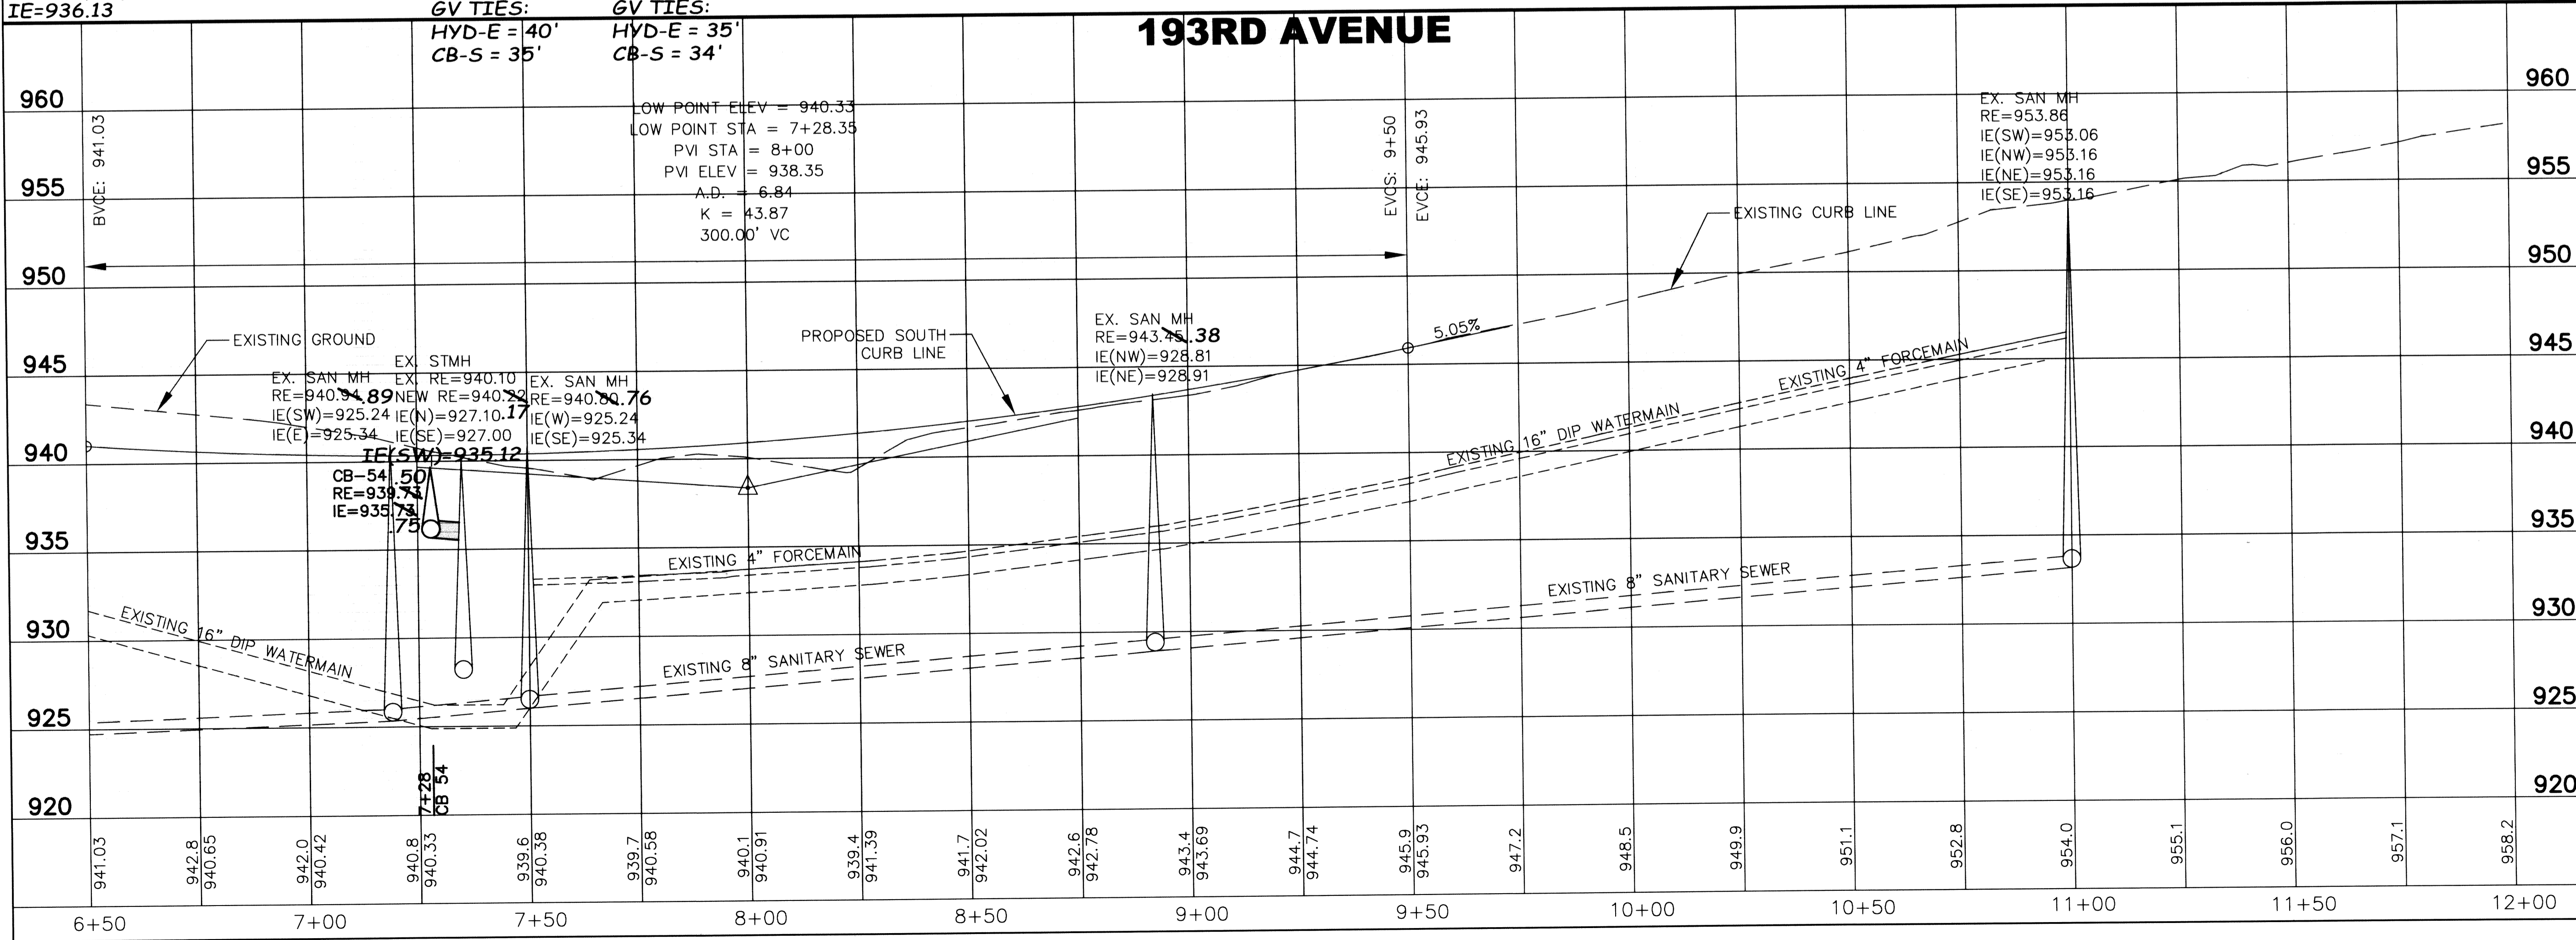


NOTES:

1. CONTRACTOR SHALL BE RESPONSIBLE FOR CONTACTING GOPHER STATE ONE CALL. CONTRACTOR SHALL COORDINATE WITH UTILITY REPRESENTATIVES TO ENSURE THAT THE INTEGRITY OF THE UTILITIES ARE MAINTAINED AND PAY FOR ANY FEES ASSOCIATED WITH THE INSTALLATION WORK. NORTHERN NATURAL GAS REQUIRES NOTIFICATION PRIOR TO ANY CROSSING OF THEIR PIPELINE.

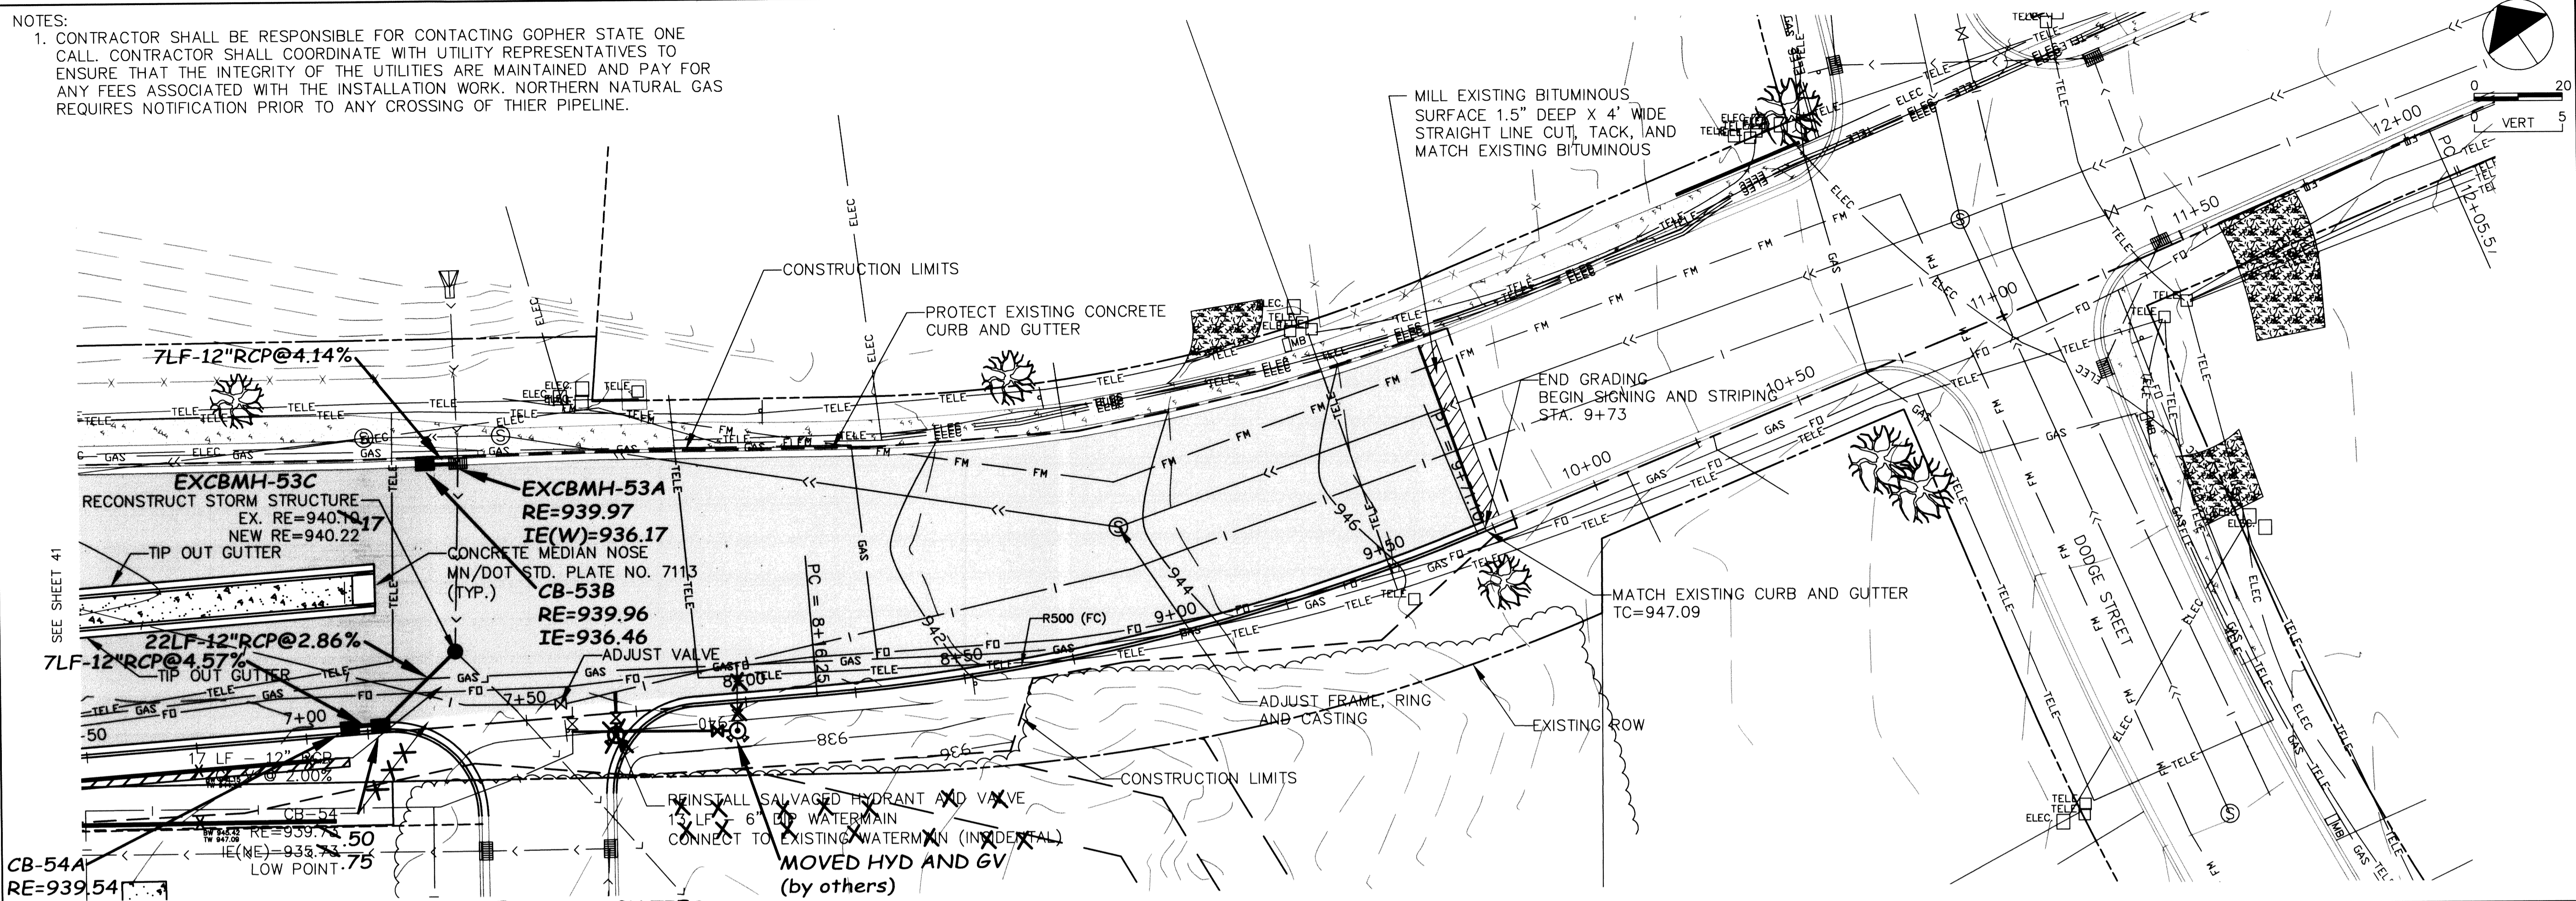

| REVISIONS | NO. | DATE | DESCRIPTION |
|-----------|-----|---------|-------------------|
| | 1 | 1/25/10 | IA RECORD DRAWING |

HEREBY CERTIFY THAT THIS PLAN SPECIFICALLY PREPARED FOR THE PROJECT AND UNDER MY DIRECT SUPERVISION AND THAT I AM A DULY LICENSED PROFESSIONAL ENGINEER UNDER THE LAWS OF THE STATE OF MINNESOTA.
 Print Name: JOHN M. ANDERSON
 Signature: *[Signature]*
 Date: 07-31-08 License # 25689

SP 204-104-07
CITY OF ELK RIVER
193RD AVENUE STREET CONSTRUCTION
STREET AND STORM SEWER
193RD AVENUE/EVANS STREET
RECORD PLAN
 7+00 TO 11+50

BDM
 CONSULTING ENGINEERS, PLC
 Engineers and Surveyors
 11040 183rd Circle NW
 Elk River, MN 55330
 Phone: (763) 441-0877
 Fax: (763) 441-7724
 bdnce.com

| |
|------------------|
| DRAWN BY: NAB |
| CHECKED BY: KJE |
| DESIGNED BY: KJE |
| JOB NO. 226069D |

| | |
|-----------------|-------------------|
| SHEET 42 | SHEETS 146 |
|-----------------|-------------------|