
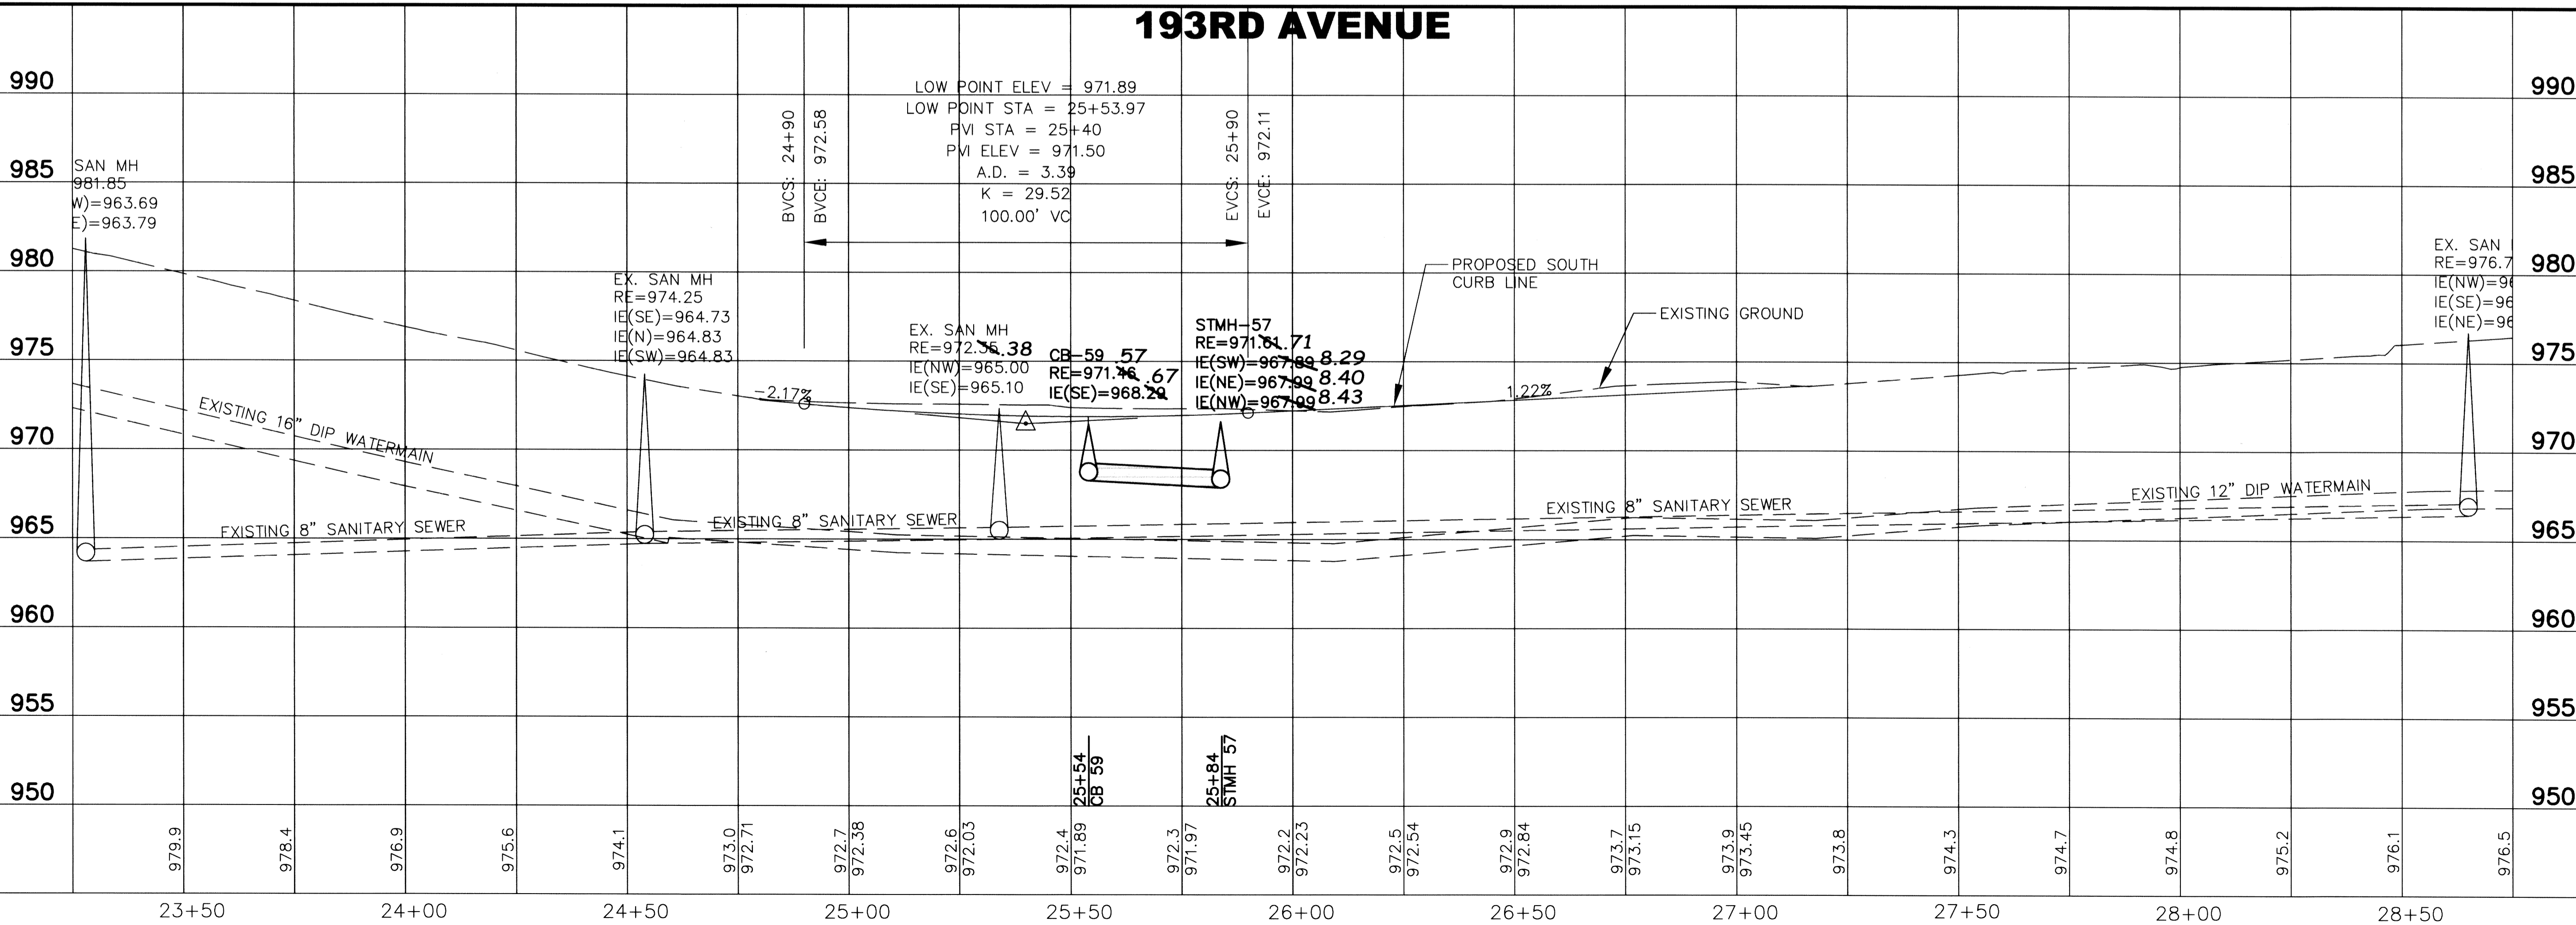


NOTES:
 1. CONTRACTOR SHALL BE RESPONSIBLE FOR CONTACTING GOPHER STATE ONE CALL. CONTRACTOR SHALL COORDINATE WITH UTILITY REPRESENTATIVES TO ENSURE THAT THE INTEGRITY OF THE UTILITIES ARE MAINTAINED AND PAY FOR ANY FEES ASSOCIATED WITH THE INSTALLATION WORK. NORTHERN NATURAL GAS REQUIRES NOTIFICATION PRIOR TO ANY CROSSING OF THEIR PIPELINE.

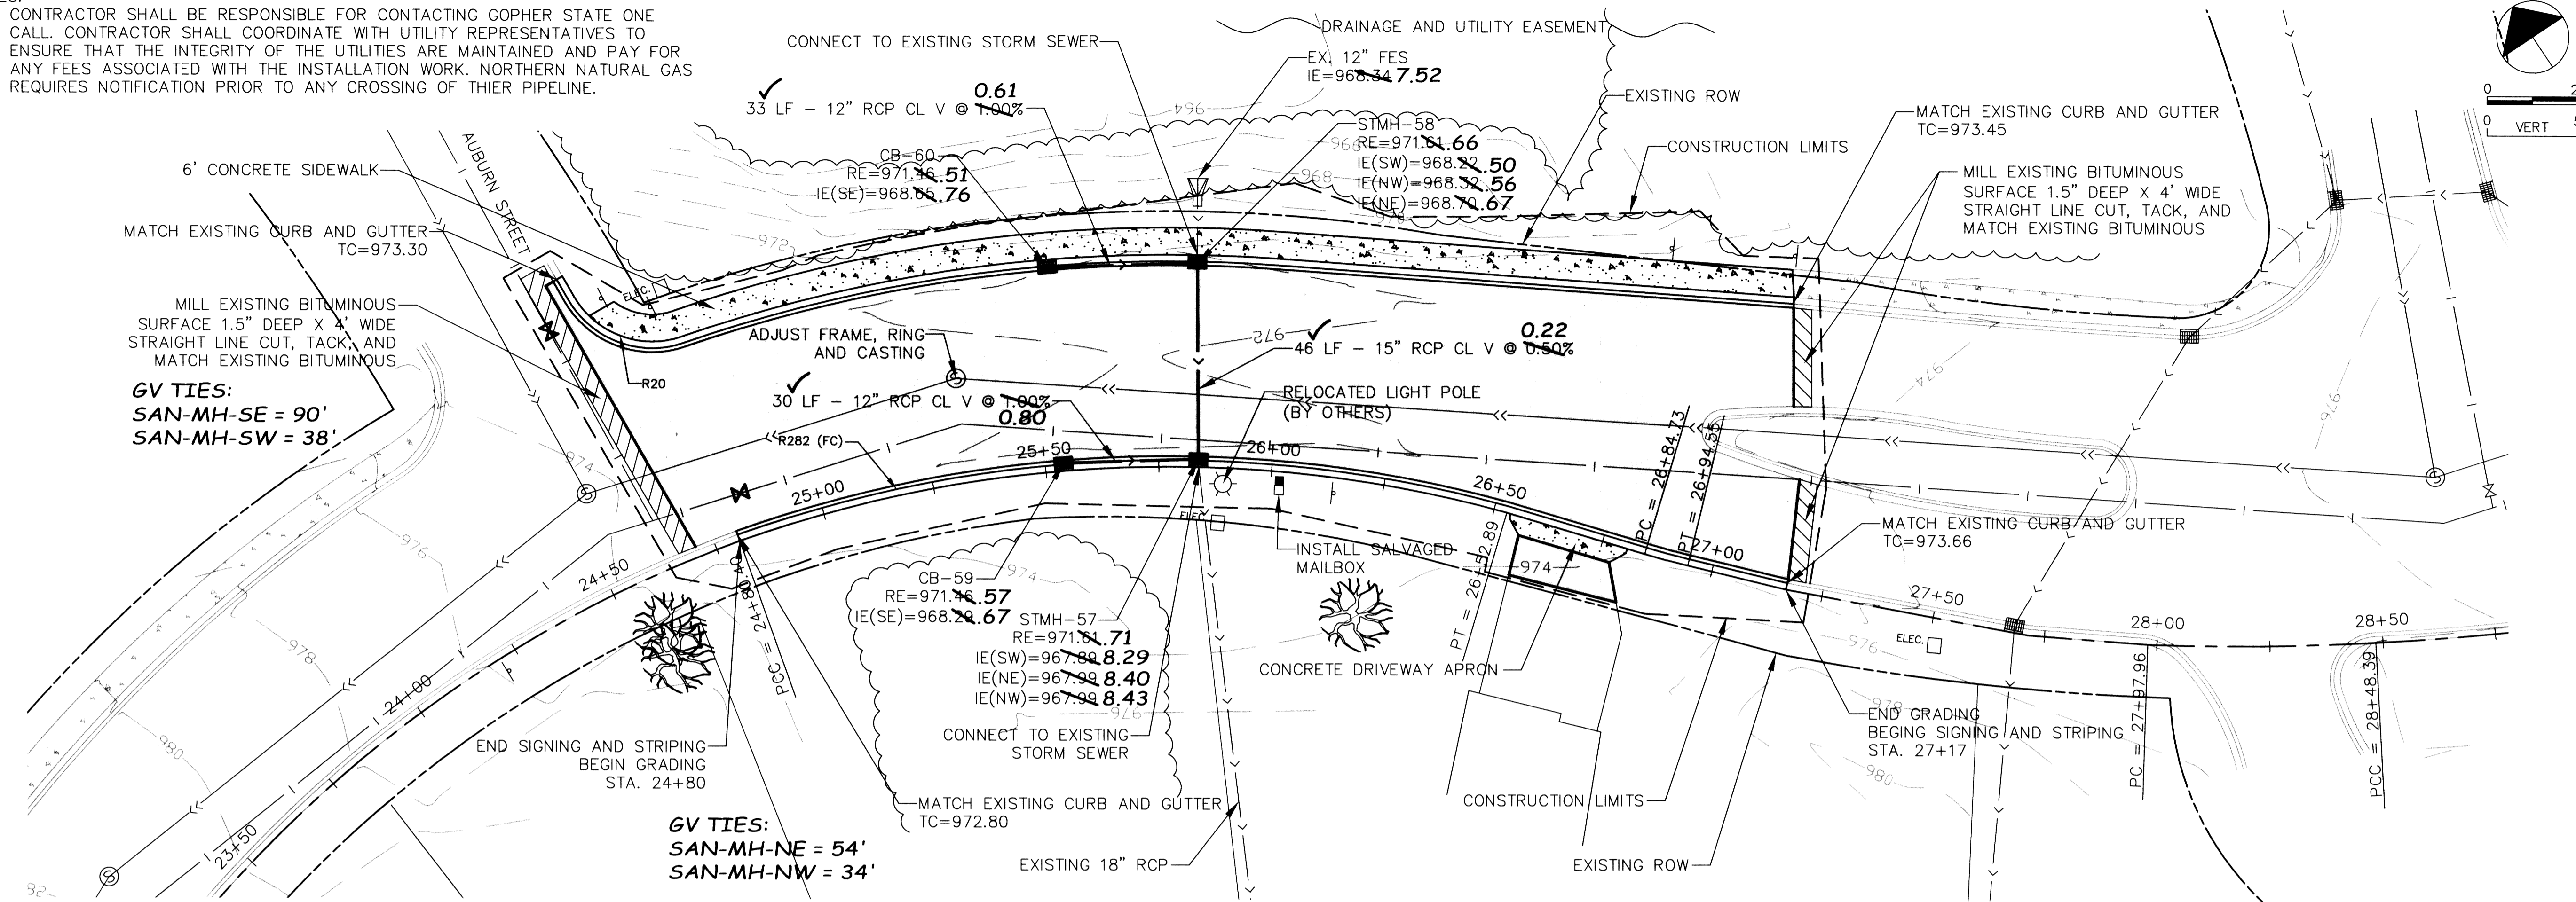

| | | |
|-----------|----------|-------------------|
| REVISIONS | NO. DATE | DESCRIPTION |
| 1 | 1/25/10 | IA RECORD DRAWING |

EVERYBODY CERTIFY THAT THIS PLAN, SPECIFICATION, REPORT AND SUPERVISION BY ME OR UNDER MY DIRECT SUPERVISION AND THAT I AM A DULY LICENSED PROFESSIONAL ENGINEER UNDER THE LAWS OF THE STATE OF MINNESOTA.

Print Name: JOHN M. ANDERSON
 Signature: [Signature]
 Date: 07-31-08 License # 25689

SP 204-104-07

CITY OF ELK RIVER
193RD AVENUE STREET CONSTRUCTION
STREET AND STORM SEWER
193RD AVENUE/AUBURN STREET
RECORD PLAN

23+50 TO 28+50

BDM
 CONSULTING ENGINEERS, PLC
 Engineers and Surveyors
 11040 183rd Circle NW
 Elk River, MN 55330
 Phone: (763) 441-0877
 Fax: (763) 441-7724
 bdnce.com

DRAWN BY: NAB
 CHECKED BY: KJE
 DESIGNED BY: KJE
 JOB NO. 228069D

SHEET **43** SHEETS **146**