
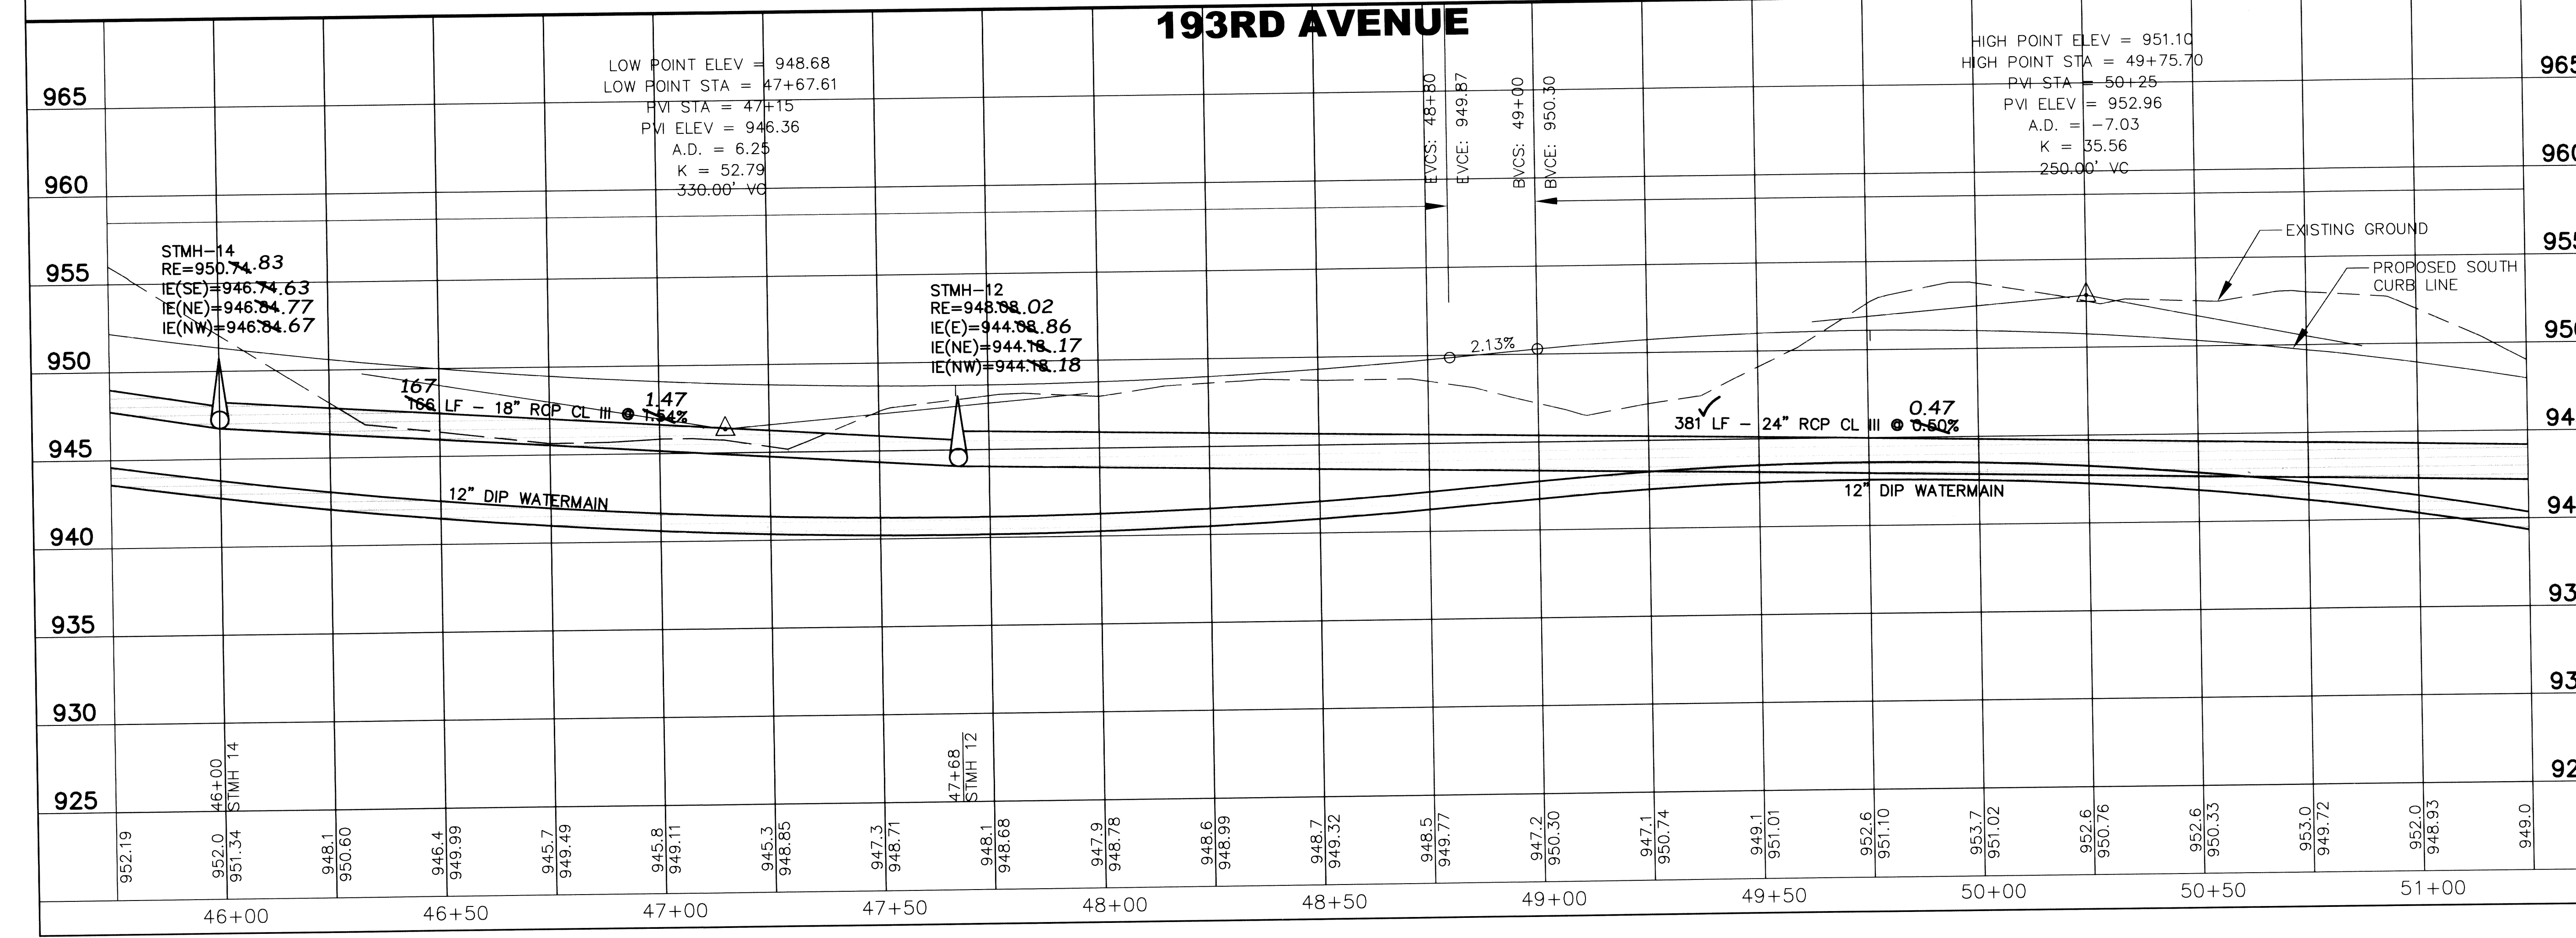


NOTES:
 1. CONTRACTOR SHALL BE RESPONSIBLE FOR CONTACTING GOPHER STATE ONE CALL. CONTRACTOR SHALL COORDINATE WITH UTILITY REPRESENTATIVES TO ENSURE THAT THE INTEGRITY OF THE UTILITIES ARE MAINTAINED AND PAY FOR ANY FEES ASSOCIATED WITH THE INSTALLATION WORK.

NO.	DATE	BY	DESCRIPTION
1	1/25/10	JA	RECORD DRAWING

I HEREBY CERTIFY THAT THIS PLAN, SPECIFICATION OR REPORT WAS PREPARED BY ME OR UNDER MY DIRECT SUPERVISION AND THAT I AM A DULY LICENSED PROFESSIONAL ENGINEER UNDER THE LAWS OF THE STATE OF MINNESOTA.
 Print Name: JOHN M. ANDERSON
 Signature: *[Signature]*
 Date: 07-31-08 License # 25889

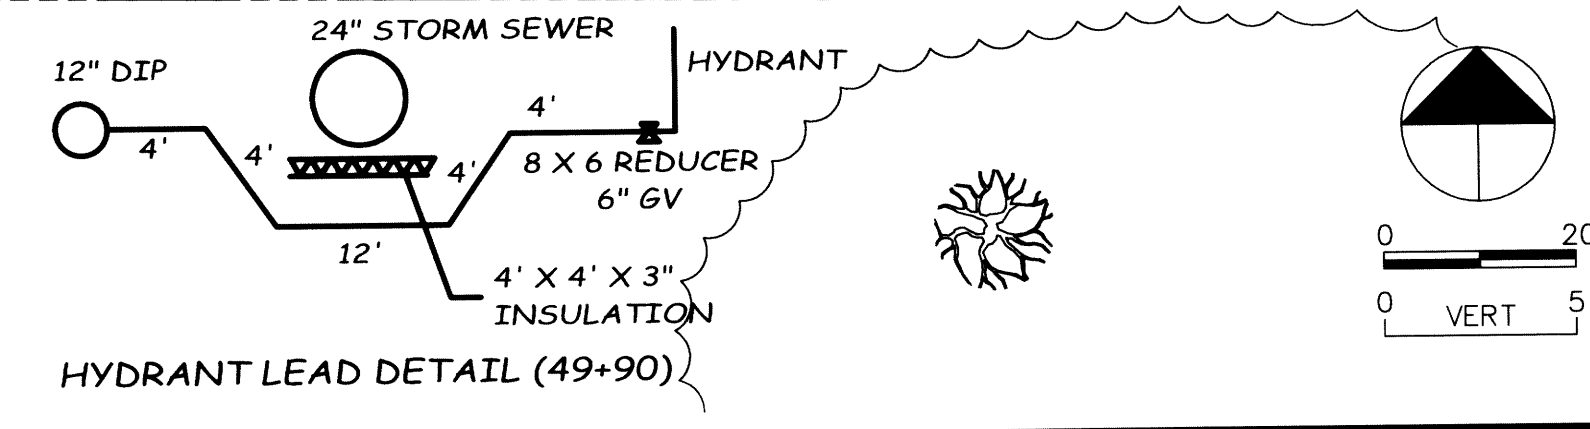

SP 204-104-07
CITY OF ELK RIVER
193RD AVENUE STREET CONSTRUCTION
STREET AND STORM SEWER
193RD AVENUE
RECORD PLAN
 46+00 TO 50+50

BDM
 CONSULTING ENGINEERS, PLC
 Engineers and Surveyors
 11040 183rd Circle NW
 Elk River, MN 55330
 Phone: (763) 441-0877
 Fax: (763) 441-7724
 bdmce.com

DRAWN BY: NAB
 CHECKED BY: KJE
 DESIGNED BY: KJE
 JOB NO. 226069D

SHEET **47** SHEETS **146**