


NO.	DATE	DESCRIPTION
1	1/25/10	JA RECORD DRAWING

I HEREBY CERTIFY THAT THIS PLAN, SPECIFICATION, OR REPORT WAS PREPARED BY ME OR UNDER MY DIRECT SUPERVISION AND THAT I AM A LICENSED PROFESSIONAL ENGINEER UNDER THE LAWS OF THE STATE OF MINNESOTA.

Print Name: JOHN M. ANDERSON
 Signature: *[Signature]*
 Date: 07-31-08 License # 25889

- NOTES:
1. CONTRACTOR SHALL BE RESPONSIBLE FOR CONTACTING GOPHER STATE ONE CALL. CONTRACTOR SHALL COORDINATE WITH UTILITY REPRESENTATIVES TO ENSURE THAT THE INTEGRITY OF THE UTILITIES ARE MAINTAINED AND PAY FOR ANY FEES ASSOCIATED WITH THE INSTALLATION WORK.
 2. ANY BITUMINOUS DAMAGED BEYOND REMOVAL LIMITS ON XAVIER STREET SHALL BE REPLACED BY THE CONTRACTOR TO THE SATISFACTION OF THE ENGINEER IN THE FIELD AT NO ADDITIONAL COST TO THE OWNER.
 3. TO AVOID MULTIPLE TEMPORARY WATER SERVICES, THE CONTRACTOR SHALL CUT IN NEW VALVES BEFORE ANY WATERMAIN REMOVAL BEGINS. THE NEW VALVES SHALL BE INSTALLED OUTSIDE OF THE WATERMAIN REMOVAL LIMITS.

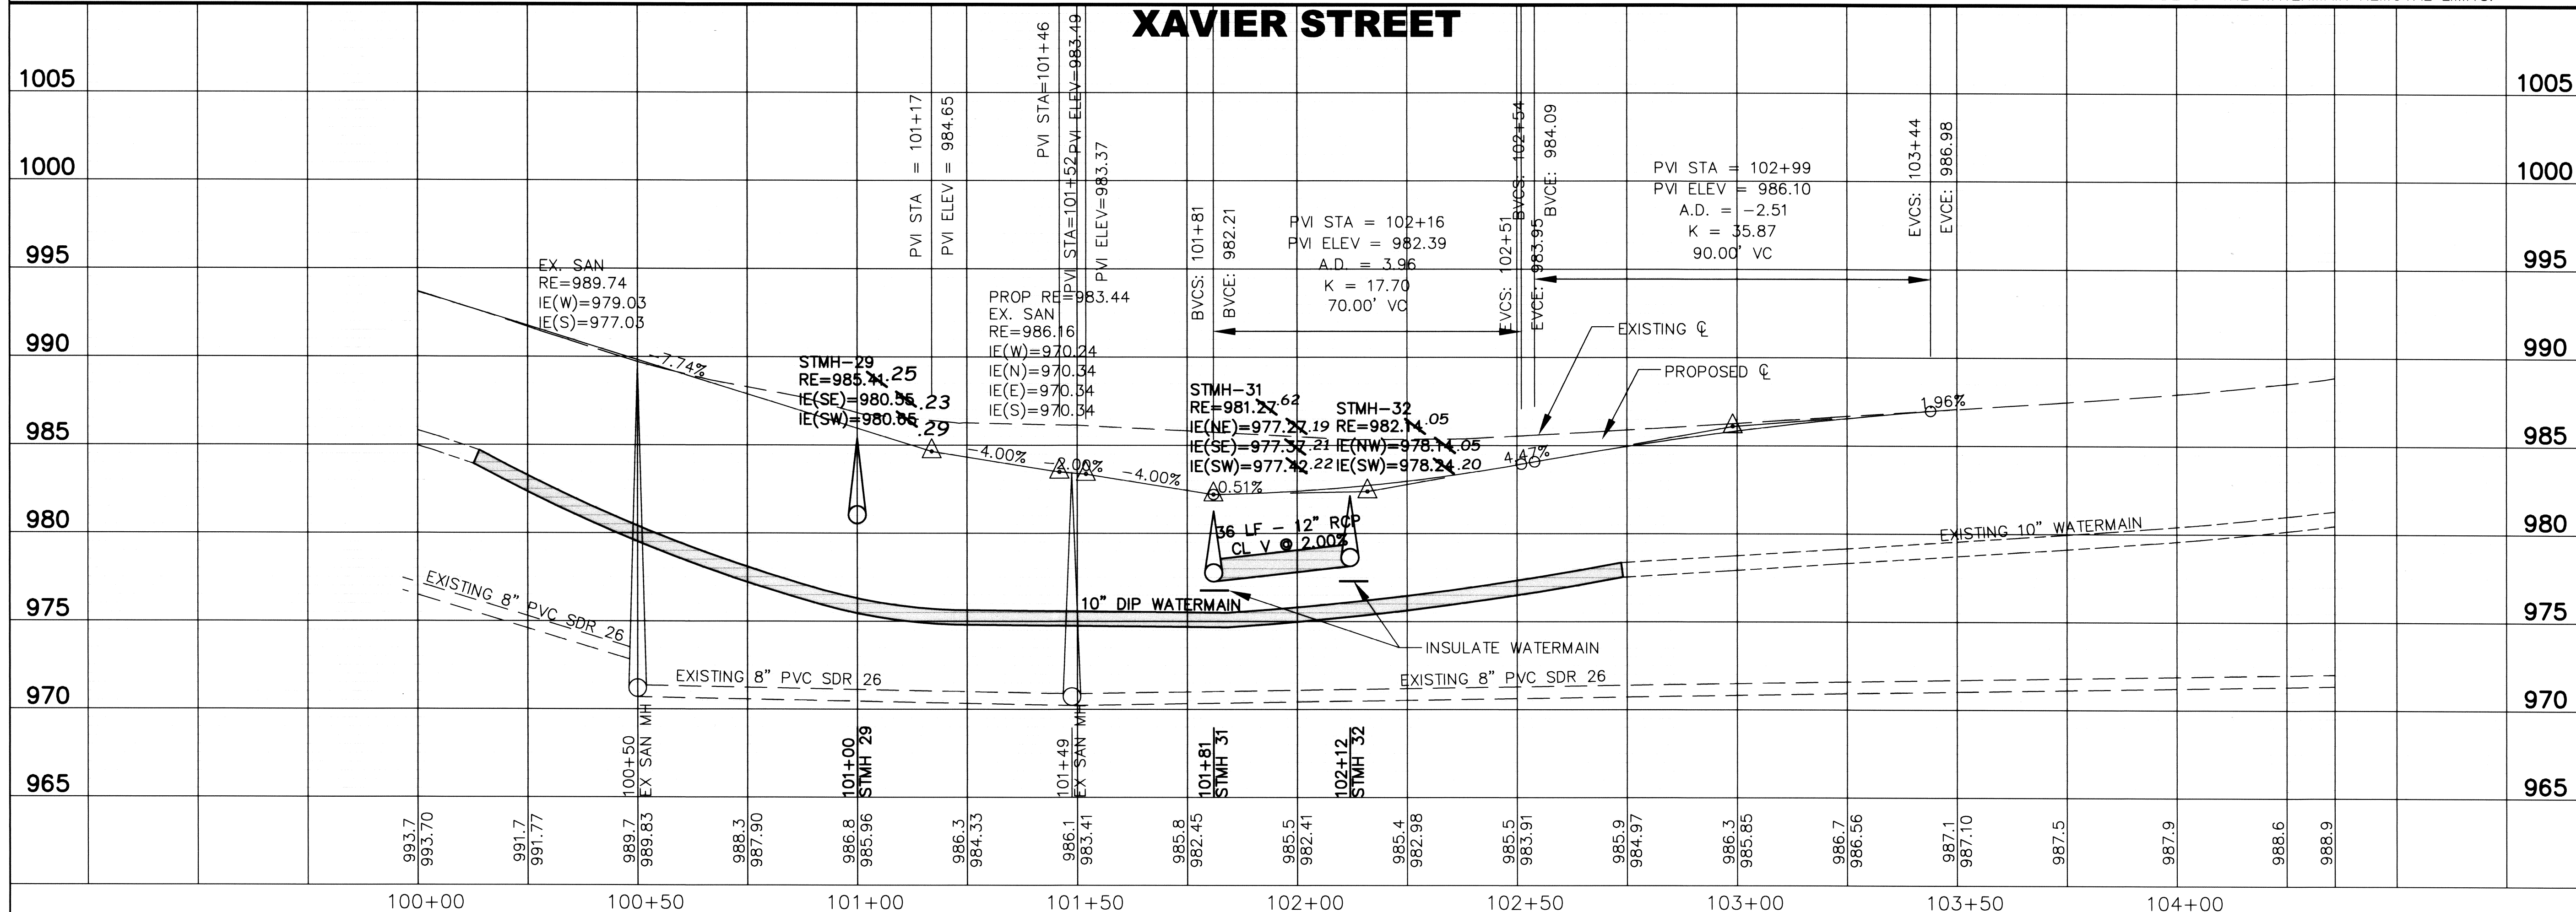

SP 204-104-07

CITY OF ELK RIVER

193RD AVENUE STREET CONSTRUCTION

STREET AND STORM SEWER

XAVIER STREET

100+00 TO 104+36

BDM
 CONSULTING ENGINEERS, PLC
 Engineers and Surveyors
 11040 183rd Circle NW
 Elk River, MN 55330
 Phone: (763) 441-0877
 Fax: (763) 441-7724
 bdmce.com

DRAWN BY: NAB
 CHECKED BY: KJE
 DESIGNED BY: KJE
 JOB NO. 226069D

SHEET **56** SHEETS **146**