
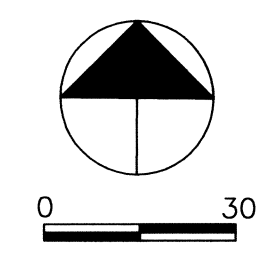


193RD AVENUE

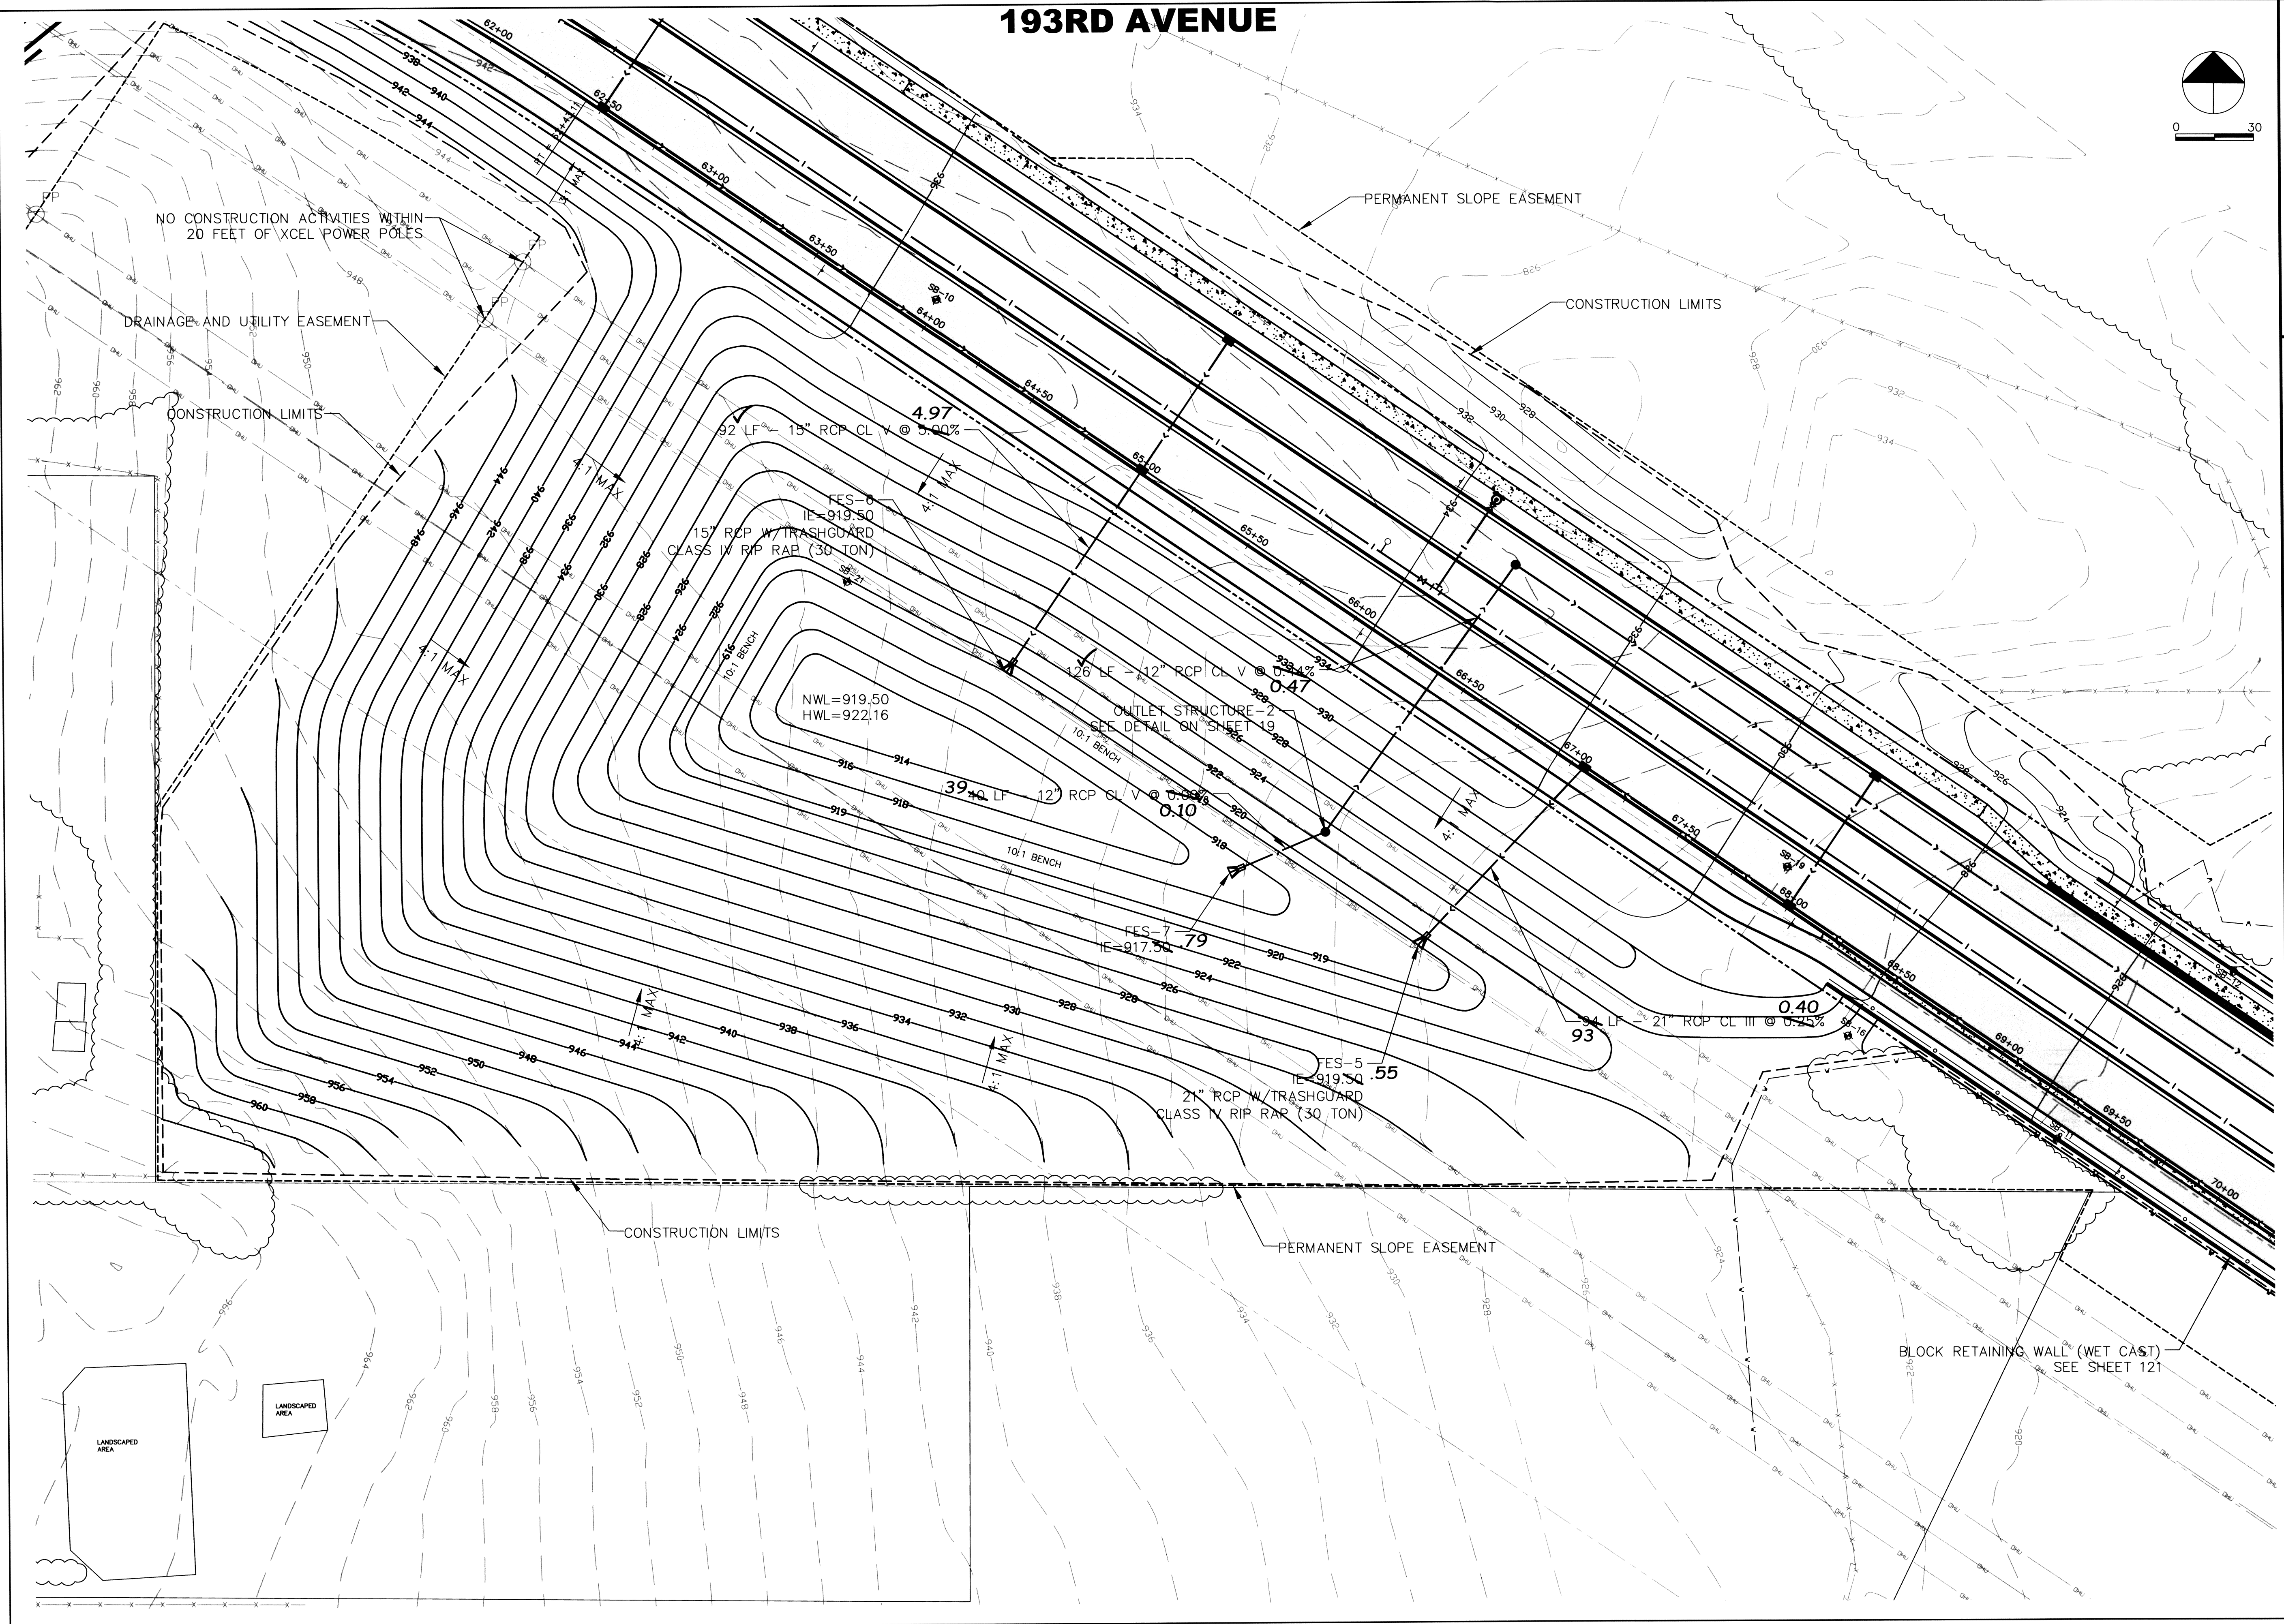

NO.	DATE	BY	DESCRIPTION
1	1/25/10	JA	RECORD DRAWING

I HEREBY CERTIFY THAT THIS PLAN, SPECIFICATION, OR REPORT WAS PREPARED BY ME OR UNDER MY DIRECT SUPERVISION AND THAT I AM A DULY LICENSED PROFESSIONAL ENGINEER UNDER THE LAWS OF THE STATE OF MINNESOTA.
 Print Name: JOHN M. ANDERSON
 Signature: *[Signature]*
 Date: 07-31-08 License # 25889

SP 204-104-07

CITY OF ELK RIVER

193RD AVENUE STREET CONSTRUCTION

GRADING PLAN

EAST STORMWATER TREATMENT POND

RECORD PLAN

BDM
 CONSULTING ENGINEERS, PLC
 Engineers and Surveyors
 11040 183rd Circle NW
 Elk River, MN 55330
 Phone: (763) 441-0877
 Fax: (763) 441-7724
 bdmce.com

DRAWN BY: NAB
 CHECKED BY: KJE
 DESIGNED BY: KJE
 JOB NO. 226069D