
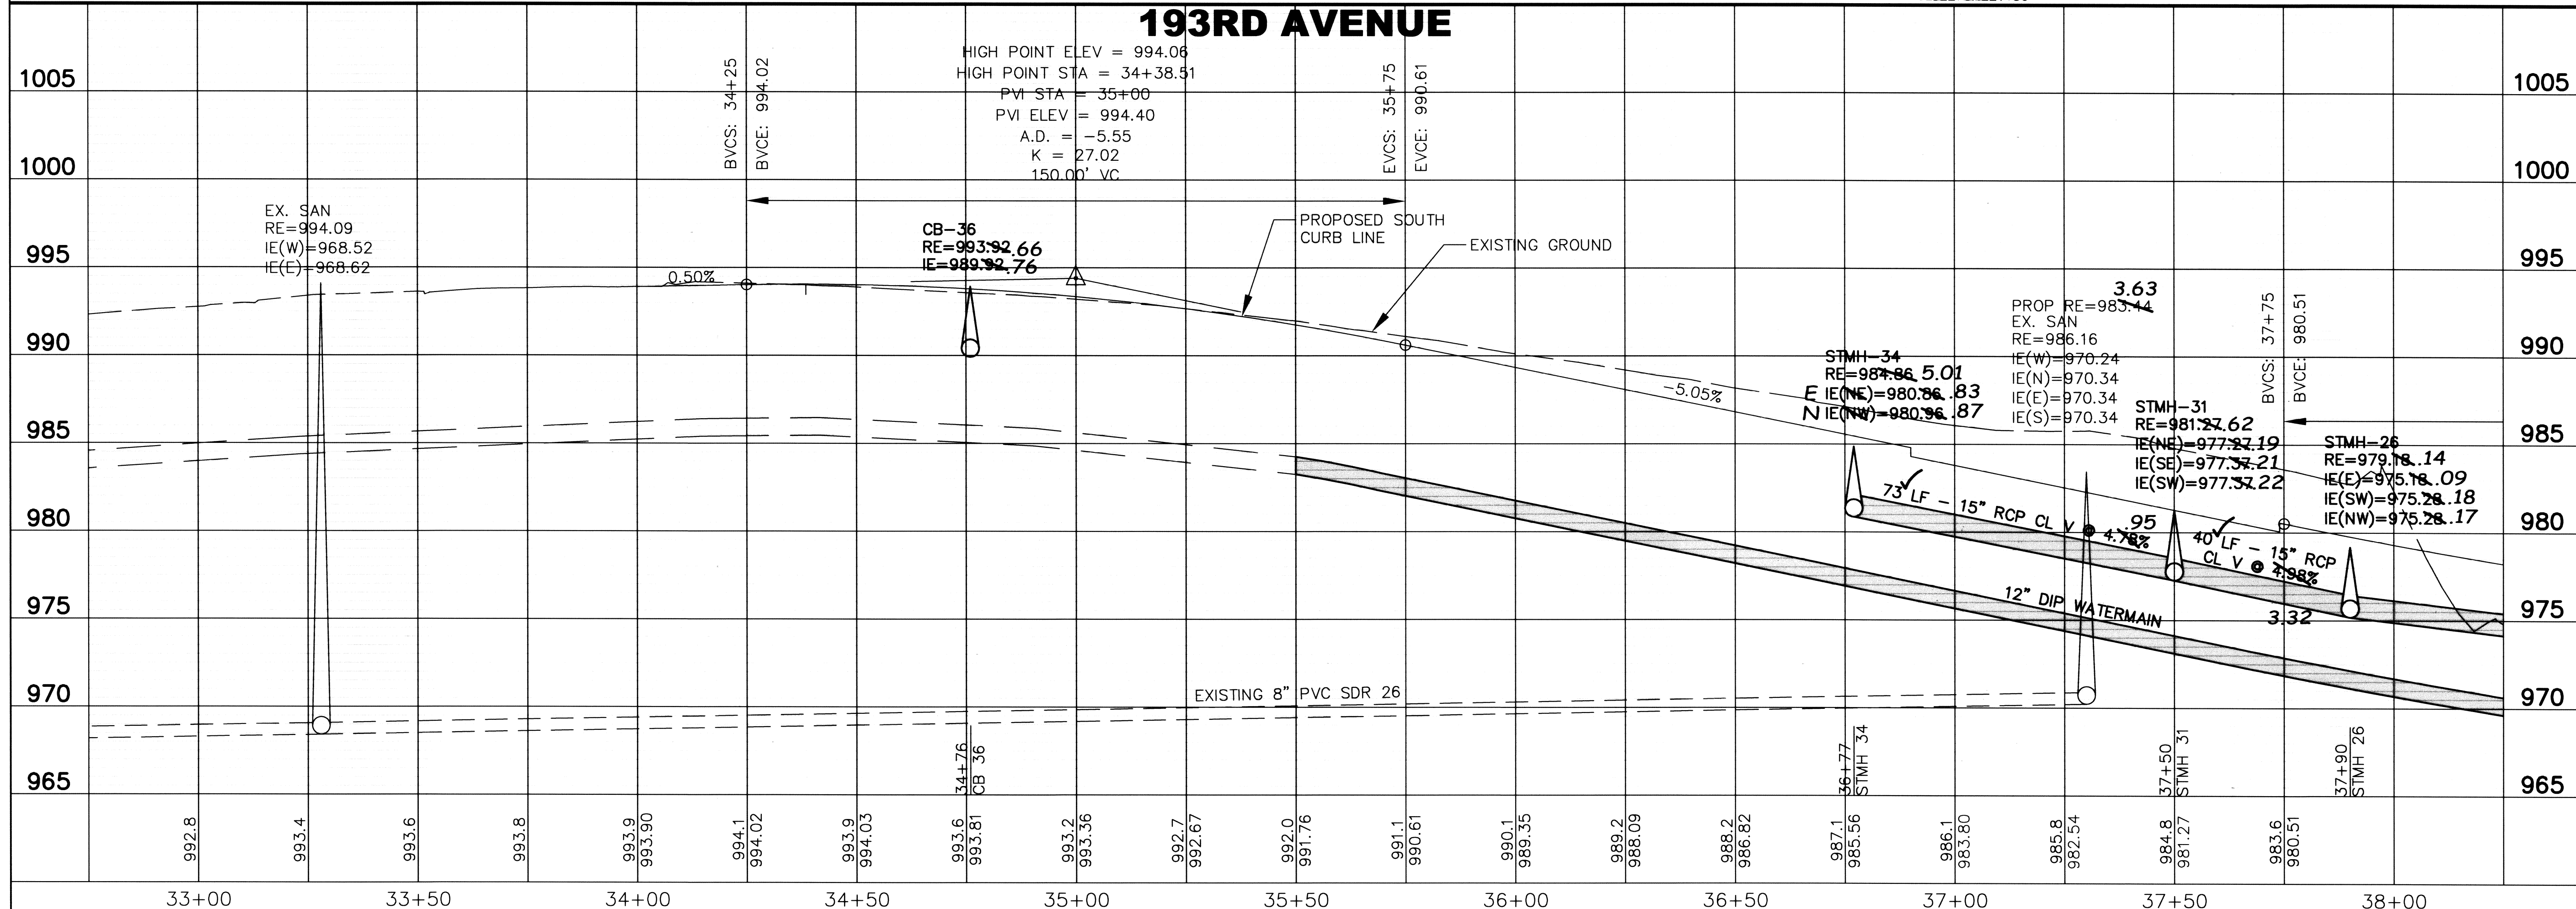


- NOTES:
- CONTRACTOR SHALL BE RESPONSIBLE FOR CONTACTING GOPHER STATE ONE CALL. CONTRACTOR SHALL COORDINATE WITH UTILITY REPRESENTATIVES TO ENSURE THAT THE INTEGRITY OF THE UTILITIES ARE MAINTAINED AND PAY FOR ANY FEES ASSOCIATED WITH THE INSTALLATION WORK.
 - TO AVOID MULTIPLE TEMPORARY WATER SERVICES, THE CONTRACTOR SHALL CUT IN NEW VALVES BEFORE ANY WATERMAIN REMOVAL BEGINS. THE NEW VALVES SHALL BE INSTALLED OUTSIDE OF THE WATERMAIN REMOVAL LIMITS.

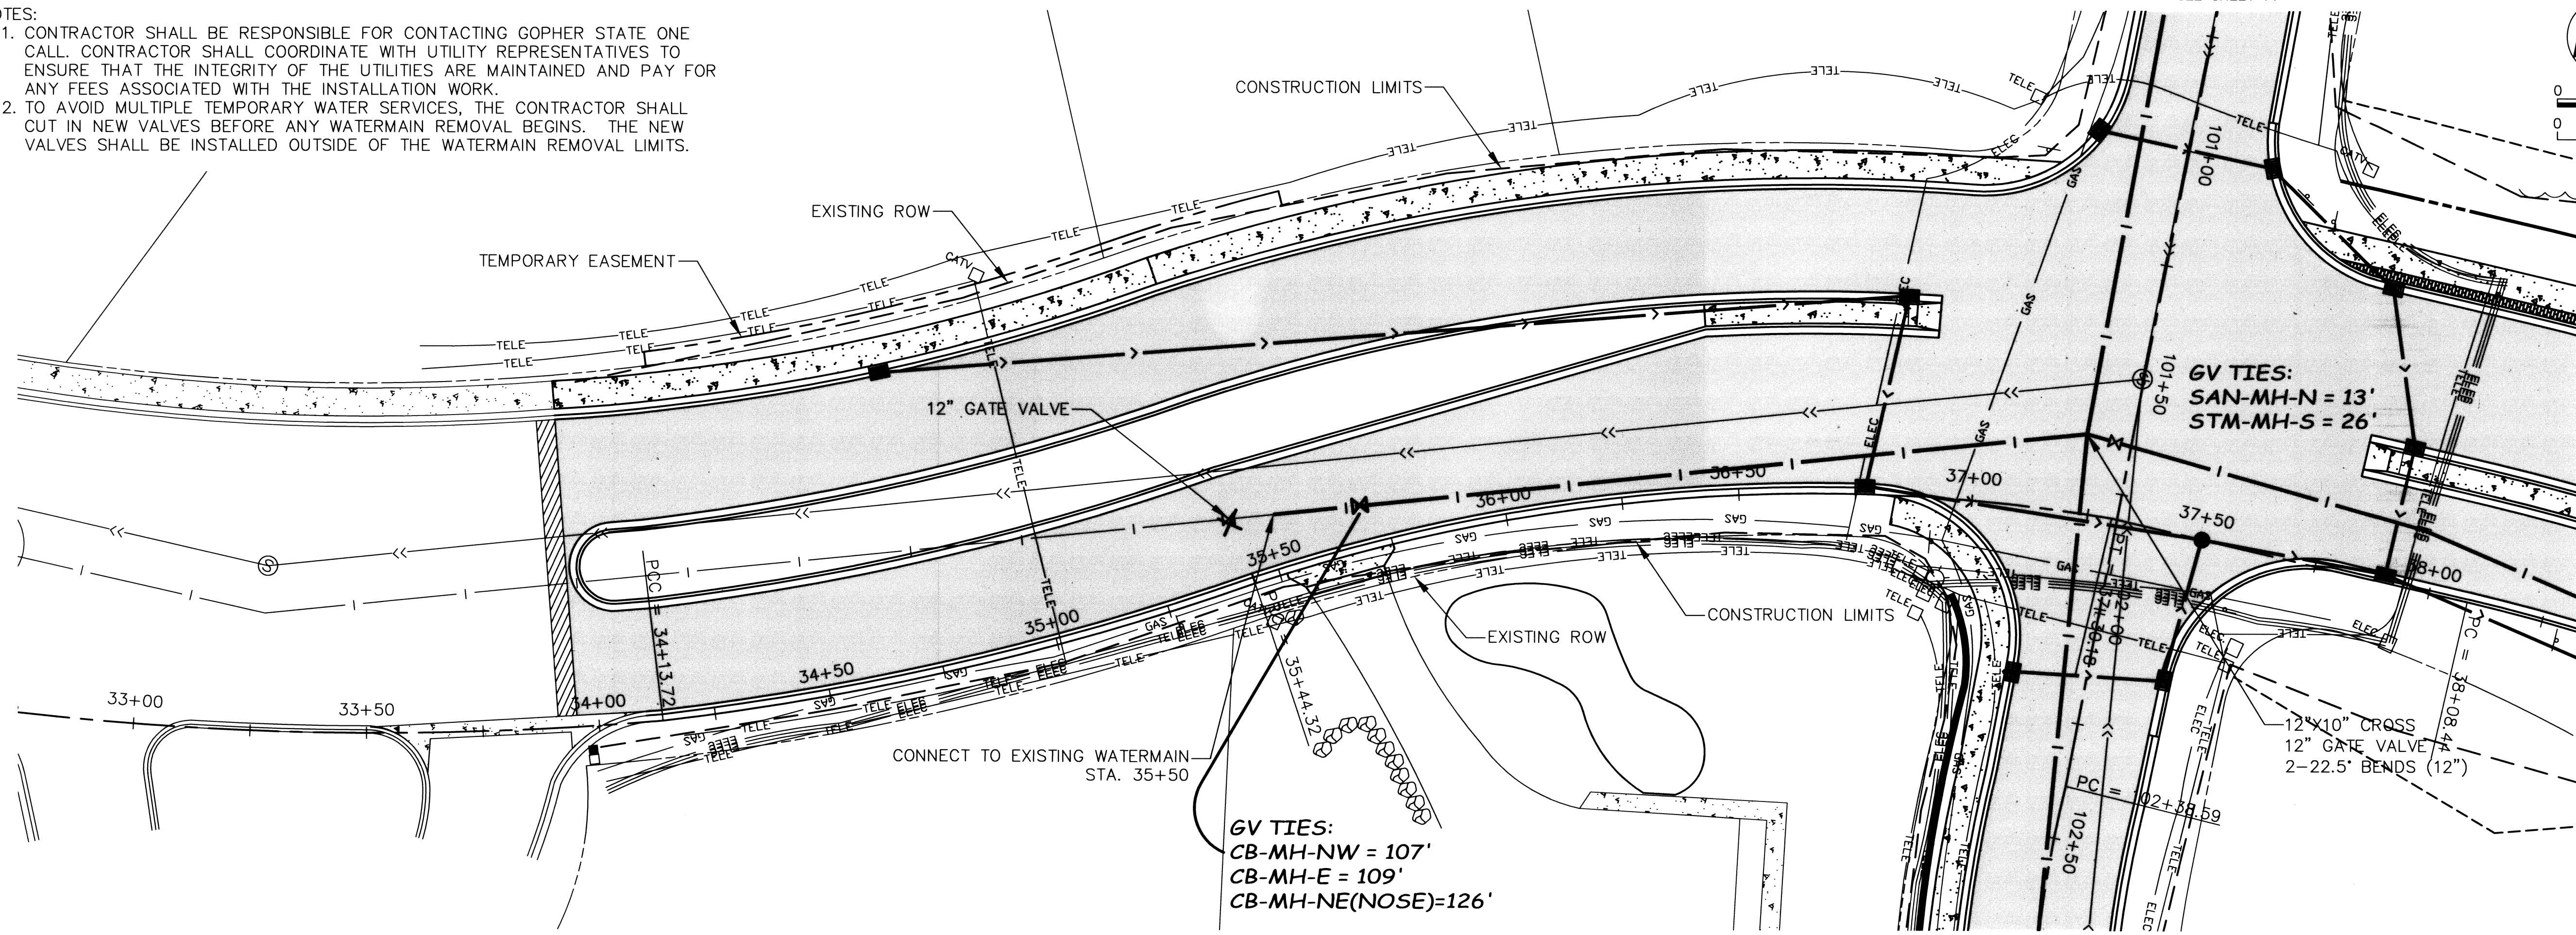

SEE SHEET 77

0 20
0 5
VERT

SEE SHEET 68

SEE SHEET 77
SEE SHEET 7756

SP 204-104-07

CITY OF ELK RIVER

193RD AVENUE STREET CONSTRUCTION

WATERMAIN

193RD AVENUE

RECORD PLAN

33+00 TO 38+00

REVISIONS

| NO. | DATE | DESCRIPTION |
|-----|---------|-------------------|
| 1 | 1/25/10 | IA RECORD DRAWING |

I HEREBY CERTIFY THAT THIS PLAN, SPECIFICATIONS, AND PREPARED BY ME OR UNDER MY DIRECT SUPERVISION AND THAT I AM A DULY LICENSED PROFESSIONAL ENGINEER UNDER THE LAWS OF THE STATE OF MINNESOTA.

Print Name: JOHN M. ANDERSON
Signature: *[Signature]*
Date: 07-31-08 License # 25889

DRAWN BY: NAB
CHECKED BY: KJE
DESIGNED BY: KJE
JOB NO. 226069D

SHEET **67** SHEETS **146**