
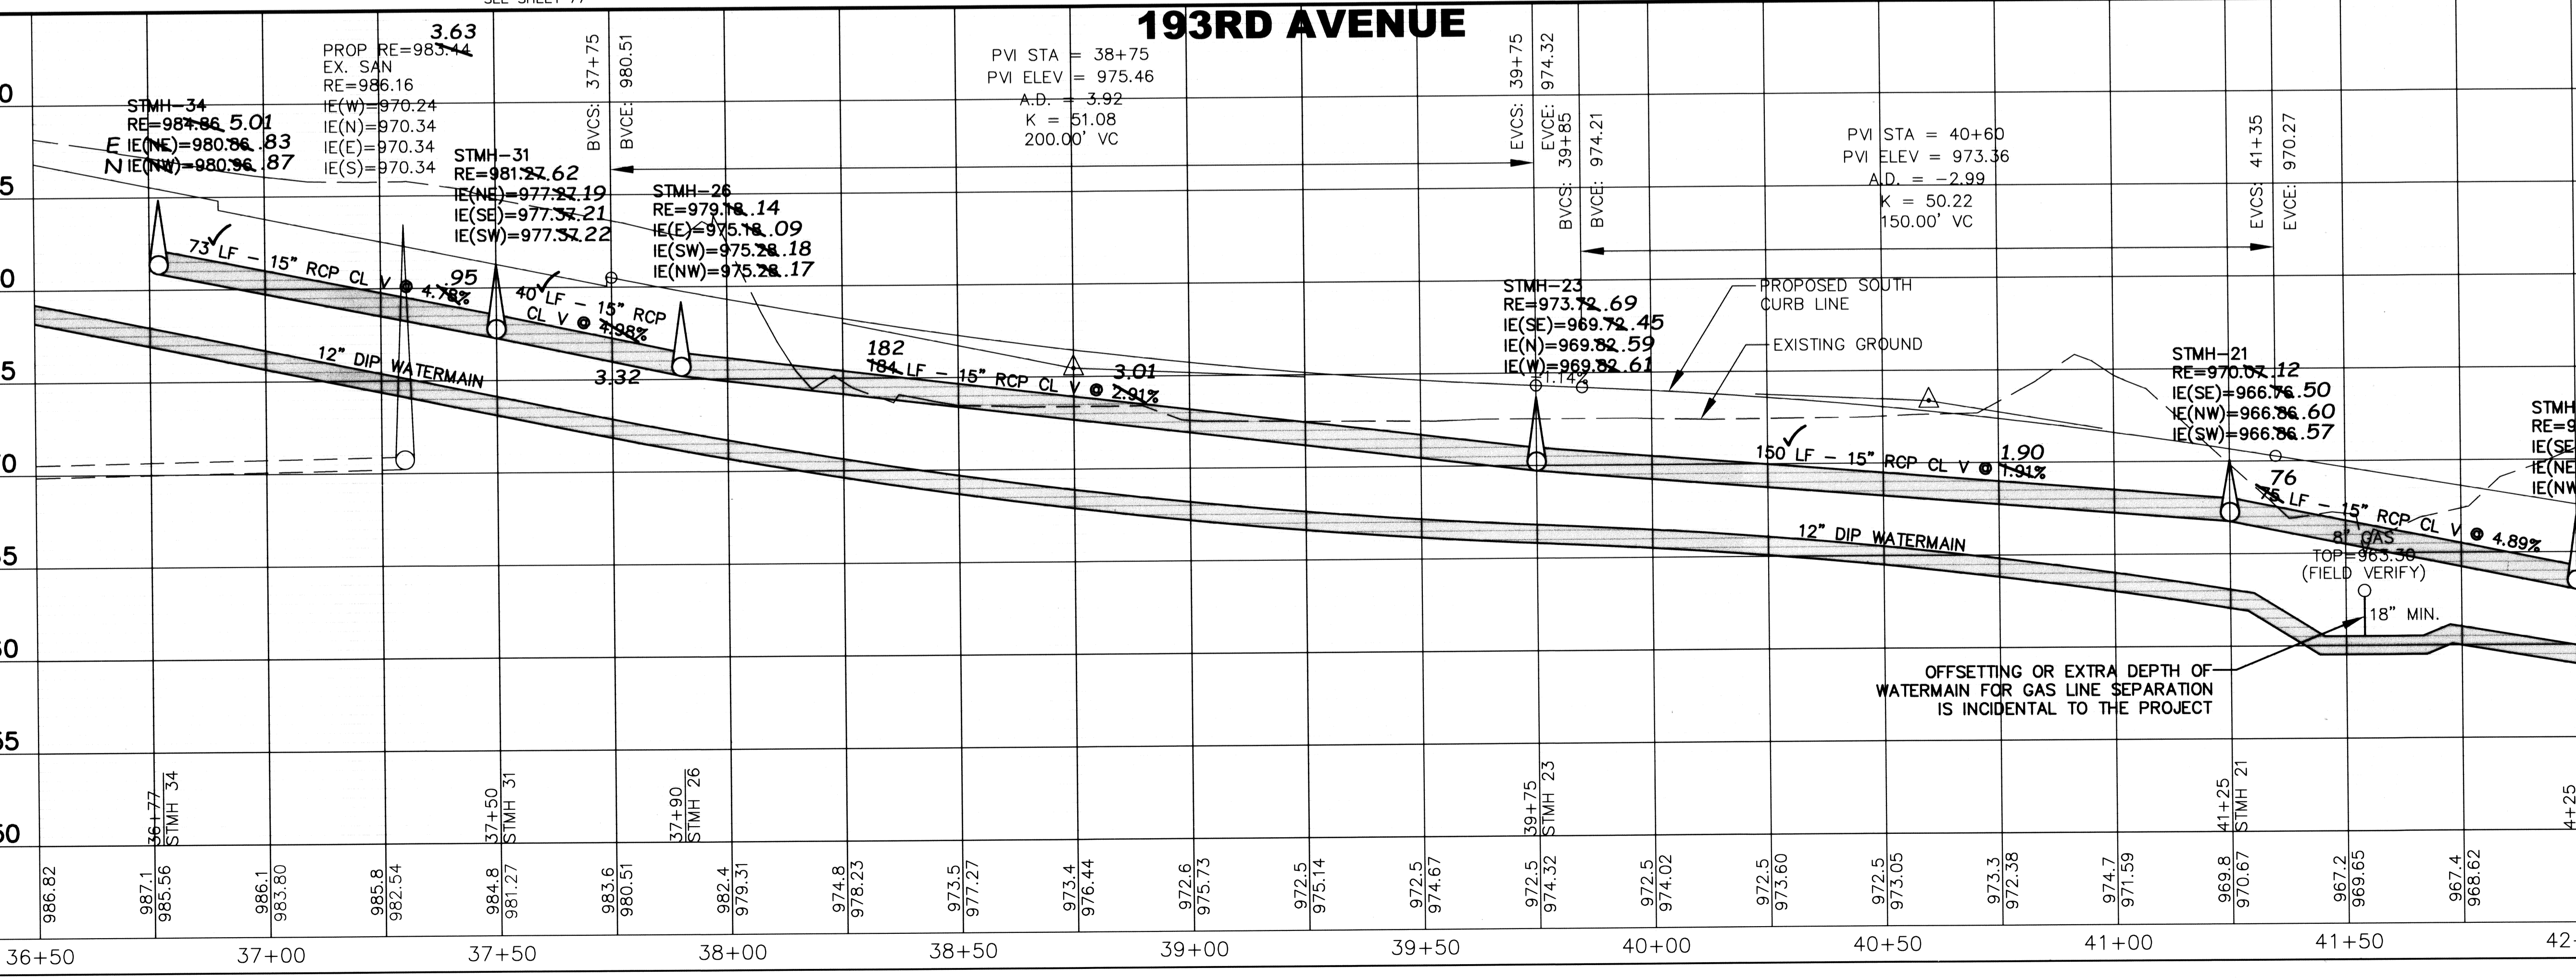
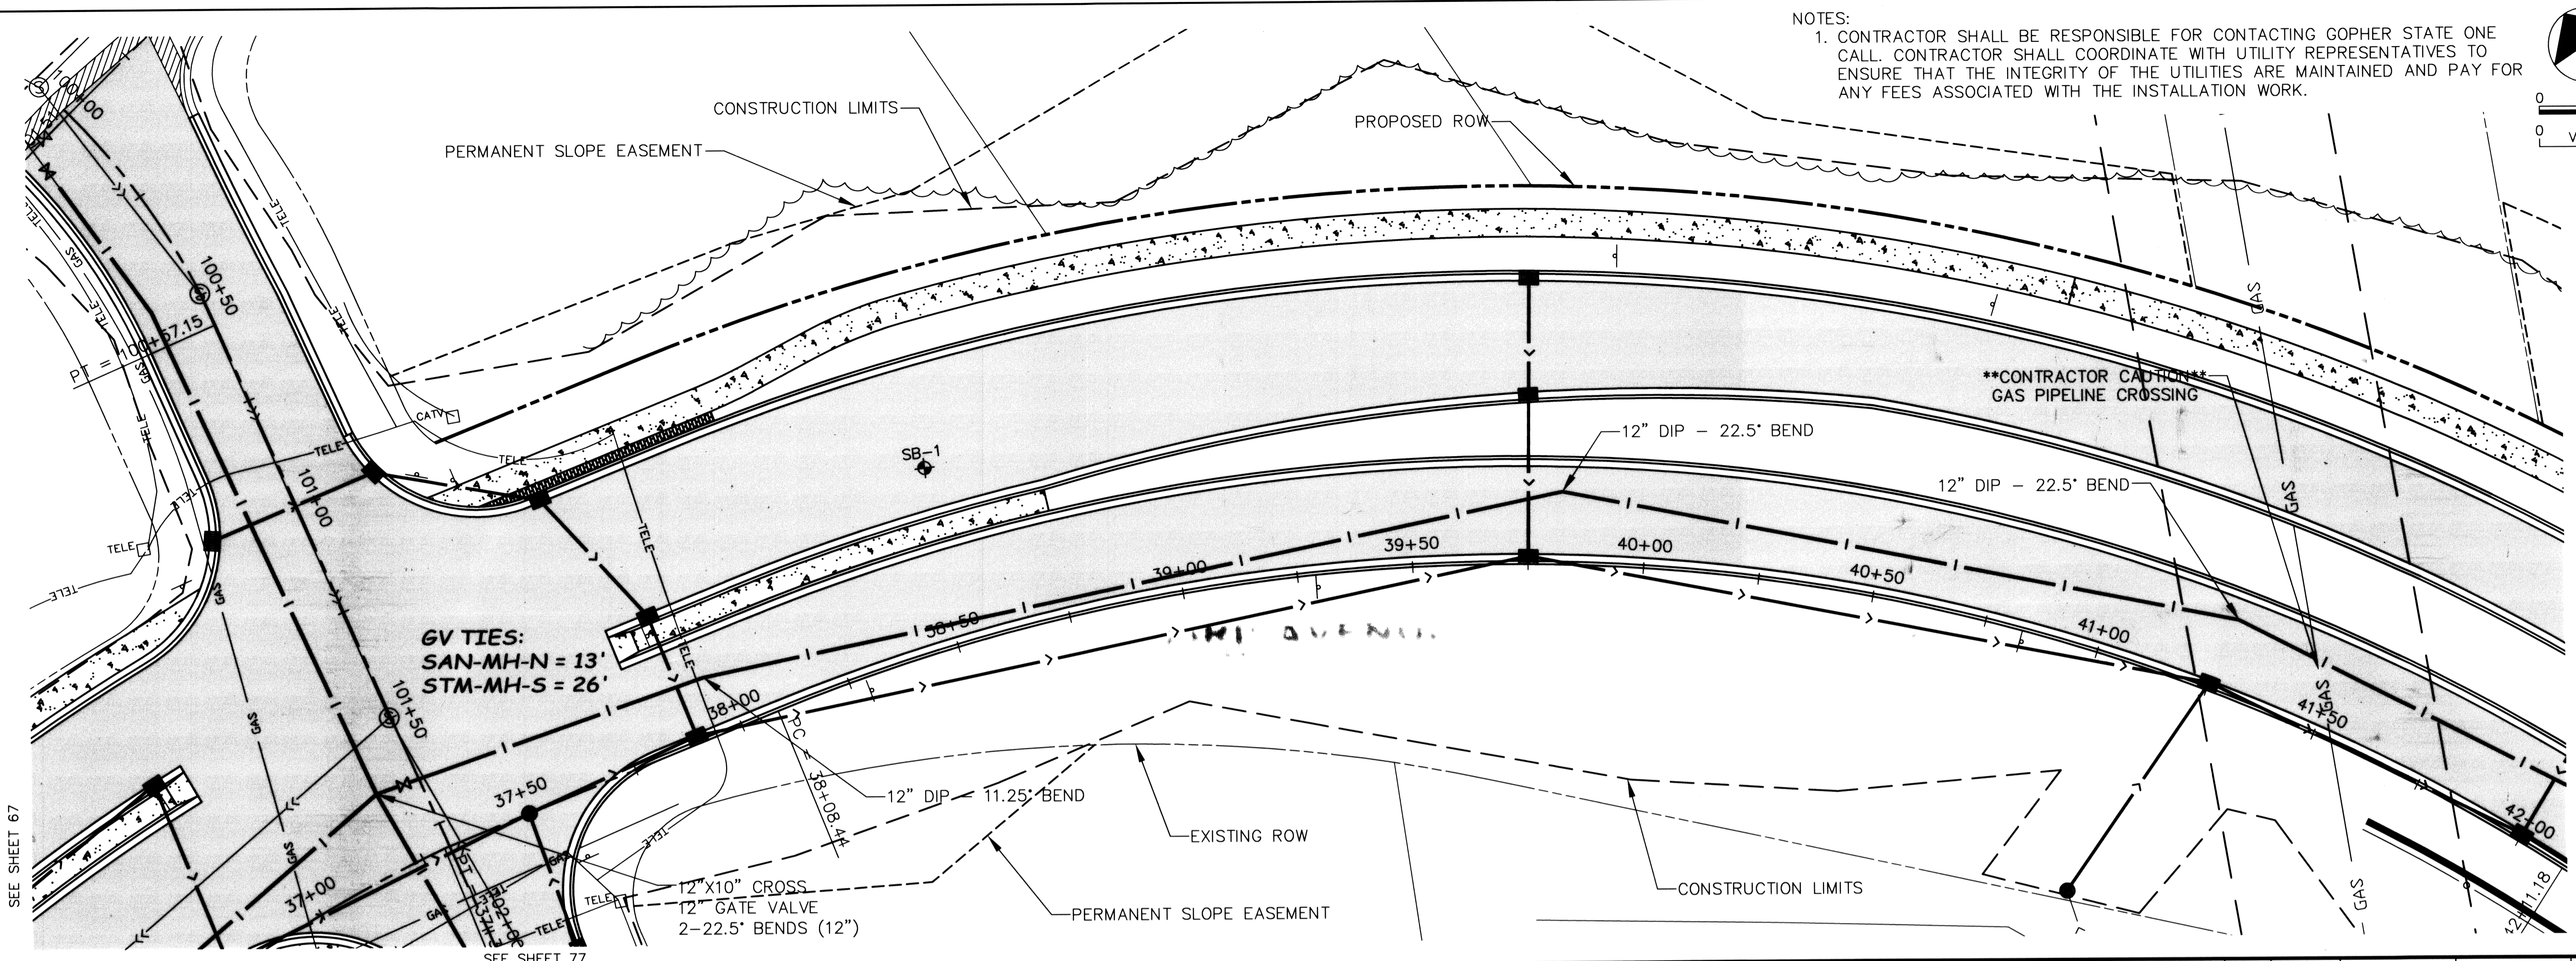


NOTES:
 1. CONTRACTOR SHALL BE RESPONSIBLE FOR CONTACTING GOPHER STATE ONE CALL. CONTRACTOR SHALL COORDINATE WITH UTILITY REPRESENTATIVES TO ENSURE THAT THE INTEGRITY OF THE UTILITIES ARE MAINTAINED AND PAY FOR ANY FEES ASSOCIATED WITH THE INSTALLATION WORK.

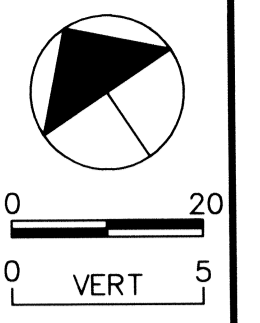

SEE SHEET 69

SEE SHEET 67

SEE SHEET 77

REVISIONS	NO.	DATE	BY	DESCRIPTION
	1	1/25/10	JA	RECORD DRAWING

I HEREBY CERTIFY THAT THIS PLAN SPECIFICATION OR REPORT WAS PREPARED BY ME OR UNDER MY DIRECT SUPERVISION AND THAT I AM A DULY LICENSED PROFESSIONAL ENGINEER UNDER THE LAWS OF THE STATE OF MINNESOTA.

SP 204-104-07

CITY OF ELK RIVER
 193RD AVENUE STREET CONSTRUCTION

CONSULTING
 Engineer
 11040
 Elk R
 Phone:
 Fax:

DRAWN
CHECKED
DESIGN
JOB NO.

SHEET
68