
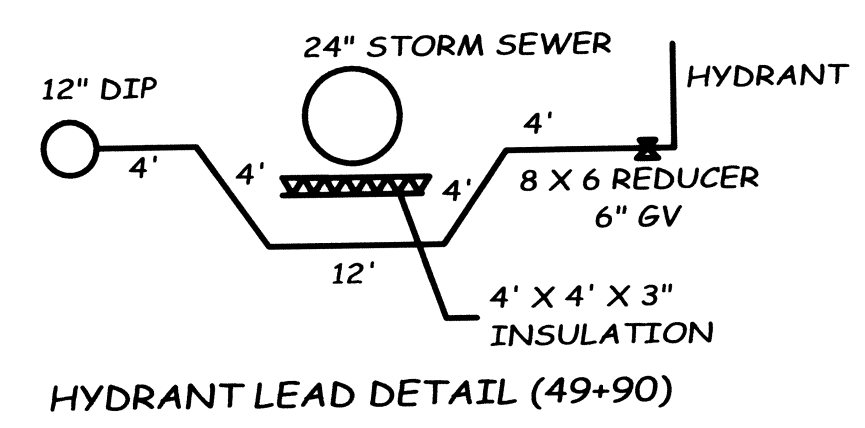


SEE SHEET 69

NOTES:  
1. CONTRACTOR SHALL BE RESPONSIBLE FOR CONTACTING GOPHER STATE ONE CALL. CONTRACTOR SHALL COORDINATE WITH UTILITY REPRESENTATIVES TO ENSURE THAT THE INTEGRITY OF THE UTILITIES ARE MAINTAINED AND PAY FOR ANY FEES ASSOCIATED WITH THE INSTALLATION WORK.

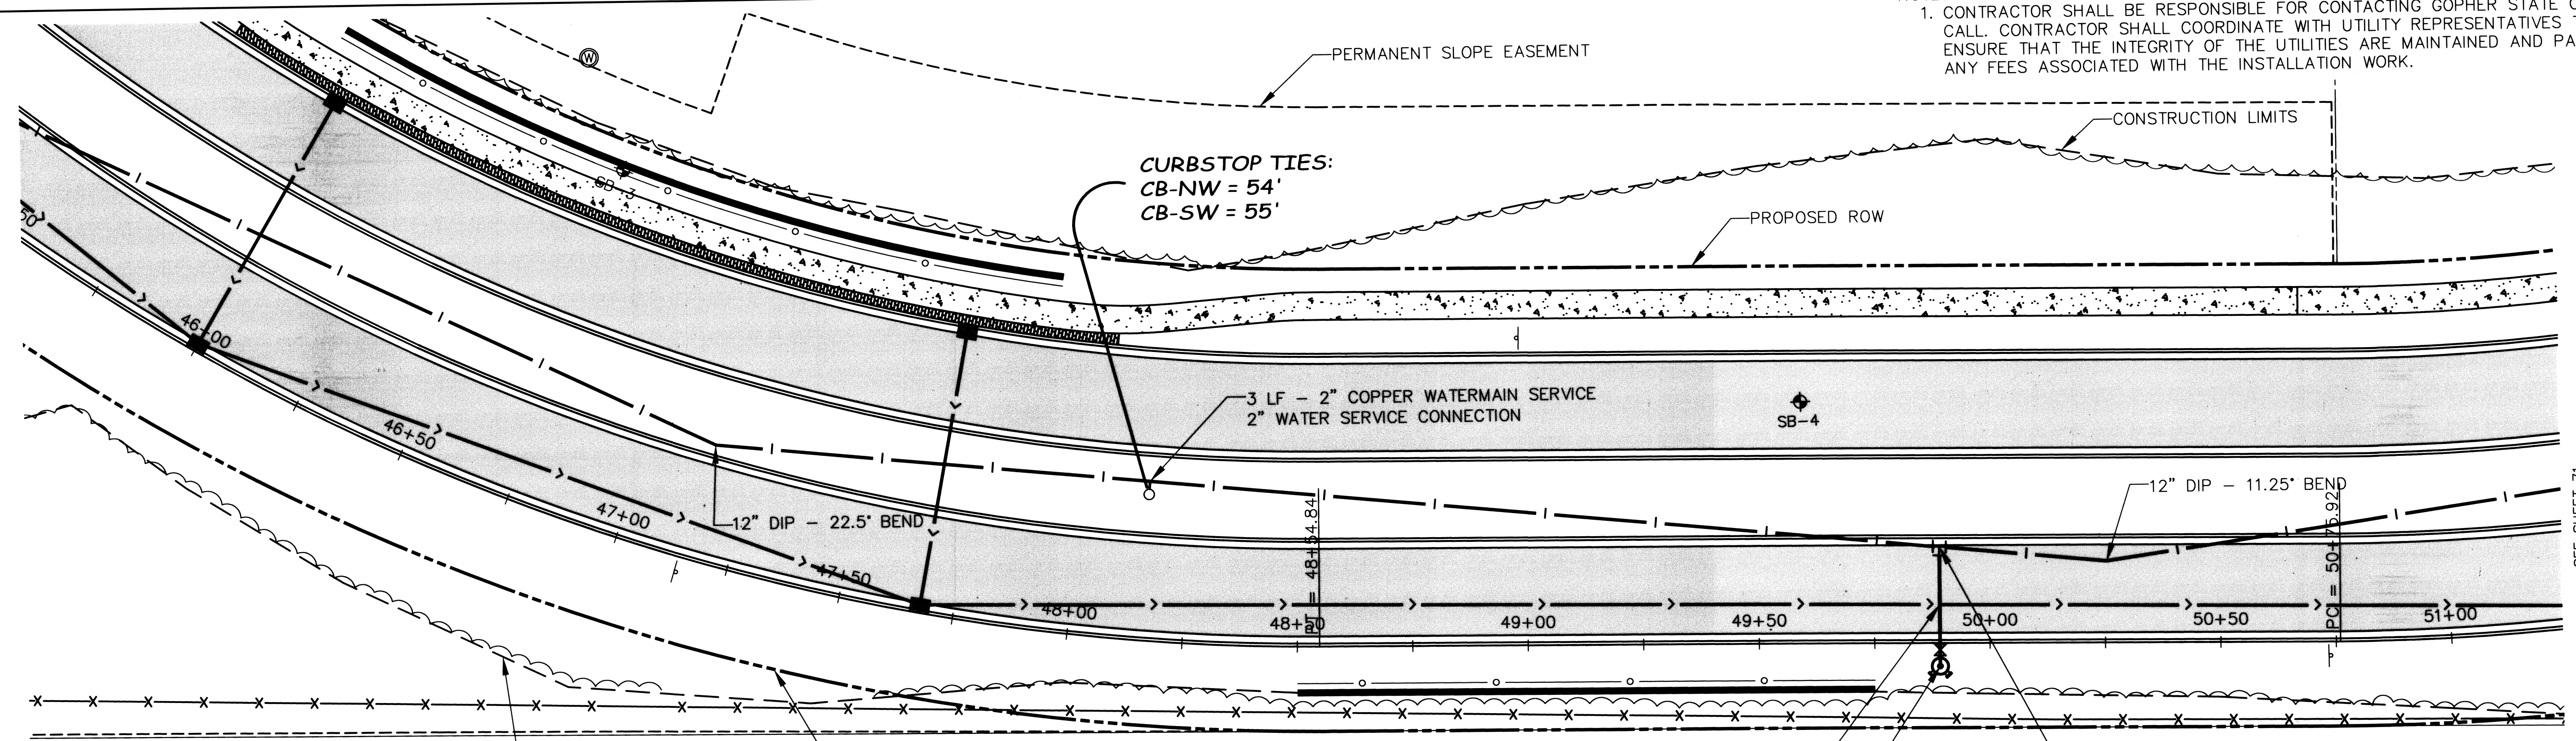


HEREBY CERTIFY THAT THIS PLAN SPECIFIC TO THE PROJECT WAS PREPARED BY ME OR UNDER MY DIRECT SUPERVISION AND THAT I AM A DULY LICENSED PROFESSIONAL ENGINEER UNDER THE LAWS OF THE STATE OF MINNESOTA.  
Print Name: JOHN M. ANDERSON  
Signature: [Signature]  
Date: 07-31-08 License # 25889

SP 204-104-07

**CITY OF ELK RIVER**  
**193RD AVENUE STREET CONSTRUCTION**  
**WATERMAIN**  
**193RD AVENUE**  
**RECORD PLAN**

46+00 TO 51+00

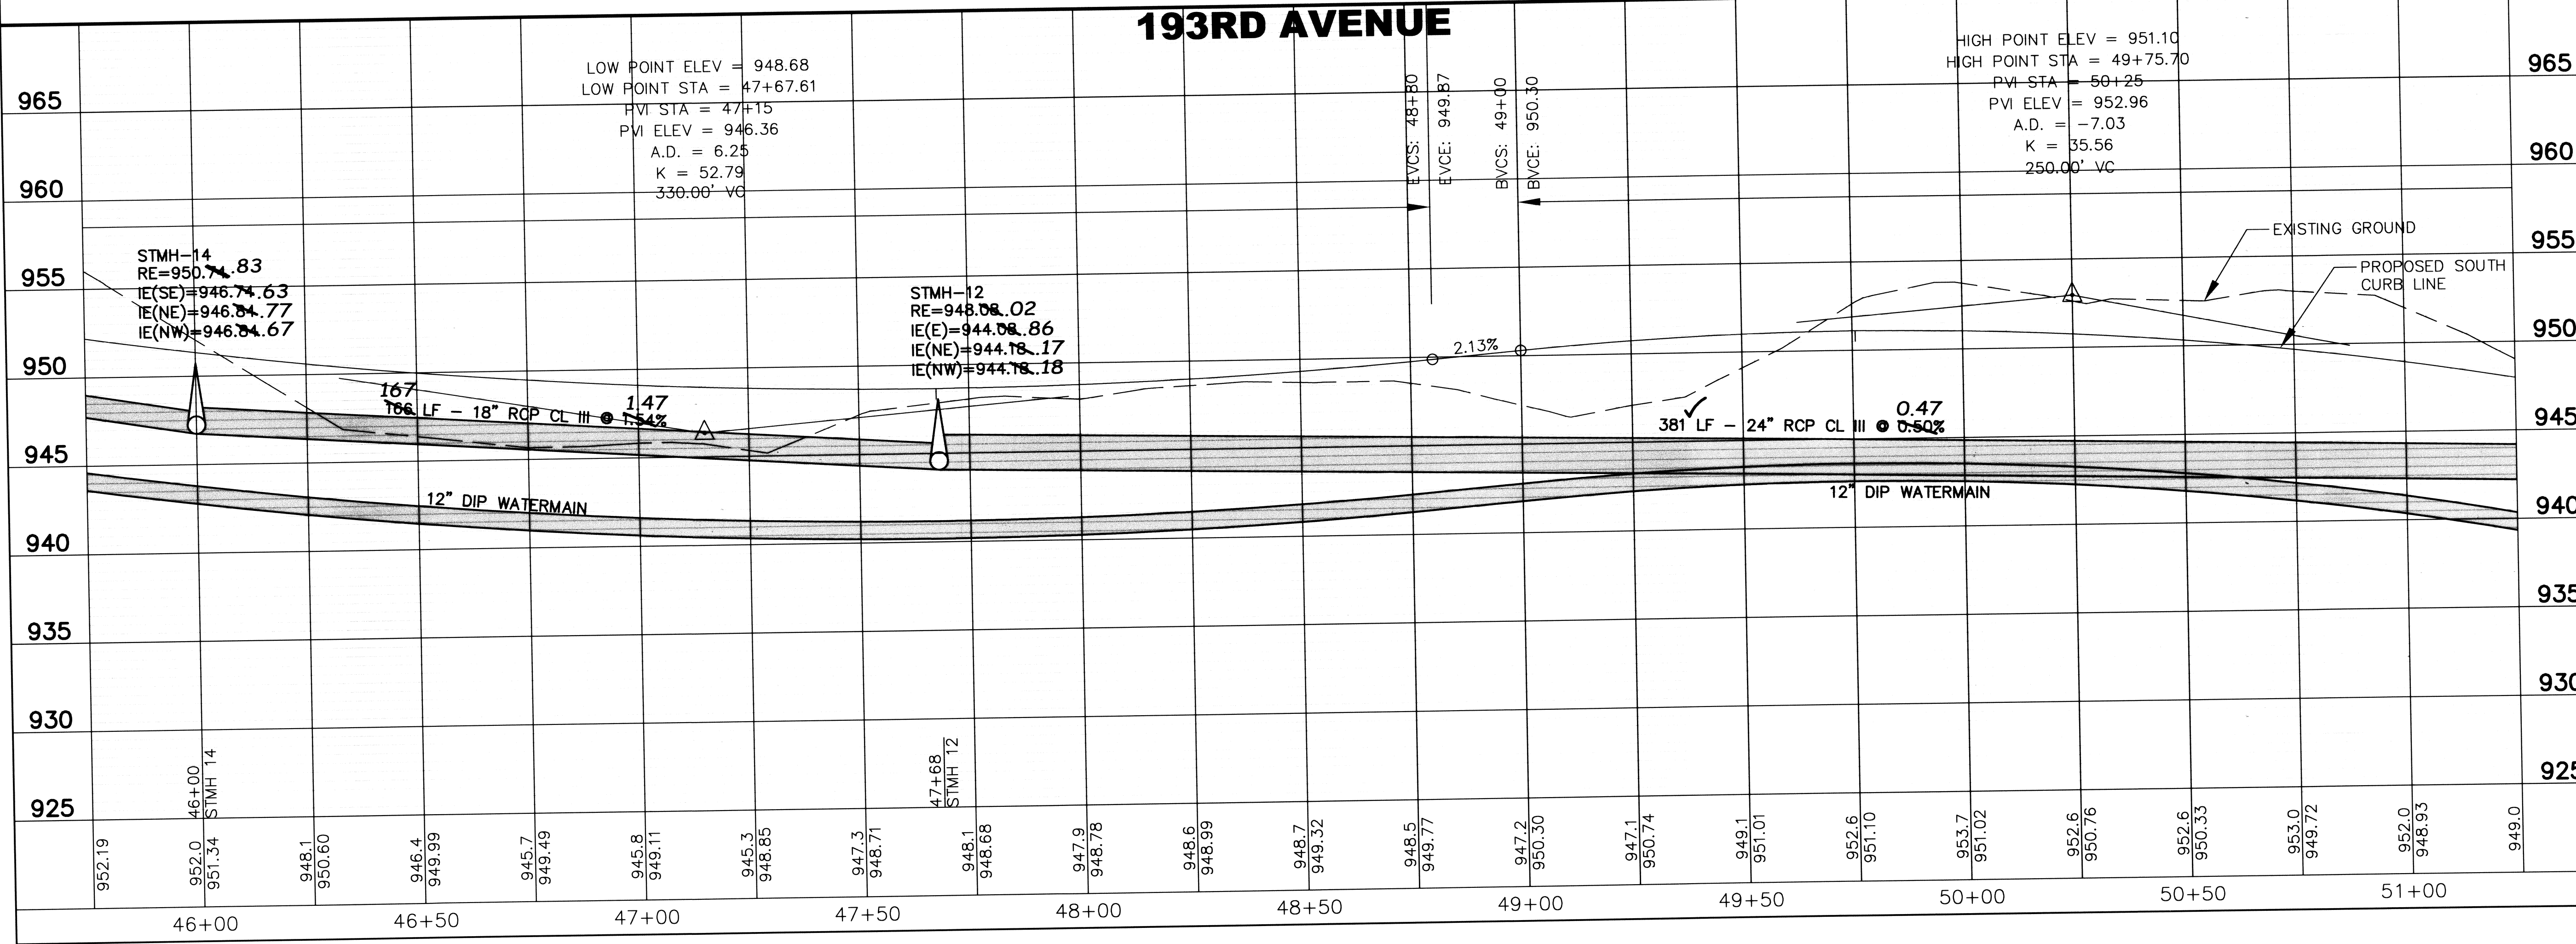

**BDM**  
CONSULTING ENGINEERS, PLC  
Engineers and Surveyors  
11040 183rd Circle NW  
Elk River, MN 55330  
Phone: (763) 441-0877  
Fax: (763) 441-7724  
bdmce.com

DRAWN BY: NAB  
CHECKED BY: KJE  
DESIGNED BY: KJE  
JOB NO. 226069D