



NOTES:

1. ALL STREET RADII SHALL BE 20' UNLESS NOTED OTHERWISE.
2. ALL STATIONING REFERS TO CENTERLINE OF R.O.W.
3. SOD AND SEED BOULEVARD AS DIRECTED BY THE ENGINEER IN THE FIELD.
4. POWER AND TELEPHONE RELOCATION SHALL BE COORDINATED BETWEEN THE CONTRACTOR AND THE PROPER UTILITY COMPANY.
5. ALL STORM SEWER CASTINGS SHALL BE NEENAH R-3067V, UNLESS NOTED OTHERWISE.
6. CLEAR AND GRUB TREES AS NECESSARY TO CONSTRUCT 5' WIDE CONCRETE SIDEWALK AND STORM SEWER INSTALLATION AS DIRECTED BY THE ENGINEER IN THE FIELD.
7. REMOVE AND RELOCATE SIGNS AS NECESSARY TO CONSTRUCT STREETS, AS DIRECTED BY THE ENGINEER IN THE FIELD.
8. SAW CUT EXISTING CONCRETE DRIVEWAYS AS NECESSARY. SAW CUTTING SHALL BE CONSIDERED INCIDENTAL TO CONCRETE DRIVEWAY RESTORATION.

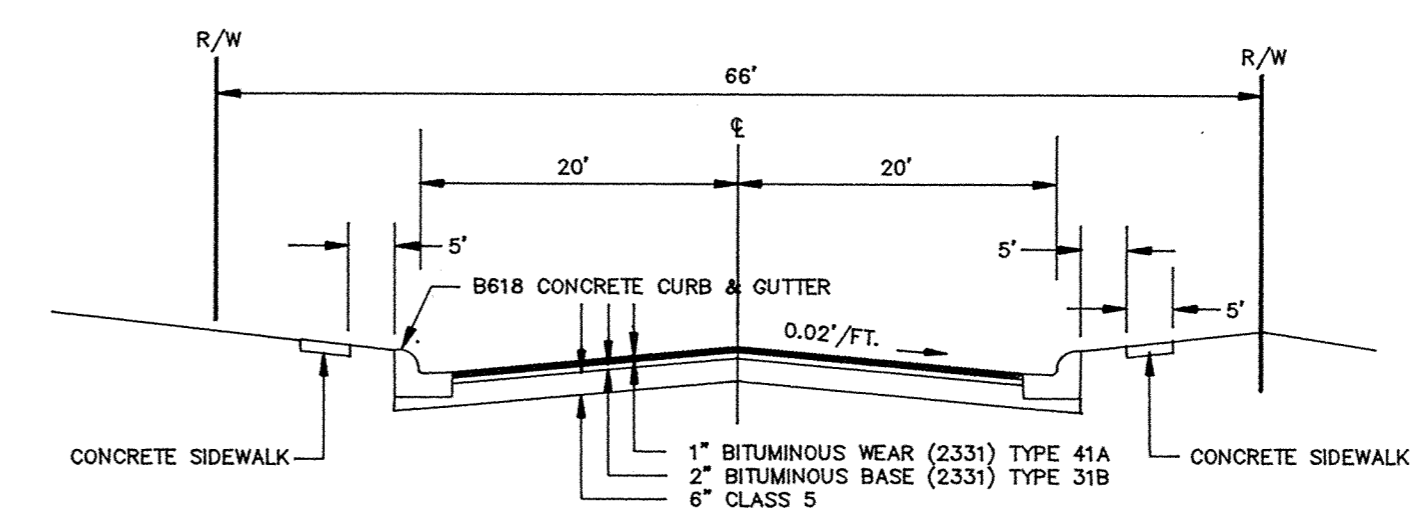

TYPICAL STREET SECTION
4TH STREET FROM HOLT TO GATES

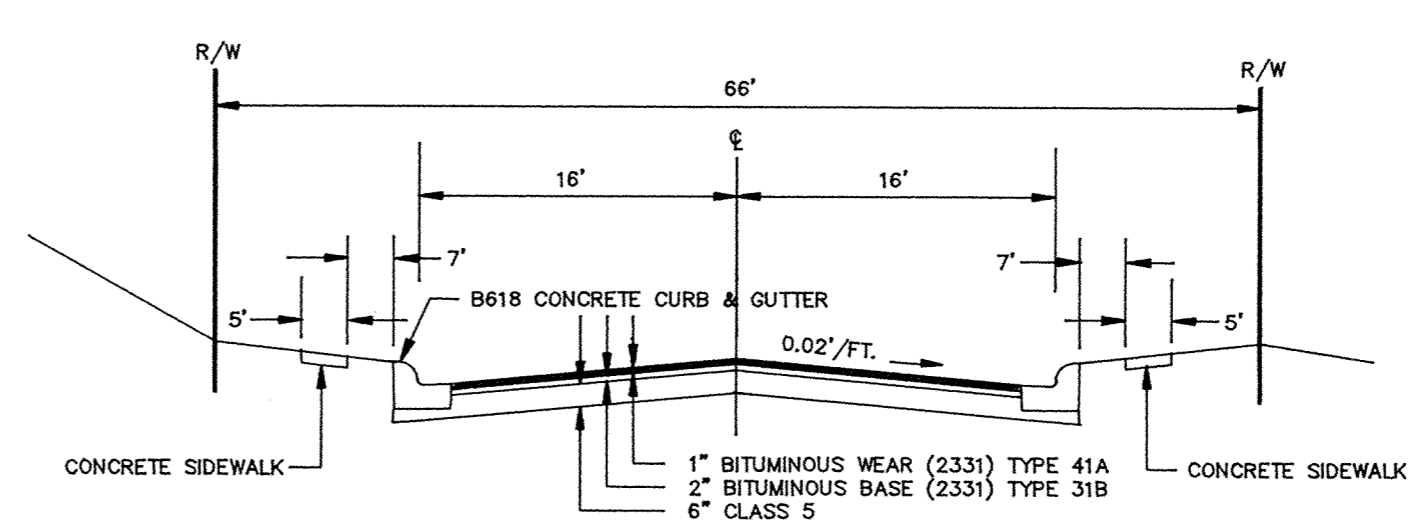

TYPICAL STREET SECTION
HOLT AVE. FROM 3RD TO 4TH ST.

RECORD PLAN
DEC. 1993

I HEREBY CERTIFY THAT THIS PLAN, SPECIFICATION, OR REPORT WAS PREPARED BY ME OR UNDER MY DIRECT SUPERVISION AND THAT I AM A DULY REGISTERED PROFESSIONAL ENGINEER UNDER THE LAWS OF THE STATE OF MINNESOTA.

Terry J. Maier

DATE 8/25/92 REG. NO. 15316

MSA CONSULTING ENGINEERS
Maier Stewart & Associates Inc.
 9800 SHELARD PARKWAY (612) 546-0432 MINNEAPOLIS, MINNESOTA 55441
 1959 SLOAN PLACE (612) 774-6021 ST. PAUL, MINNESOTA 55117

| DATE | DESCRIPTION | DESIGNED |
|------|-------------|---------------|
| | | CHECKED |
| | | DRAWN MRF |
| | | GRAPHIC SCALE |
| | | 0 HORIZ. 100 |
| | | 0 VERT. |

| | | |
|-----------------------------------|----------------|-------------|
| CITY OF ELK RIVER | | |
| LOCATION MAP AND TYPICAL SECTIONS | | |
| 4TH STREET AND HOLT AVENUE | | |
| DATE | SHEET | PROJECT NO. |
| AUG., 1992 | 2 OF 10 SHEETS | 230-146 |