

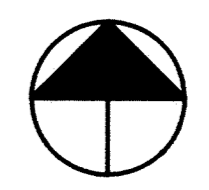


4TH STREET

St. Andrews Church AUDITORS SUBDIVISION NO. 4

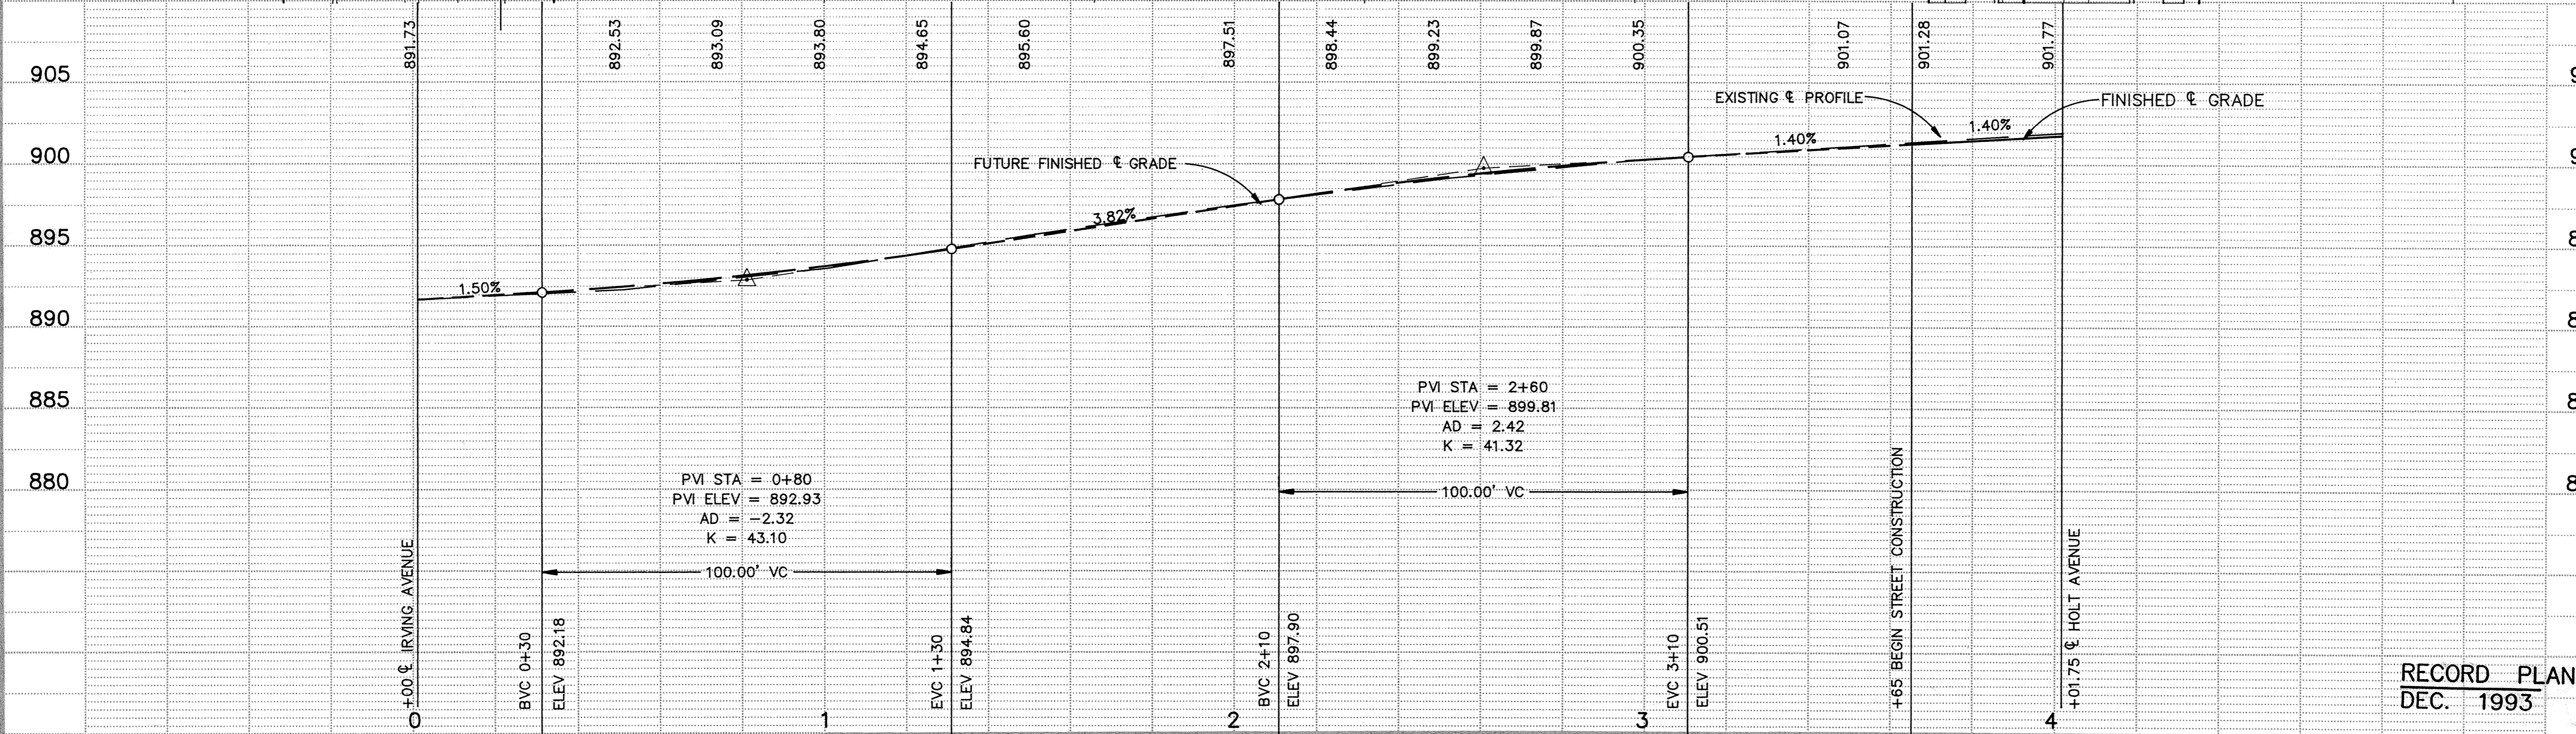

HOUSE

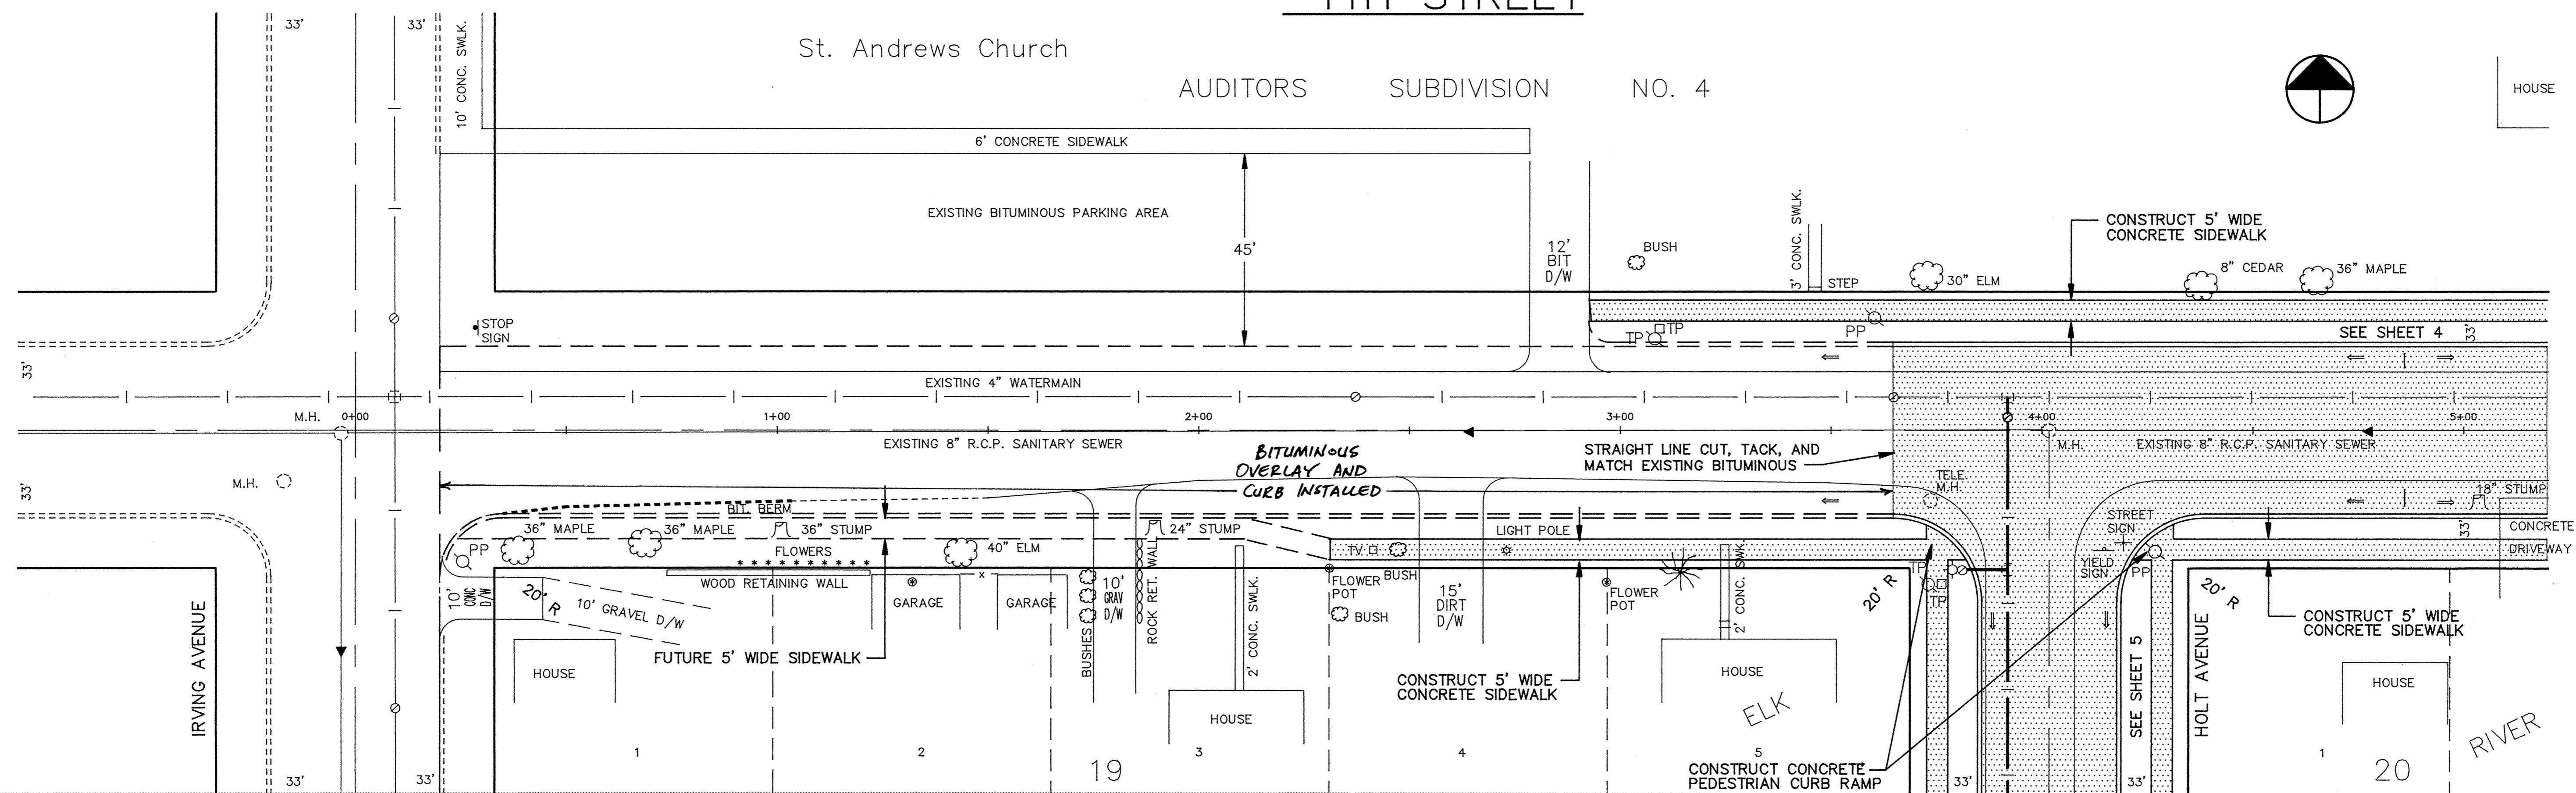

RECORD PLAN
DEC. 1993

I HEREBY CERTIFY THAT THIS PLAN, SPECIFICATION OR REPORT WAS PREPARED BY ME OR UNDER MY DIRECT SUPERVISION AND THAT I AM A DULY REGISTERED PROFESSIONAL ENGINEER UNDER THE LAWS OF THE STATE OF MINNESOTA.

Terry J. Maurer
DATE 8/25/92 REG. NO. 15314

Maier Stewart & Associates Inc.
CONSULTING ENGINEERS
9800 SHELARD PARKWAY (612) 546-0432 MINNEAPOLIS, MINNESOTA 55441
1959 SLOAN PLACE (612) 774-6021 ST. PAUL, MINNESOTA 55117

DATE	DESCRIPTION	DESIGNED	CHECKED

GRAPHIC SCALE
HORIZ. 20
VERT. 5

CITY OF ELK RIVER
STREET IMPROVEMENTS
4TH STREET

STA. 3+65 TO 4+01.75

DATE AUG., 1992 SHEET 3 OF 10 SHEETS PROJECT NO. 230-146