




BLOCK 19

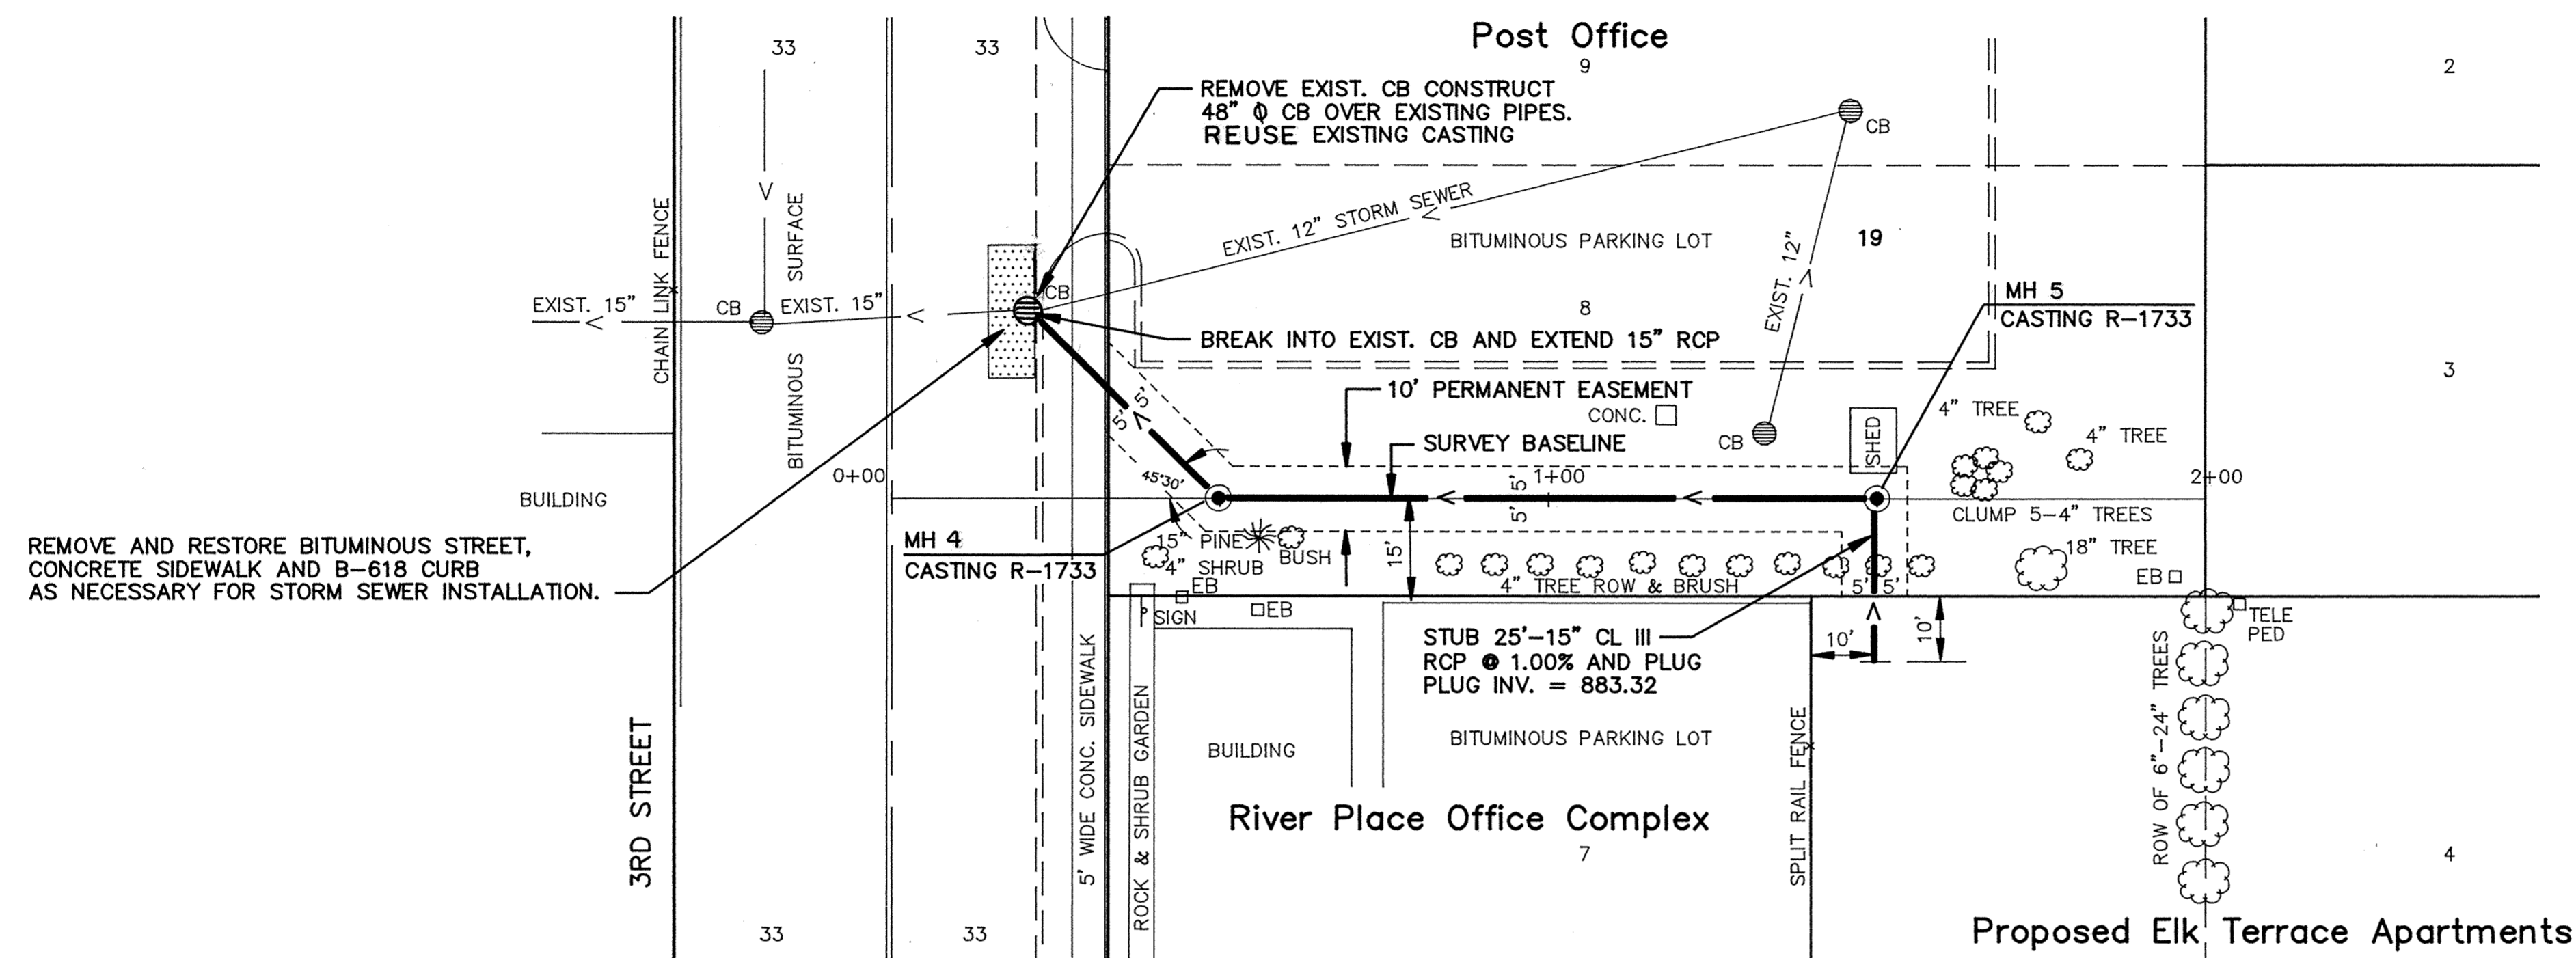

NOTE:
PERMANENT DRAINAGE EASEMENT
TO BE OBTAINED (BY OTHERS).

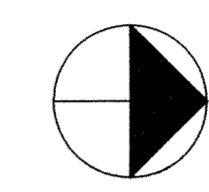

REMOVE AND RESTORE BITUMINOUS STREET,
CONCRETE SIDEWALK AND 8-618 CURB
AS NECESSARY FOR STORM SEWER INSTALLATION.

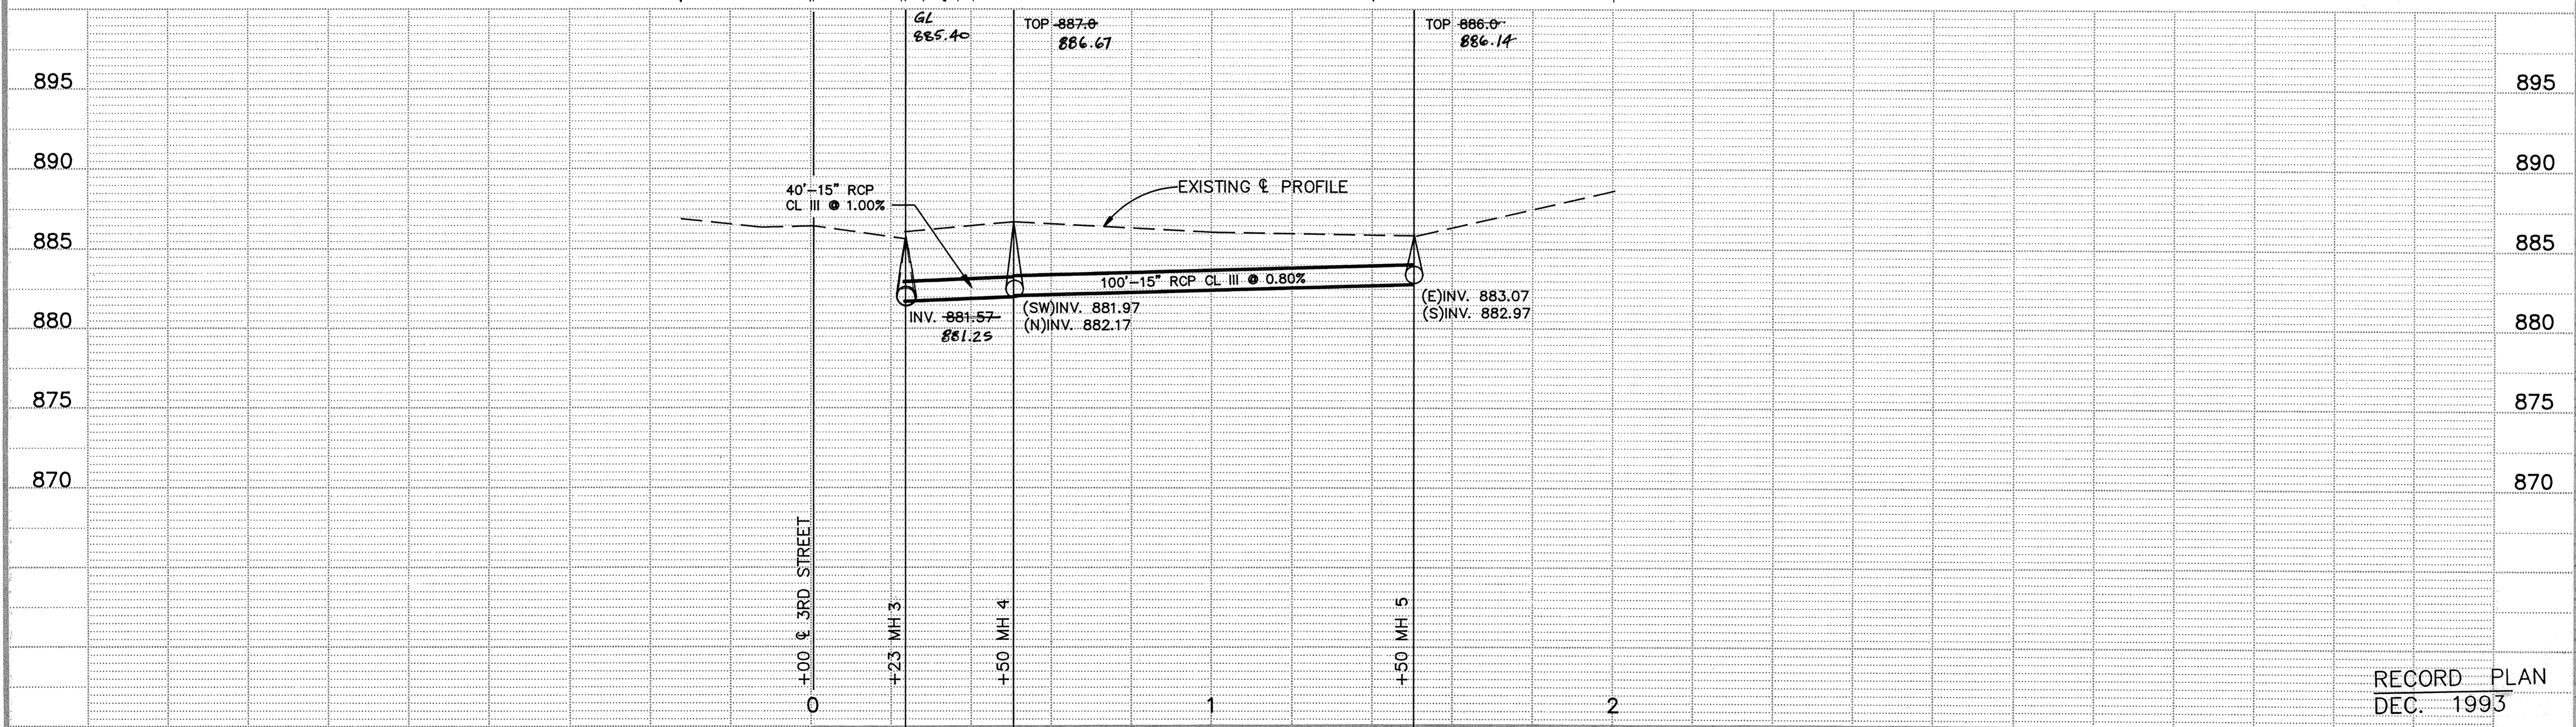

RECORD PLAN
DEC. 1993

I HEREBY CERTIFY THAT THIS PLAN, SPECIFICATION, OR REPORT WAS PREPARED BY ME OR UNDER MY DIRECT SUPERVISION AND THAT I AM A DULY REGISTERED PROFESSIONAL ENGINEER UNDER THE LAWS OF THE STATE OF MINNESOTA.
Tony J. Maier
DATE 8/25/92 REG. NO. 15346

Maier Stewart & Associates Inc.
CONSULTING ENGINEERS
9800 SHELARD PARKWAY (612) 546-0432 MINNEAPOLIS, MINNESOTA 55441
1959 SLOAN PLACE (612) 774-6021 ST. PAUL, MINNESOTA 55117

DATE	DESCRIPTION	DESIGNED	CHECKED

GRAPHIC SCALE
HORIZ. 20'
VERT. 5'

CITY OF ELK RIVER
STORM SEWER
BLOCK 19

STA. 0+00 TO 2+00

DATE AUG., 1992 SHEET 6 OF 10 SHEETS PROJECT NO. 230-146