



NOTES: 1. WATER SERVICE TO EACH PROPERTY SHALL BE MAINTAINED AT ALL TIMES. TEMPORARY WATER SERVICE MAY BE NECESSARY.
 2. THIS PLANSHEET IS FOR INFORMATIONAL PURPOSES ONLY. REFER TO PLANS AND SPECIFICATIONS FOR EXACT PROJECT REQUIREMENTS. LOCATION OF HYDRANTS AND VALVES ARE APPROXIMATE. CONTRACTOR TO DETERMINE EXACT LOCATIONS IN THE FIELD.

- EXISTING WATERMAIN TO REMAIN IN PLACE
- - - EXISTING WATERMAIN TO BE REMOVED OR ABANDONED
- PROPOSED 12-INCH WATERMAIN
- ⊗ PROPOSED VALVE
- EXISTING VALVE
- EXISTING HYDRANT

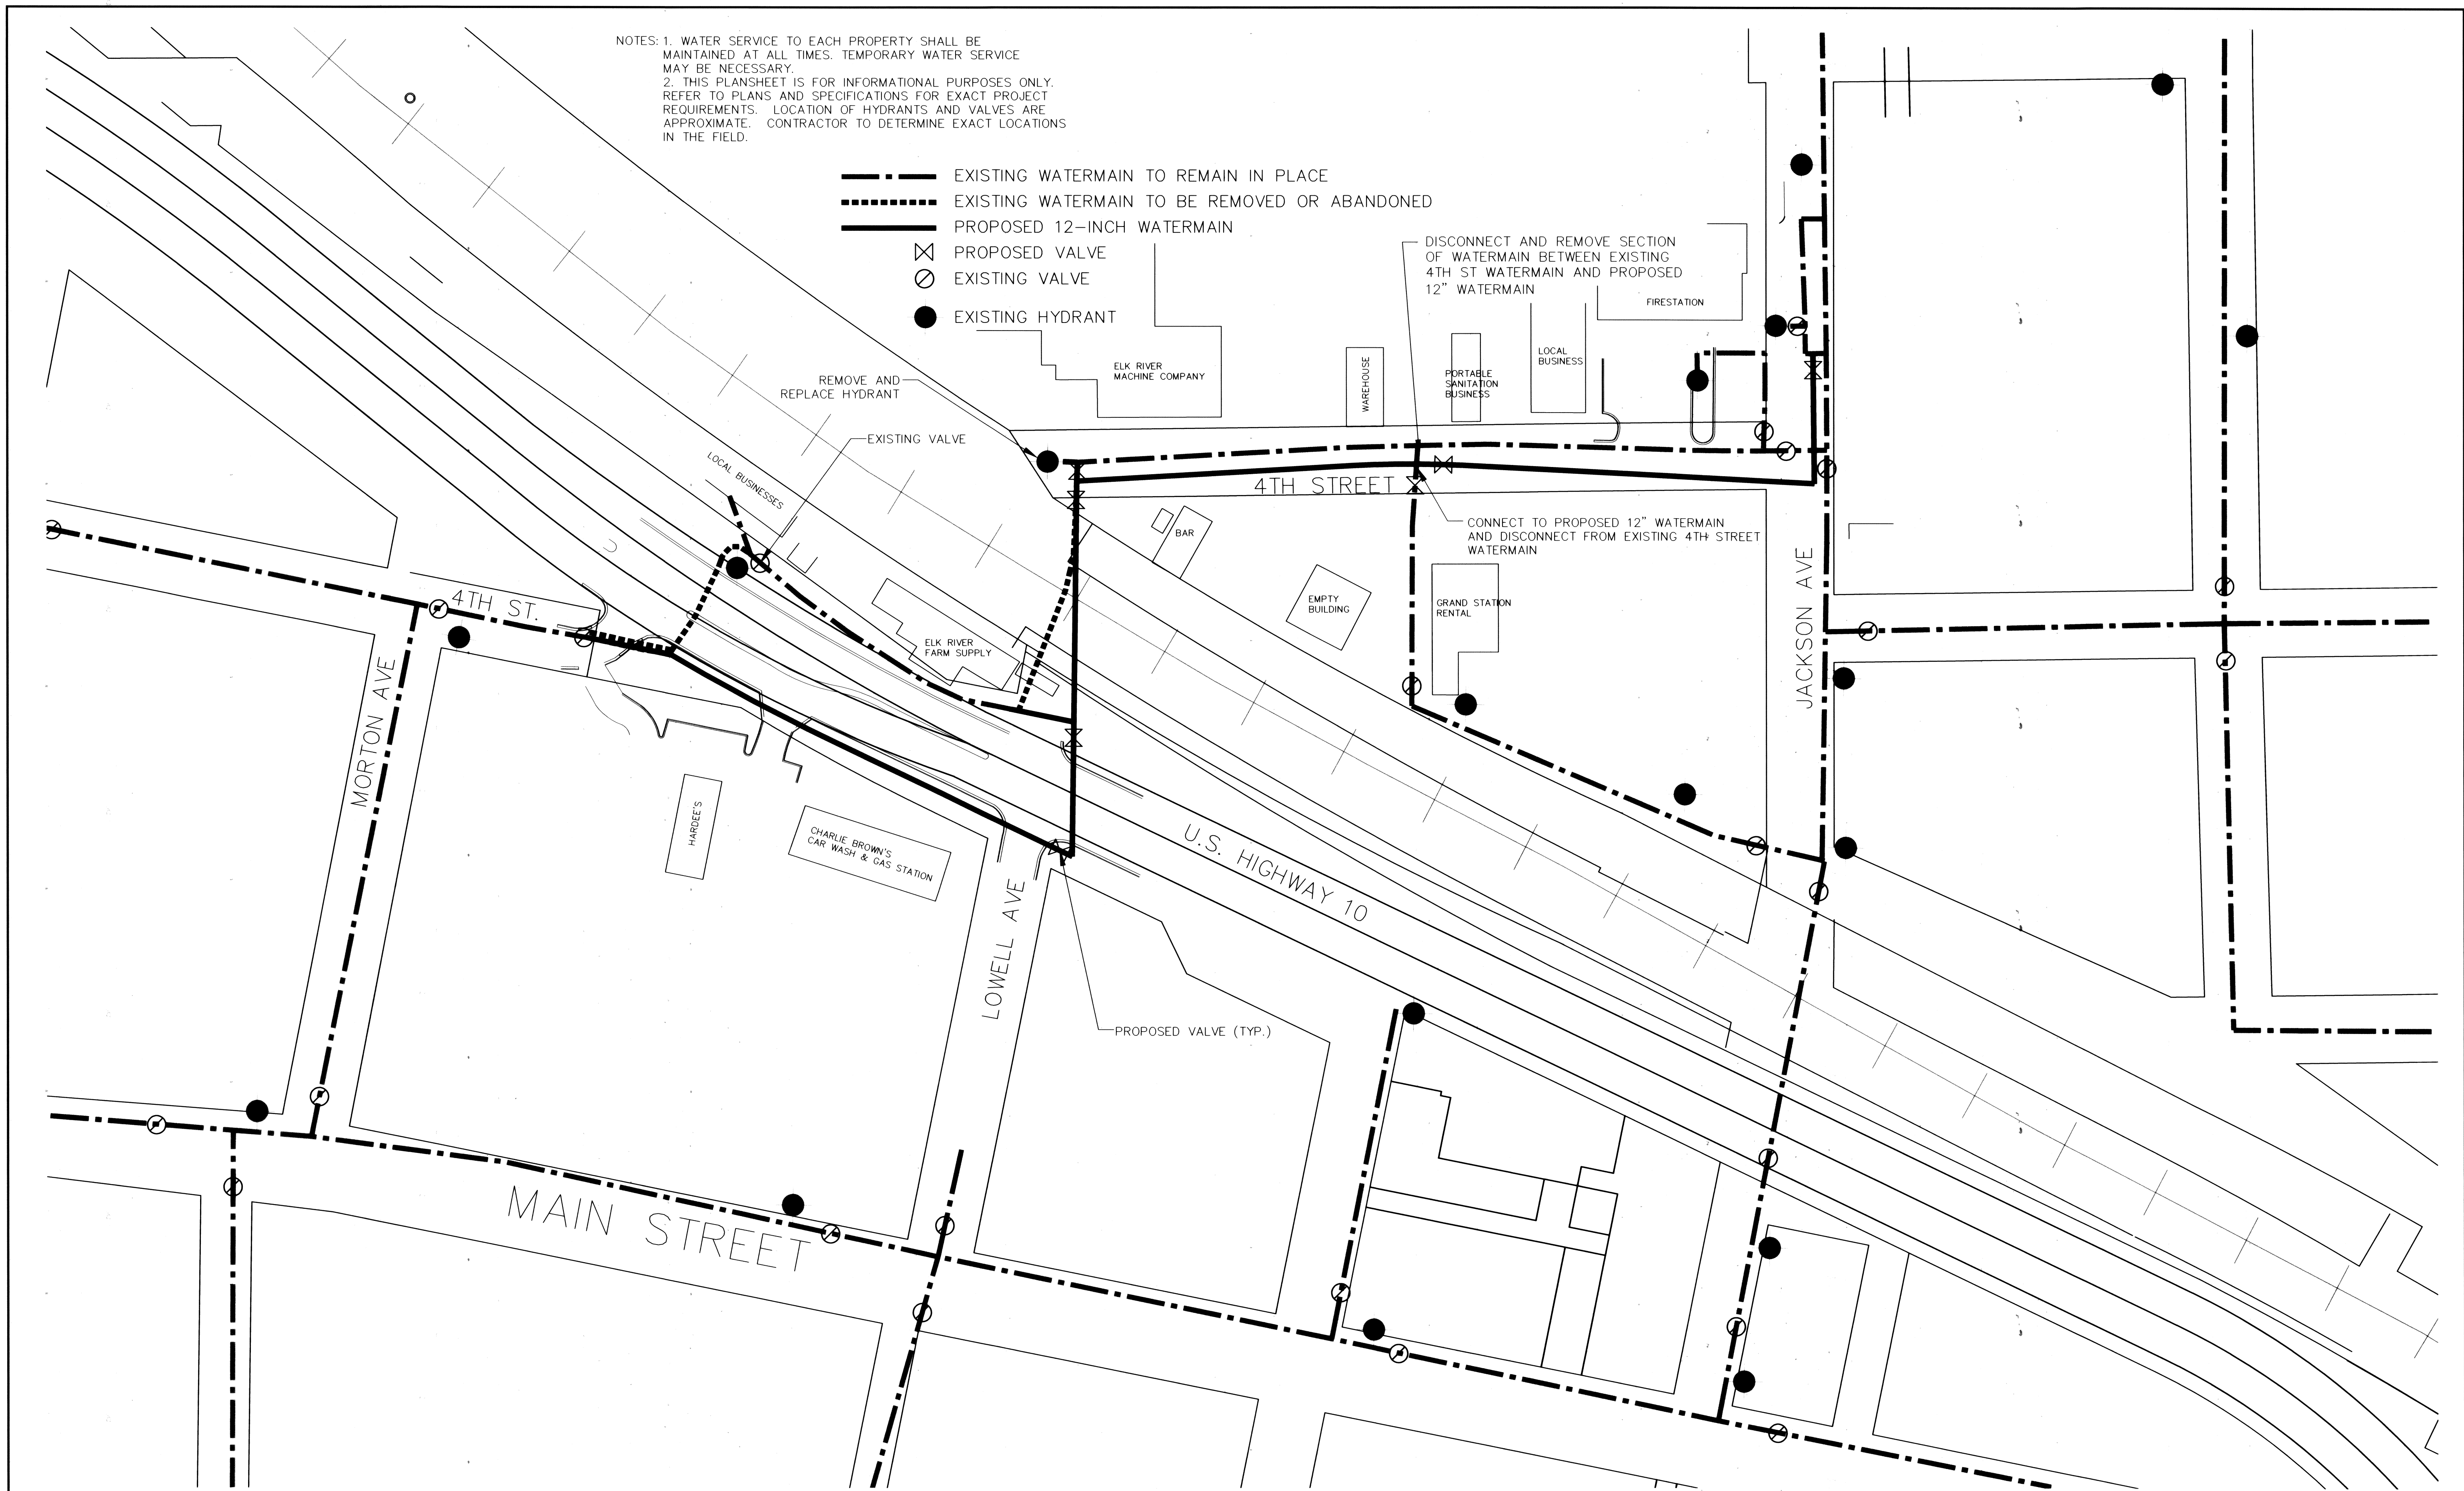

 ELFERING & ASSOCIATES	10062 FLANDERS CT NE BLAINE, MN 55449 PH: (763) 780-0450	DESIGNED BY: KJE DRAWN BY: NAB APPROVED BY: KJE JOB NUMBER: 235021E CAD DATE: October 9, 2007 CAD FILE: 235021E-4th St Watermain\dwg\Overall	I HEREBY CERTIFY THAT THIS PLAN, SPECIFICATION, OR REPORT WAS PREPARED BY ME OR UNDER MY DIRECT SUPERVISION AND THAT I AM A DULY LICENSED PROFESSIONAL ENGINEER UNDER THE LAWS OF THE STATE OF MINNESOTA. SIGNATURE: _____ DATE: _____ PRINTED NAME: KRISTINA J. ELFERING LIC. NO. 42350	<table border="1" style="width: 100%; border-collapse: collapse;"> <thead> <tr> <th style="font-size: small;">NO.</th> <th style="font-size: small;">DATE</th> <th style="font-size: small;">BY</th> <th style="font-size: small;">REVISION DESCRIPTION</th> </tr> </thead> <tbody> <tr><td> </td><td> </td><td> </td><td> </td></tr> <tr><td> </td><td> </td><td> </td><td> </td></tr> <tr><td> </td><td> </td><td> </td><td> </td></tr> </tbody> </table>	NO.	DATE	BY	REVISION DESCRIPTION													4TH STREET WATERMAIN IMPROVEMENTS ELK RIVER MUNICIPAL UTILITIES	AS-BUILTS OVERALL VIEW	SHEET NO. 3
	NO.	DATE	BY	REVISION DESCRIPTION																			