



5TH STREET

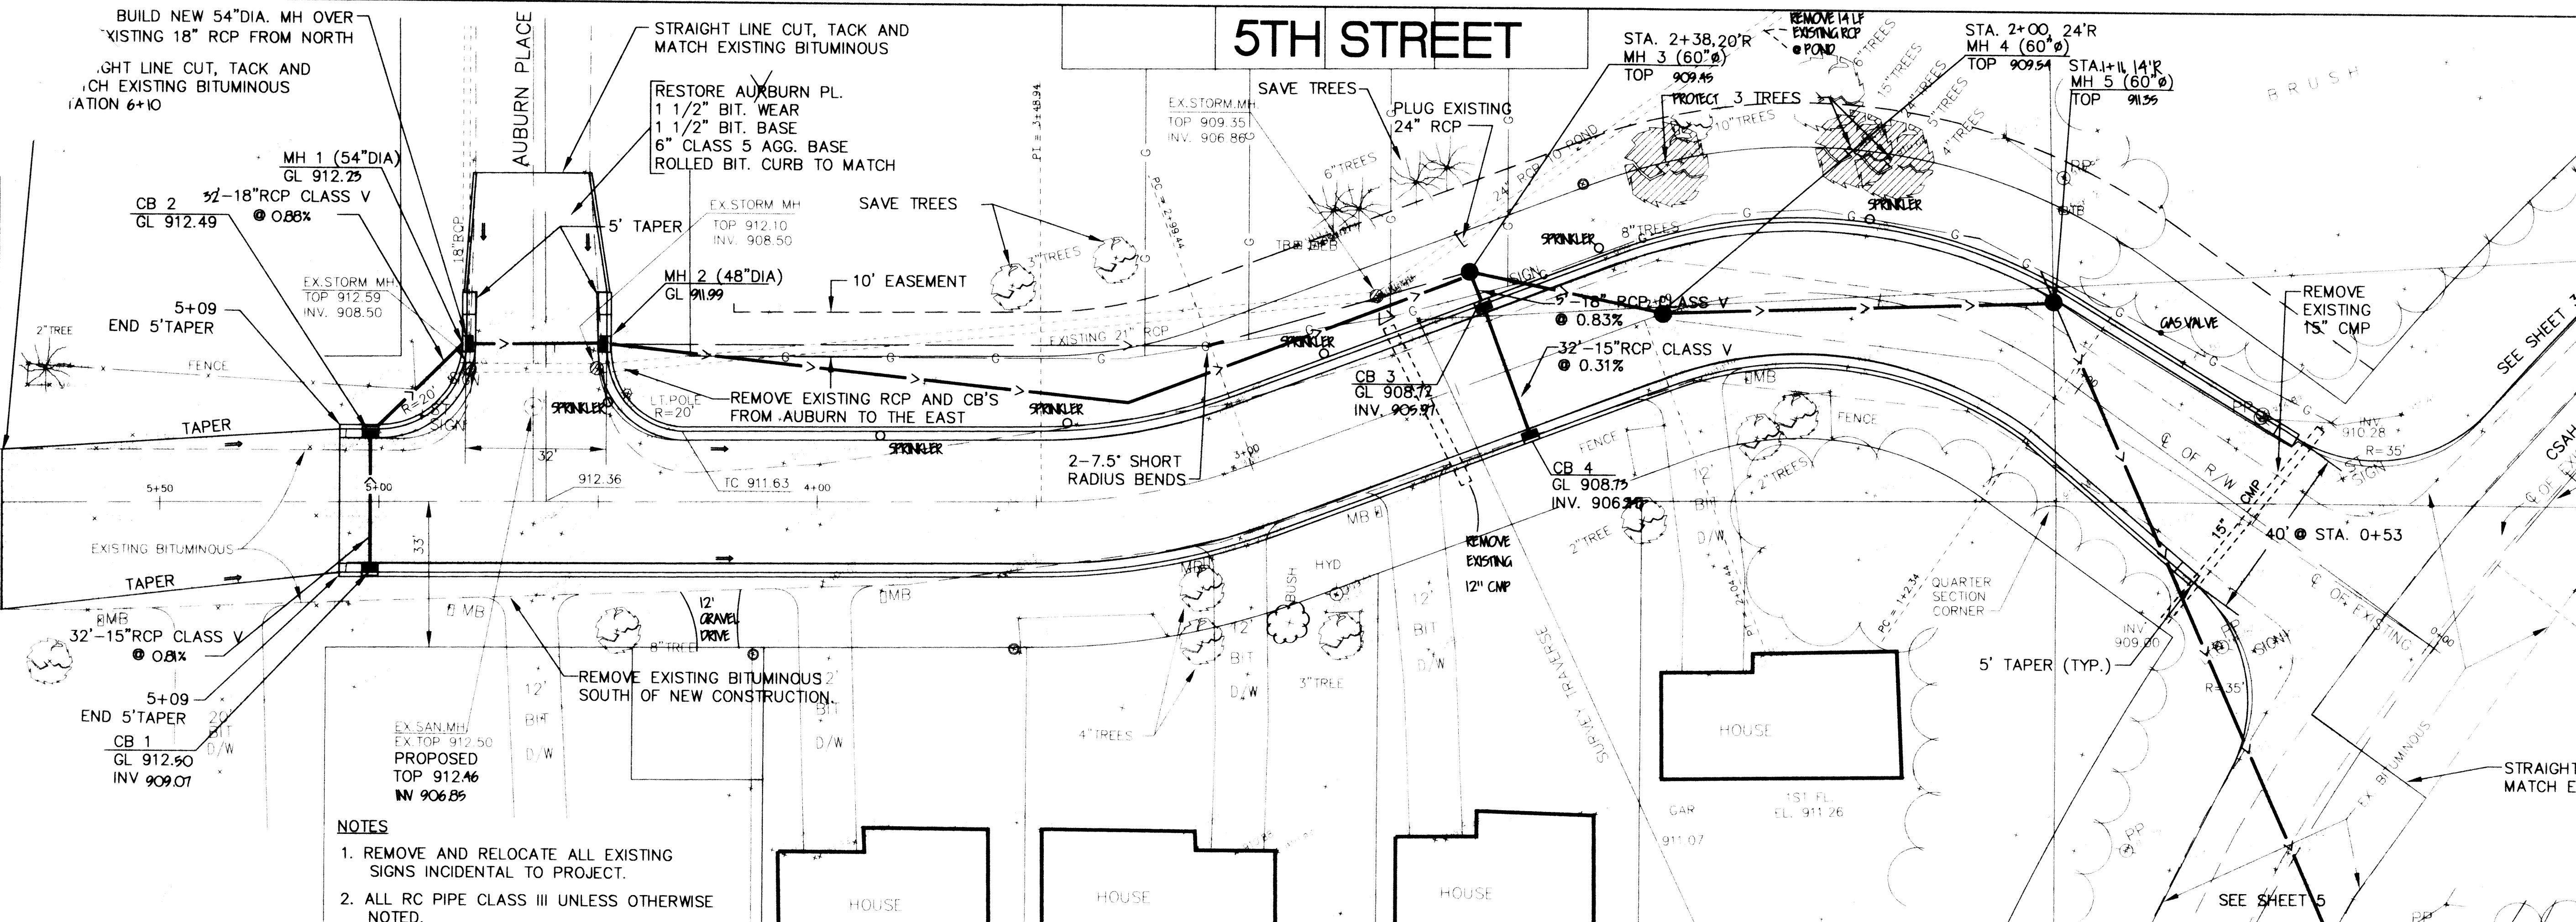


- NOTES**
1. REMOVE AND RELOCATE ALL EXISTING SIGNS INCIDENTAL TO PROJECT.
 2. ALL RC PIPE CLASS III UNLESS OTHERWISE NOTED.

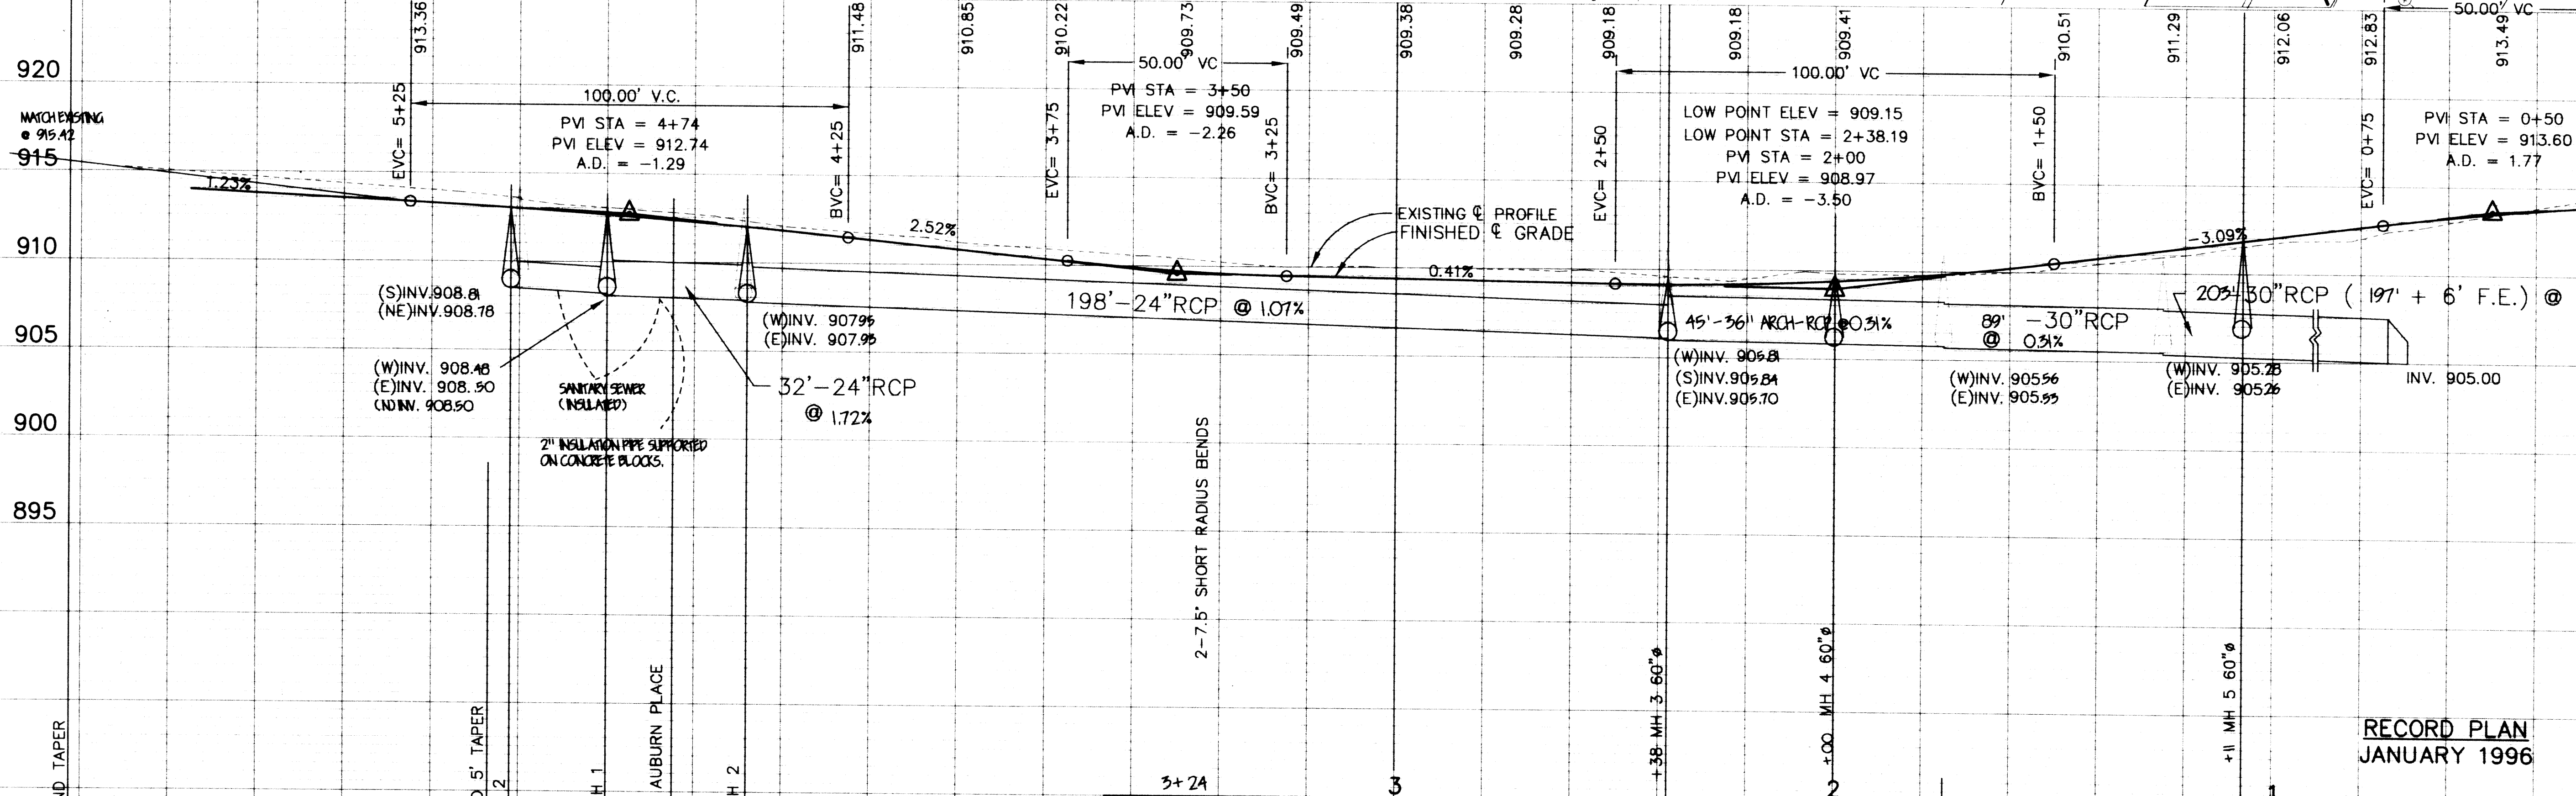

RECORD PLAN
JANUARY 1996

I HEREBY CERTIFY THAT THIS PLAN, SPECIFICATION, OR REPORT WAS PREPARED BY ME OR UNDER MY DIRECT SUPERVISION AND THAT I AM A DULY REGISTERED PROFESSIONAL ENGINEER UNDER THE LAWS OF THE STATE OF MINNESOTA.

James J. Hansen
DATE: 5/12/94 REG. NO. 75316

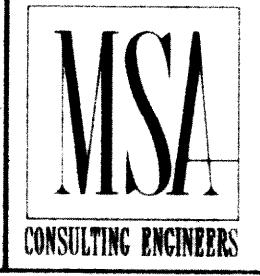

1326 ENERGY PARK DRIVE
ST. PAUL, MINNESOTA 55108
(612) 644-4389

9800 SHELARD PARKWAY
MINNEAPOLIS, MINNESOTA 55441
(612) 546-0432

DATE	DESCRIPTION	DESIGNED, DEN.
6-12-95	REVISED TO MATCH PLANS FOR 5TH ST. WEST TO TH 169	CHECKED DRAWN: TPC
REVISIONS		GRAPHIC SCALE 0' HORIZ 0' VERT