
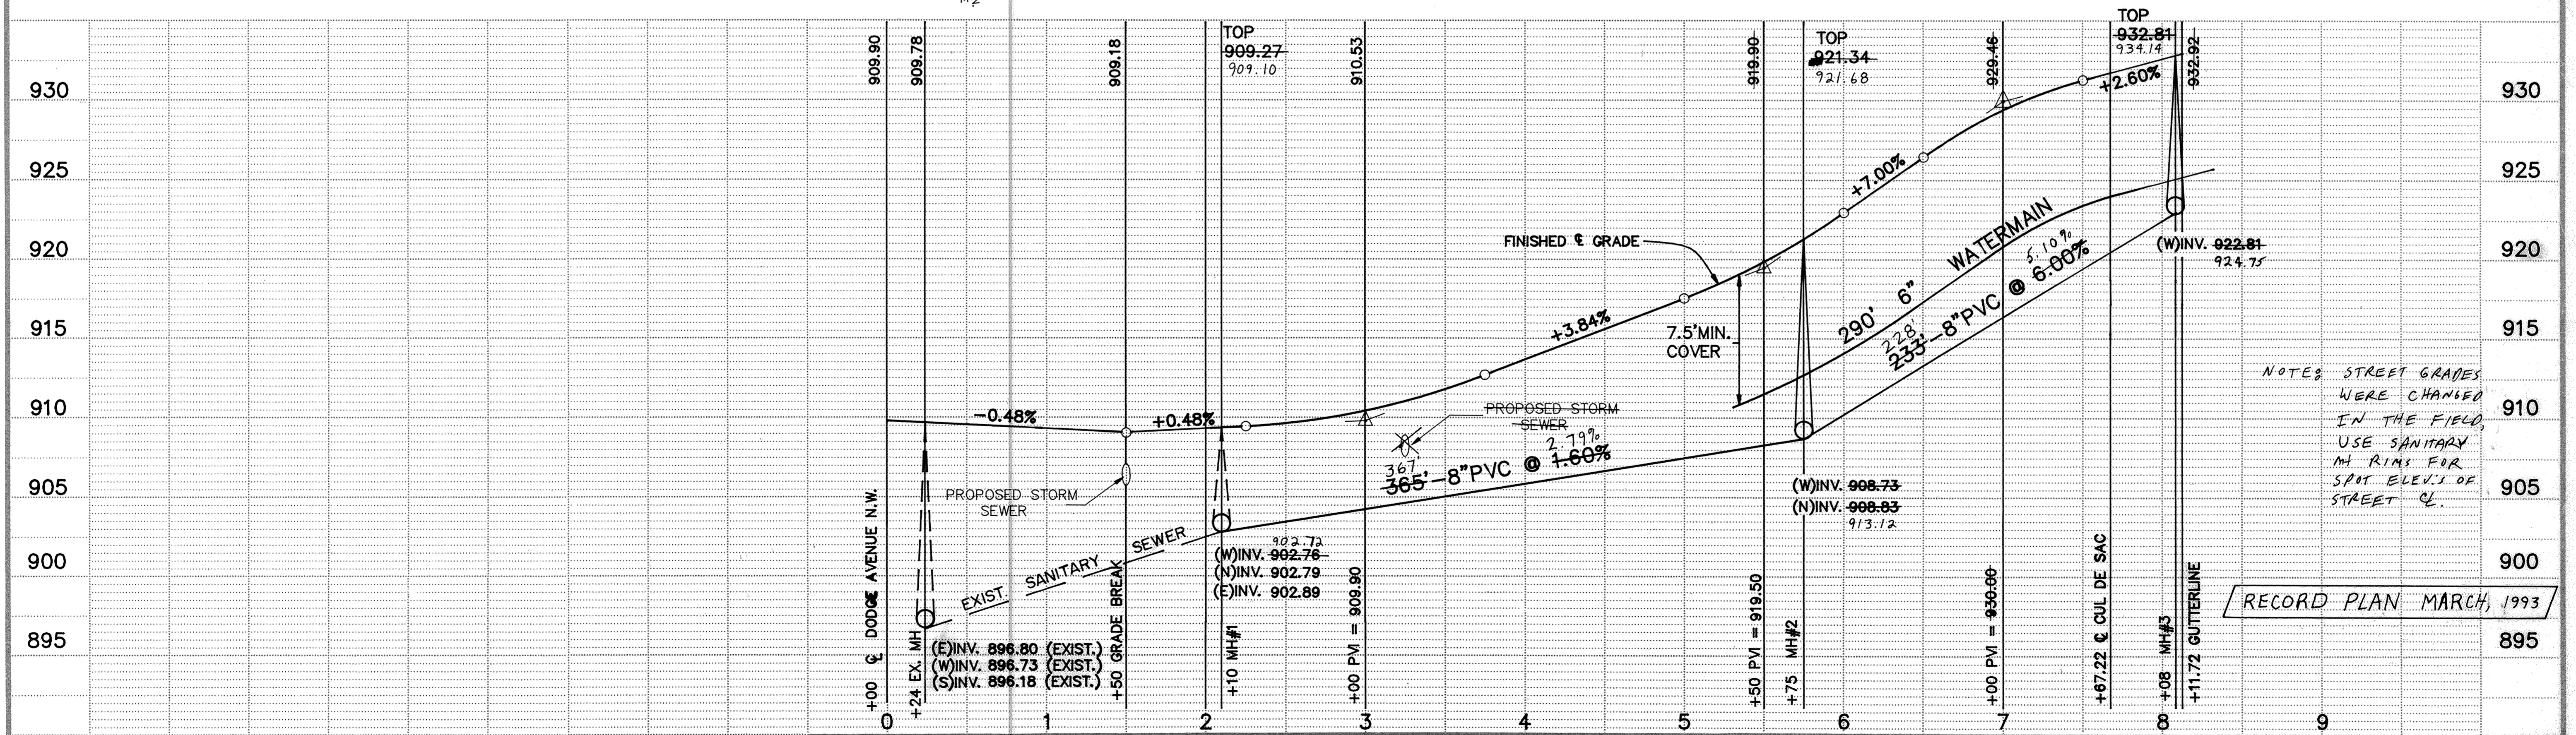
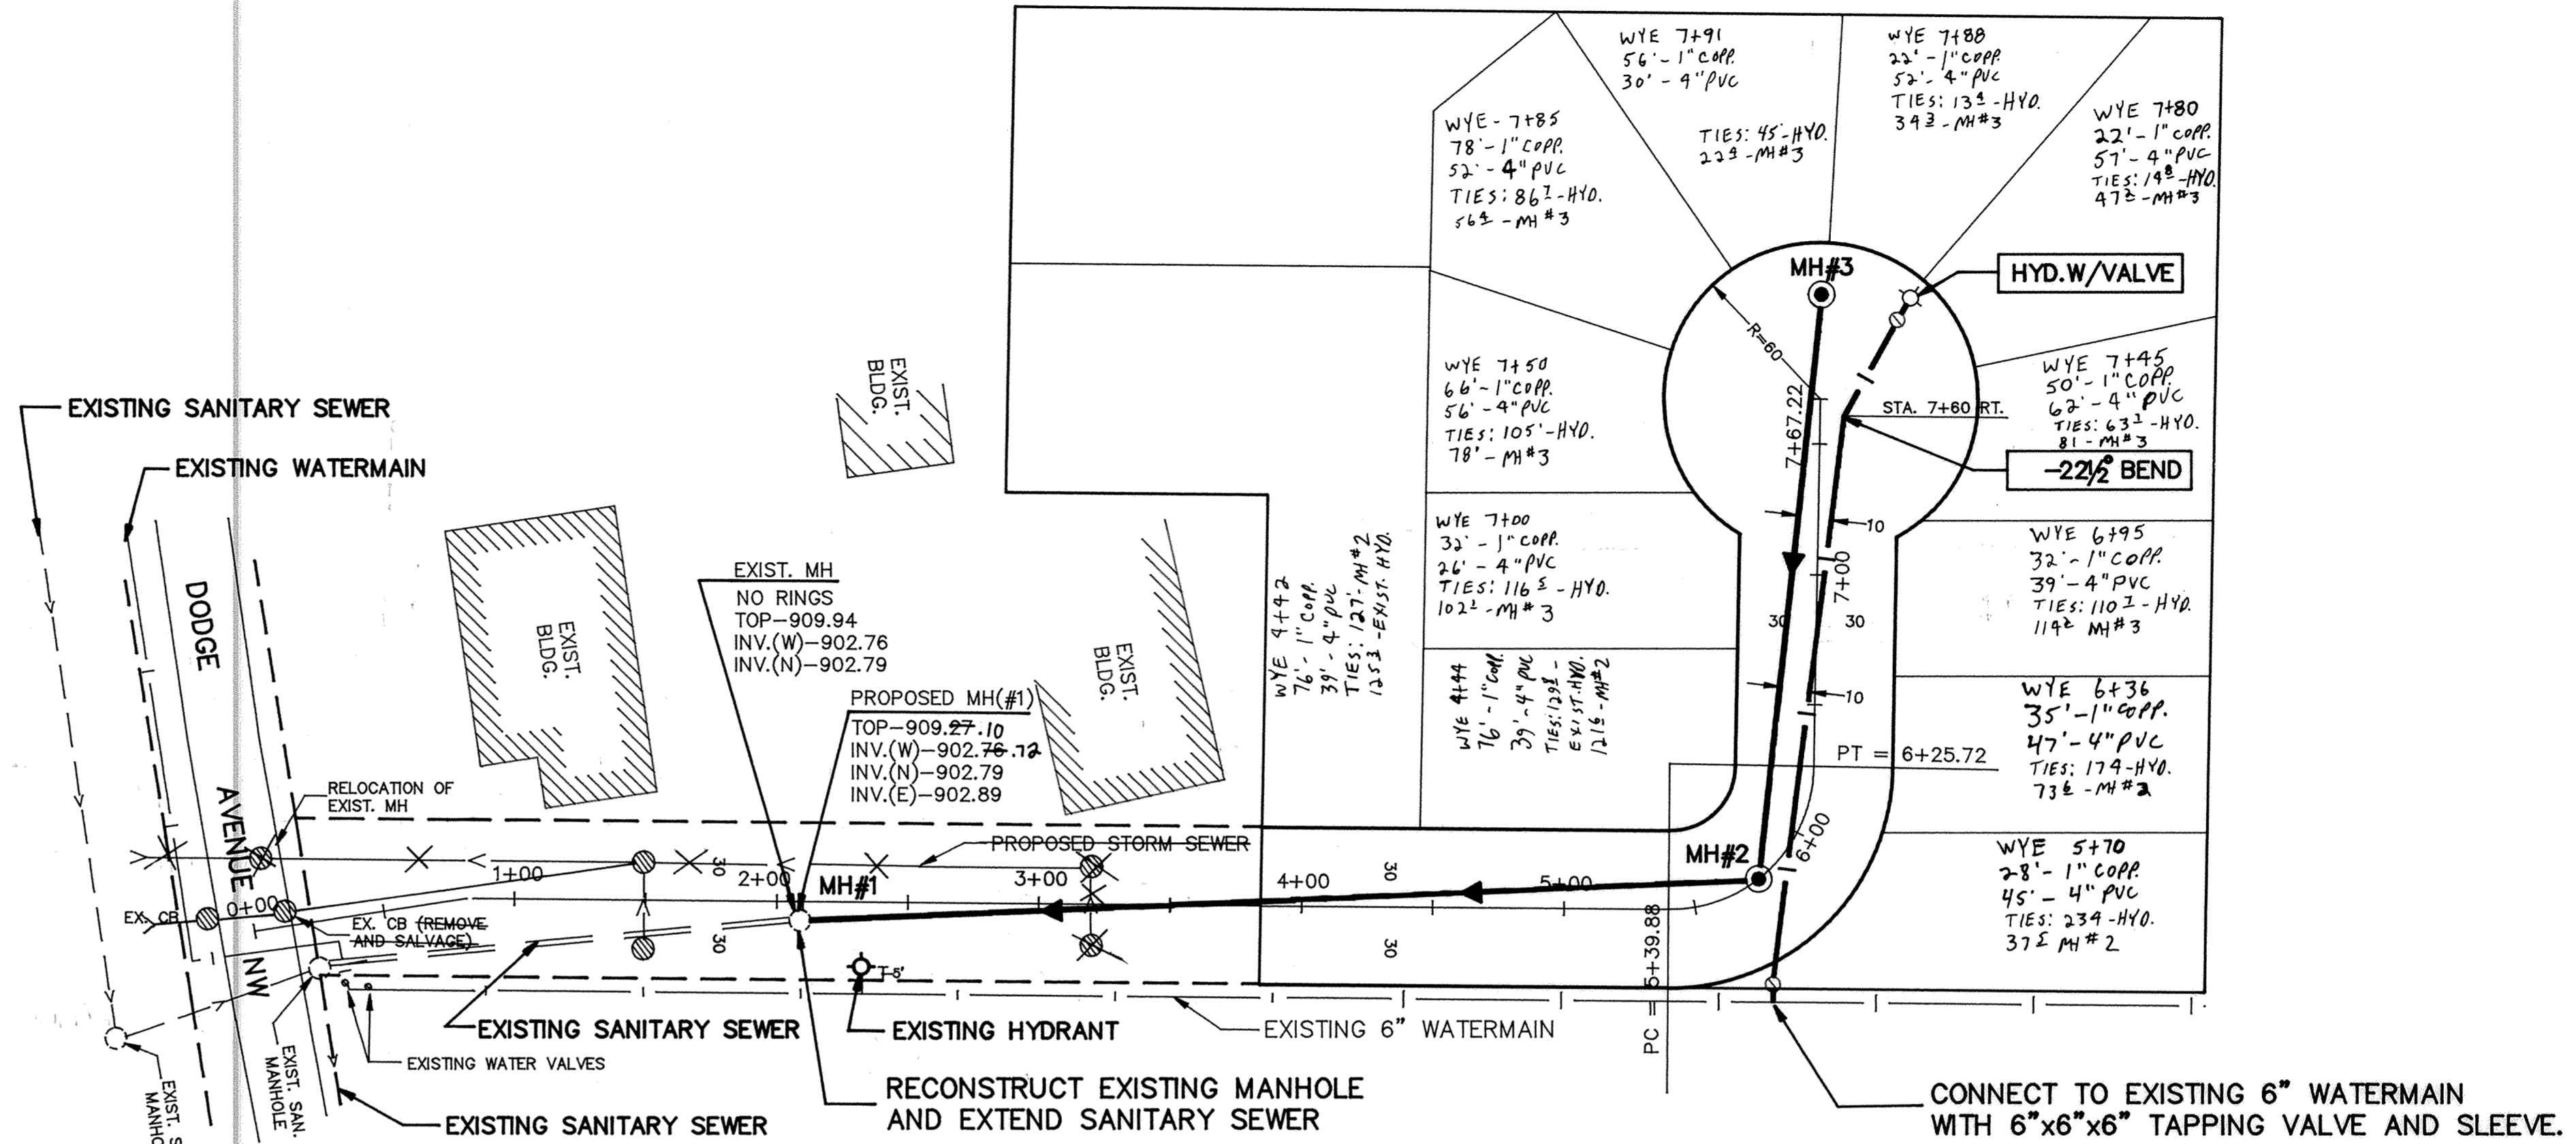


8TH STREET

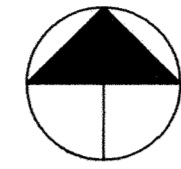

NOTES: STREET GRADES WERE CHANGED IN THE FIELD. USE SANITARY MH RIMS FOR SPOT ELEV. OF STREET CL.

RECORD PLAN MARCH, 1993

I HEREBY CERTIFY THAT THIS PLAN, SPECIFICATION, OR REPORT WAS PREPARED BY ME OR UNDER MY DIRECT SUPERVISION AND THAT I AM A DULY REGISTERED PROFESSIONAL ENGINEER UNDER THE LAWS OF THE STATE OF MINNESOTA.
 Terry J. Maier
 DATE 3/29/91 REG. NO. 15316

Maier Stewart & Associates Inc.
 CONSULTING ENGINEERS
 1959 SLOAN PLACE (612) 774-6021 ST. PAUL, MINNESOTA 55117

DATE	DESCRIPTION	CHECKED

CITY OF ELK RIVER
 SANITARY SEWER AND WATERMAIN
 8TH STREET

DATE MAR 1991 SHEET 2 OF 7 SHEETS PROJECT NO. 230-102-20