



1981 IMPROVEMENT PROJECT

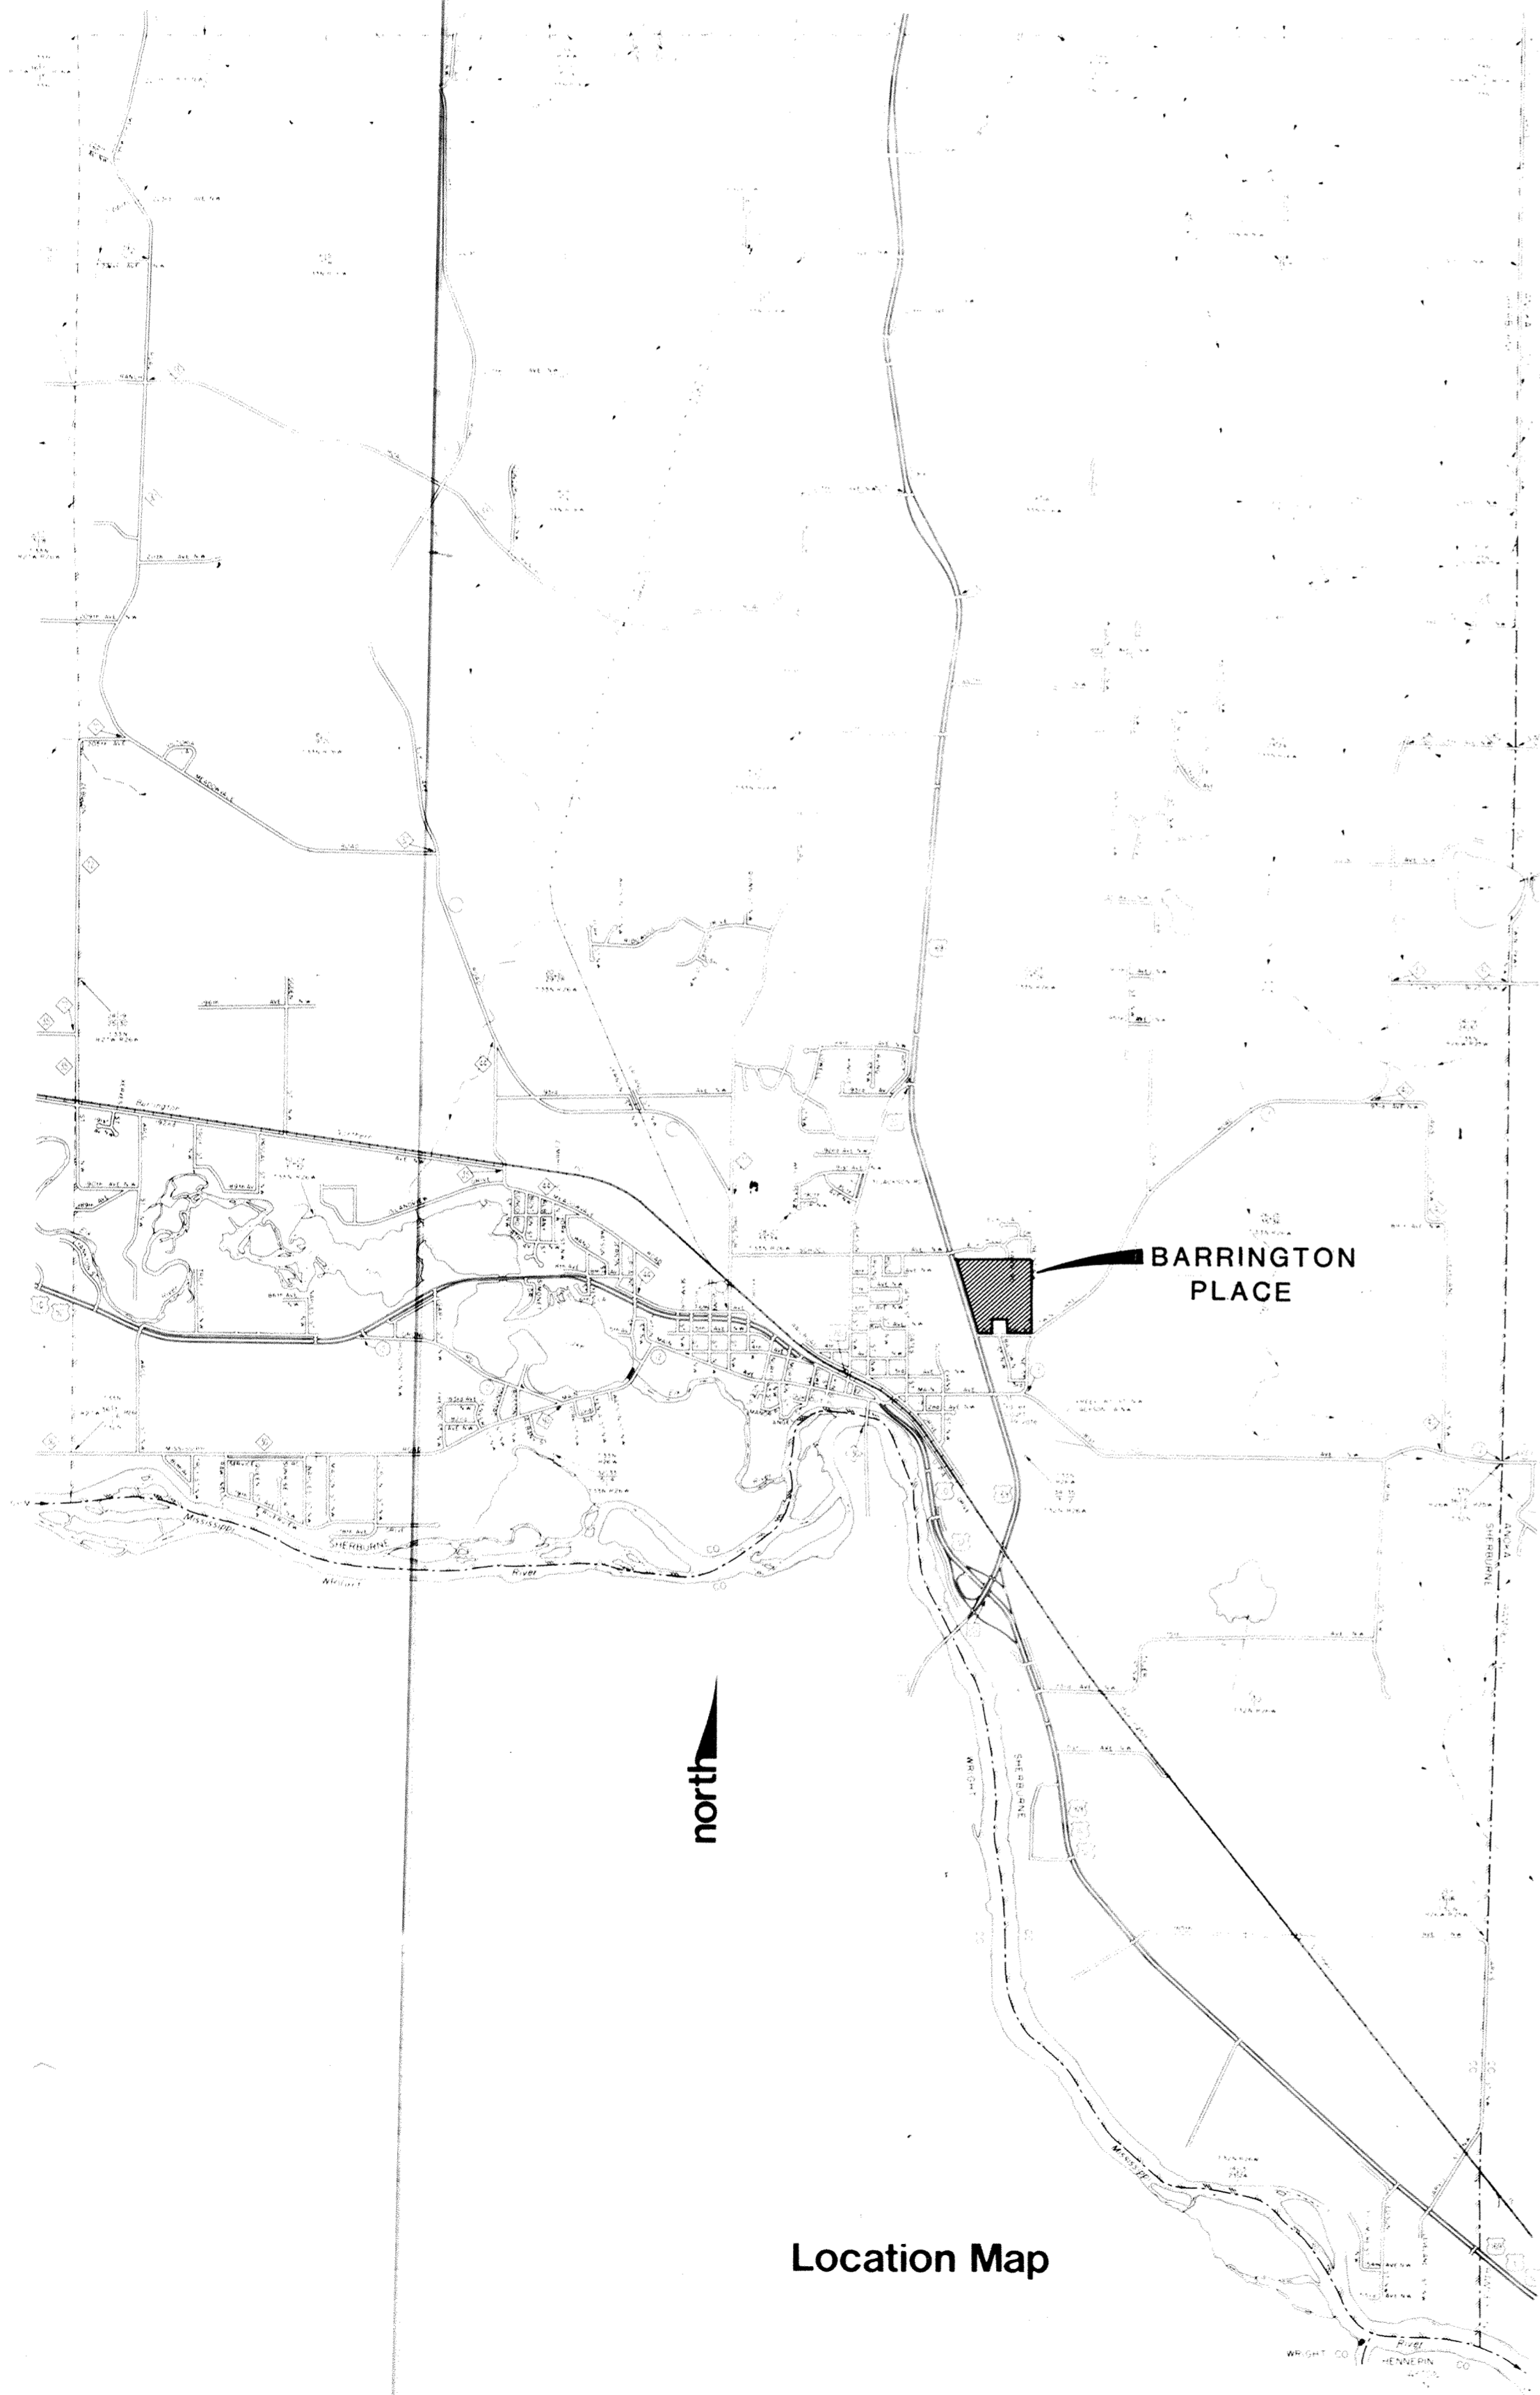


SANITARY SEWER, WATERMAIN,
STORM DRAINAGE & STREET CONSTRUCTION


BARRINGTON PLACE

AS-BUILT Date _____
 DRAWN BY: MRF Date 11/7/82
 CHECKED BY: _____
 INSPECTOR RW Date 1/4/82
 DESIGN ENG: JGM Date 7/18/82
 PARTY CHIEF RB Date 1/4/82

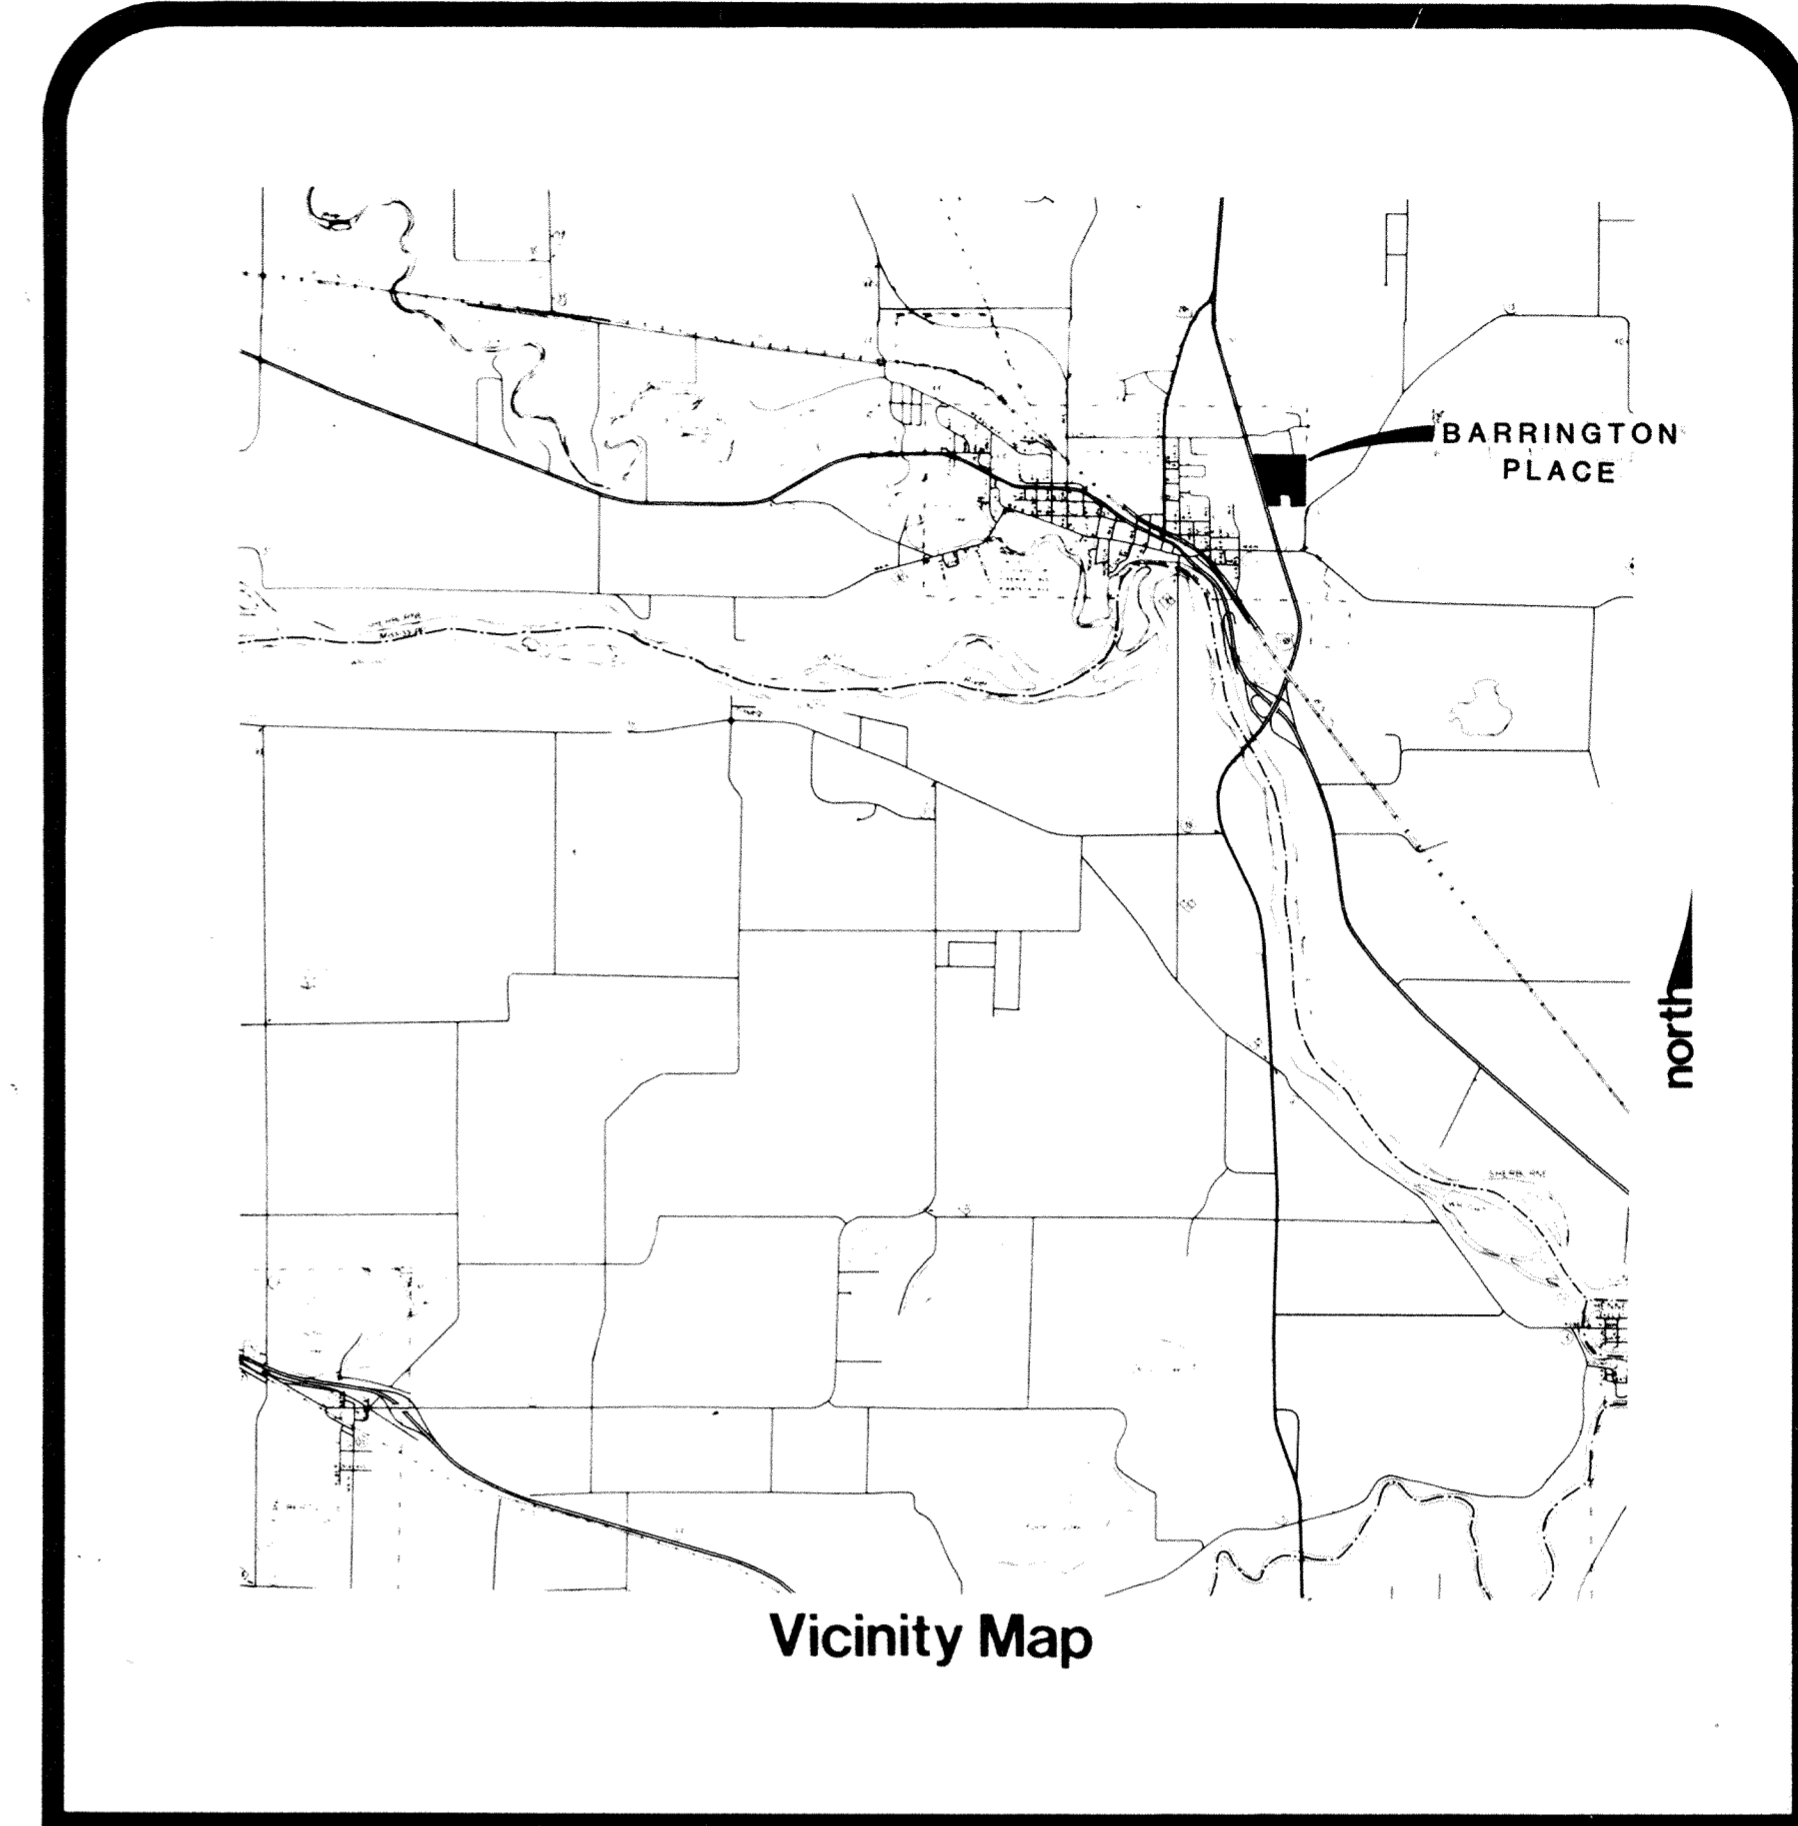

I hereby certify that this plan, specification or report was prepared by me or under my direct supervision and that I am duly Registered Professional Engineer under State of Minnesota Statutes Section 326.02 to 326.16
 Jeffrey J. Root
 Date 5-5-81 Minnesota Registration No. 10206

consulting engineers diversified inc. 
 civil municipal planning environmental land surveying geotechnics
 p.o. box j. osseo, minnesota 55369 (612) 425-2181


 City of Elk
 Barrington Place
 1980
 245' 16-110

DRAWING NUMBER

DRAWING NUMBER

DRAWING NUMBER

DRAWING NUMBER
BARR1.81
1