

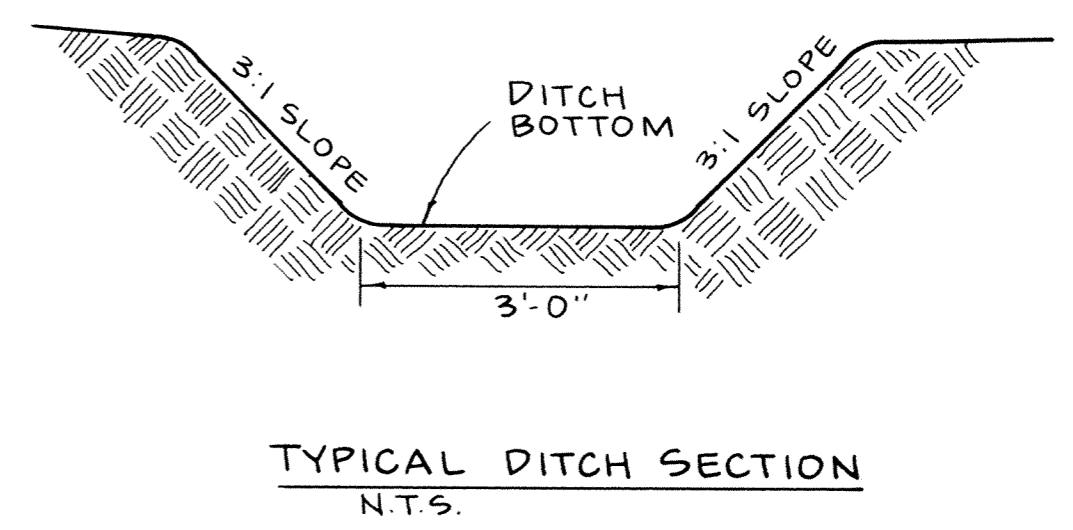


Fed. Proj. No.

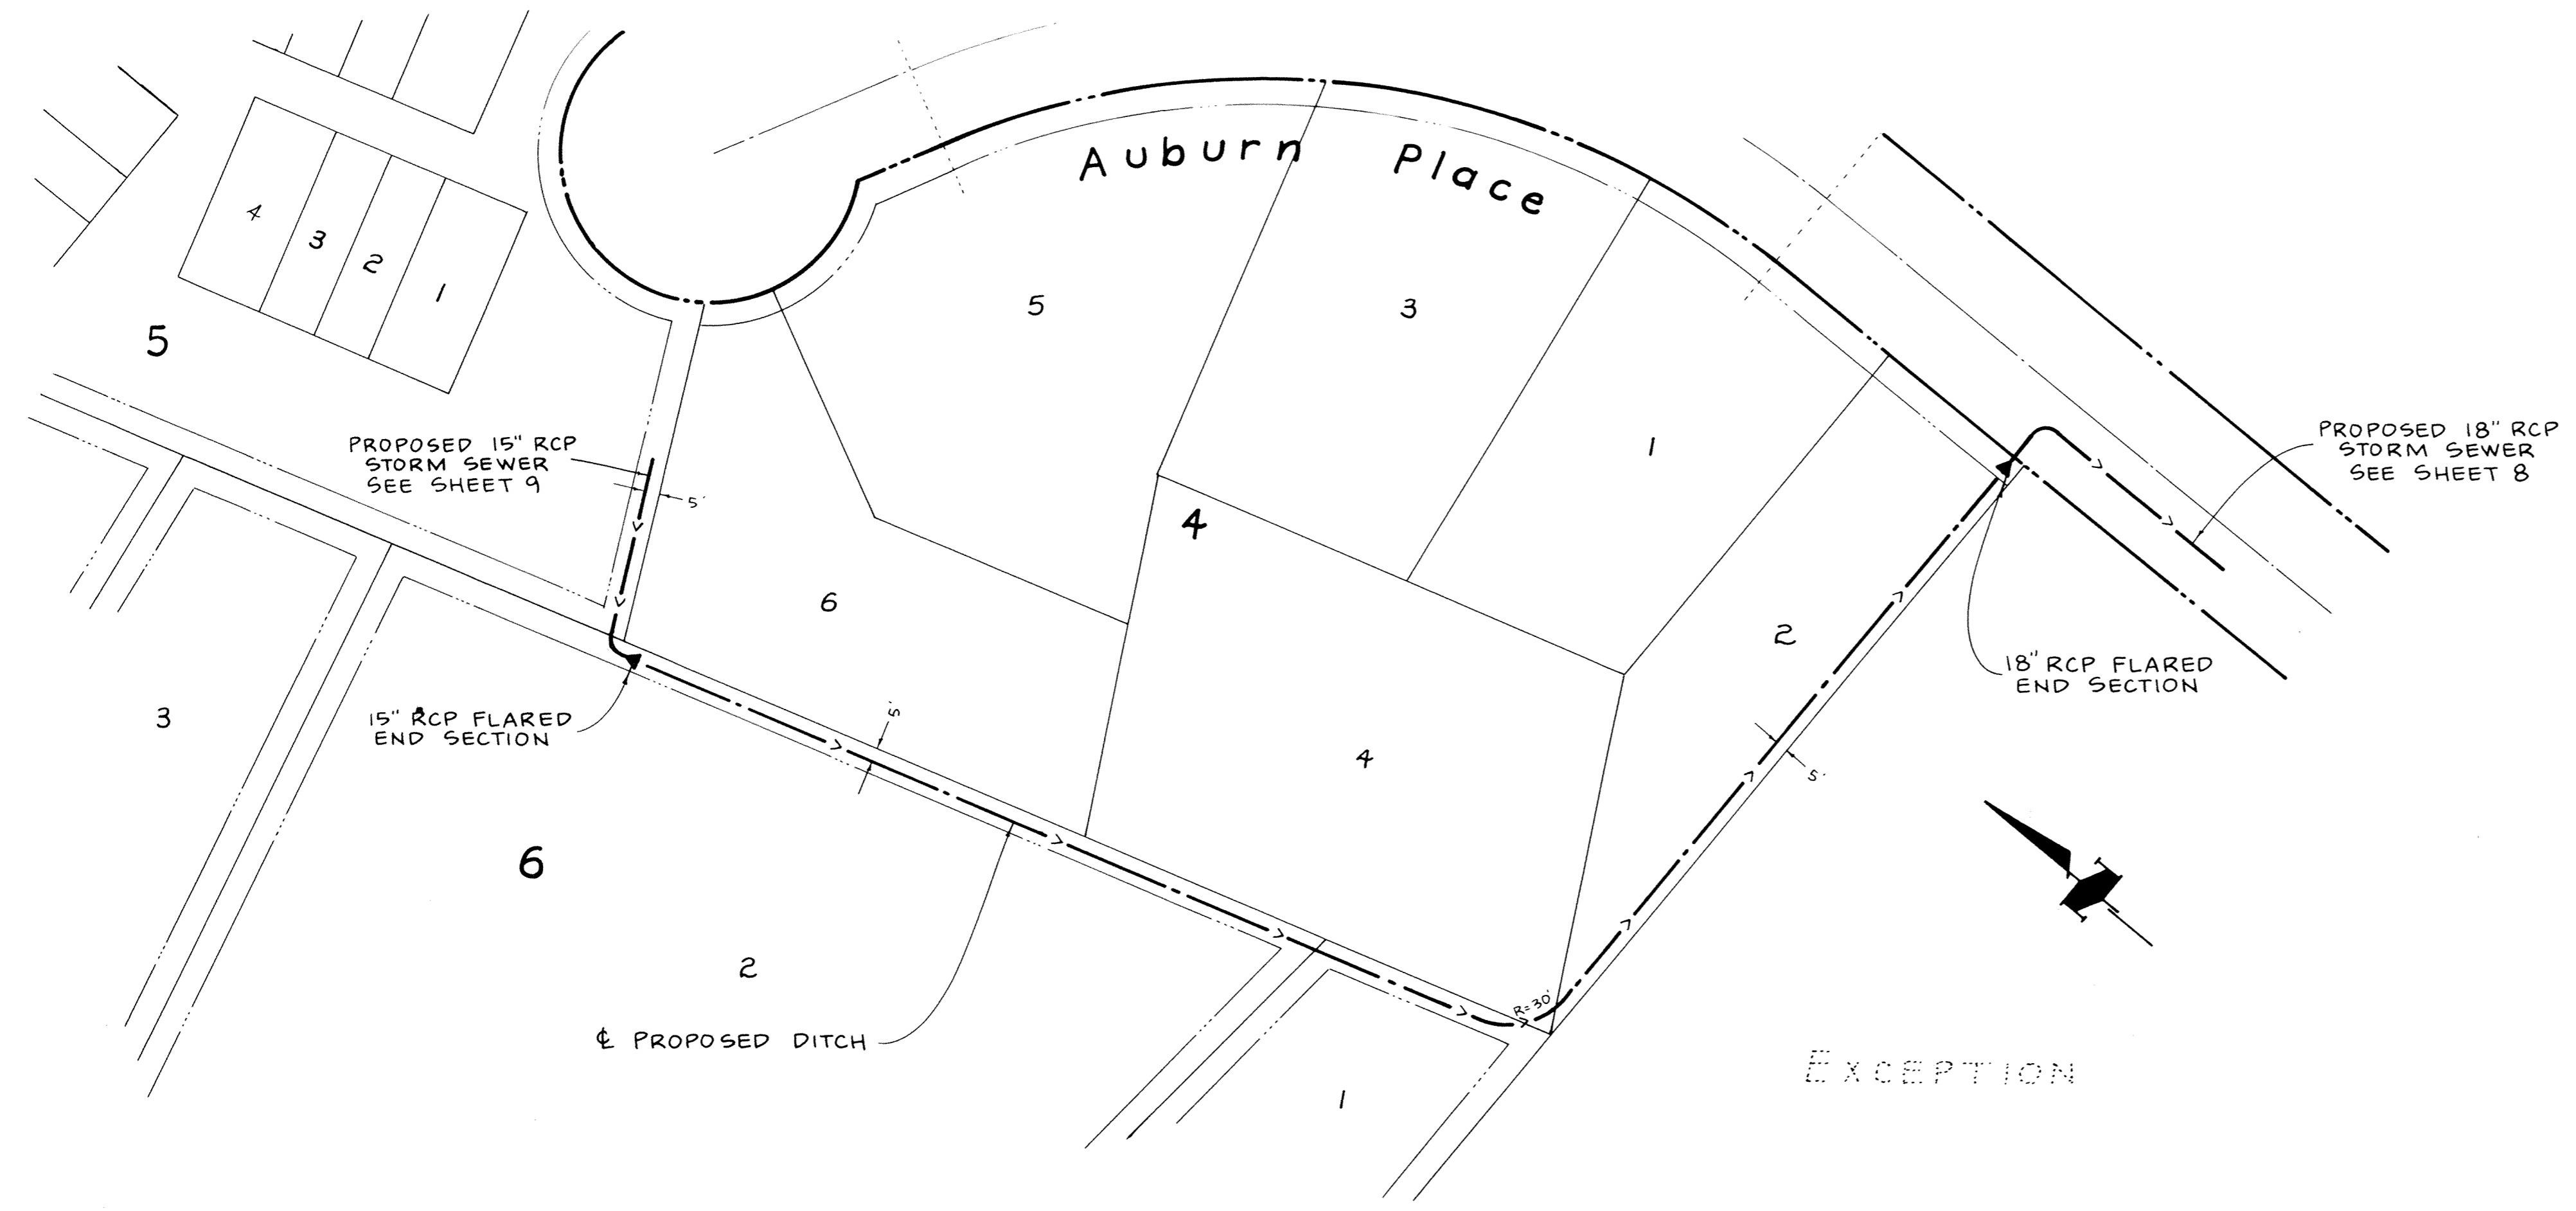


EXCEPTION

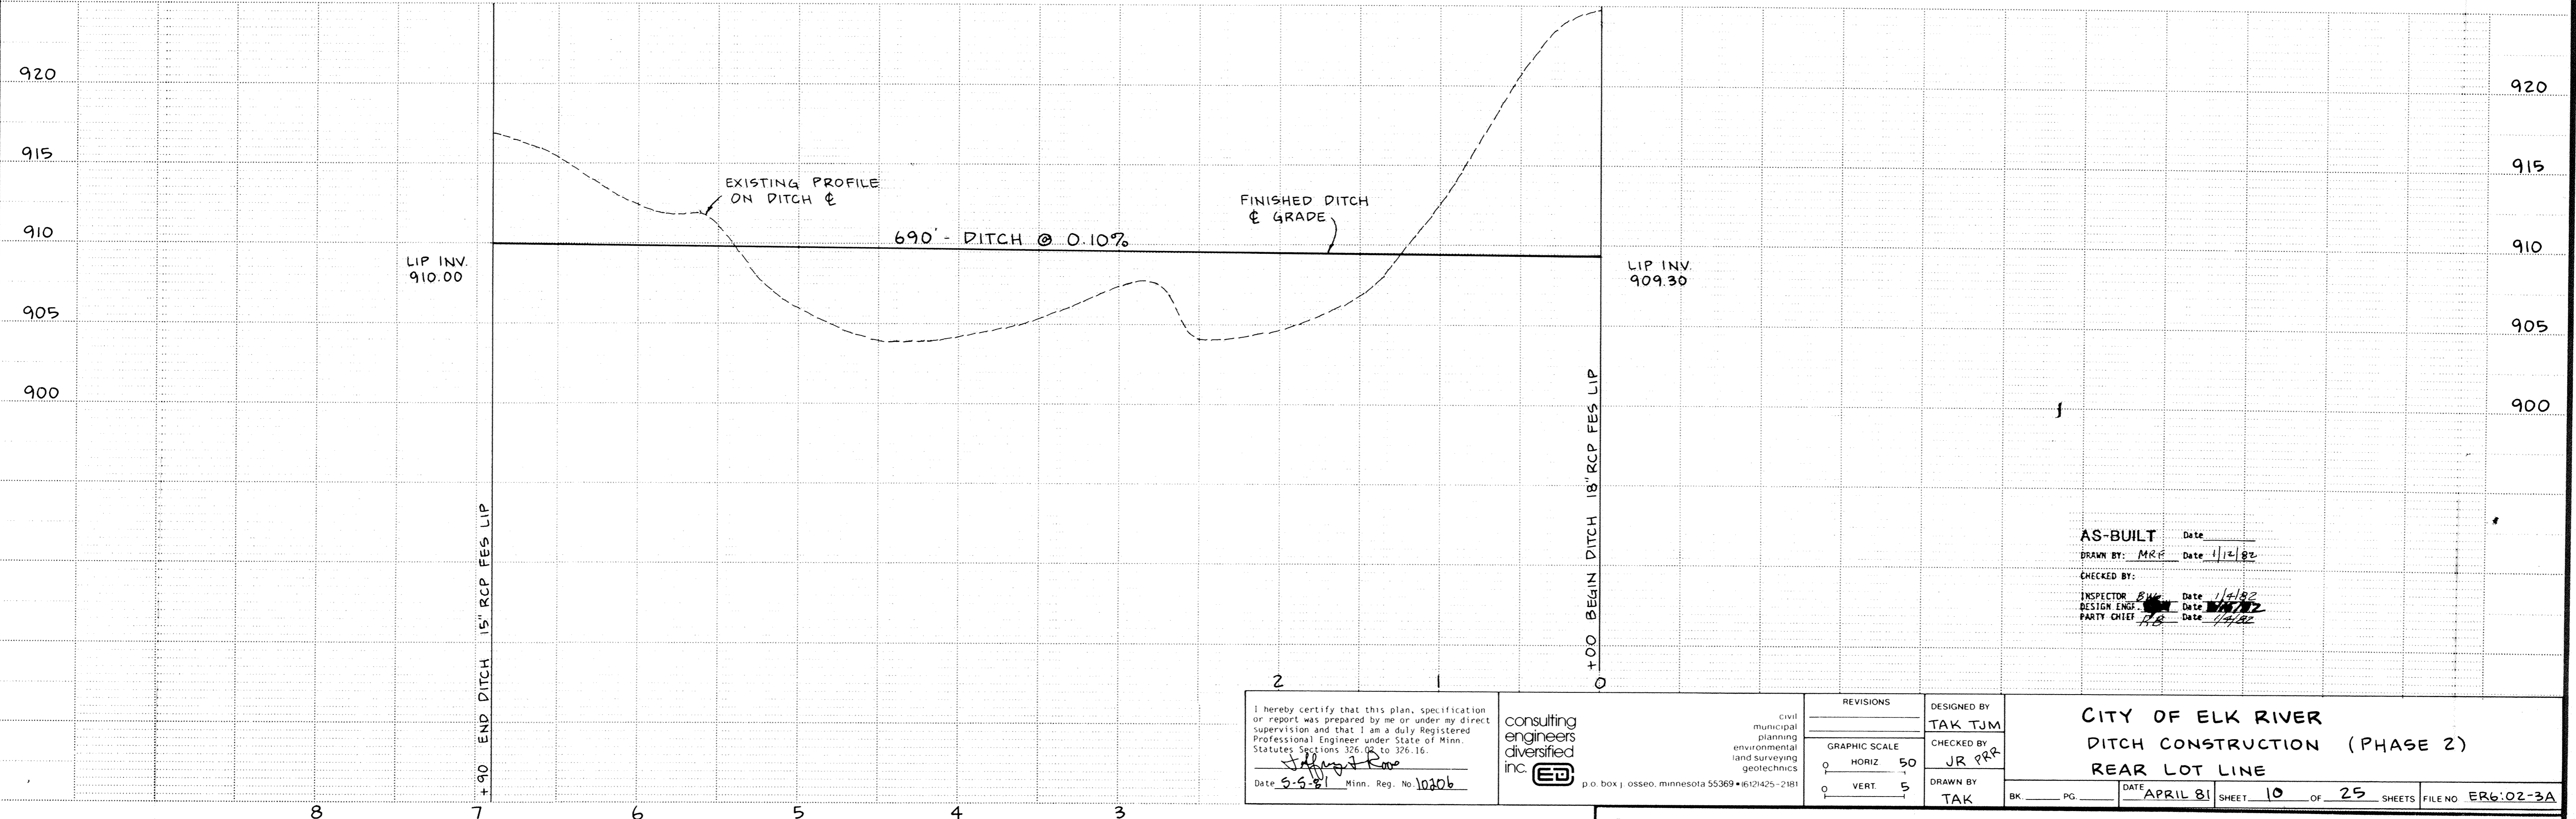

I hereby certify that this plan, specification or report was prepared by me or under my direct supervision and that I am a duly Registered Professional Engineer under State of Minn. Statutes, Sections 326.02 to 326.16.

Jeffrey J. Rowe
 Date 5-5-81 Minn. Reg. No. 10206

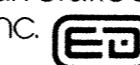consulting engineers diversified inc. 
 civil municipal planning environmental land surveying geotechnics
 p.o. box 1 osseo, minnesota 55369 • 612/425-2181

DESIGNED BY TAK TJM
CHECKED BY JR PRP
DRAWN BY TAK

CITY OF ELK RIVER
DITCH CONSTRUCTION (PHASE 2)
REAR LOT LINE

DATE **APRIL 81** SHEET **10** OF **25** SHEETS FILE NO. **ER6-02-3A**

State Proj. No.

Sheet No. of Sheets