

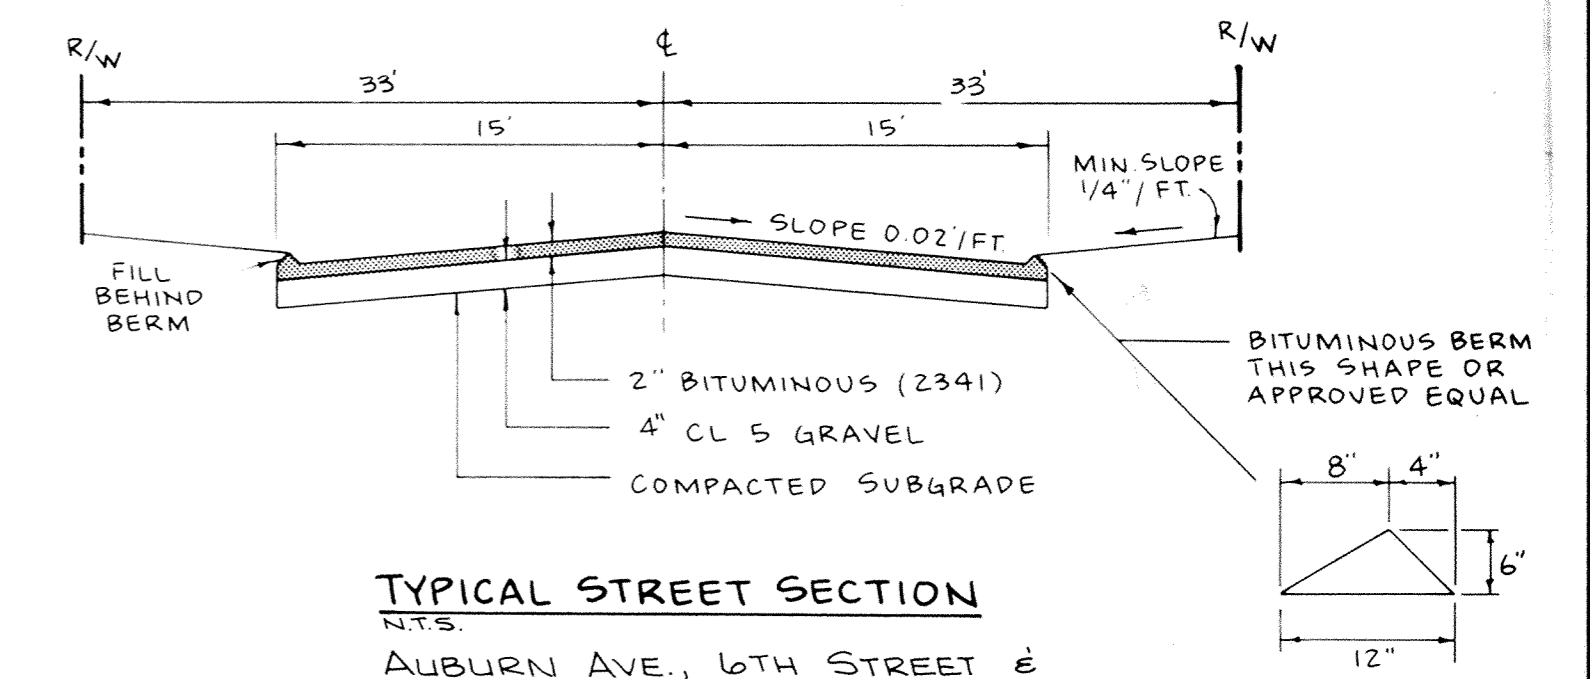


Fed. Proj. No.

AUBURN AVE.

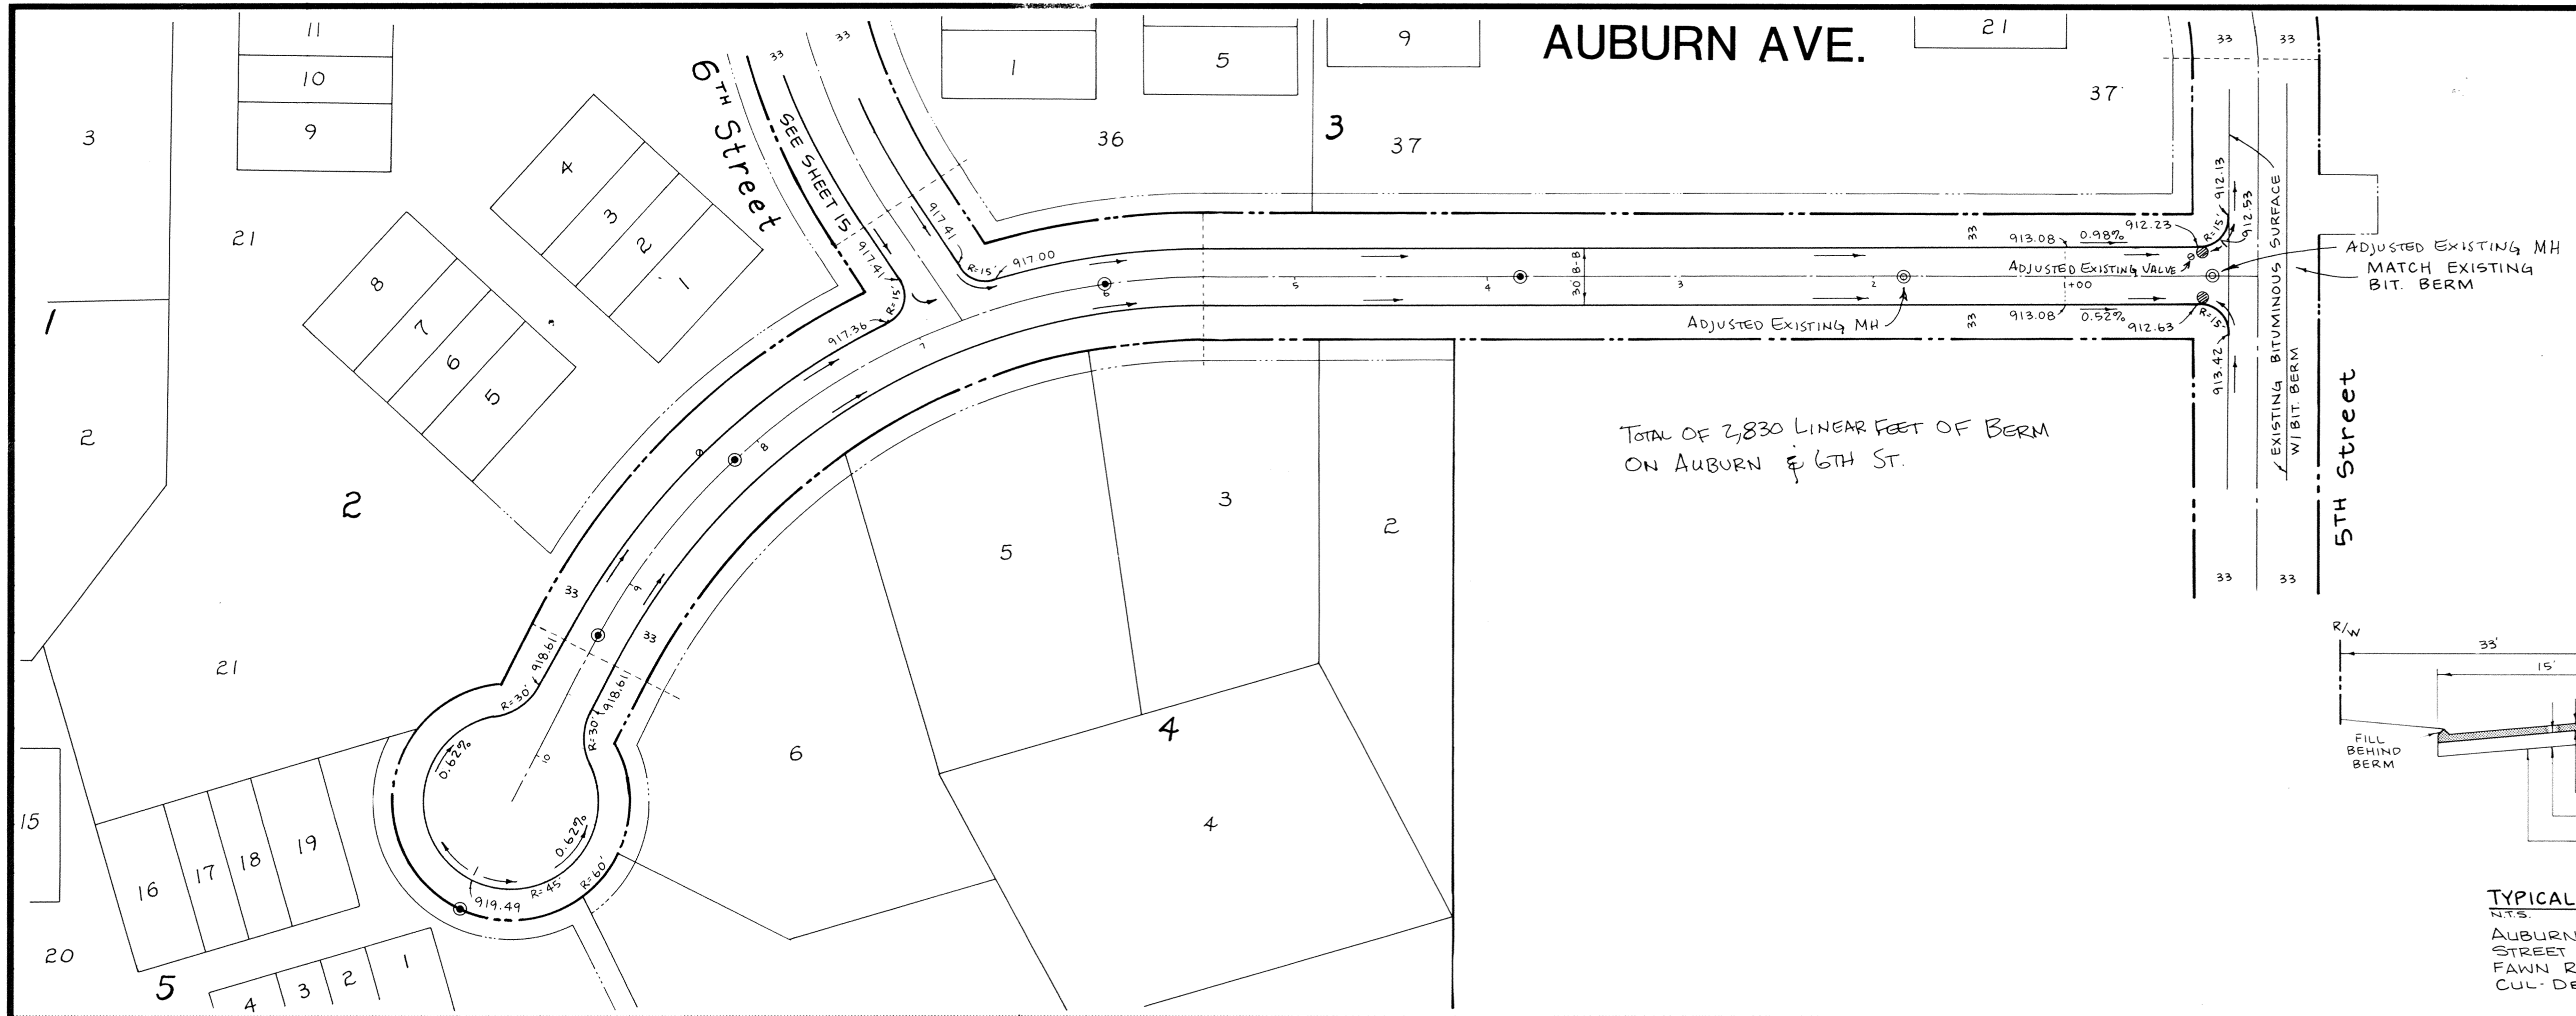

TYPICAL STREET SECTION
N.T.S.
AUBURN AVE., 6TH STREET & STREET COMPOSITION FOR FAUN ROAD & LINE AVE. CUL-DE-SACS

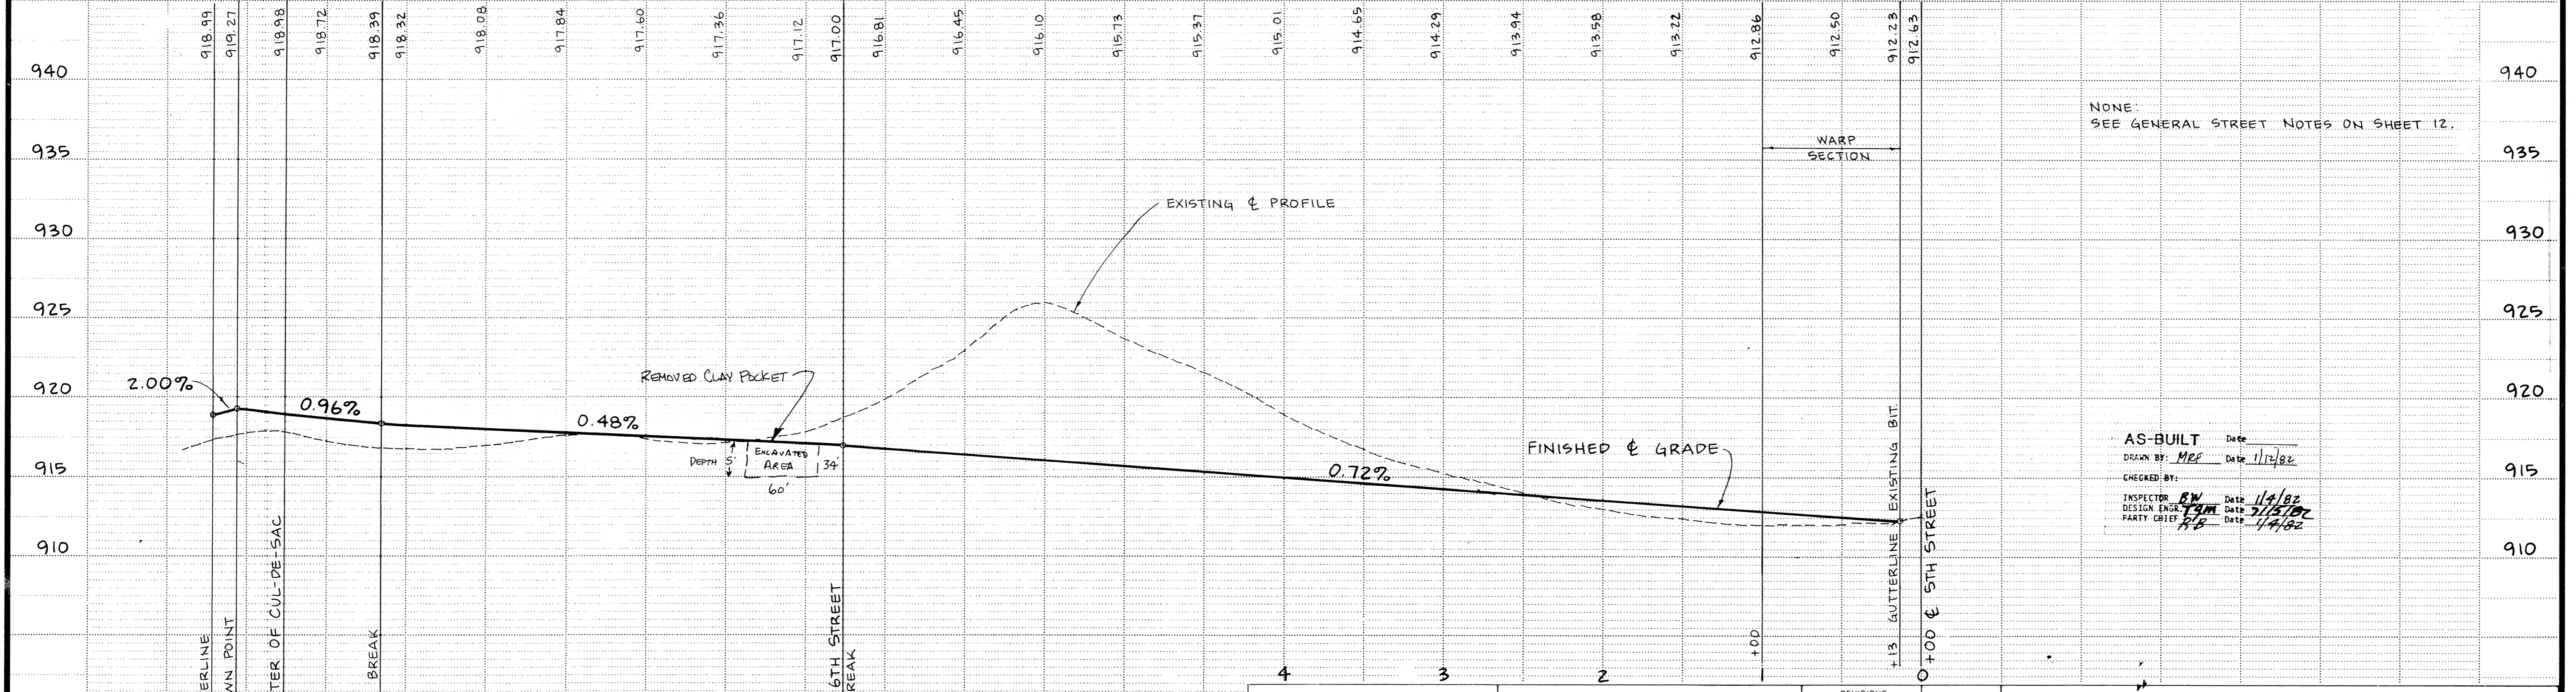

AS-BUILT Date 11/14/02
 DRAWN BY: MEL Date 11/14/02
 CHECKED BY:
 INSPECTOR: BW Date 11/14/02
 DESIGN ENGR: JRM Date 11/14/02
 PARTY CHIEF: RLP Date 11/14/02

I hereby certify that this plan, specification or report was prepared by me or under my direct supervision and that I am a duly Registered Professional Engineer under State of Minnesota Statutes Sections 325B.02-325.16
 Jeffrey J. Kross
 Date 5-5-01 Minn. Reg. No. 100206

consulting engineers diversified inc. civil municipal planning environmental land surveying geotechnics
 p.o. box 10550, minnesota 55369 • 612-425-2181

REVISIONS	

DESIGNED BY: TAK TJM
 CHECKED BY: JR per
 DRAWN BY: TAK
 CITY OF ELK RIVER
 STREET CONSTRUCTION (PHASE 2)
 AUBURN PLACE
 DATE APRIL 01 SHEET 14 OF 25 SHEETS FILE NO. ER6.02-3A