
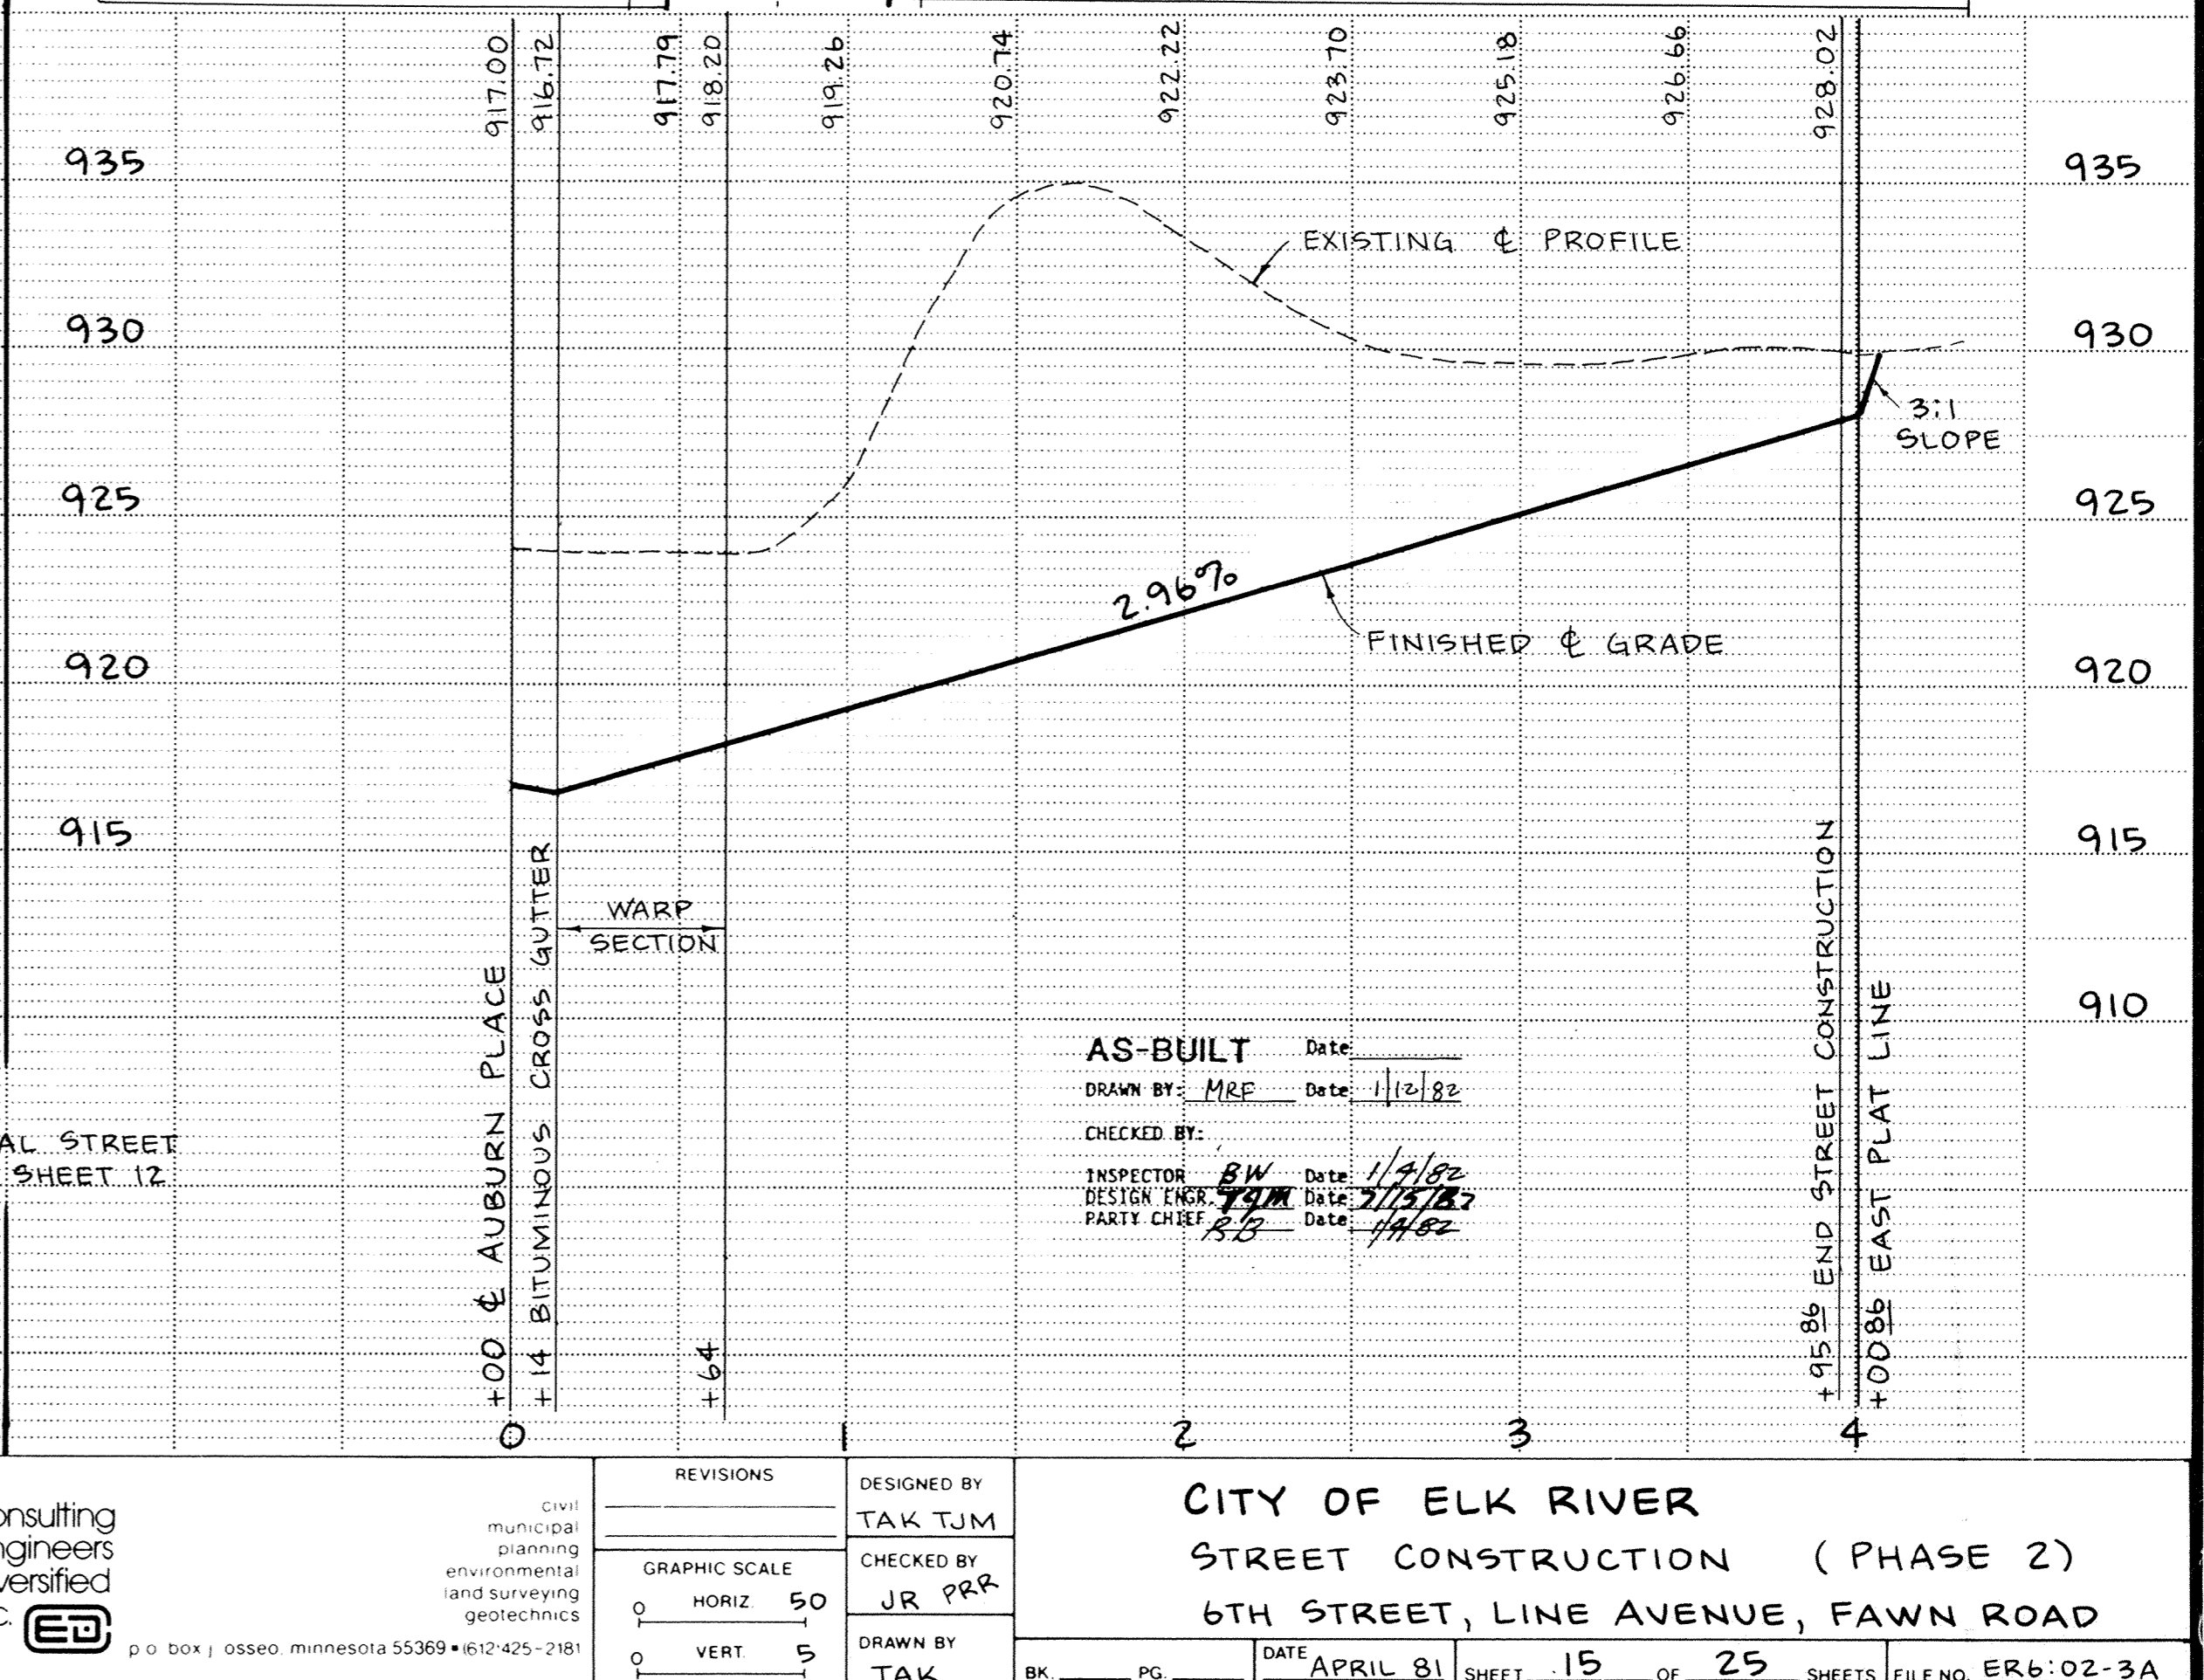
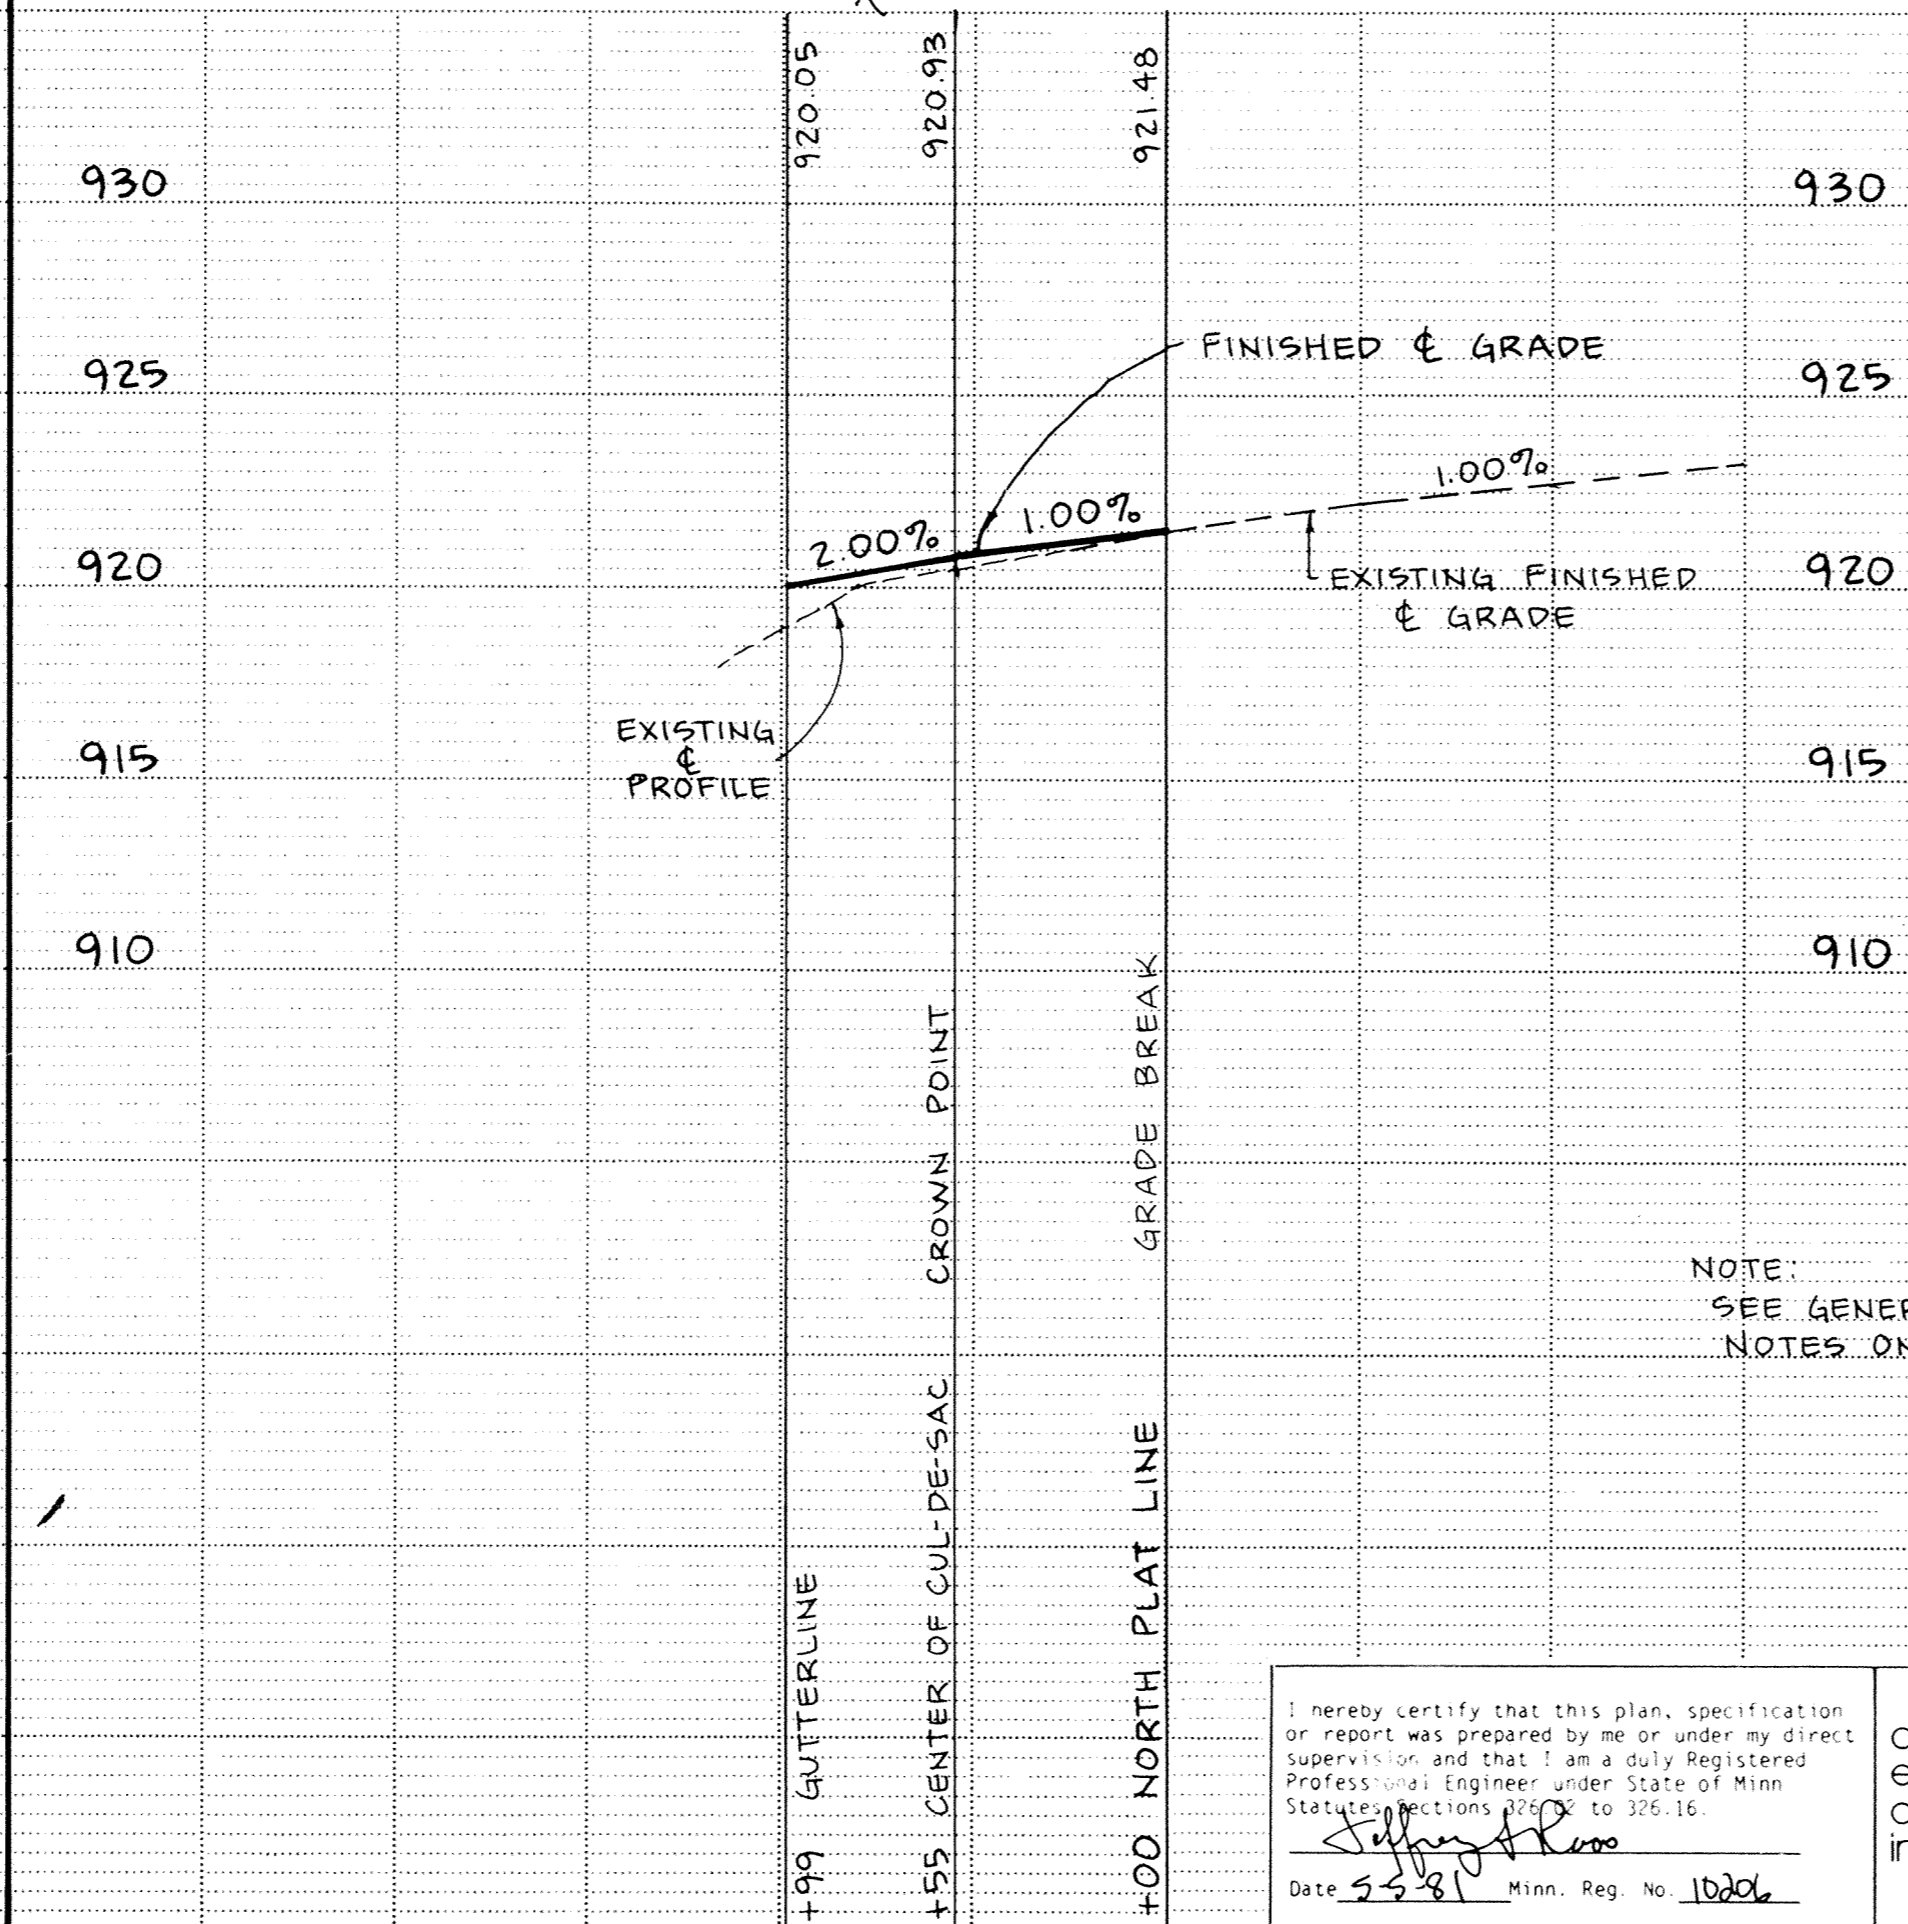
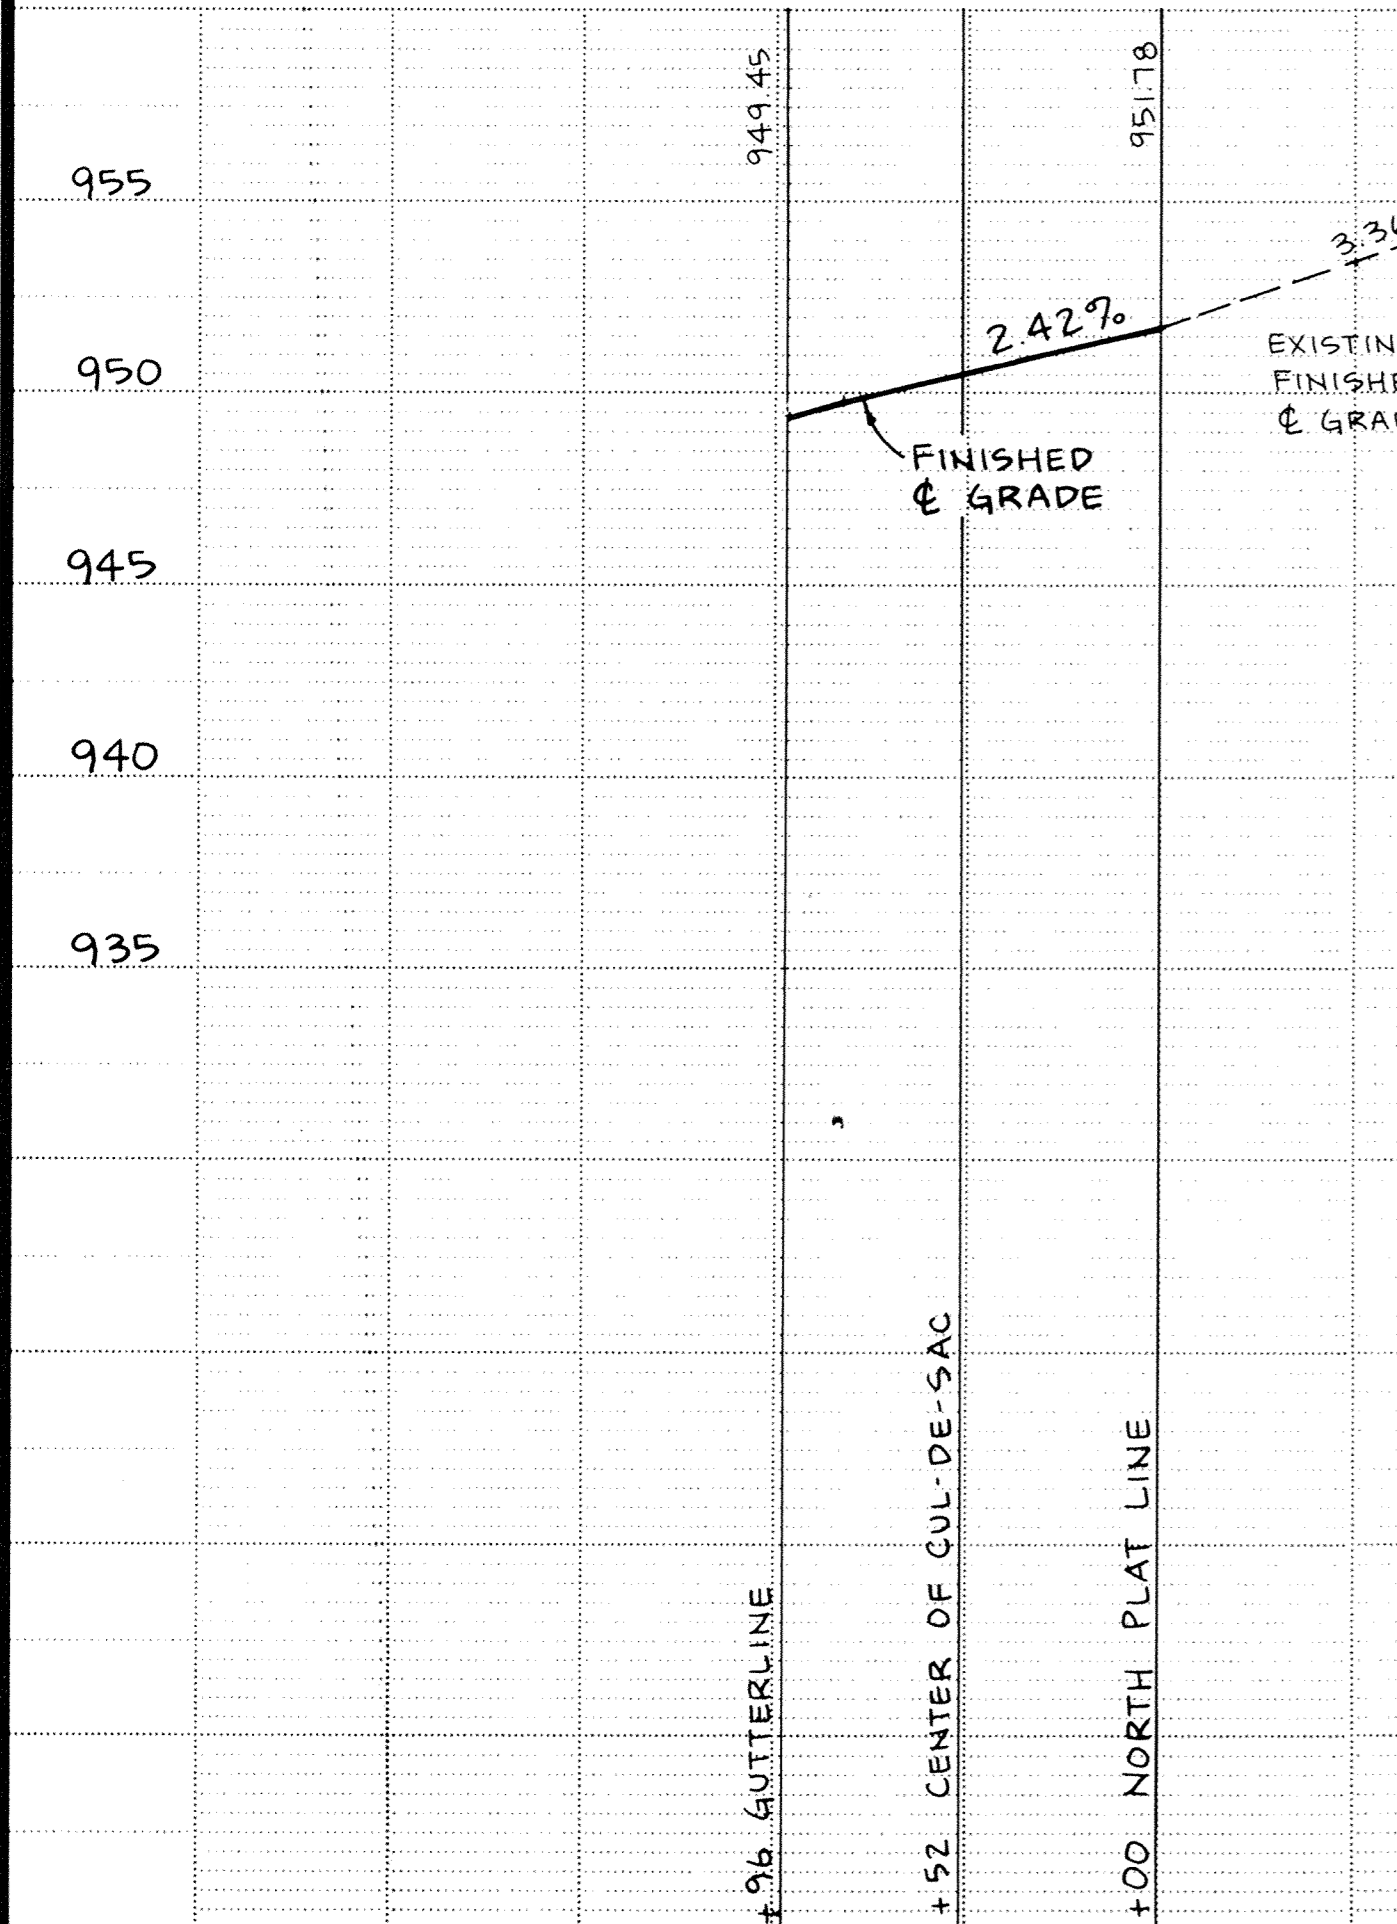
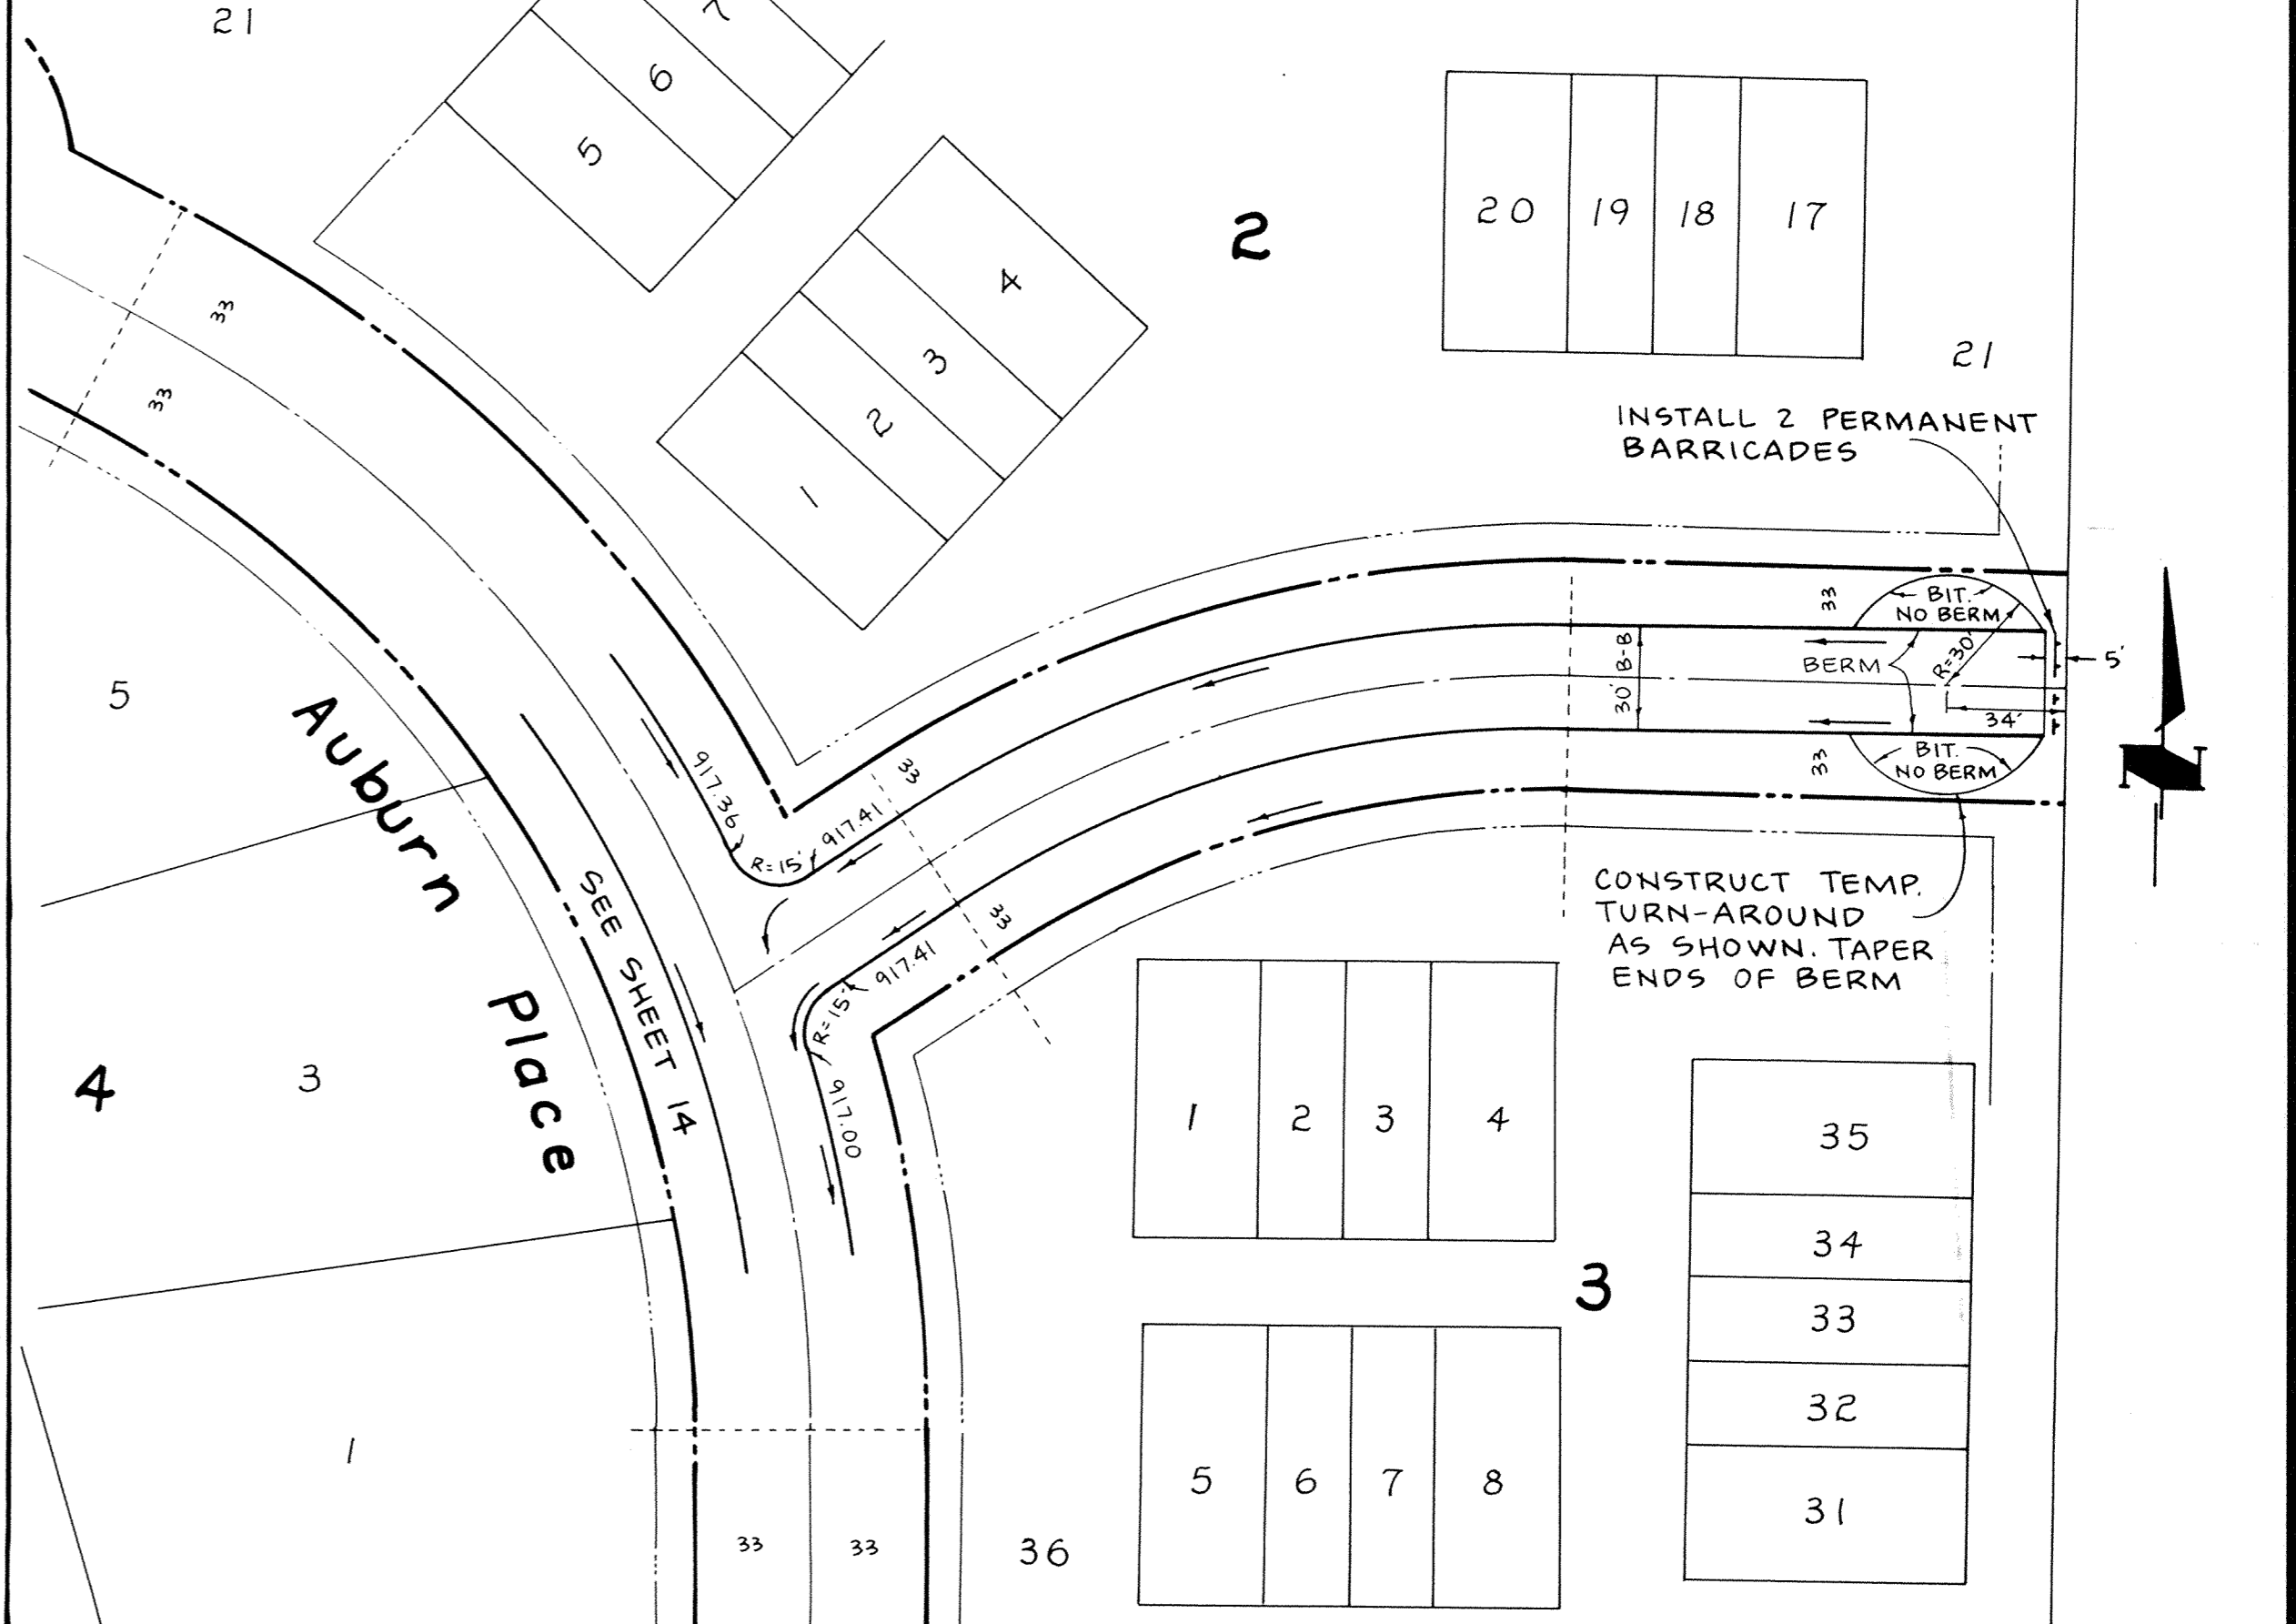
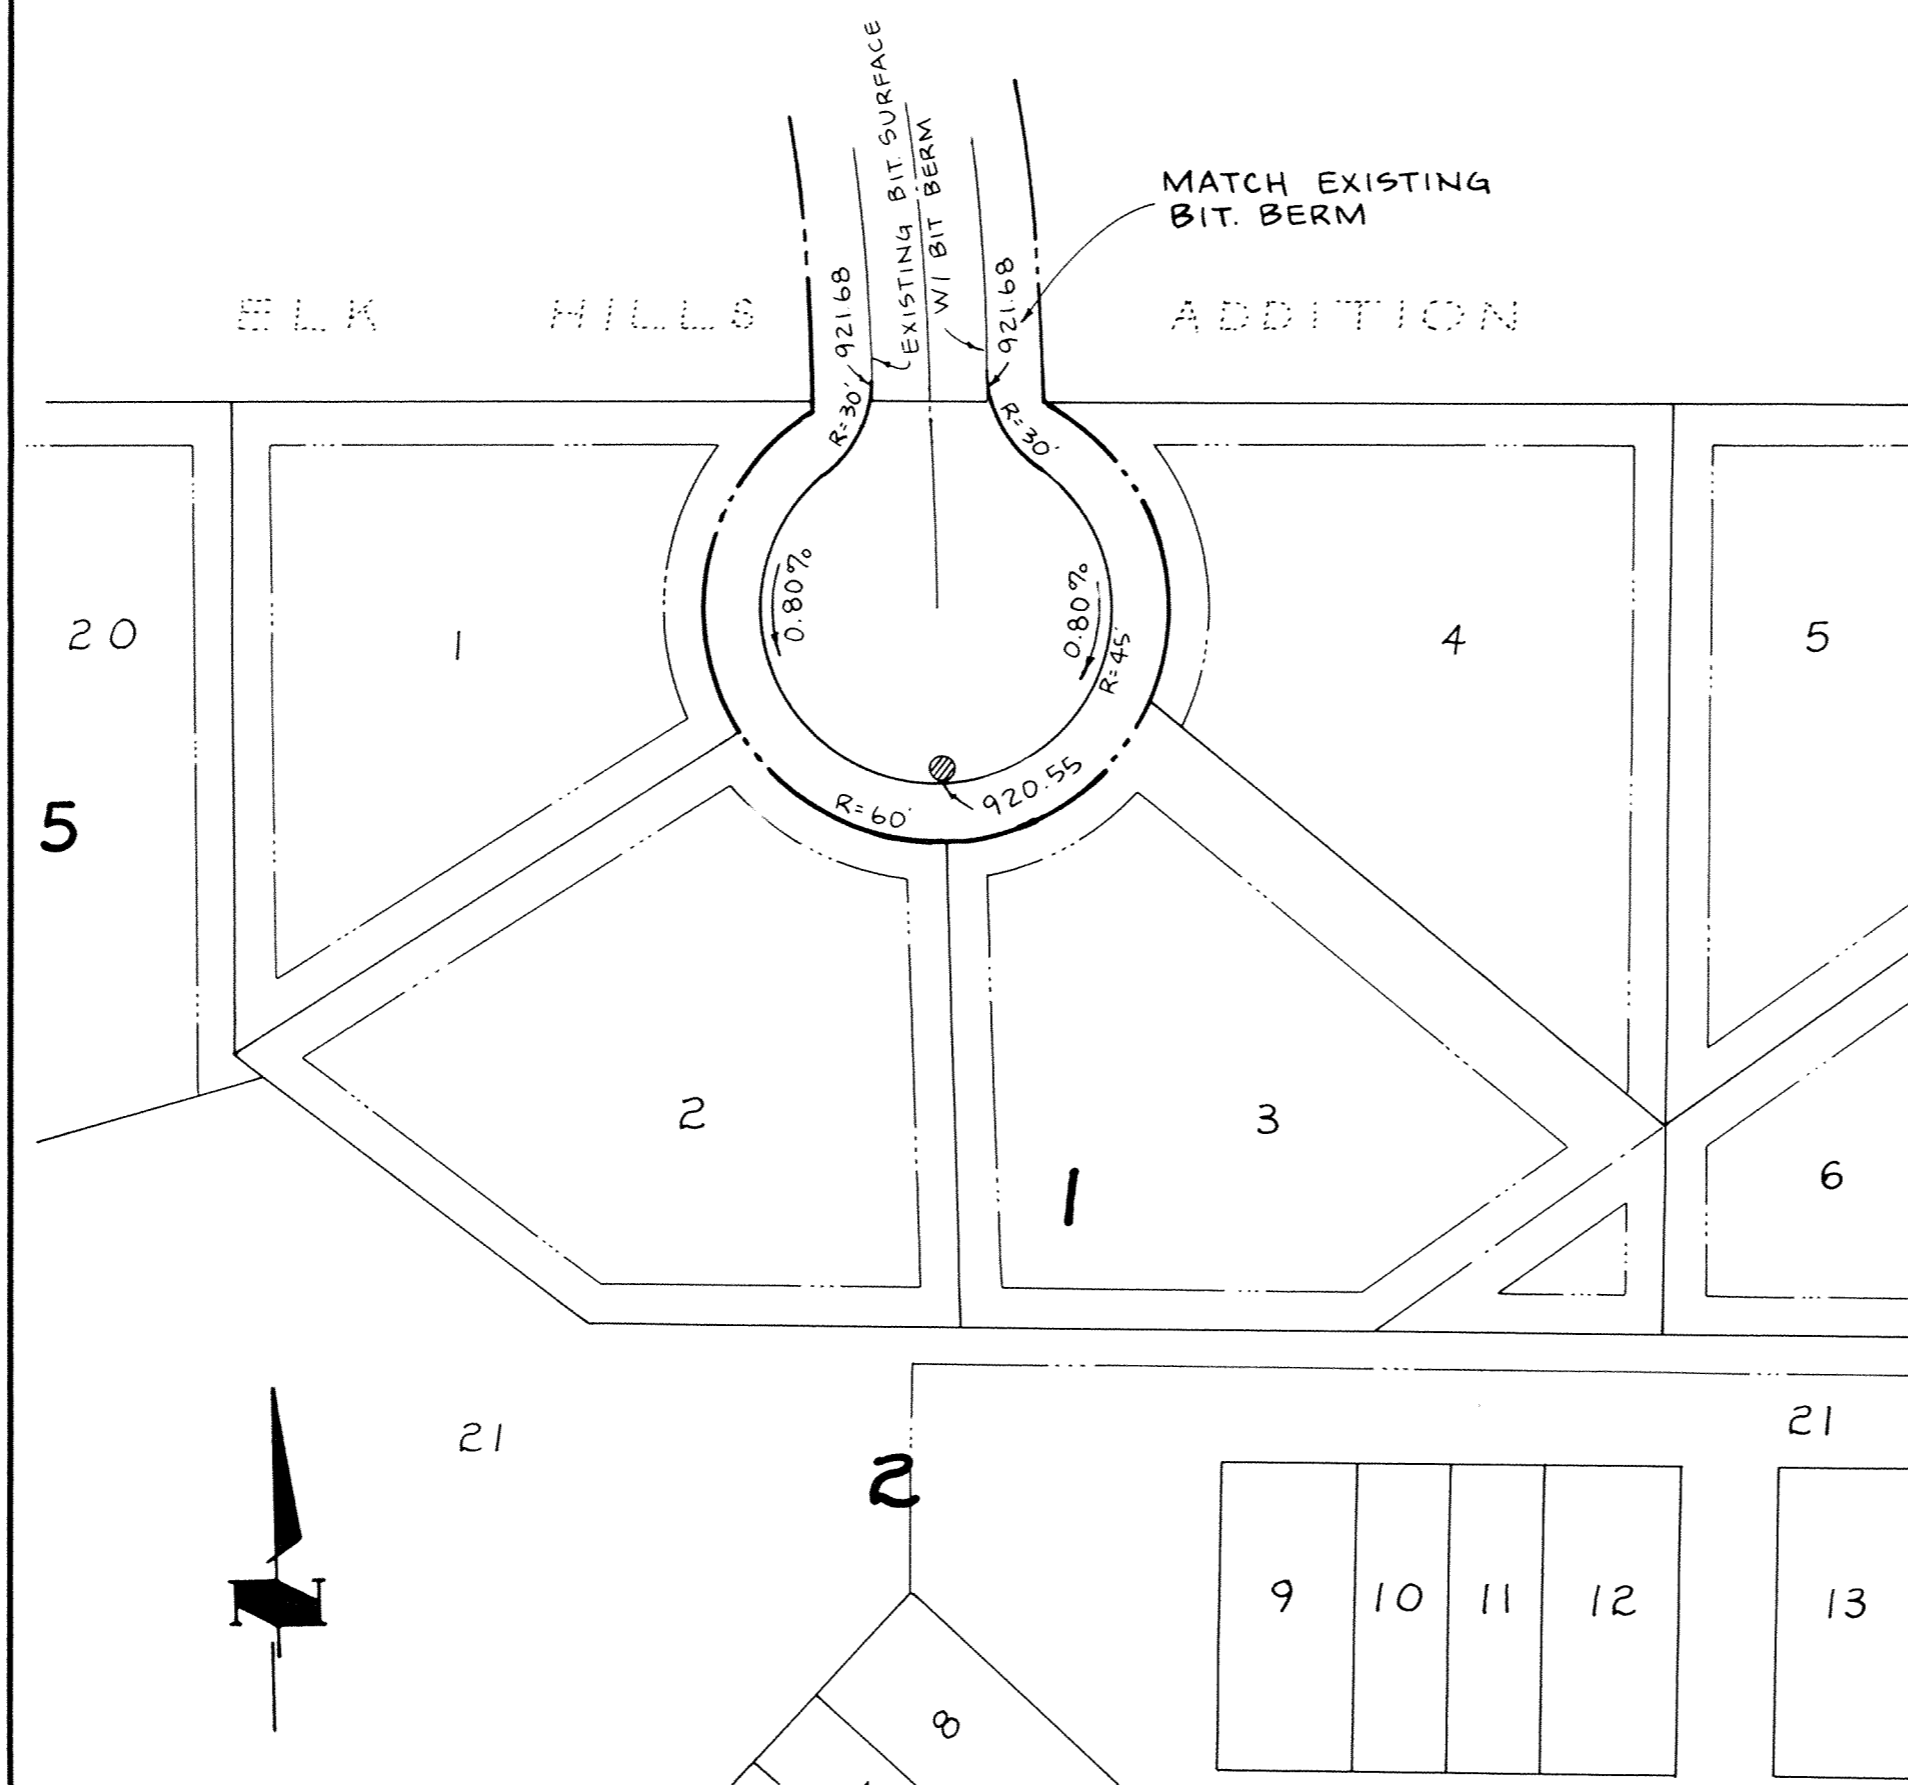


**FAWN ROAD  
LINE AVE.**

**LINE AVE.  
FAWN ROAD**

**6TH STREET Fed. Proj. No.**

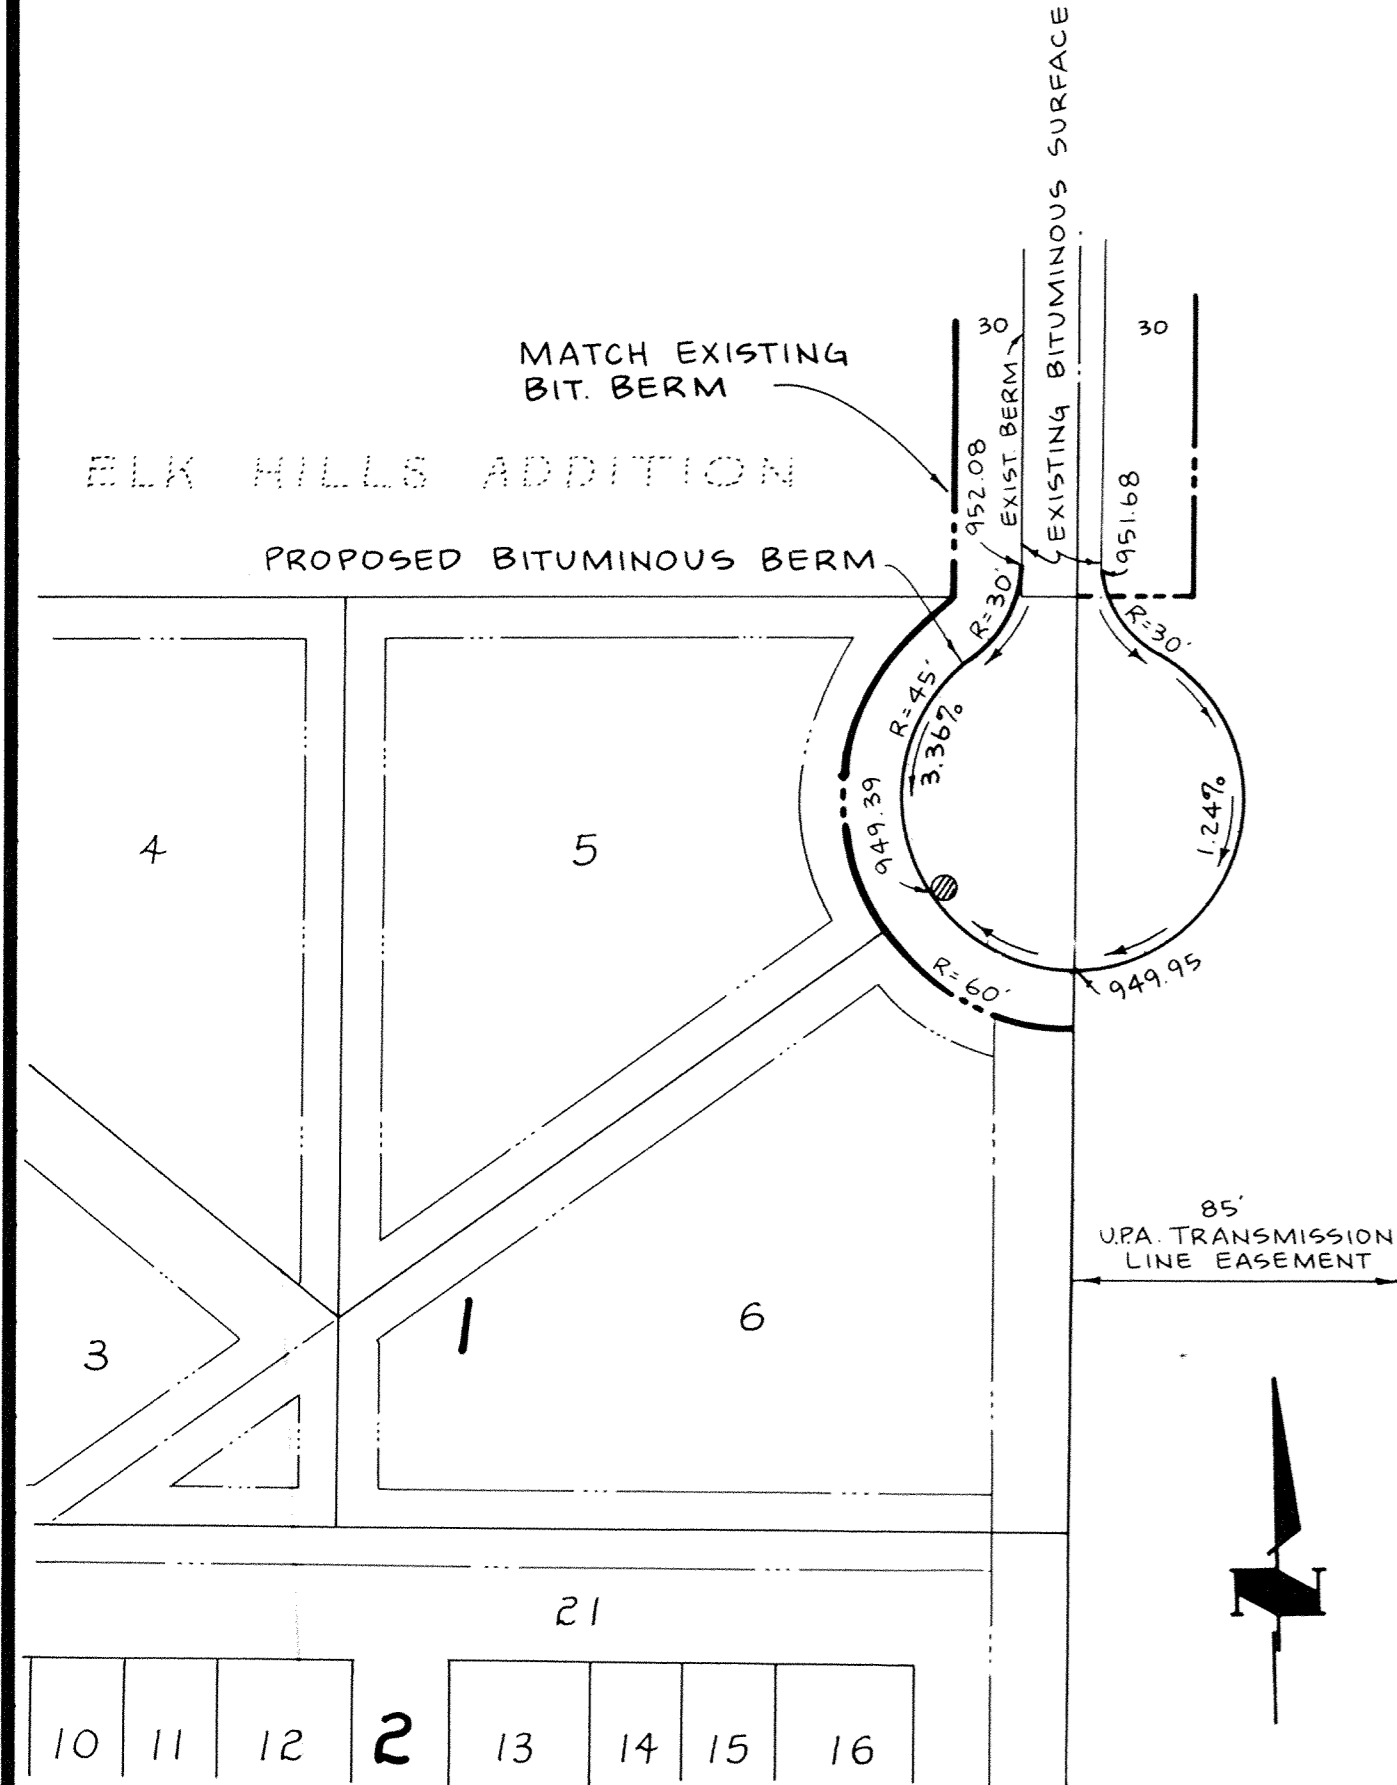

I hereby certify that this plan, specification or report was prepared by me or under my direct supervision and that I am a duly Registered Professional Engineer under State of Minnesota, License No. 55381, to 326.16.  
Date 5/3/81 Minn. Reg. No. 10206

consulting engineers diversified inc.  
civil municipal planning environmental land surveying geotechnics  
p.o. box 1 osseo, minnesota 55369 • (612) 425-2181

REVISIONS	
0	GRAPHIC SCALE
1	HORIZ 50
2	VERT 5

DESIGNED BY: TAK TJM  
CHECKED BY: JR PRP  
DRAWN BY: TAK  
CITY OF ELK RIVER  
STREET CONSTRUCTION (PHASE 2)  
6TH STREET, LINE AVENUE, FAWN ROAD  
DATE: APRIL 81 SHEET 15 OF 25 SHEETS FILE NO ER6-02-3A

AS-BUILT Date: 1/10/82  
DRAWN BY: MKP Date: 1/10/82  
CHECKED BY: [Signature]  
INSPECTOR: BW Date: 1/14/82  
DESIGN ENGR: JRM Date: 7/25/82  
PARTY CHIEF: [Signature] Date: 1/14/82