



Fed. Proj. No.

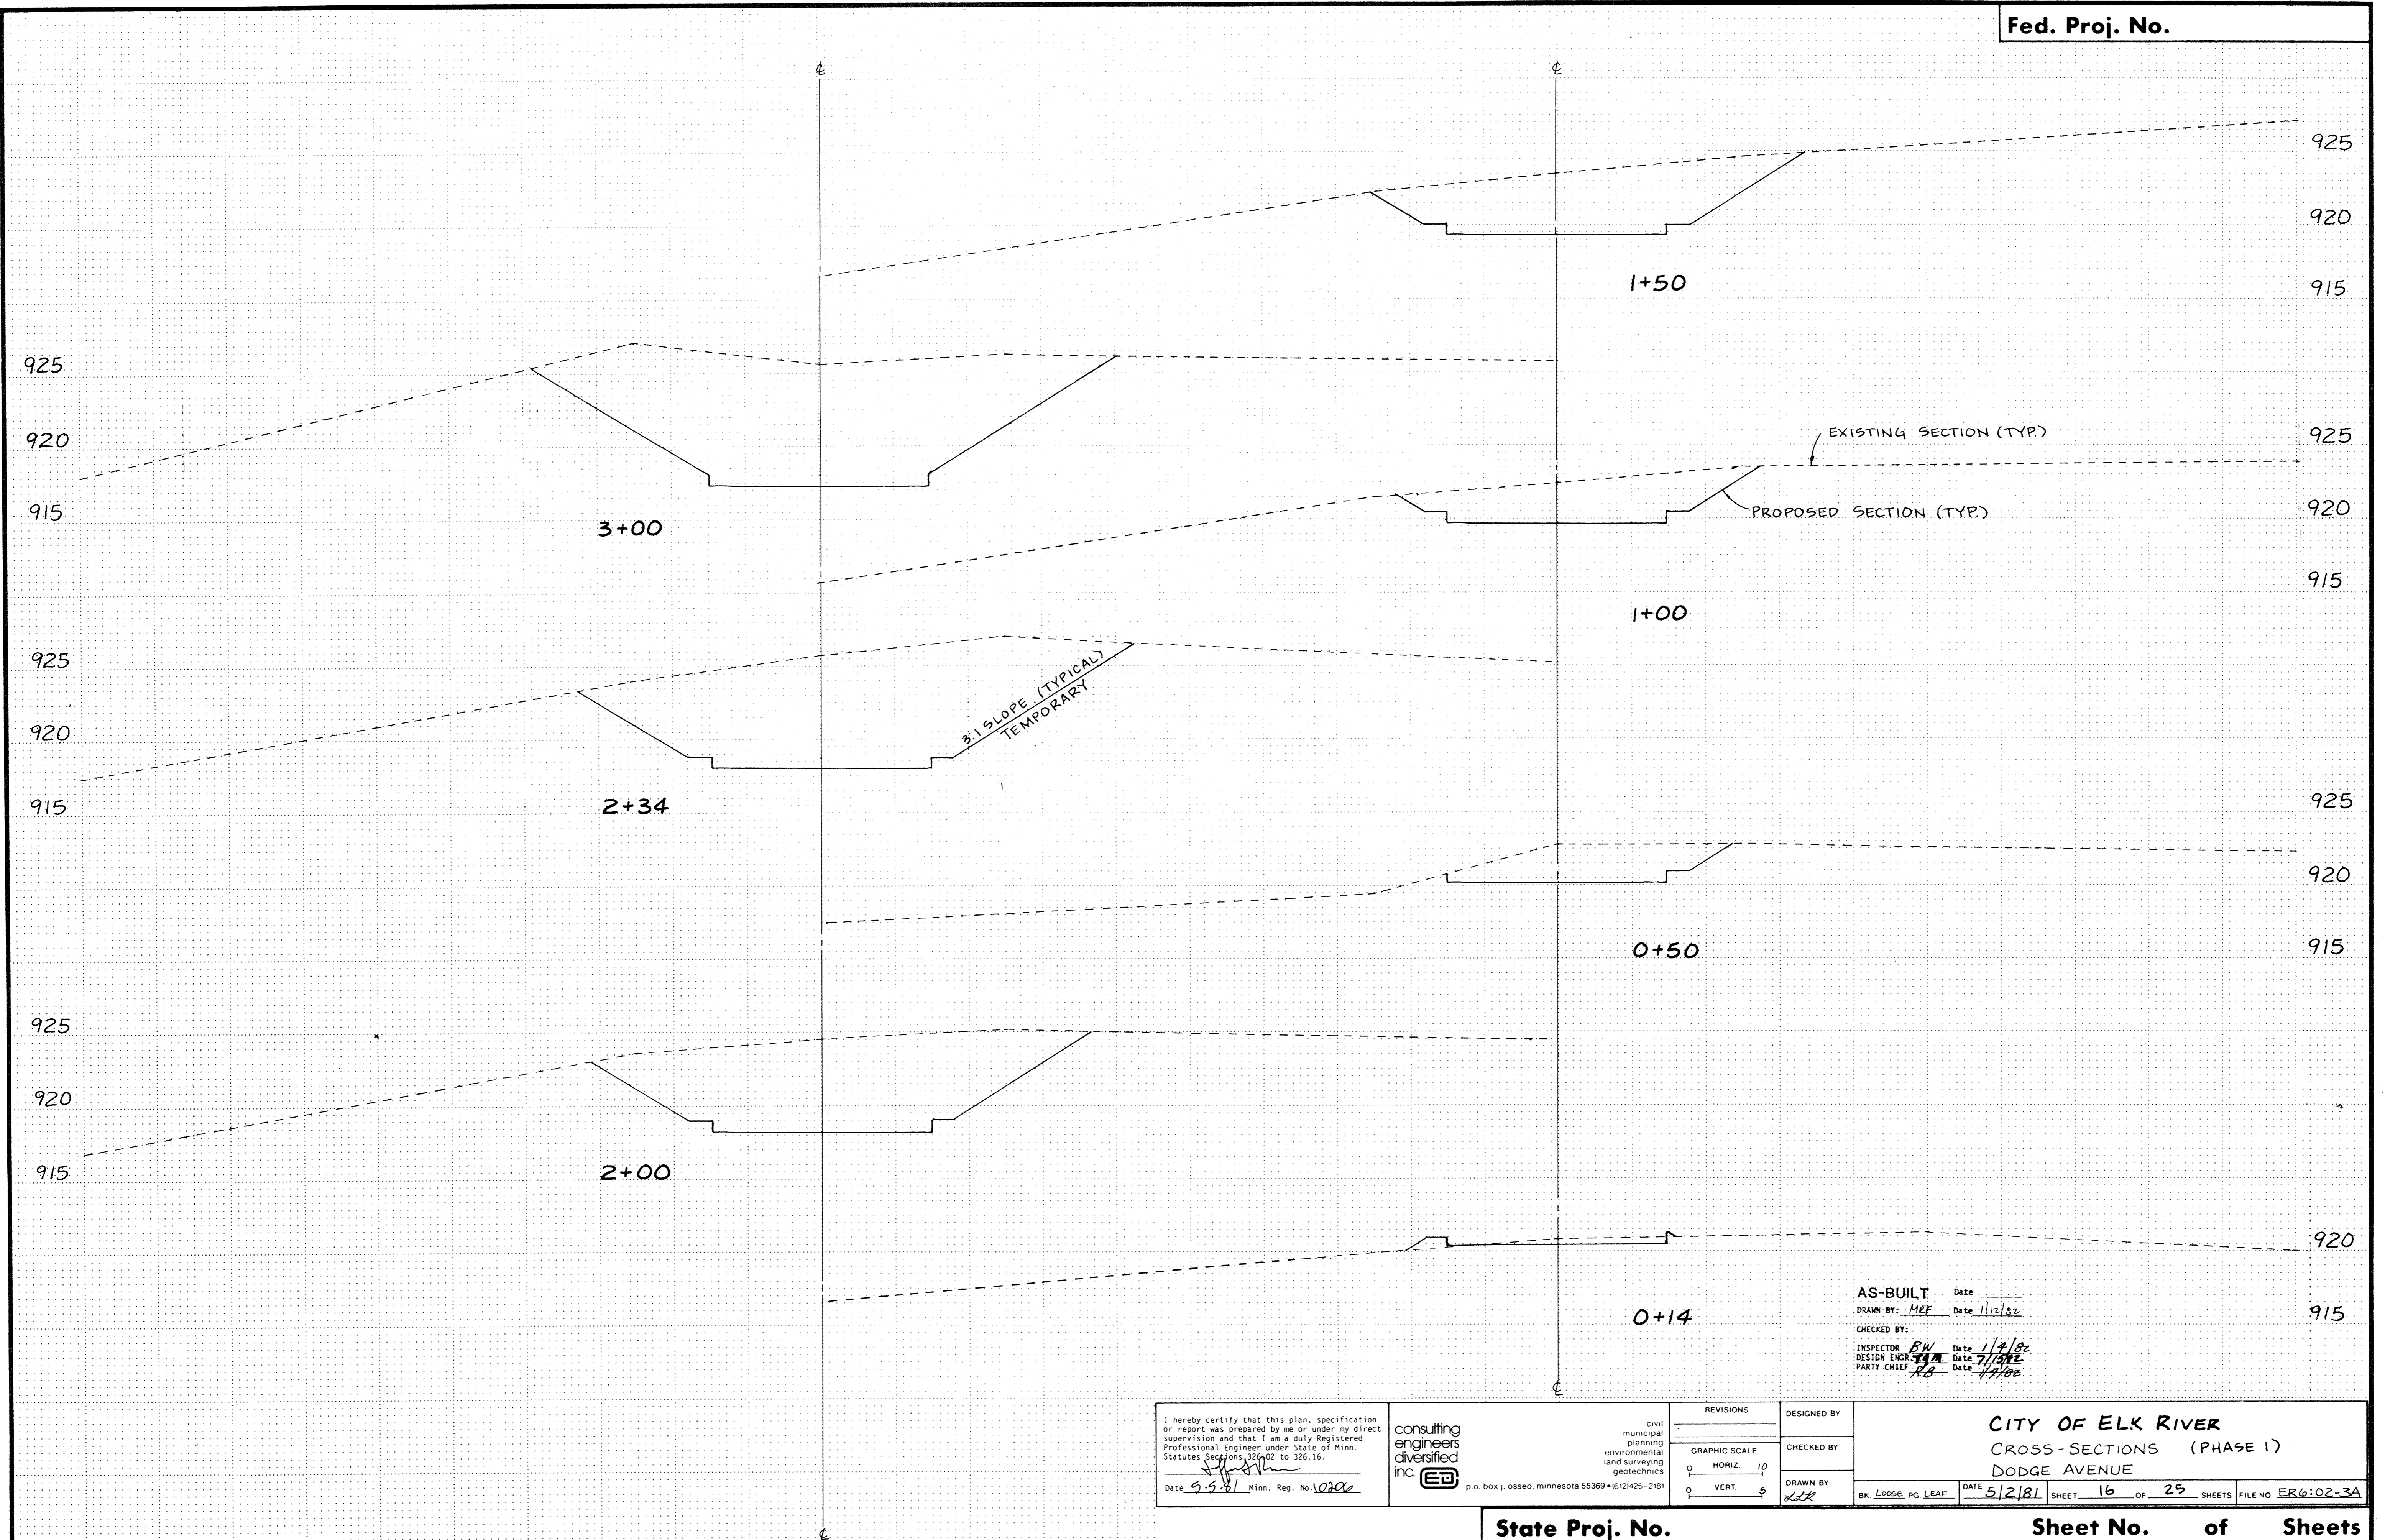

AS-BUILT Date _____
 DRAWN BY: MEF Date 11/2/82
 CHECKED BY: _____
 INSPECTOR: BW Date 1/4/83
 DESIGN ENGR: JJA Date 7/1/82
 PARTY CHIEF: RB Date 1/1/83

I hereby certify that this plan, specification or report was prepared by me or under my direct supervision and that I am a duly Registered Professional Engineer under State of Minn. Statutes Sections 326.02 to 326.16.
 Date 5-5-81 Minn. Reg. No. 10202

consulting engineers diversified inc. 
 p.o. box 1, osseo, minnesota 55369 • 612/425-2181

REVISIONS	

GRAPHIC SCALE
 0 HORIZ 10
 0 VERT 5

DESIGNED BY _____
 CHECKED BY _____
 DRAWN BY *MEF*
 CITY OF ELK RIVER
 CROSS-SECTIONS (PHASE 1)
 DODGE AVENUE
 BK. LODGE PG. LEAF DATE 5/2/81 SHEET 16 OF 25 SHEETS FILE NO. ERG:02-3A

State Proj. No. Sheet No. of Sheets